

O.D.O.T. DISTRICT 2 SURVEY OFFICE (USE ONLY)

PERSONNEL

REFERENCE NO. 11

SHEET OF

NOTES MILLER DATE 8/5/24

H.C. NIESE WEATHER SUNNY

R.C. PRESTON-COLVIN TEMP. 80°

ASTON

DWG BY BARRIERE PID 92371

ROUTE SR 18

COUNTY SENECA

TOWNSHIP LOUDON

SECTION 16

T 2 N R 13 E

TYPE MONUMENT MAG NAIL/WASHER

ON SURFACE - BELOW 2" BELOW

OFFSET $\oslash$ PAVEMENT 1.5' LT LT : RT

 TO EDGE PAVEMENT

STATION: 190+00.62

HORIZ.DATUM: NAD83 (2011)



GEOID: 18

GRID: NORTHING: 535977.128


EASTING: 1729541.914

LDP: NORTHING:

EASTING:

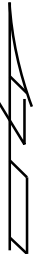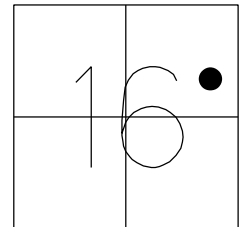

RECORD: P.O.T.
STA. 190+00.62
FD P.K./WASHER
ATOP MINE SPIKE
FD P.K./WASHER
7/10/97, MB
SET P.K./WASHER
11/6/97, MB
FD P.K./WASHER
REF11
4/22/19
8/19/19, JFO
FD P.K./WASHER
2" DOWN
2/10/23, JMR
FD P.K.SHANK
2 1/2" DOWN
9/15/23,
10/6/23, DSA
4/5/24, TDN
SET MAG/WASHER
8/5/24, TDN

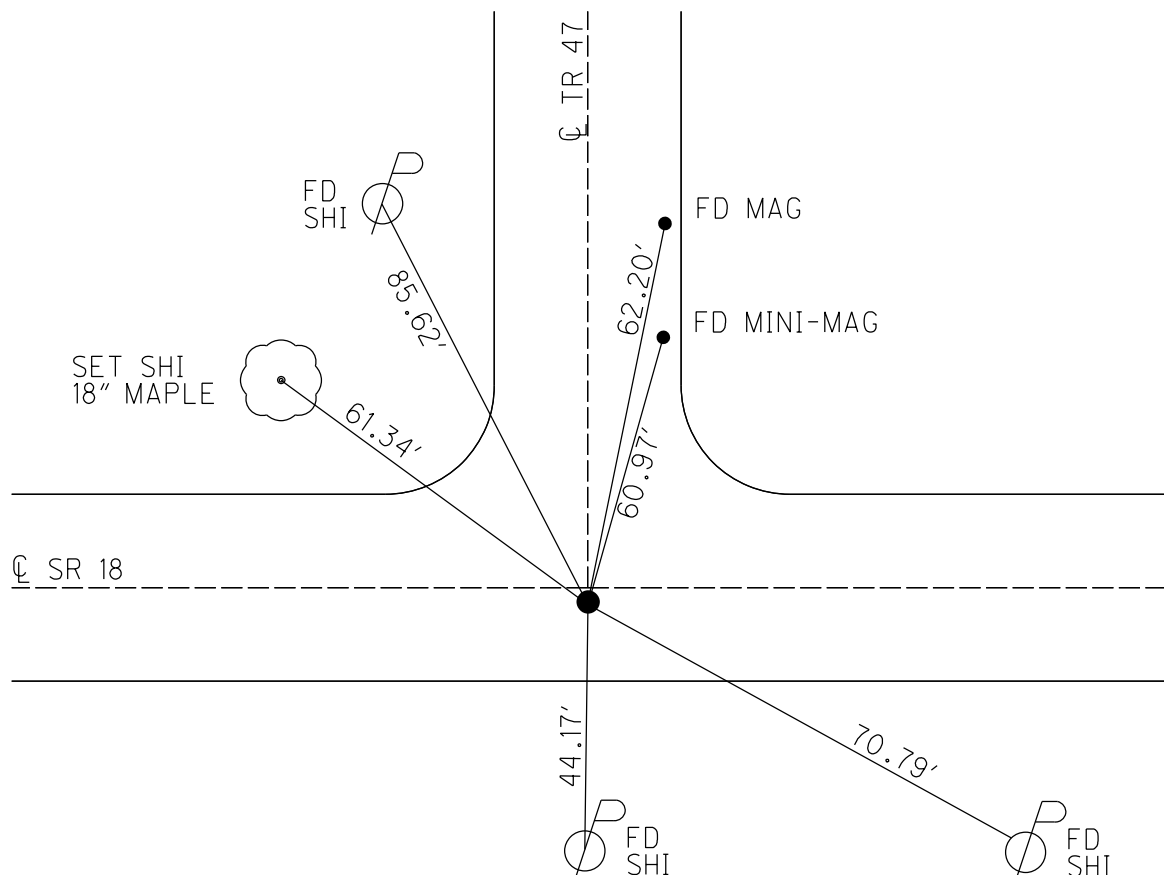

O.D.O.T. DISTRICT 2 SURVEY OFFICE (USE ONLY)

PERSONNEL

REFERENCE NO. 11

SHEET 6 OF 48

NOTES RHOADES

DATE 9/15/23

ROUTE SR 18

H.C. MILLER

WEATHER SUNNY

COUNTY SENECA

R.C. RHOADES

TEMP. 53°

TOWNSHIP LOUDON

SECTION 16

DWG BY RHOADES

PID PAVETRAIN

T 2 N R 13 E

TYPE MONUMENT P.K. SHANK

~~ON SURFACE~~ - BELOW 2 1/2"

OFFSET CL PAVEMENT 1.5' LT : ~~RT~~

13.5' TO LT EDGE PAVEMENT



STATION: 190+00.62

HORZ.DATUM: NAD83 2011

GEOID: NAVD88 2012A

GRID: NORTHING: 535977.120

EASTING: 1729541.906

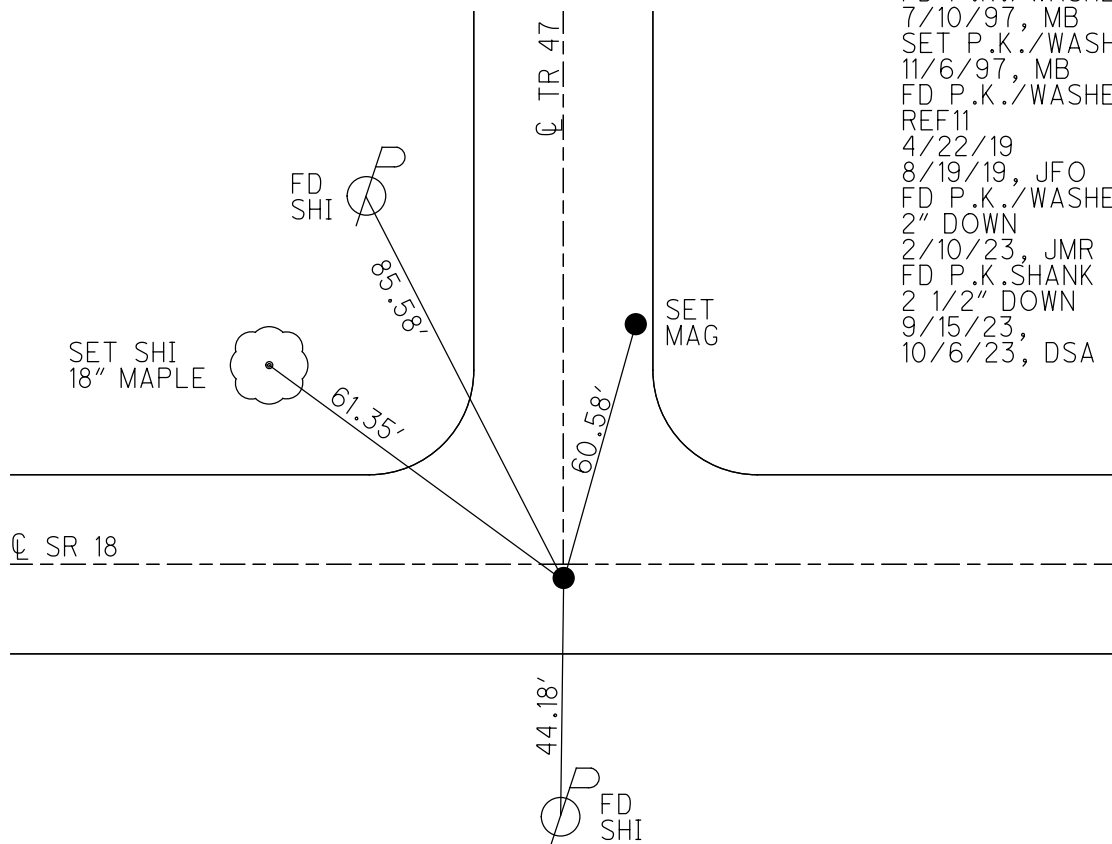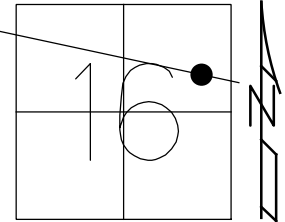

RECORD: P.O.T.
STA.190+00.62
FD P.K./WASHER
ATOP MINE SPIKE
FD P.K./WASHER
7/10/97, MB
SET P.K./WASHER
11/6/97, MB
FD P.K./WASHER
REF11
4/22/19
8/19/19, JFO
FD P.K./WASHER
2" DOWN
2/10/23, JMR
FD P.K.SHANK
2 1/2" DOWN
9/15/23,
10/6/23, DSA

O.D.O.T. DISTRICT 2 SURVEY OFFICE (USE ONLY)

PERSONNEL

REFERENCE NO. 11

SHEET 6 OF 48

NOTES BARNHISEL
H.C. CANTERBURY
R.C. WEAVER
ROUSOS

DATE 7/10/97
WEATHER SUNNY
TEMP. 75°

ROUTE SR 18
COUNTY SENECA
TOWNSHIP LOUDON
SECTION 16

DWG BY NIESE PID NO PID

T 2 N R 13 E

TYPE MONUMENT P.K./WASHER

ON SURFACE - ~~BELOW~~ ON

OFFSET Q PAVEMENT 1.5' LT : ~~RT~~

13.5' TO LT EDGE PAVEMENT


STATION: 190+00.62

HORZ.DATUM: NAD83(2011)


GEOID: 2012A

GRID: NORTHING: 535977.120

EASTING: 1729541.906

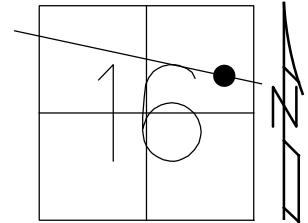

RECORD: P.O.T.
STA.190+00.62
FD P.K./WASHER
ATOP MINE SPIKE
FD P.K./WASHER
7/10/97, MB
SET P.K./WASHER
11/6/97, MB
FD P.K./WASHER
REF11
4/22/19
8/19/19, JFO
FD P.K./WASHER
2" DOWN
2/10/23, JMR

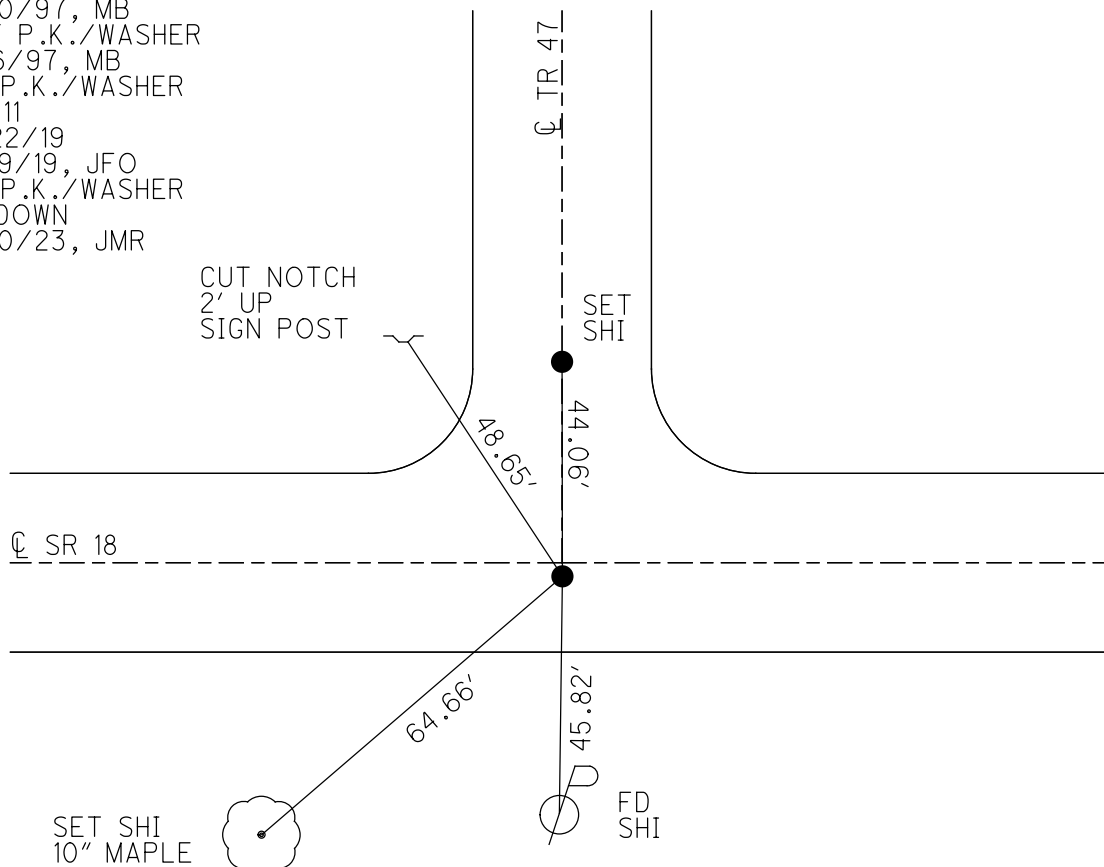

O.D.O.T. DISTRICT 2 SURVEY OFFICE (USE ONLY)

PERSONNEL

REFERENCE NO. 11

SHEET 6 OF 48

NOTES BARNHISEL

DATE 7/10/97

ROUTE SR 18

H.C. CANTERBURY

WEATHER SUNNY

COUNTY SENECA

R.C. WEAVER

TEMP. 75°

TOWNSHIP LOUDON

ROUSOS

SECTION 16

DWG BY NIESE PID NO PID

T 2 N R 13 E

TYPE MONUMENT P.K./WASHER

ON SURFACE - ~~BELOW~~ ON

OFFSET 13.5' Q PAVEMENT 1.5' LT : ~~RT~~

TO LT EDGE PAVEMENT


STATION: 190+00.62

HORZ.DATUM: NAD83(2011)


GEOID: 2012A

GRID: NORTHING: 535977.120

EASTING: 1729541.906

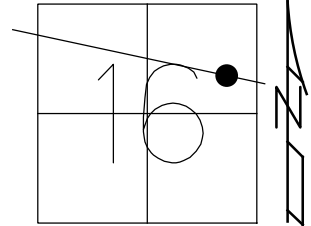

RECORD: P.O.T.
STA.190+00.62
FD P.K./WASHER
ATOP MINE SPIKE
FD P.K./WASHER
7/10/97, MB
SET P.K./WASHER
11/6/97, MB
FD P.K./WASHER
REF11
4/22/19
8/19/19, JFO

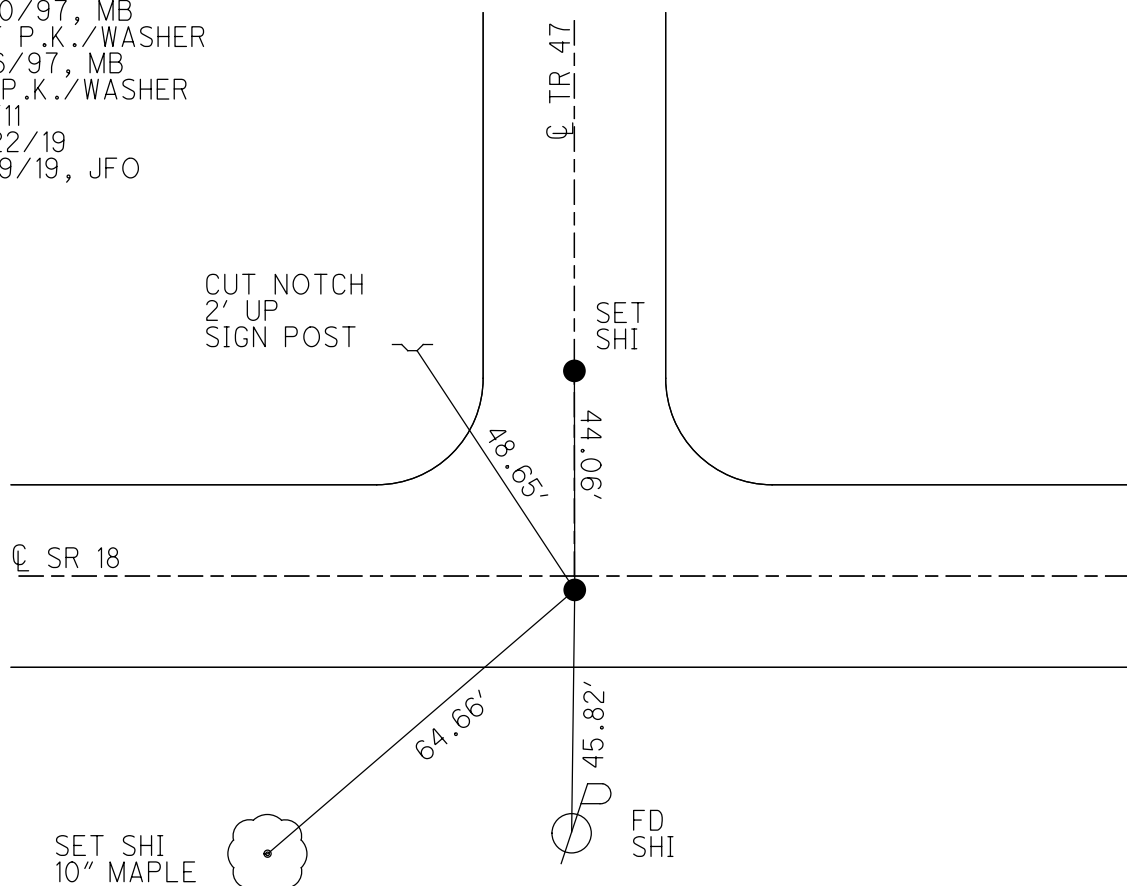

O.D.O.T. DISTRICT 2 SURVEY OFFICE

PERSONNEL

REFERENCE NO. 11

SHEET 11 OF 22

NOTES Barnhart

H.C. Cantonbury

R.C. WEAVER

Rousos

Drawn By Rousos

DATE 7-10-97

WEATHER SUNNY

TEMP. 75°

ROUTE 18

COUNTY SENECA

TOWNSHIP LOUDON

SECTION 16

T2 N R 13 E


TYPE MONUMENT PK & WASHER

ON SURFACE - ~~BELOW~~ ON SURFACE

LEFT - PAV'T. - ~~RIGHT~~ 1.5

13.5 TO LT EDGE PAVEMENT

S.L.M. C+ 167.7 SLK

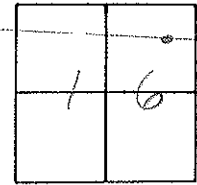

P.O.T. SURVEY

-190+00.62

PK & WASHER ATOP

MINI SPIKE

CUT NOTCH IN
SIGN POST 2' UP

SET S&W
IN PLAT

RESET PK & WASHER
11-6-97
MB

⌘ SURVEY SR18

SET S&W
10" MAPLE
N/S

S&W N/S

O.D.O.T. DISTRICT 2 SURVEY OFFICE

PERSONNEL

REFERENCE NO. 11

SHEET 11 OF

NOTES C. BONIN

DRAWN 1/19/90

H.C. RIPPLE

DATE 1/18/90

ROUTE #18

R.C. BARBOUR

WEATHER OVERCAST - WINDY

COUNTY SENECA

GEYMAN

TEMP. 38°

TOWNSHIP LOUPOON

SECTION 16

T 2 N R 13 E


TYPE MONUMENT P.K. & WASHER

ON SURFACE - BELOW


LEFT - & PAV'T. - RIGHT 2.1 ft

TO EDGE PAVEMENT

S.L.M.

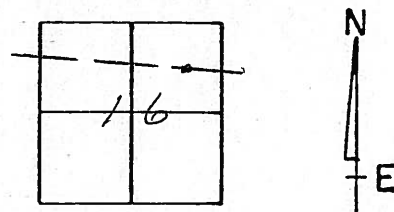

P.O.T. SURVEY
190 + 00.62
P.K. & WASHER ATOP
MINE SPIKE

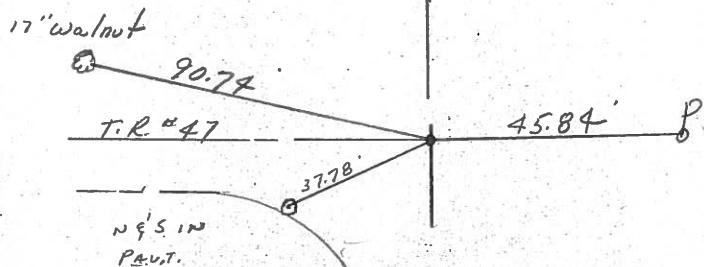

PERSONNEL	TITLE	PERSONNEL	TITLE	COUNTY	DATE	WEATHER	TEMP.
Schneider				Seneca	10-16-68	Fair - Windy	80°
Messer				S. R. 18			
Barbour				SEC. Fosteria to Bascom			
Peets							


DESCRIPTION *Ties for Control Points*

LEFT

CENTER LINE

RIGHT

JOB NO.

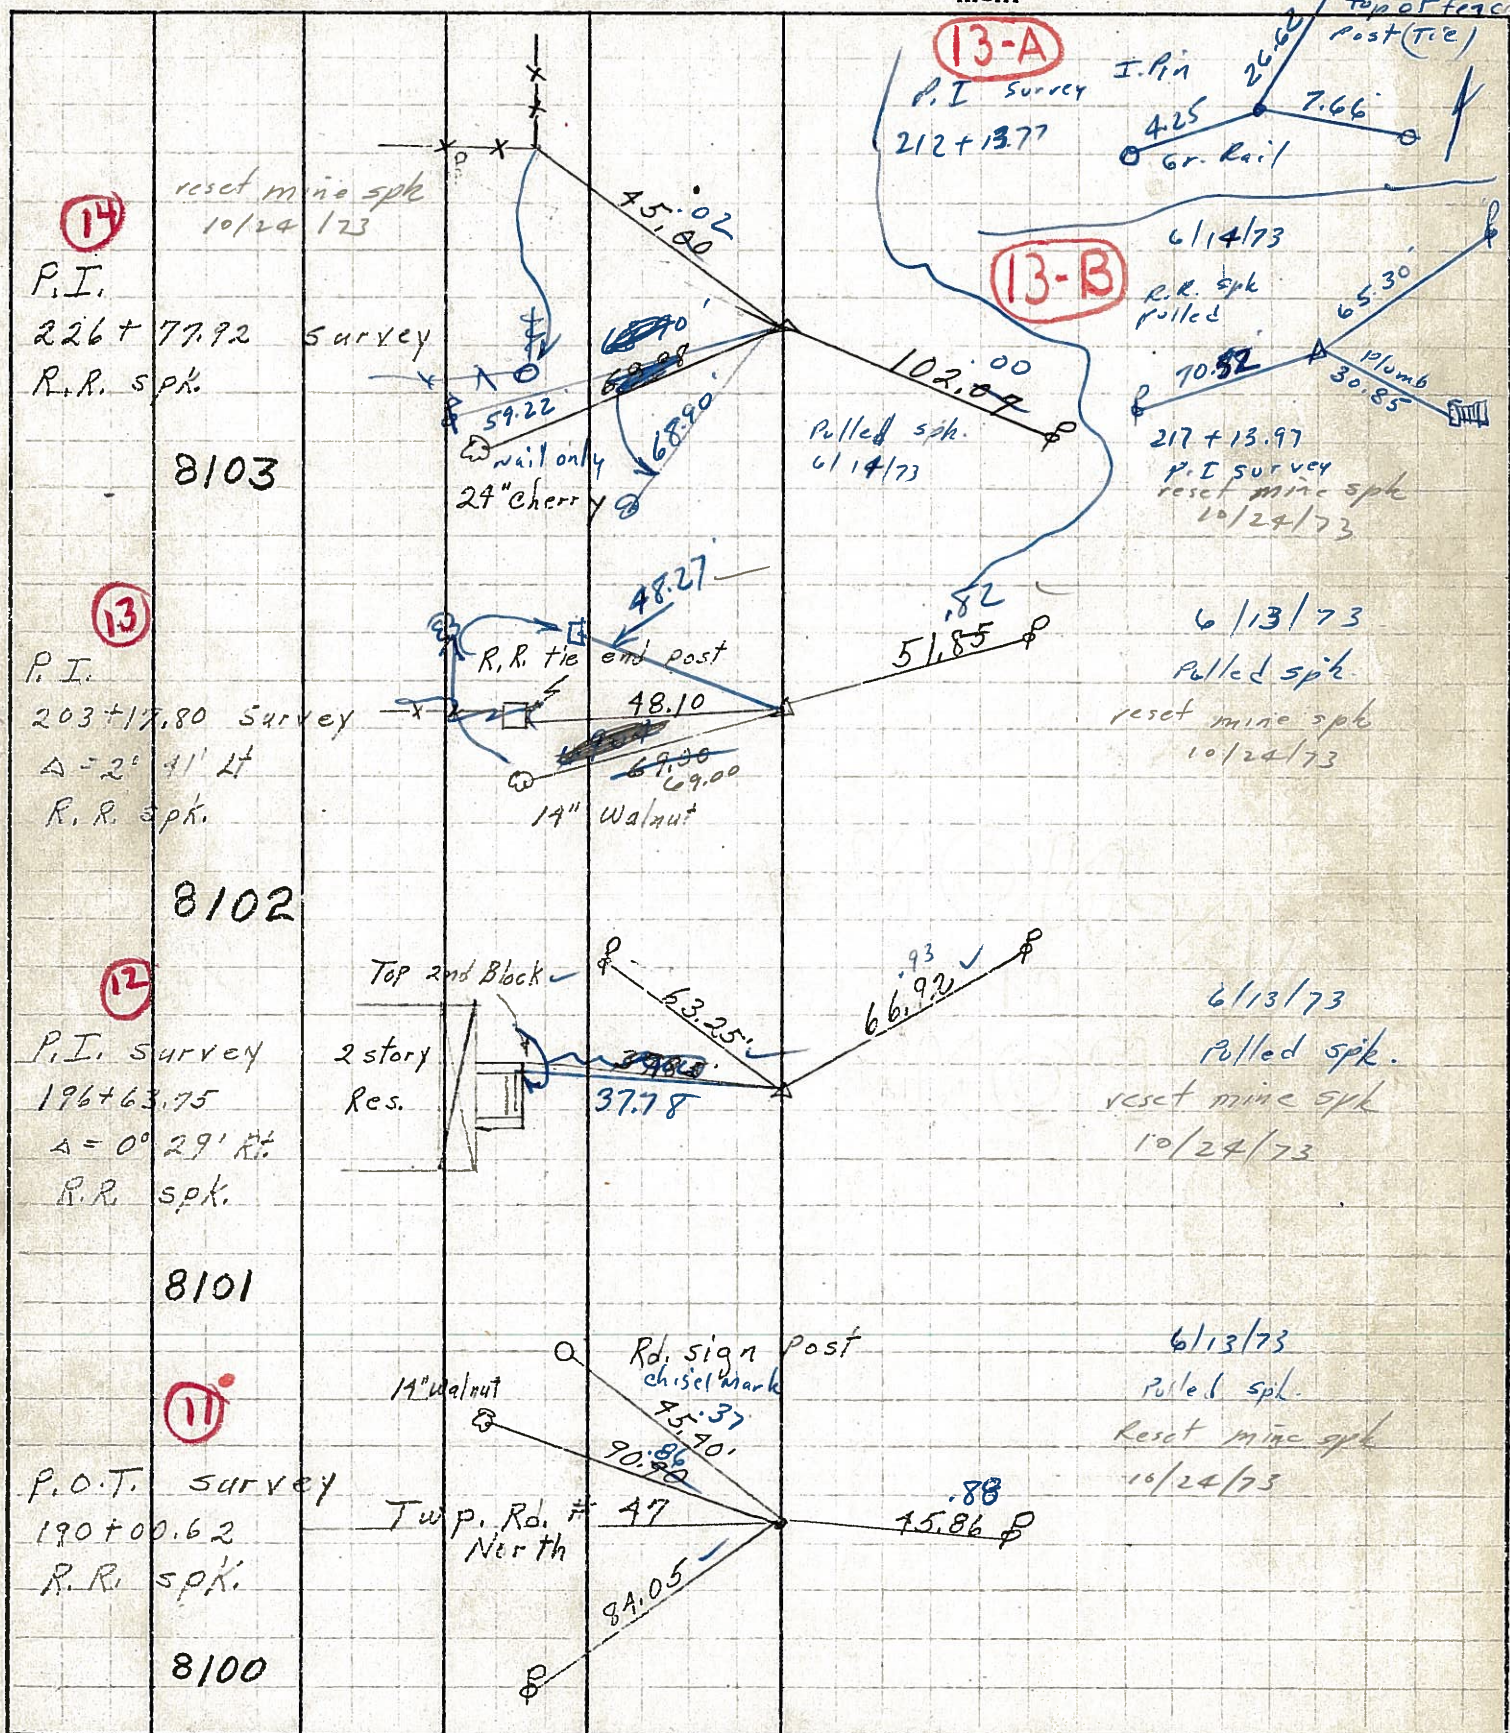

PERSONNEL TITLE PERSONNEL TITLE

Schneider

COUNTY Seneca

DATE 10-16-68

Mosser

S. R. 18

WEATHER Fair-windy

Barbour

SEC. Fostoria to Bascom

TEMP. 80°

Potts

DESCRIPTION Ties for Control Points

JOB NO.

LEFT

CENTER LINE

RIGHT


14

P.I.

226+77.92 Survey

R.R. spk.

8103

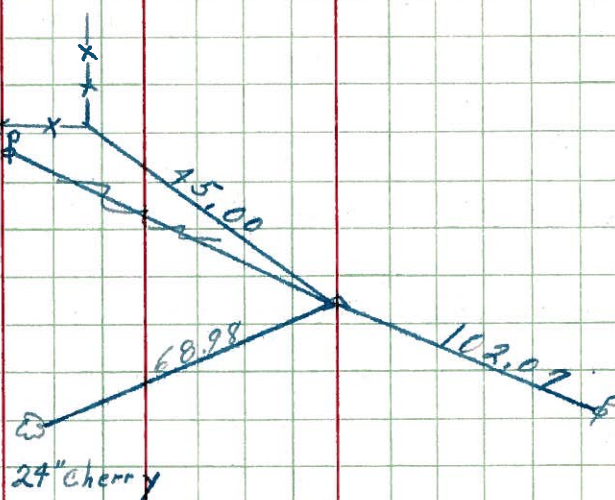

13


P.I.

203+17.80 Survey

 $\Delta = 2^\circ 41' \text{ Lt}$

R.R. spk.

8102

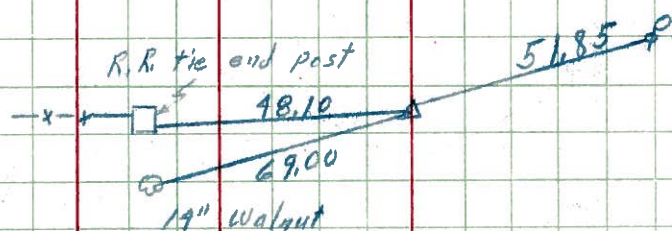

12


P.I. Survey

196+63.75

 $\Delta = 0^\circ 29' \text{ Rt}$

R.R. spk.

8101

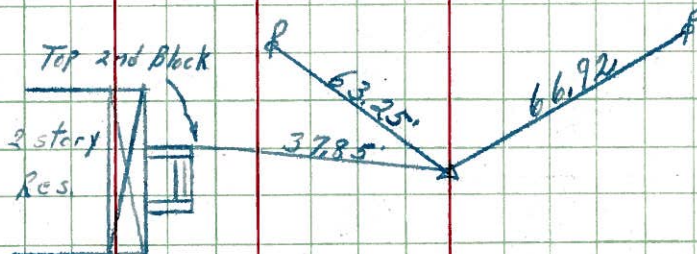


11

P.C.T. Survey

190+00.62

R.R. spk.

8100

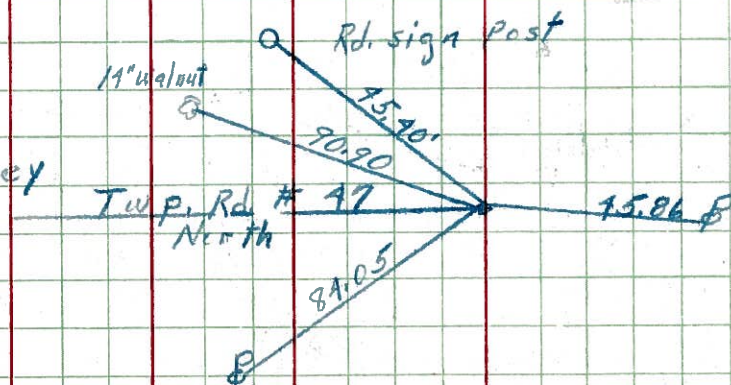

PERSONNEL TITLE PERSONNEL TITLE

Schneider

Mosser

Barbour

Potts

COUNTY Seneca

DATE 10-16-68

S. R. 18

WEATHER Fair-windy

SEC. Fostoria to Bascom

TEMP. 80°


DESCRIPTION Ties for Control Points

JOB NO.

LEFT

CENTER LINE

RIGHT

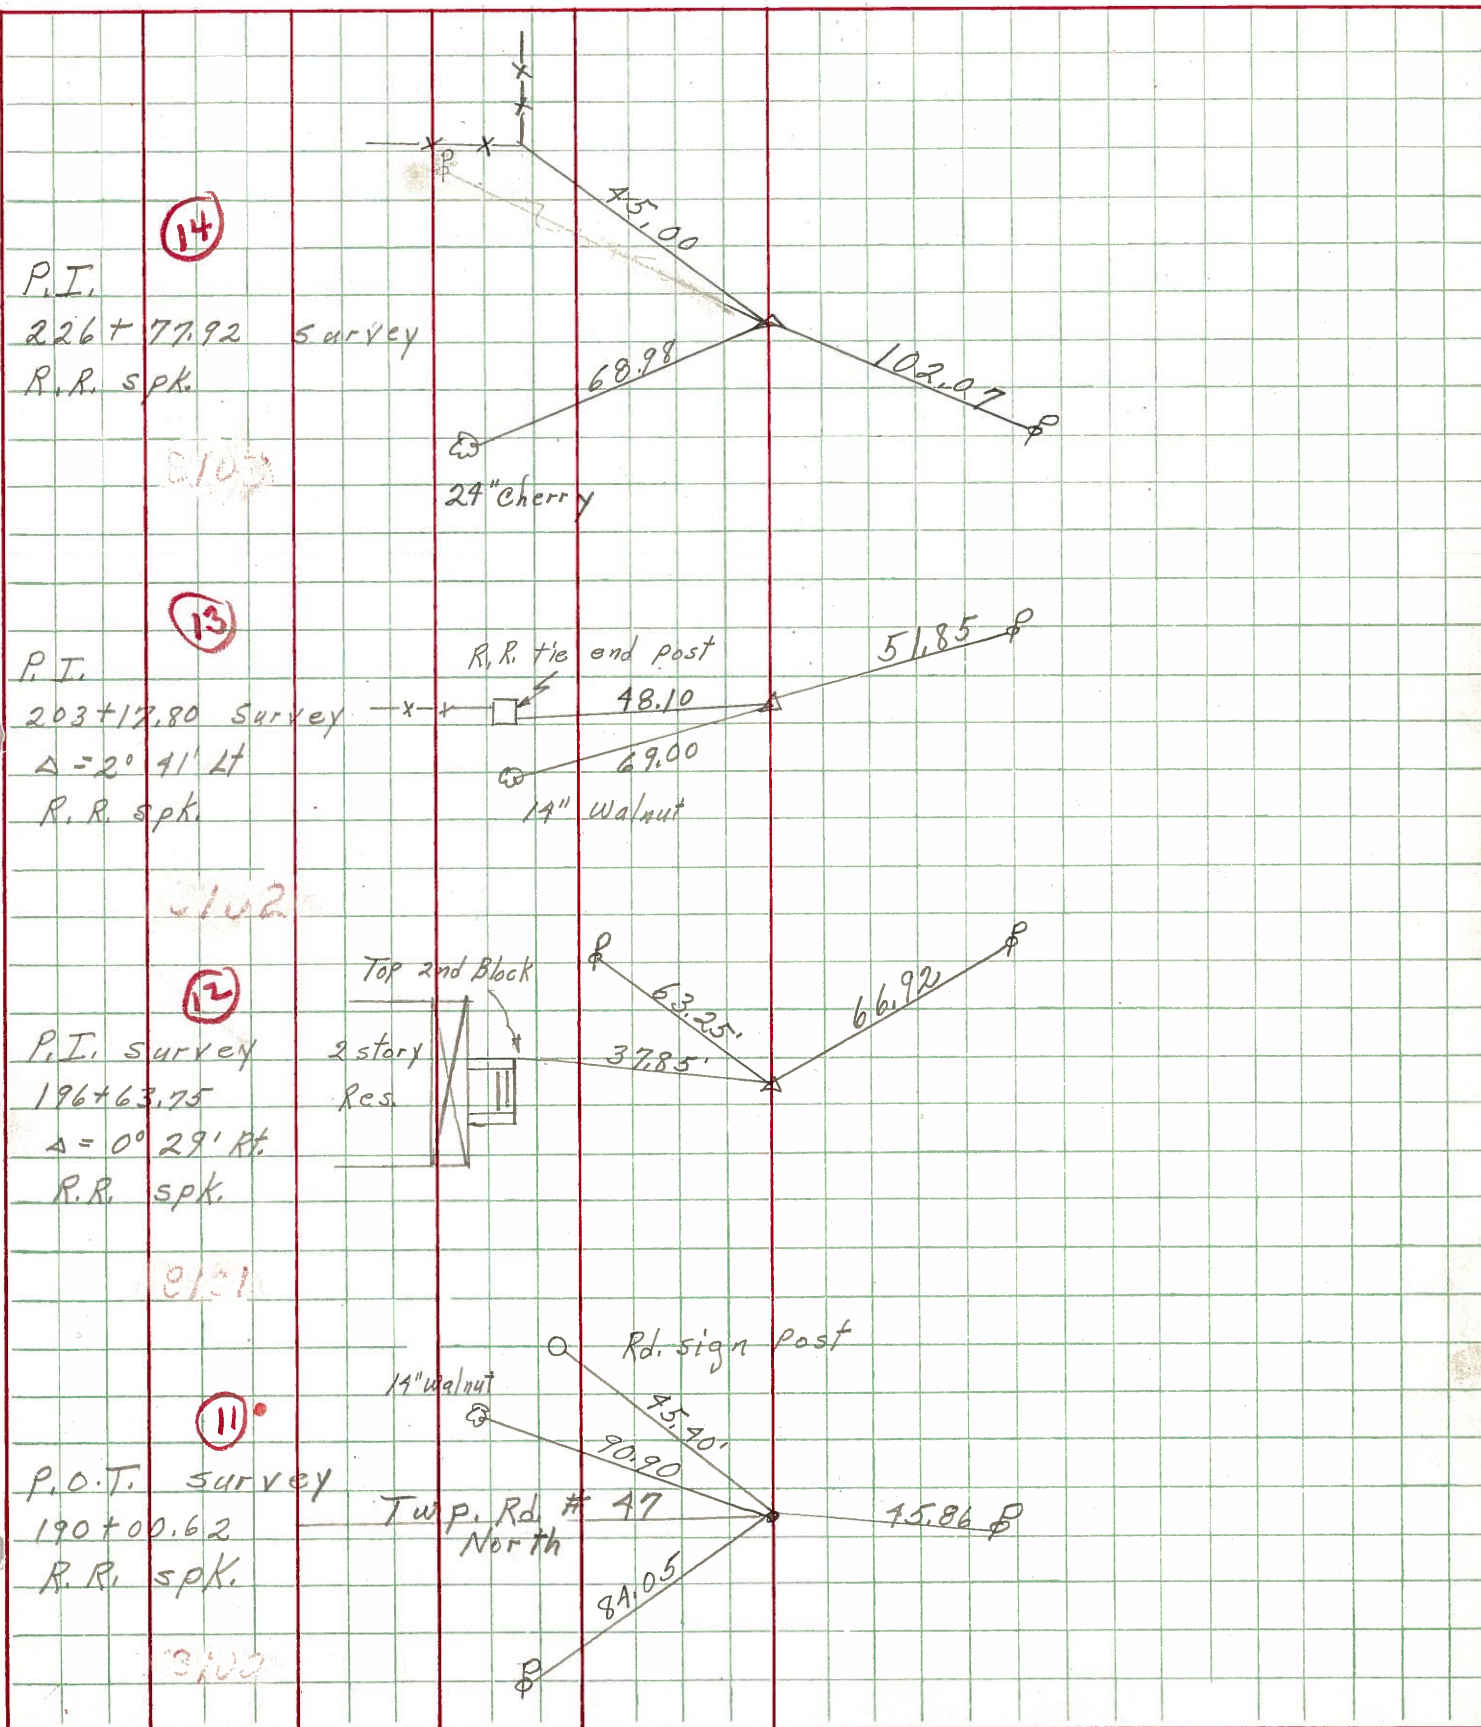

COUNTY Sonoma

DATE Dec. 4, '58

454

TITLE

PERSONNEL

TITLE

Genius

人面虎心

S. R. #18 Fosteria - Roscom Rd. WEATHER Cloudy

WEATHER Cloudy

Lee master

7044 K.

SEC. Sen-18-1179-860 TEMP. 30°

DESCRIPTION

Control Point ties - 2 Survey Const

JOB NO.

LEFT

CENTER LINE Survey

RIGHT