

O.D.O.T. DISTRICT 2 SURVEY OFFICE (USE ONLY)

PERSONNEL

REFERENCE NO. 12

SHEET OF

NOTES MILLER

DATE 8/5/24

ROUTE SR 18

H.C. NIESE

WEATHER SUNNY

COUNTY SENECA

R.C. PRESTON-COLVIN

TEMP. 80°

TOWNSHIP LOUDON

ASTON

SECTION 16

DWG BY BARRIERE

PID 92371

T 2 N R 13 E

TYPE MONUMENT MAG NAIL/WASHER

ON SURFACE - BELOW 2" BELOW

OFFSET $\odot$ PAVEMENT 2.2' LT LT : RT

 TO EDGE PAVEMENT

STATION: 196+63.75

HORIZ.DATUM: NAD83 (2011)


GEOID: 18

GRID: NORTHING: 535931.200

EASTING: 1730203.225

LDP: NORTHING:

EASTING:

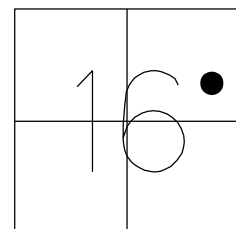

RECORD: P.O.T.
STA. 196+63.75
FD P.K./SHINER
ATOP MINE SPIKE
FD P.K.SHANK
7/10/97, TMR
SET P.K./WASHER
11/6/97, MB
FD P.K./WASHER
REF12
4/22/19, JFO
SET MAG/WASHER
8/19/19, JFO
FD MAG/WASHER
9/1/21, DSA
2/15/22, JFO
2/10/23, JMR
10/6/23, DSA
SET MAG/WASHER
8/5/24, TDN



2 STORY
RES. #
10141

TOP 2ND BLOCKS
OUTER CORNERS

37.94'
37.89'

64.61'
FD
SHI

$\odot$ SR 18

106.83'

62.75'

FD
SHI

TOP COR. BLOCK

FRUTH WETLAND

O.D.O.T. DISTRICT 2 SURVEY OFFICE (USE ONLY)

PERSONNEL

REFERENCE NO. 12

SHEET 7 OF 48

NOTES AUBLE

DATE 9/1/21

ROUTE SR 18

H.C. NIESE

WEATHER WINDY

COUNTY SENECA

R.C. AUBLE

TEMP. 72°

TOWNSHIP LOUDON

DWG BY RHOADES

PID PVTRAIN

SECTION 16

T 2 N R 13 E

TYPE MONUMENT MAG/WASHER

ON SURFACE - ~~BELOW~~ ON

OFFSET CL PAVEMENT 3.2' LT : ~~RT~~

9.5' TO LT EDGE PAVEMENT


STATION: 196+63.75

HORZ.DATUM: NAD83 2011


GEOID: NAVD88 2012A

GRID: NORTHING: 535931.233

EASTING: 1730203.188

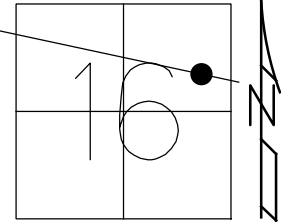

RECORD: P.O.T.
STA.196+63.75
FD P.K./SHINER
ATOP MINE SPIKE
FD P.K.SHANK
7/10/97, TMR
SET P.K./WASHER
11/6/97, MB
FD P.K./WASHER
REF12
4/22/19, JFO
SET MAG/WASHER
8/19/19, JFO
FD MAG/WASHER
9/1/21, DSA
2/15/22, JFO
2/10/23, JMR
10/6/23, DSA

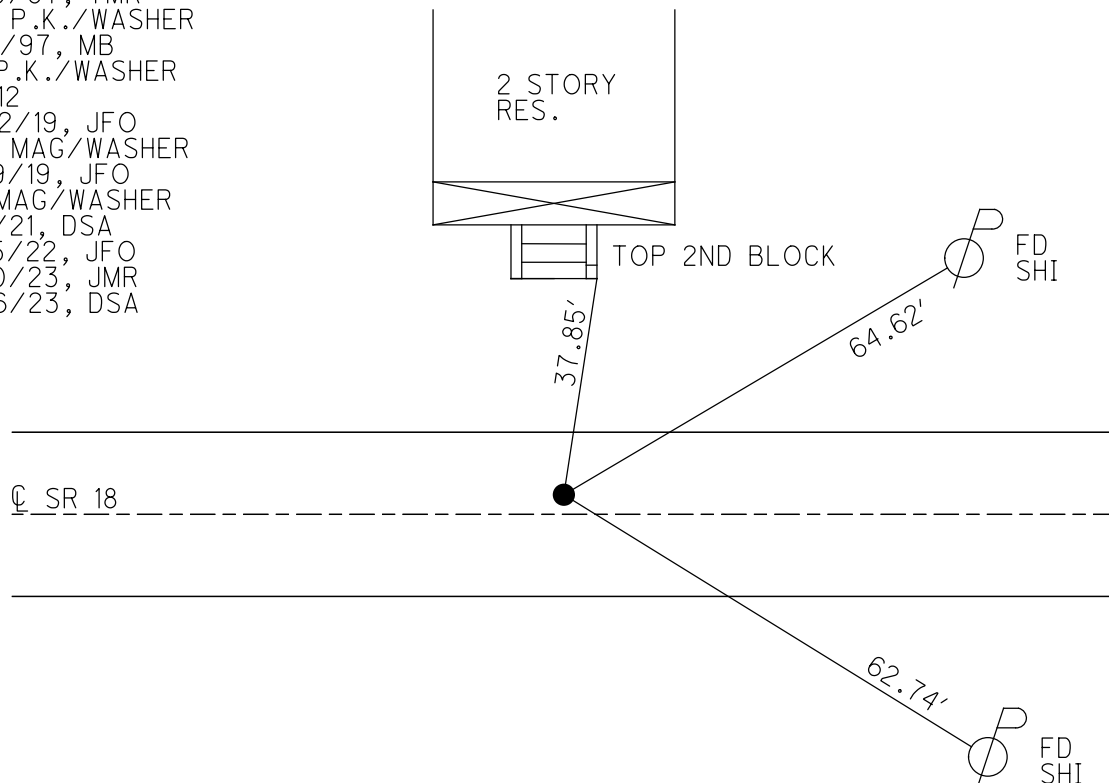

O.D.O.T. DISTRICT 2 SURVEY OFFICE (USE ONLY)

PERSONNEL

REFERENCE NO. 12

SHEET 7 OF 48

NOTES AUBLE

DATE 9/1/21

ROUTE SR 18

H.C. NIESE

WEATHER WINDY

COUNTY SENECA

R.C. AUBLE

TEMP. 72°

TOWNSHIP LOUDON

DWG BY RHOADES

PID PVTRAIN

SECTION 16

T 2 N R 13 E

TYPE MONUMENT MAG/WASHER

ON SURFACE - ~~BELOW~~ ON

OFFSET Q PAVEMENT 3.2' LT : ~~RT~~

9.5' TO LT EDGE PAVEMENT


STATION: 196+63.75

HORZ.DATUM: NAD83(2011)


GEOID: 2012A

GRID: NORTHING: 535931.233

EASTING: 1730203.188

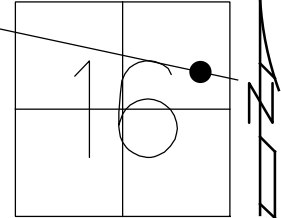

RECORD: P.O.T.
STA.196+63.75
FD P.K./SHINER
ATOP MINE SPIKE
FD P.K.SHANK
7/10/97, TMR
SET P.K./WASHER
11/6/97, MB
FD P.K./WASHER
REF12
4/22/19, JFO
SET MAG/WASHER
8/19/19, JFO
FD MAG/WASHER
9/1/21, DSA
2/15/22, JFO
2/10/23, JMR

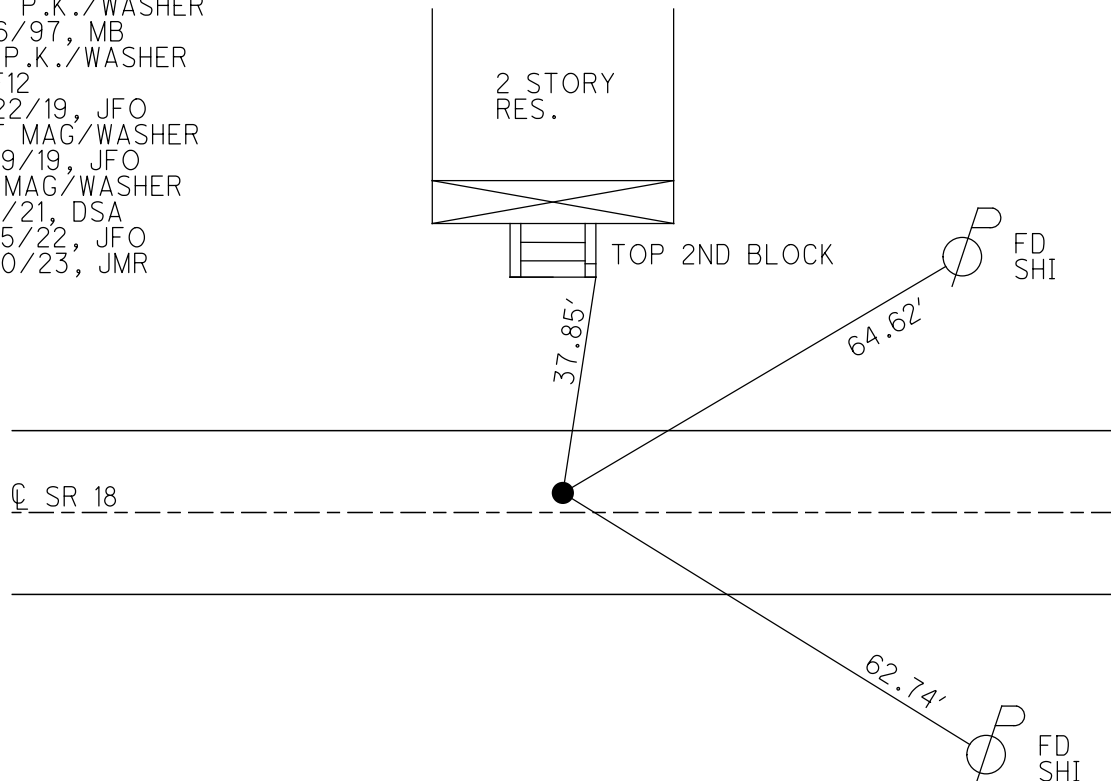

O.D.O.T. DISTRICT 2 SURVEY OFFICE (USE ONLY)

PERSONNEL

REFERENCE NO. 12

SHEET 7 OF 48

NOTES AUBLE

DATE 9/1/21

ROUTE SR 18

H.C. NIESE

WEATHER WINDY

COUNTY SENECA

R.C. AUBLE

TEMP. 72°

TOWNSHIP LOUDON

SECTION 16

DWG BY RHOADES

PID PVTRAIN

T 2 N R 13 E

TYPE MONUMENT MAG/WASHER

ON SURFACE - ~~BELOW~~ ON

OFFSET CL PAVEMENT 2.2' LT : ~~RT~~

9.5' TO LT EDGE PAVEMENT


STATION: 196+63.75

HORIZ.DATUM: NAD83(2011)


GEOID: 2012A

GRID: NORTHING: 535931.233

EASTING: 1730203.188

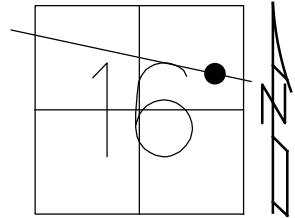

RECORD: P.O.T.
STA. 196+63.75
FD P.K./SHINER
ATOP MINE SPIKE
FD P.K.SHANK
7/10/97, TMR
SET P.K./WASHER
11/6/97, MB
FD P.K./WASHER
REF12
4/22/19, JFO
SET MAG/WASHER
8/19/19, JFO
FD MAG/WASHER
9/1/21, DSA
2/15/22, JFO

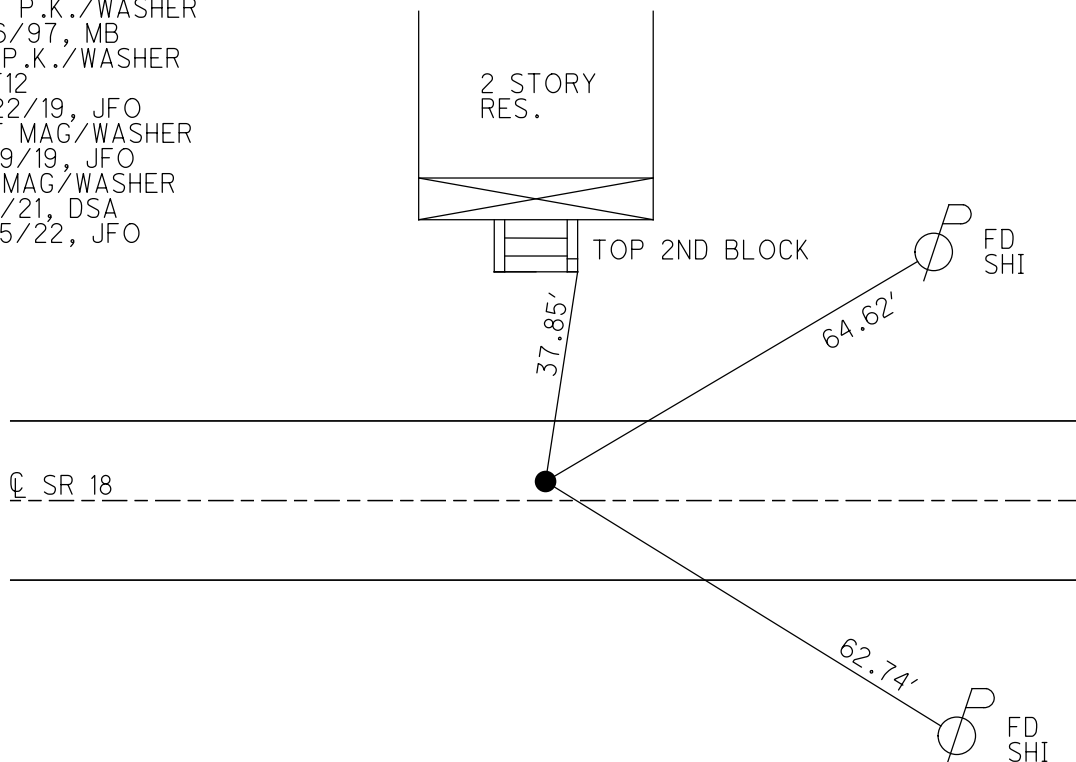

O.D.O.T. DISTRICT 2 SURVEY OFFICE (USE ONLY)

PERSONNEL

REFERENCE NO. 12

SHEET 7 OF 48

NOTES RHOADES

DATE 8/19/19

ROUTE SR 18

H.C. O'DONNELL

WEATHER SUNNY

COUNTY SENECA

R.C. AUBLE

TEMP. 70°

TOWNSHIP LOUDON

DWG BY NIESE

PID NO PID

SECTION 16

T 2 N R 13 E

TYPE MONUMENT MAG/WASHER

ON SURFACE - ~~BELOW~~ ON

OFFSET CL PAVEMENT 2.2' LT : ~~RT~~

9.5' TO LT EDGE PAVEMENT


STATION: 196+63.75

HORZ.DATUM: NAD83(2011)


GEOID: 2012A

GRID: NORTHING: 535931.233

EASTING: 1730203.188

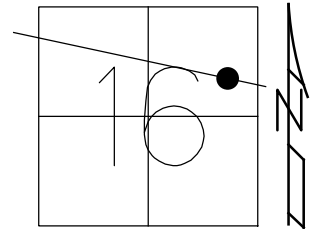

RECORD: P.O.T.
STA. 196+63.75
FD P.K./SHINER
ATOP MINE SPIKE
FD P.K.SHANK
7/10/97, TMR
SET P.K./WASHER
11/6/97, MB
FD P.K./WASHER
REF12
4/22/19, JFO
SET MAG/WASHER
8/19/19, JFO

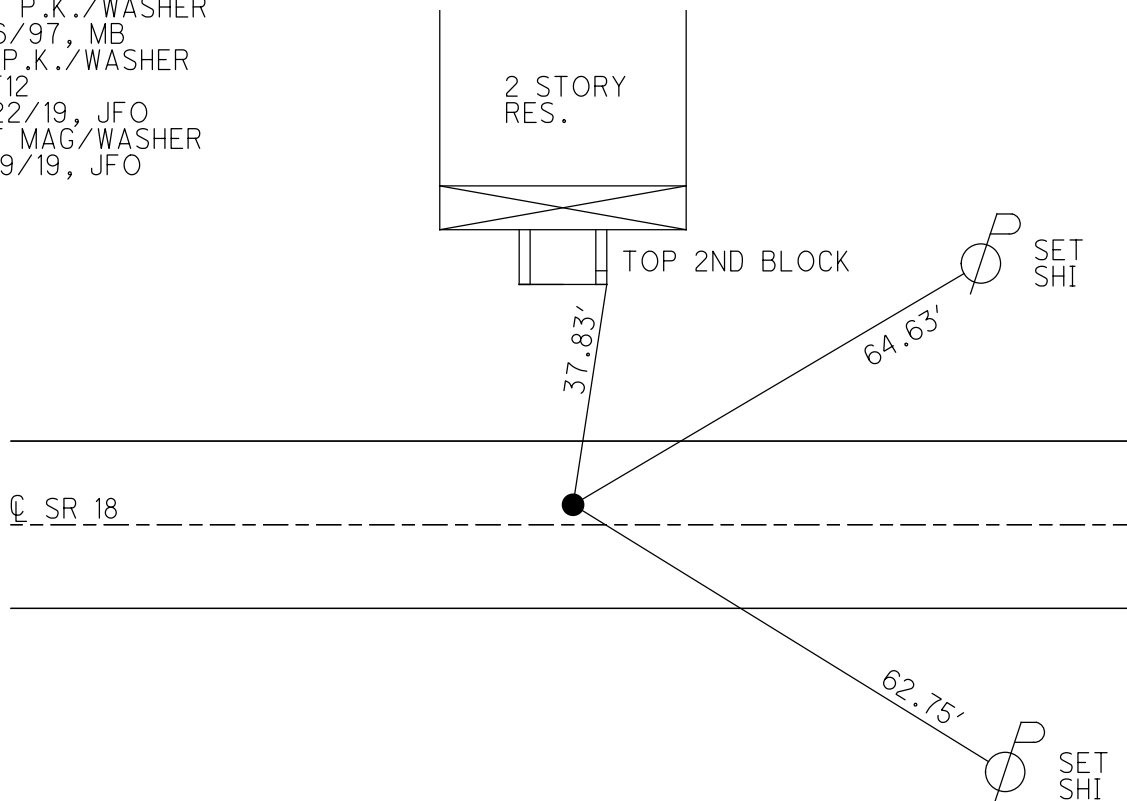

O.D.O.T. DISTRICT 2 SURVEY OFFICE

PERSONNEL

REFERENCE NO. 12

SHEET 12 OF 22

NOTES Barnet

H.C. CANTERBURY

DATE 7-10-97

ROUTE 18

R.C. WEAVER

WEATHER SUNNY

COUNTY SENeca

17 ROUSE

TEMP. +7.5°

TOWNSHIP London

DRAWN BY ROUSE

SECTION 16

T2 N R 13 E


TYPE MONUMENT P.K. (SHANK FD.)

ON SURFACE - BELOW ON SURFACE

LEFT - CL PAV'T. - RIGHT 2.2'

9.5 TO LT EDGE PAVEMENT

S.L.M. 64390.7 SLK

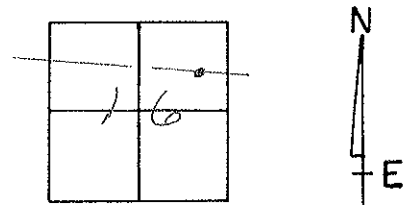


RESET P.K. WASHER
11-6-97
MB

P.O.T. SURVEY

196 + 63.75

P.K. & SHINER ATOP

LINE SPIKE

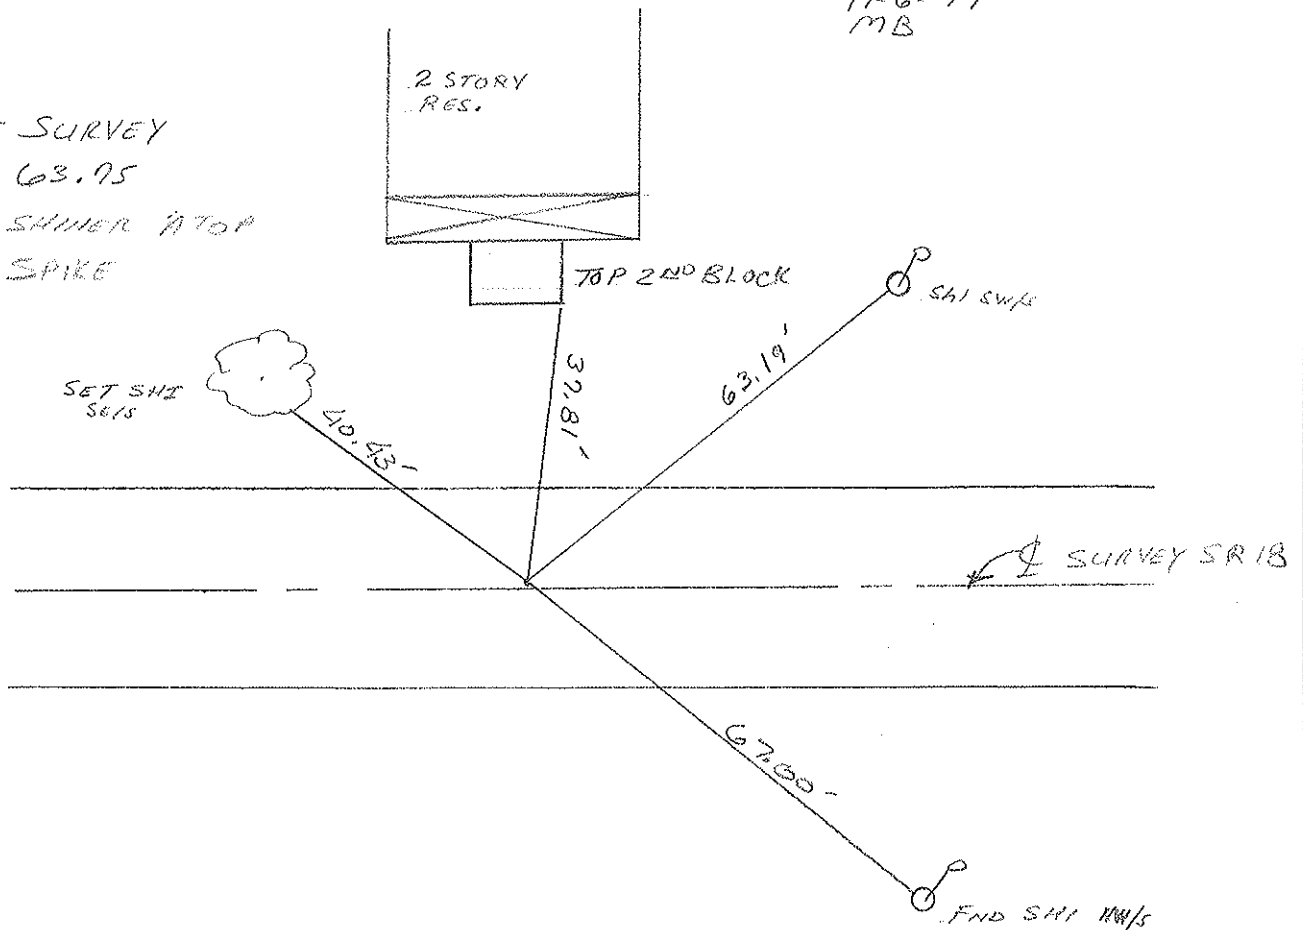

O.D.O.T. DISTRICT 2 SURVEY OFFICE

PERSONNEL

NOTES

H.C.

R.C.

REFERENCE NO. 12

DRAWN 11/19/90

DATE 11/12/87

WEATHER SUNNY

TEMP. 50°

SHEET 12 OF

ROUTE #18

COUNTY SENECA

TOWNSHIP LODGE

SECTION 16

T. 2 N. R. 13 E.


TYPE MONUMENT P.K. & Shiner

ON SURFACE - BELOW

LEFT- & PAV'T. - RIGHT 2.9' ±

TO EDGE PAVEMENT

S.L.M.

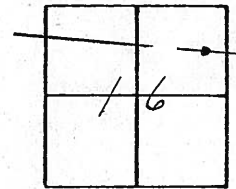

P.O.T. SURVEY
196 + 63.75
P.K. & SHINER ATOP
MINE SPIKE

2 story Res.

TOP 2ND BLOCK

63.22'

57.79'


S. 50° E. S.P. #187

66.94'

~~N~~

PERSONNEL	TITLE	PERSONNEL	TITLE	COUNTY	Seneca	DATE	10-16-68
Schneider				S. R.	18	WEATHER	Fair - Windy
Messer				SEC.	Fosteria to Bascom	TEMP.	80°
Barbour							
Potts							

DESCRIPTION *Ties for Control Points*

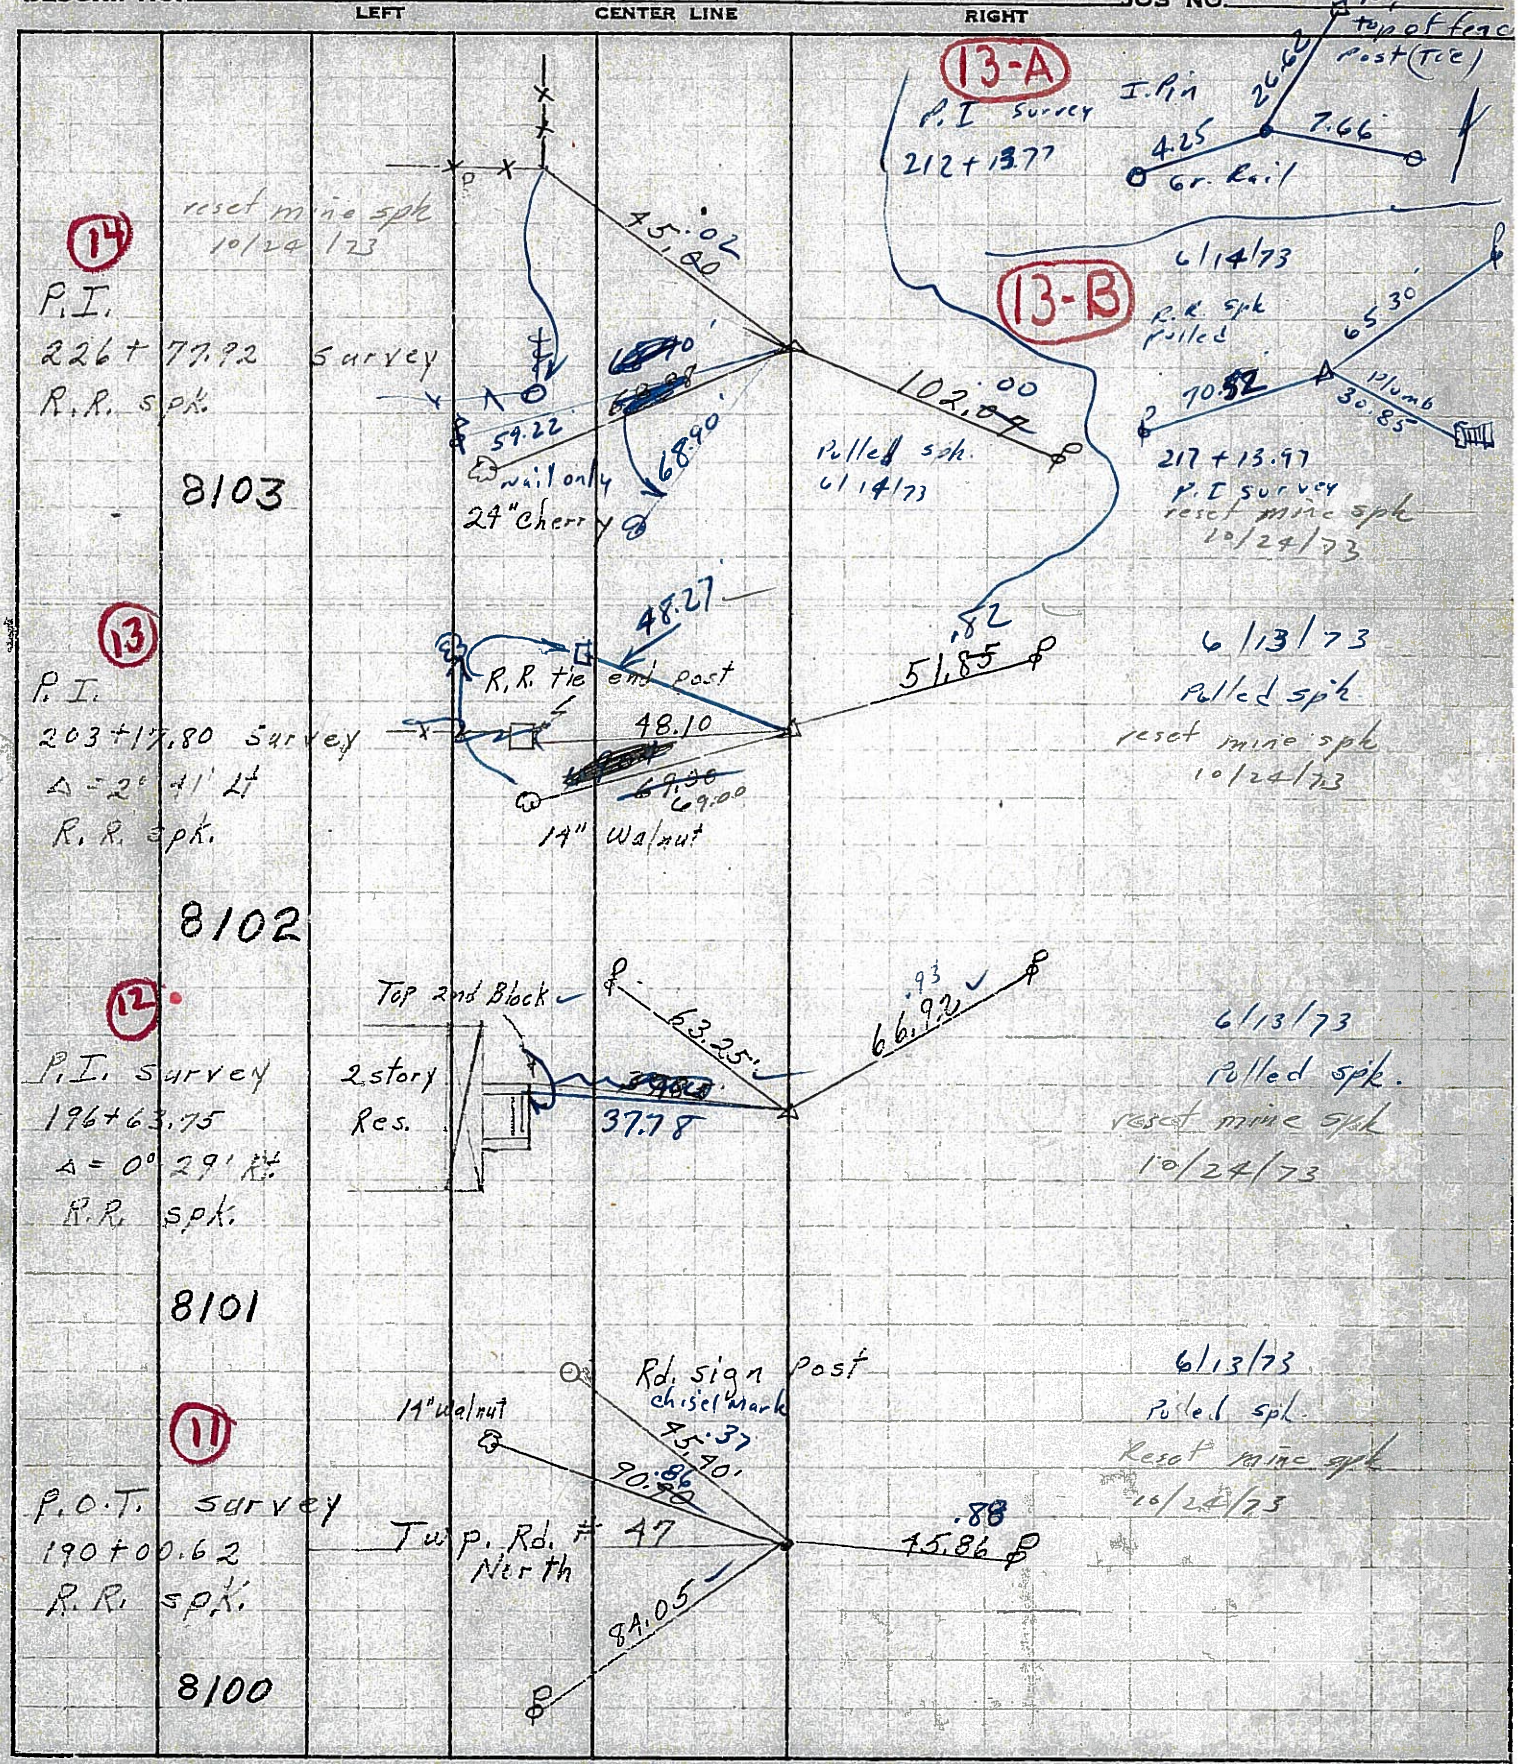

PERSONNEL TITLE PERSONNEL TITLE

COUNTY Seneca

DATE 10-12-68

Schneider

Mosser

Barbour

Potts

S. R. 18

WEATHER Fair-windy

SEC. Fostoria to Bascom

TEMP. 80°

DESCRIPTION Ties for Control Points

JOB NO.

LEFT

CENTER LINE

RIGHT

14

P.T.

226+77.92 Survey

R.R. spk.

8103

24" Cherry

13

P.T.

203+17.80 Survey

$\Delta = 2^\circ 41' L$

R.R. spk.

8102

R.R. tie end post

48.10

29.00

14" Walnut

12

P.T. Survey

196+63.75

$\Delta = 0^\circ 29' R$


R.R. spk.

8101

Top 2nd Block

2 story

Res.

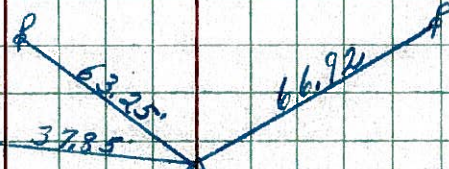


11

P.O.T. Survey

190+00.62

R.R. spk.

8100

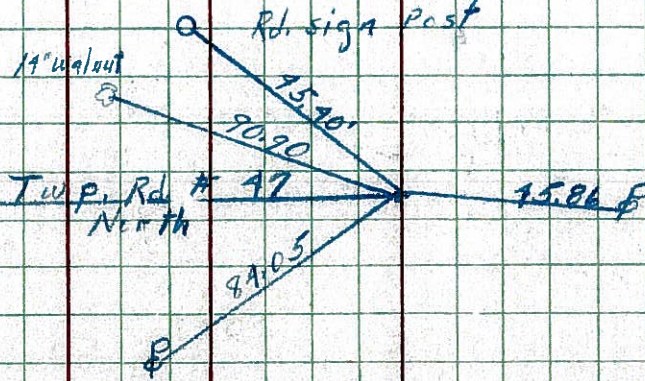

PERSONNEL TITLE PERSONNEL TITLE

Schneider

COUNTY Seneca

DATE 10-16-68

Mosser

S. R. 18

WEATHER Fair - windy

Barbour

SEC. Fostoria to Bascom

TEMP. 80°

Potts


DESCRIPTION Ties for Control Points

JOB NO.

LEFT

CENTER LINE

RIGHT

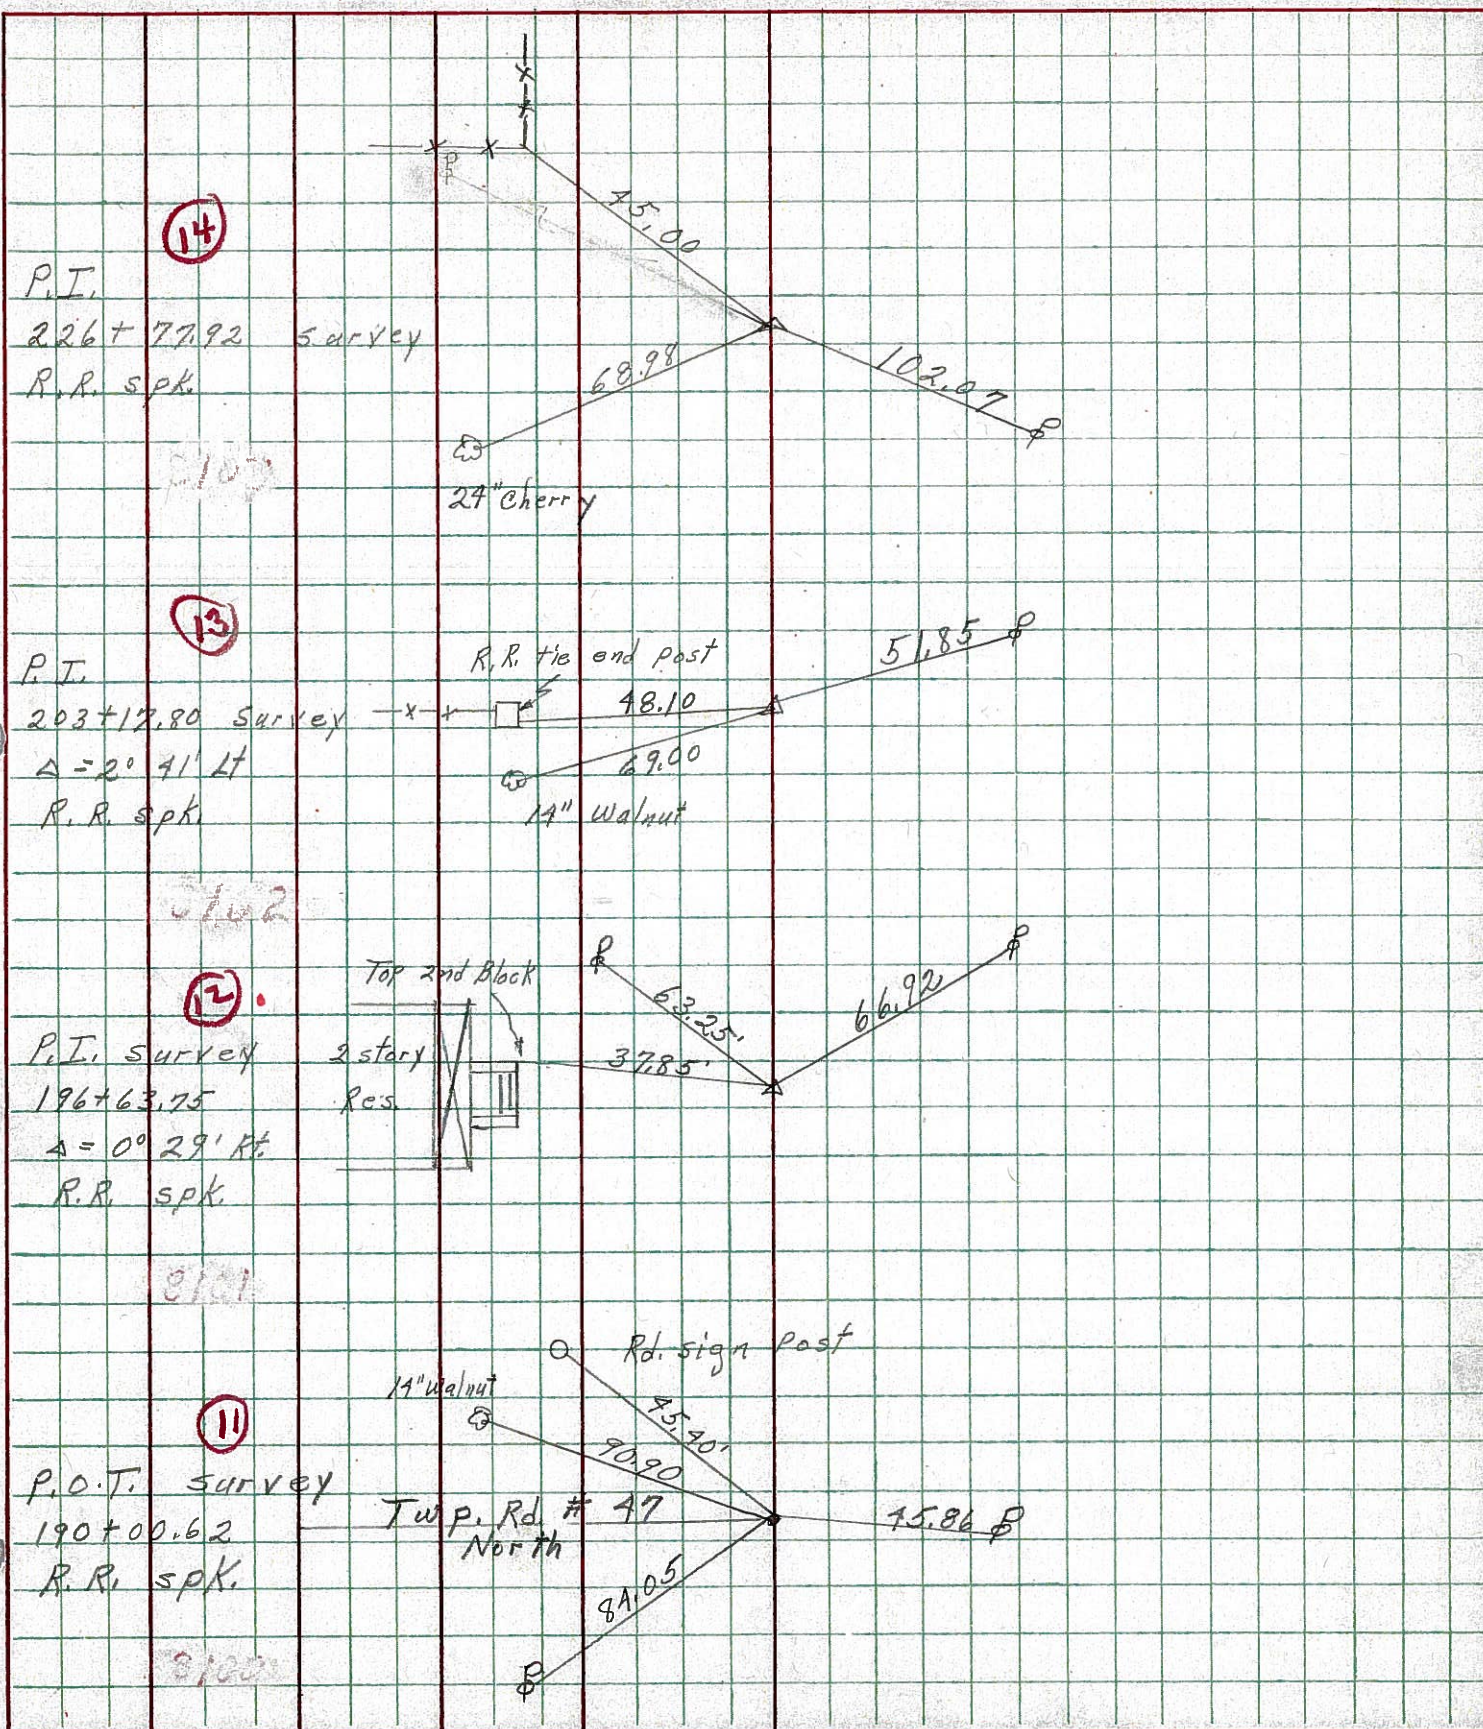

PERSONNEL	TITLE	PERSONNEL	TITLE
1	1	1	1
2	2	2	2
3	3	3	3
100	100	100	100

COUNTY Sonoma

DATE Dec. 4 '58

454

TITLE

PERSONNEL

TITLE

Cro 7/77

4845

S. R. #18 Foster's - Boscom Rd. WEATHER Cloudy

Leemaster

70A-4

SEC. Sen-18-1179-860 TEMP. 30°

DESCRIPTION

Control Point Ties - 4 Survey + Const

JOB NO.

LEFT

CENTER LINE *Survey*

RIGHT

JOB NO.

P.O.T. $200 + 60.31 \text{ Const.}$

P.O.T. 2m + 1.31 Surucu

P.K. Nail & Shi.

P.A. Vail & Son

"x" Intersections of
Q Survey & Const.

"X" Intersection of
Const. & Survey

Found R.R. on top
10/29/65

Top and Block

9-1-59 R.R. 501/6.

P.O.T. $196 + 63.75$ Plan Survey =

P.I. 196+63.75 Survey

$$A = 0^\circ - 29' RT.$$

P. R. Spk.

P.O.T. 190+00.62 Survey

£ Typ. Pd.

A.K. Nait 7.5 mi

P.O.T. 181 + 40.63

AK Nail + Shi'

"X" Intersection of Survey & Const.

P.O.T. 181 + 40.63

15. Nail + Shi.

"X" Intersection of
 & Const. & Survey

Const Tang

P.O.T. 176 + 58.00 Sur

R. R. Spk.

N. 4 Str. in 7th Fence Post
From East Cor. Post. S. 1/2 S.