

O.D.O.T. DISTRICT 2 SURVEY OFFICE (USE ONLY)

PERSONNEL

REFERENCE NO. A13

SHEET OF

NOTES MILLER

DATE 8/5/24

ROUTE SR 18

H.C. NIESE

WEATHER SUNNY

COUNTY SENECA

R.C. PRESTON-COLVIN

TEMP. 80°

TOWNSHIP LOUDON

ASTON

SECTION 15

DWG BY BARRIERE

PID 92371

T 2 N R 13 E

TYPE MONUMENT 1" IPIN

ON SURFACE - BELOW ON

OFFSET $\varnothing$ PAVEMENT 21.3' LT LT : RT

 TO EDGE PAVEMENT

STATION: 212+13.77

HORIZ.DATUM: NAD83 (2011)



GEOID: 18

GRID: NORTHING: 535852.983

EASTING: 1731750.364


LDP: NORTHING:

EASTING:

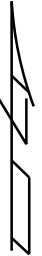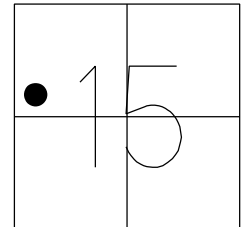

RECORD: P.I.
STA. 212+13.77
 $\Delta = 07^\circ 56' 00''$ RT
D.N.F.
4/22/19, JFO
FD 1" IPIN
4" DOWN
REFA13
9/21/20, TDN
FD 1" IPIN
NEWREF13A
8/5/24, TDN

FD SHI
6" HAWTHORN

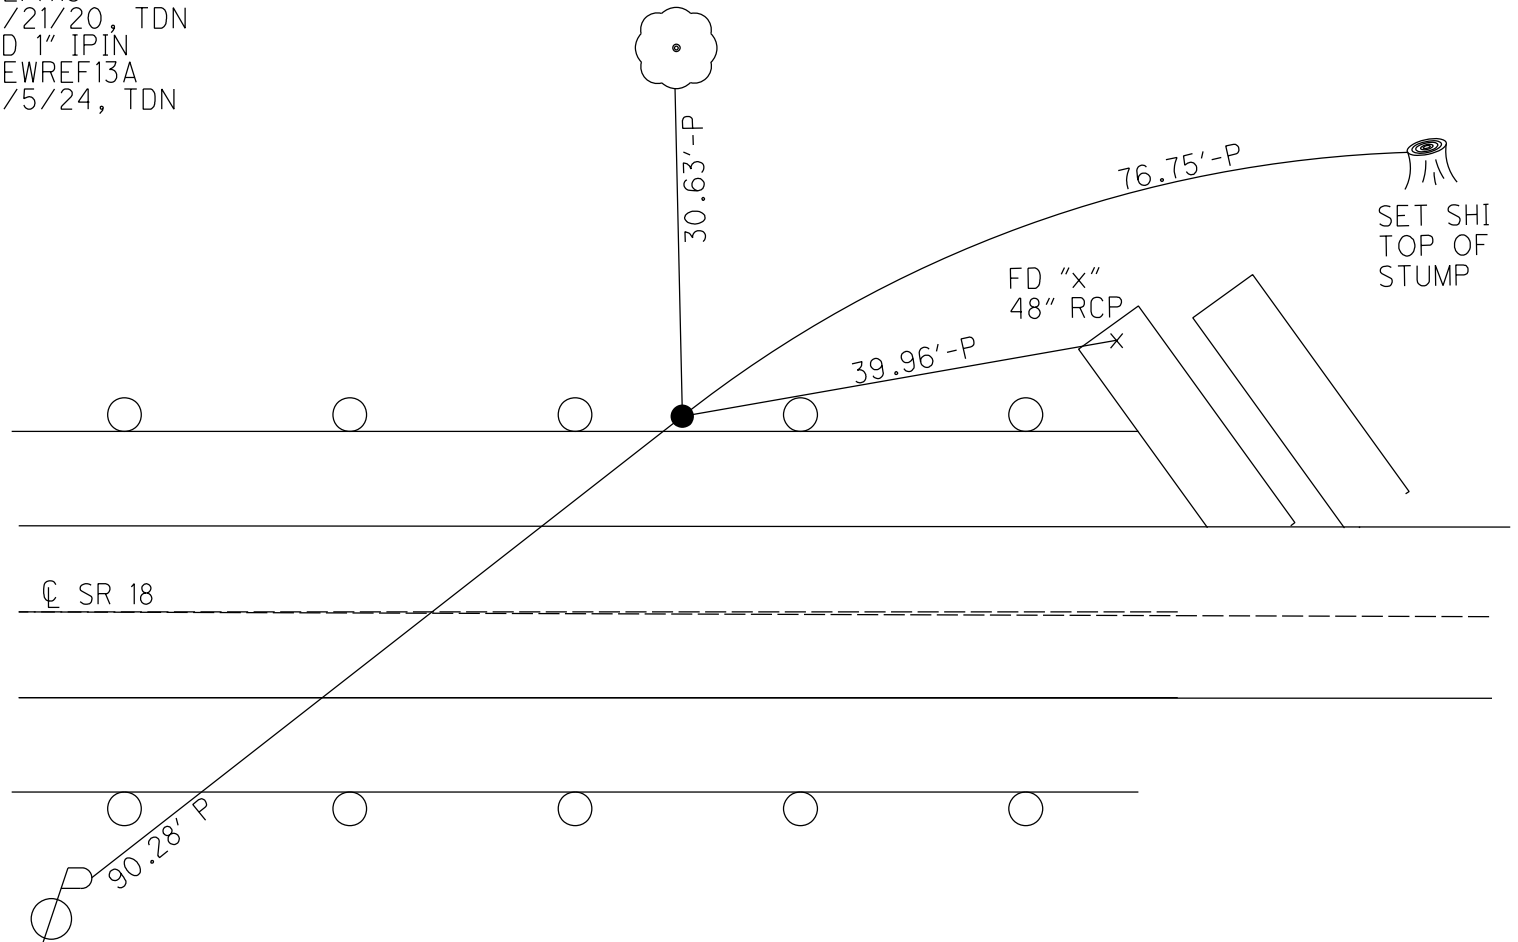

O.D.O.T. DISTRICT 2 SURVEY OFFICE (USE ONLY)

PERSONNEL

REFERENCE NO. 13 A

SHEET 9 OF 48

NOTES BARNHISEL

DATE 7/11/97

ROUTE SR 18

H.C. CANTERBURY

WEATHER SUNNY

COUNTY SENECA

R.C. WEAVER

TEMP. 75°

TOWNSHIP LOUDON

ROUSOS

SECTION 15

DWG BY NIESE

PID NO PID

T 2 N R 13 E

TYPE MONUMENT IPIN

ON SURFACE - ~~BELOW~~ ON

OFFSET CL PAVEMENT 21.3' LT : ~~RT~~

9.7' TO LT EDGE PAVEMENT


STATION: 212+13.77

HORZ.DATUM: -

GEOID: -


GRID: NORTHING: -

EASTING: -

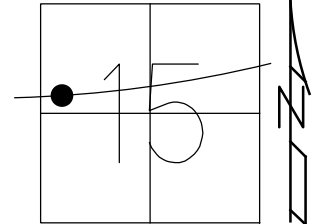

RECORD: P.I.
STA. 212+13.77
 $\Delta = 07^\circ 56' 00''$ RT
D.N.F.
4/22/19, JFO

FD SHI'S
GR POSTS

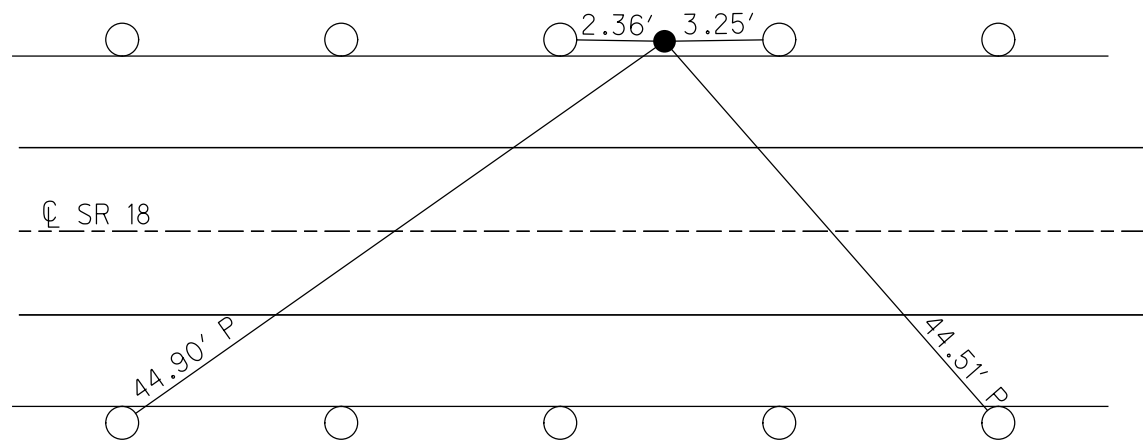

O.D.O.T. DISTRICT 2 SURVEY OFFICE

PERSONNEL

REFERENCE NO. 13-A

SHEET 14 OF 22

NOTES BARNHISEL

H.C. CANTERBURY

R.C. WEAVER

Rousos

Drawn By Rousos

DATE 7-11-97

WEATHER SUNNY

TEMP. +75°

ROUTE 18

COUNTY SENECA

TOWNSHIP London

SECTION 15

T 2 N R 13 E


TYPE MONUMENT I PIN

ON SURFACE - ~~BELOW~~ ON SURFACE

LEFT - ~~CL~~ PAV'T. - ~~RIGHT~~ 21.3'

9.7 TO Lt EDGE PAVEMENT


S.L.M. 6 x 842.4 SLK

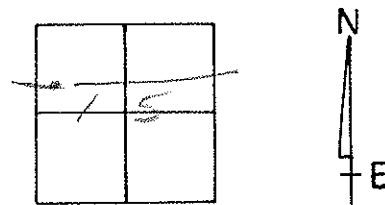

P.I. SURVEY

212 + 13.77

$\Delta = 07^{\circ} 56' 00''$ Rt

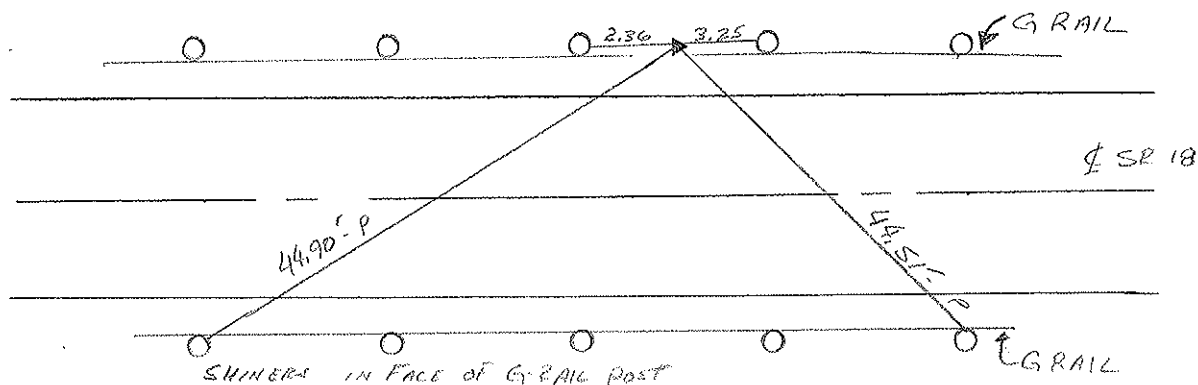

O.D.O.T. DISTRICT 2 SURVEY OFFICE

PERSONNEL

NOTES CRONIN (DRAW)

H.C. RIPPLE

R.C. BARBOUR & MEAS

GEYMAN

REFERENCE NO. 14

DRAWN 1/19/90

DATE 11/12/87

WEATHER SUNNY

TEMP. 50°

SHEET 14 OF

ROUTE #18

COUNTY SENECA

TOWNSHIP LOUPOW

SECTION 15

T 2 N R 13 E

TYPE MONUMENT E. PIN


ON SURFACE - BELOW

LEFT - & PAV'T. - RIGHT 20' ±

TO EDGE PAVEMENT

S.L.M.

13-A

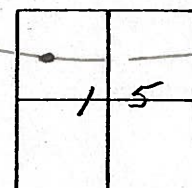

P.I. SURVEY

212 ± 13.77

A = 07° 56' 00" R.L.

Top fence post

26.62


500 S.R. * 187

7.66
42.5
G.E. RAIL

N
E

PERSONNEL	TITLE	PERSONNEL	TITLE	COUNTY	Seneca	DATE	10-16-68
Schneider				S. R.	18	WEATHER	Fair - windy
Messer				SEC.	Fosteria to Bascom	TEMP.	80°
Barbour							
Potts							

DESCRIPTION Ties for Control Points

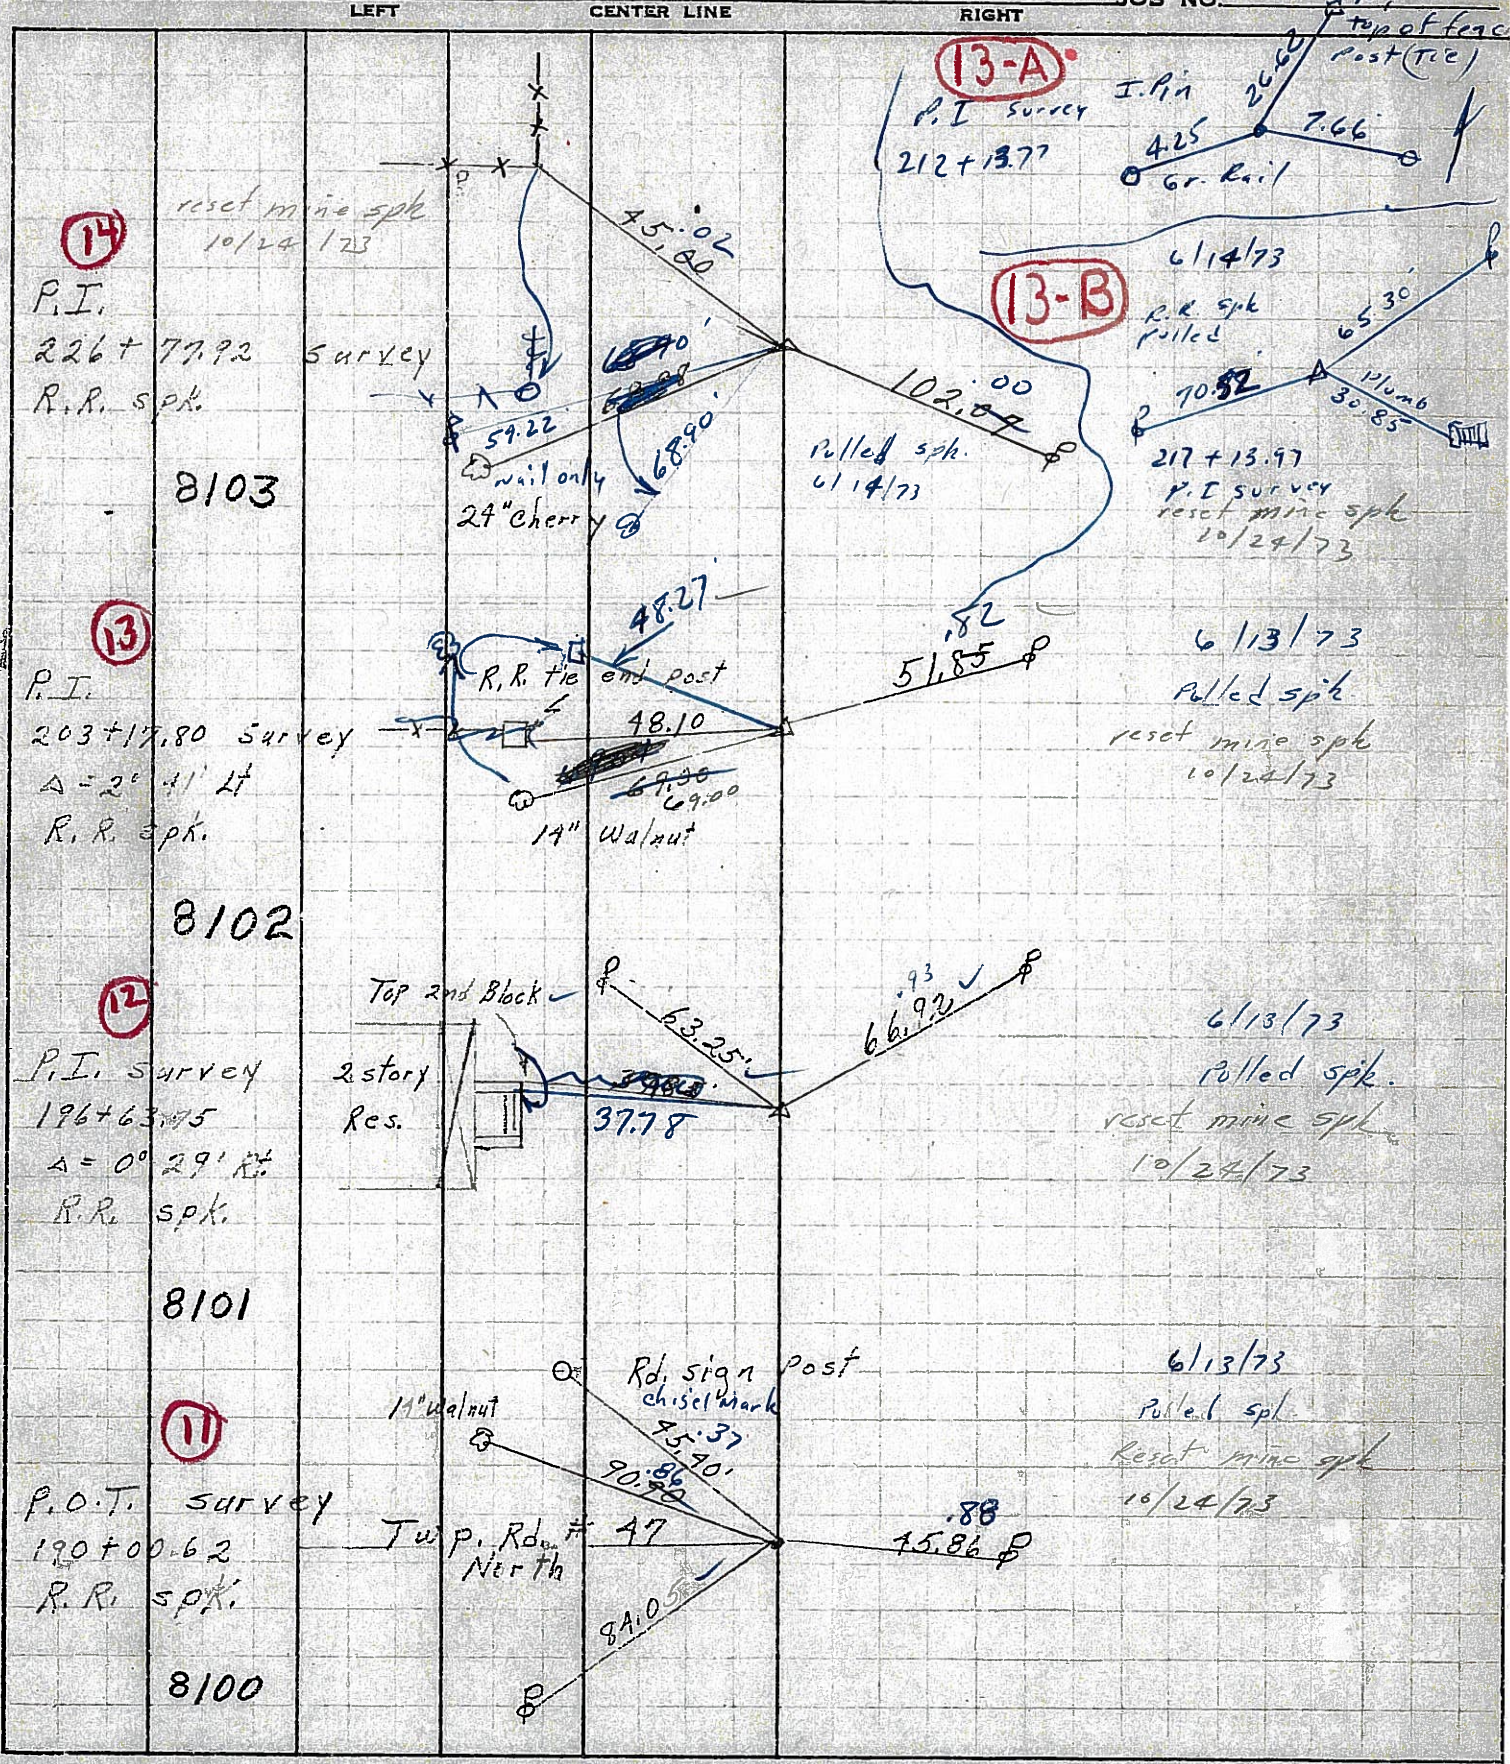

PERSONNEL

TITLE

PERSONNEL

TITLE

COUNTY SenecaDATE Dec. 18, '58HshCromerLeemasterLehrJohn M.S. R. #18 Fosterie-Buscom Rd. WEATHER CloudySEC. Sen-18 (1.79-8.60)TEMP. 20°

DESCRIPTION

Control Point Ties - & Survey & Const.

LEFT

CENTER LINE - Survey

RIGHT

JOB NO.

(13-A)

11-2-59 I.P.Survey CurveP.I. 212+13.77 SurveyP.R. Spk.Did not find10/28/55Found 11/1/55Found I.P.11-2-59 I.P.P.C. 211+14.45 SurveyP.K. Nail + Shi.Did not findSurvey Tang.Survey Tang.