

O.D.O.T. DISTRICT 2 SURVEY OFFICE (USE ONLY)

PERSONNEL

REFERENCE NO. 13B

SHEET OF

NOTES MILLER DATE 8/5/24

H.C. NIESE WEATHER SUNNY

R.C. PRESTON-COLVIN TEMP. 80°

ASTON

ROUTE SR 18

COUNTY SENECA

TOWNSHIP LOUDON

SECTION 15

DWG BY BARRIERE PID 92371

T 2 N R 13 E

TYPE MONUMENT MAG NAIL/WASHER

ON SURFACE - BELOW ON

OFFSET CL PAVEMENT 21.3' LT LT : RT

 TO EDGE PAVEMENT

STATION: 212+13.77

HORZ.DATUM: NAD83 (2011)


GEOID: 18

GRID: NORTHING: 535768.414


EASTING: 1732243.483

LDP: NORTHING:

EASTING:

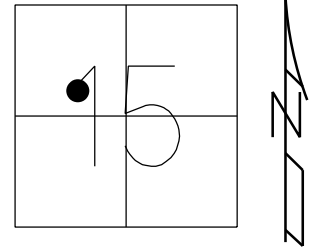

RECORD: P.I.
 $\Delta = 04^{\circ} 58' 00''$ LT
STA.217+13.97
FD P.K./WASHER
ATOP MINE SPIKE
FD P.K./WASHER
7/11/97, MB
SET P.K./WASHER
11/6/97, MB
FD P.K./WASHER
1 1/2" DOWN
REFB13
4/22/19
8/19/19, JFO
9/1/21, DSA
2/15/22, JFO
2/10/23, JMR
9/15/23, JAM
SET MAG/WASHER
11/6/23, DSA
SET MAG/WASHER
8/5/24, TDN

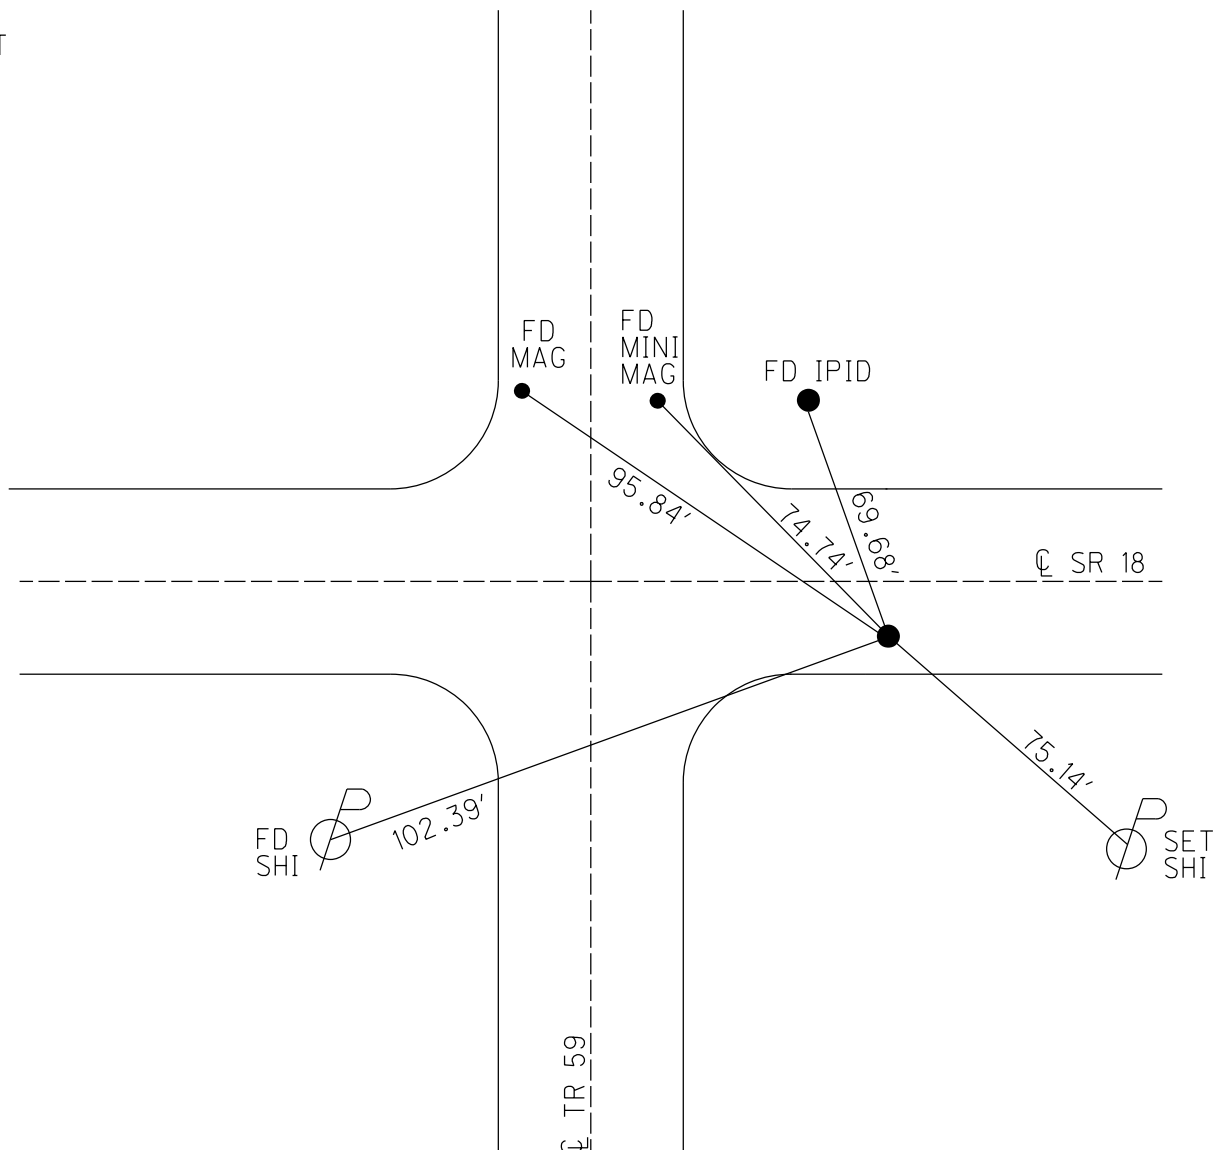

PERSONNEL

REFERENCE NO. 13 B

SHEET 10 OF 48

NOTES AUBLE

DATE 10/6/23

ROUTE SR 18

H.C. MILLER

WEATHER FAIR

COUNTY SENECA

R.C. AUBLE

TEMP. 42°

TOWNSHIP LOUDONSECTION 15

DWG BY RHOADES PID PVTRAIN

T_2_N R_13_E

TYPE MONUMENT MAG/WASHER

ON SURFACE - ~~BELOW~~ ON _____

OFFSET @ PAVEMENT 7.0' ~~LT~~ : RT


4.8' TO RT EDGE PAVEMENT

STATION: 217+13.97

HORZ.DATUM: NAD83(2011)

GEOID: 2012A

GRID: NORTHING: 535768.414

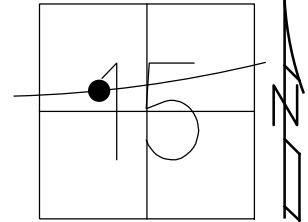EASTING: 1732243.463

RECORD: P.I.

$$\Delta = 04^{\circ} 58' 00'' \text{ LT}$$

STA.217+13.97

FD P.K./WASHER

ATOP MINE SPIKE
ED BY M. W. CHASE

FD P.K./WASHER

7/11/97, MB

SET P.K./WASHER

11/6/97, MB

FD P.K./WASHER

1 1/2" DOWN
B55B17

REFB13
4 400 414/22/19
2/12/19 150

8/19/19, JFO
8/1/21, DCA


9/1/21, DSA
2/15/22 IFO

2/15/22, JF O
2/10/23, JMD

2/10/23, JMR
9/15/23, IAM

9/15/23, JAM
SET MAC / WASHER

SET MAG/WAS
11/6/23 DSA

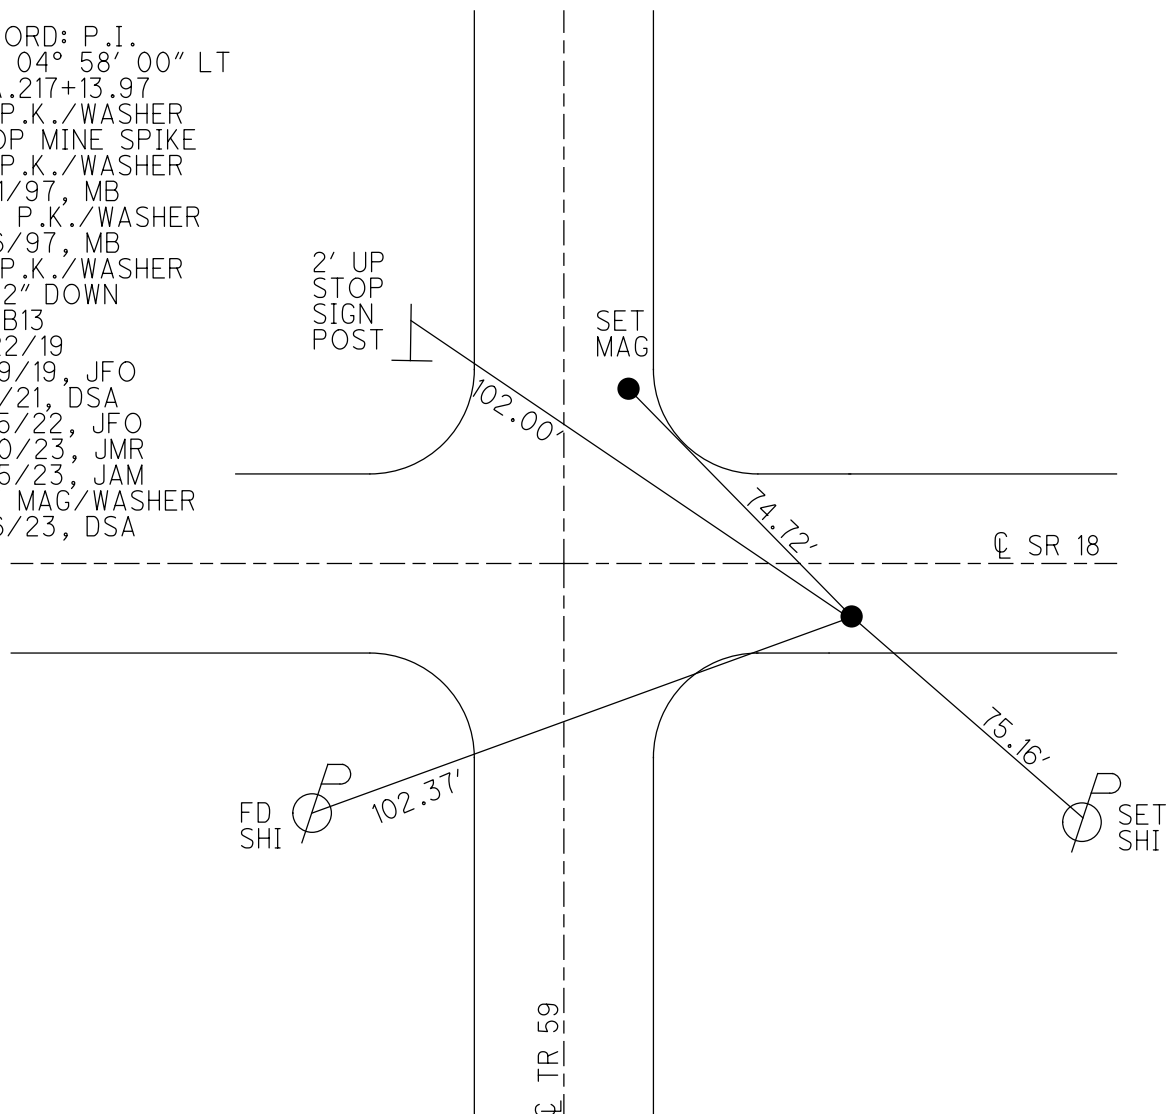

O.D.O.T. DISTRICT 2 SURVEY OFFICE (USE ONLY)

PERSONNEL

REFERENCE NO. 13 B

SHEET 10 OF 48

NOTES AUBLE

DATE 9/1/21

ROUTE SR 18

H.C. NIESE

WEATHER WINDY

COUNTY SENECA

R.C. AUBLE

TEMP. 72°

TOWNSHIP LOUDON

SECTION 15

DWG BY RHOADES

PID PVTRAIN

T 2 N R 13 E

TYPE MONUMENT P.K./WASHER

~~ON SURFACE~~ - BELOW 1 1/2"

OFFSET Q PAVEMENT 7.0' ~~LT~~ : RT

4.8' TO RT EDGE PAVEMENT


STATION: 217+13.97

HORZ.DATUM: NAD83(2011)


GEOID: 2012A


GRID: NORTHING: 535768.414

EASTING: 1732243.463

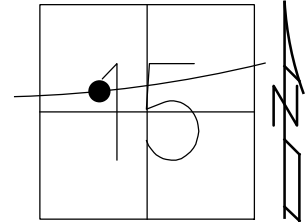

RECORD: P.I.
 $\Delta = 04^{\circ} 58' 00''$ LT
STA. 217+13.97
FD P.K./WASHER
ATOP MINE SPIKE
FD P.K./WASHER
7/11/97, MB
SET P.K./WASHER
11/6/97, MB
FD P.K./WASHER
1 1/2" DOWN
REFB13
4/22/19
8/19/19, JFO
9/1/21, DSA
2/15/22, JFO
2/10/23, JMR

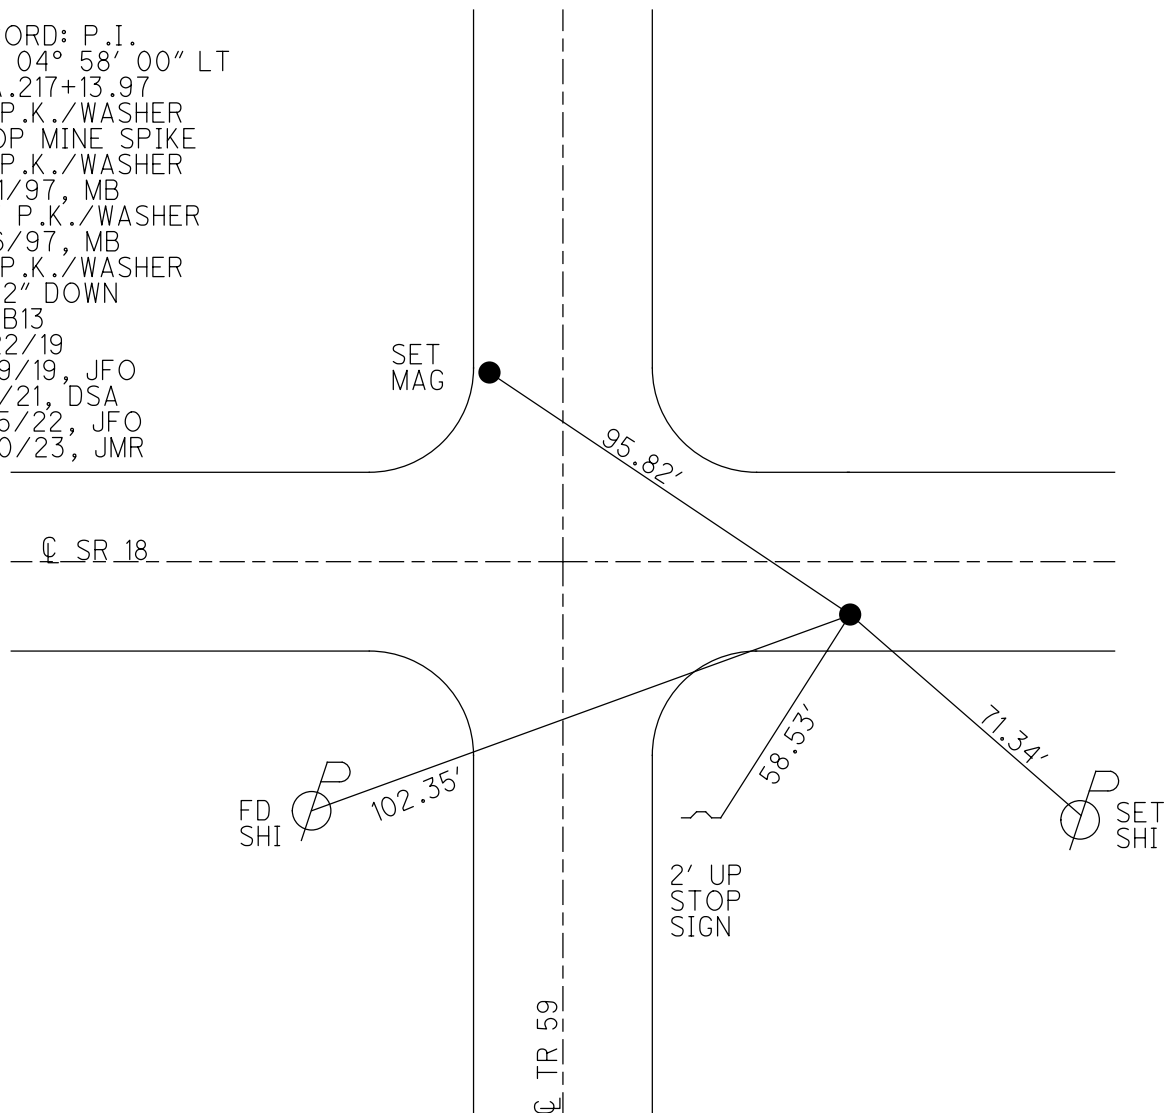

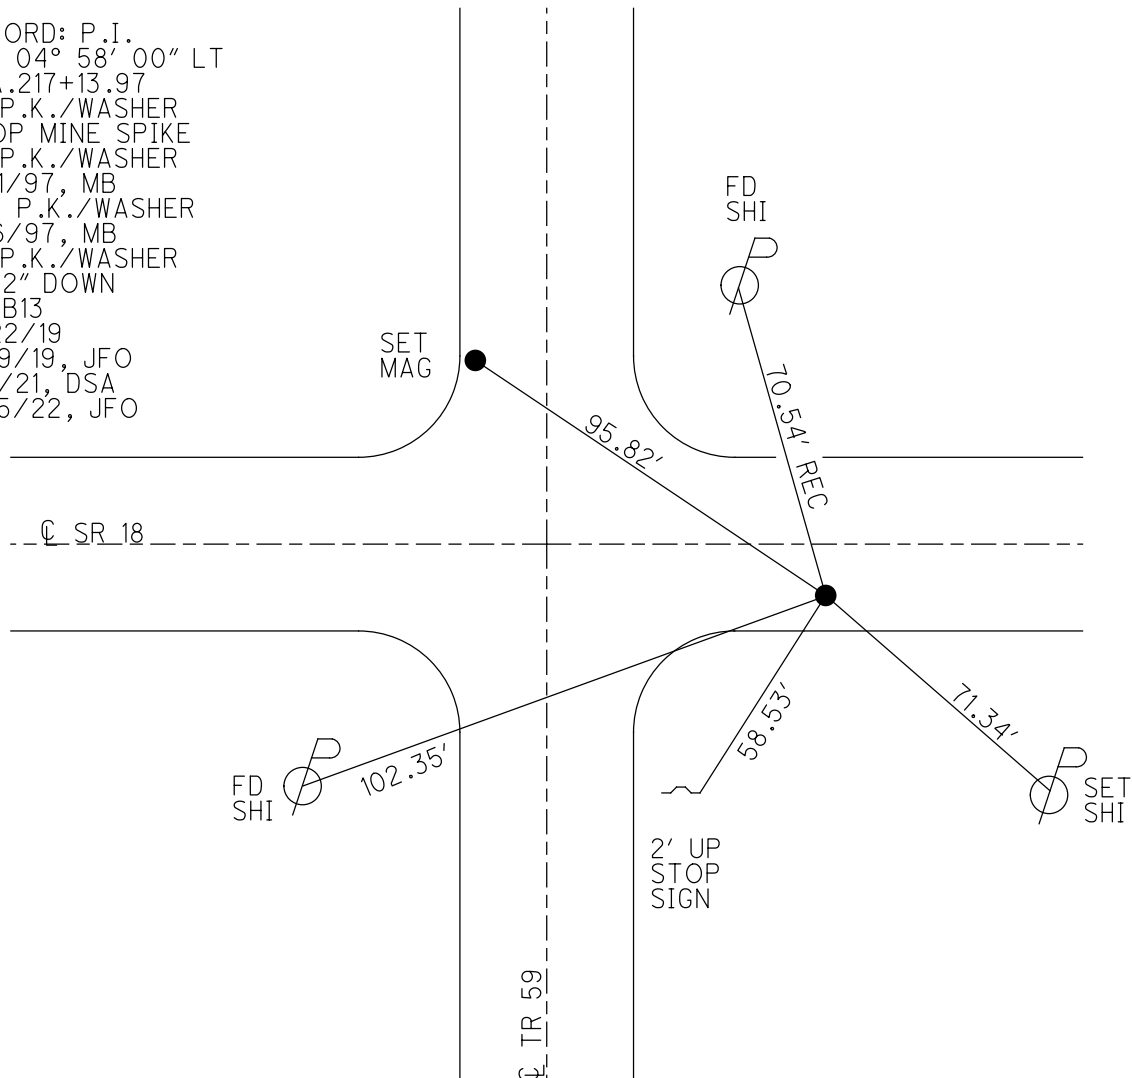

O.D.O.T. DISTRICT 2 SURVEY OFFICE (USE ONLY)

PERSONNEL

REFERENCE NO. 13 B

SHEET 10 OF 48

NOTES BARNHISEL

DATE 7/11/97

ROUTE SR 18

H.C. CANTERBURY

WEATHER SUNNY

COUNTY SENECA

R.C. WEAVER

TEMP. 75°

TOWNSHIP LOUDON

ROUSOS

SECTION 15

DWG BY NIESE

PID NO PID

T 2 N R 13 E

TYPE MONUMENT P.K./WASHER

ON SURFACE - ~~BELOW~~ ON

OFFSET CL PAVEMENT 7.0' ~~LT~~ : RT

4.8' TO RT EDGE PAVEMENT


STATION: 217+13.97

HORIZ.DATUM: NAD83(2011)


GEOID: 2012A

GRID: NORTHING: 535768.414

EASTING: 1732243.463

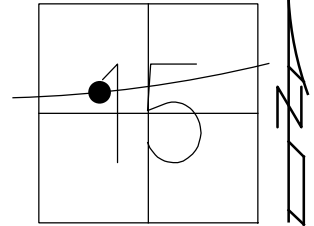

RECORD: P.I.
 $\Delta = 04^{\circ} 58' 00''$ LT
STA. 217+13.97
FD P.K./WASHER
ATOP MINE SPIKE
FD P.K./WASHER
7/11/97, MB
SET P.K./WASHER
11/6/97, MB
FD P.K./WASHER
1 1/2" DOWN
REFB13
4/22/19
8/19/19, JFO

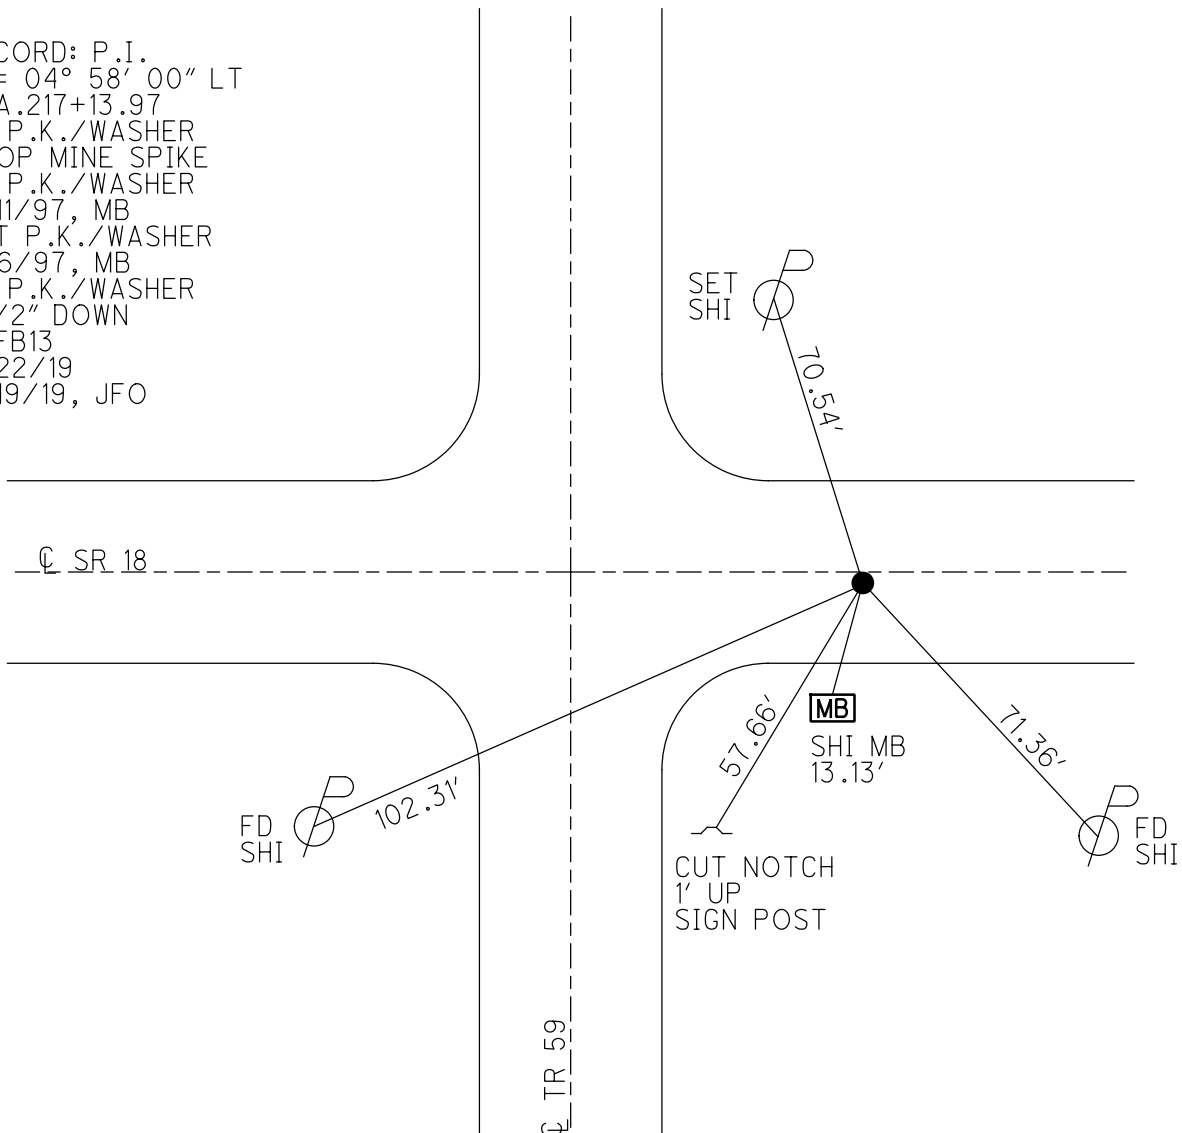

O.D.O.T. DISTRICT 2 SURVEY OFFICE

PERSONNEL

REFERENCE NO. 13-B

SHEET 15 OF 22

NOTES BARNHISEL

H.C. CANTERBURY

R.C. WEAVER

P. RANSOS

DRAWN BY RANSOS

DATE 7-11-97

WEATHER SUNNY

TEMP. +75°

ROUTE 18

COUNTY SENECA

TOWNSHIP LOUDON

SECTION 15

T 2 N R 13 E


TYPE MONUMENT P.K. WASHER

ON SURFACE - BELOW ON SURFACE

LEFT-CL PAW'T. - RIGHT 7.0

4.8 TO RT EDGE PAVEMENT

S.L.M. G. 994.8 SLK

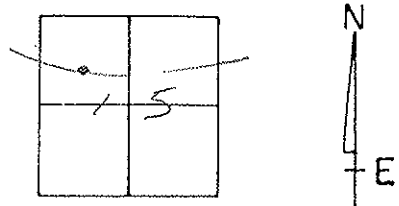

P.I. SURVEY
 $\Delta = 04^{\circ} 58' 00''$ LT
 217 + 13.97
 1/2" WASHER ATOP
 MINE SPIKE

RESET PK WASHER
 11-6-97
 MB

Top Ed 59

SET N/SHE, SE/S
 70.56'

CL SR 182

SAI MEAS



102.31'

CUT NOTCH
 1' UP

M.B.

13.13'

71.36'

END SAI
 H.N/S

O.D.O.T. DISTRICT 2 SURVEY OFFICE

PERSONNEL

NOTES CRONIN
H.C. RIPPLE
R.C. BARBOUR
GEYMAN


REFERENCE NO. 5
DRAWN 1/19/90
DATE 1/18/90
WEATHER OVERCAST-WINDY
TEMP. 38°

SHEET 15 OF


ROUTE #18
COUNTY SENECA
TOWNSHIP LOUDDON
SECTION 15
T 2 N R 13 E

TYPE MONUMENT P.K. & WASHER
ON SURFACE - BELOW
LEFT - & PAW'T. - RIGHT 7' E
 TO EDGE PAVEMENT
S.L.M.

13-B

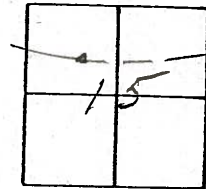

P.I. SURVEY
 $\Delta = 04^{\circ}58'00''$ LT.
217+13.97
P.K. & WASHER ATOP
MINE SPIKE

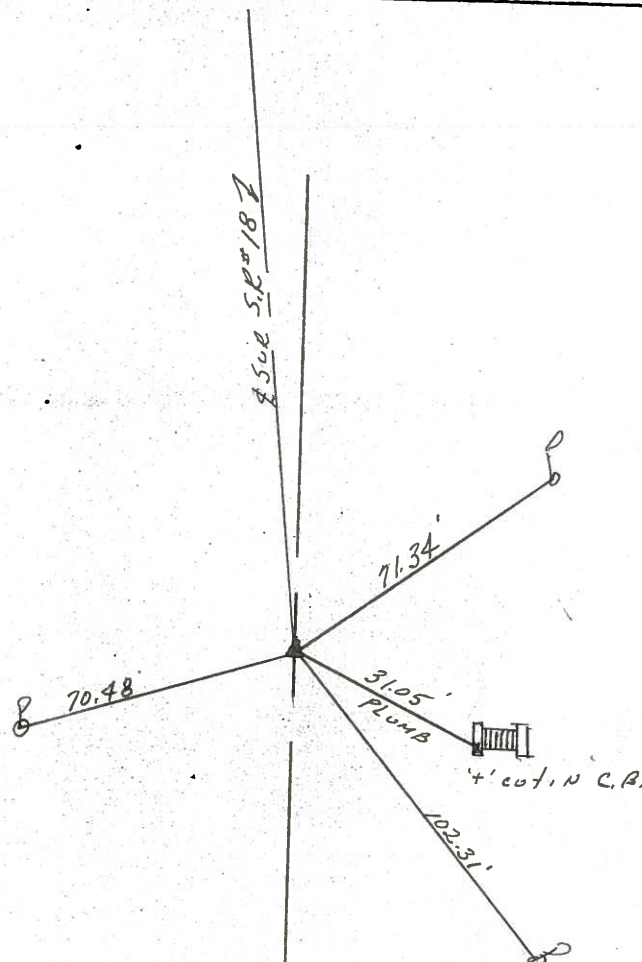

[illegible]

COUNTY Severa

DATE 10-16-58

Schneider

Messer

Barbour

Pc 45

S. R. 18

WEATHER Fair - windy

SEC. Fosteria to Bascom

TEMP. 80°


DESCRIPTION Lies for Control Points

LEFT

CENTER LINE

RIGHT

ON JOB

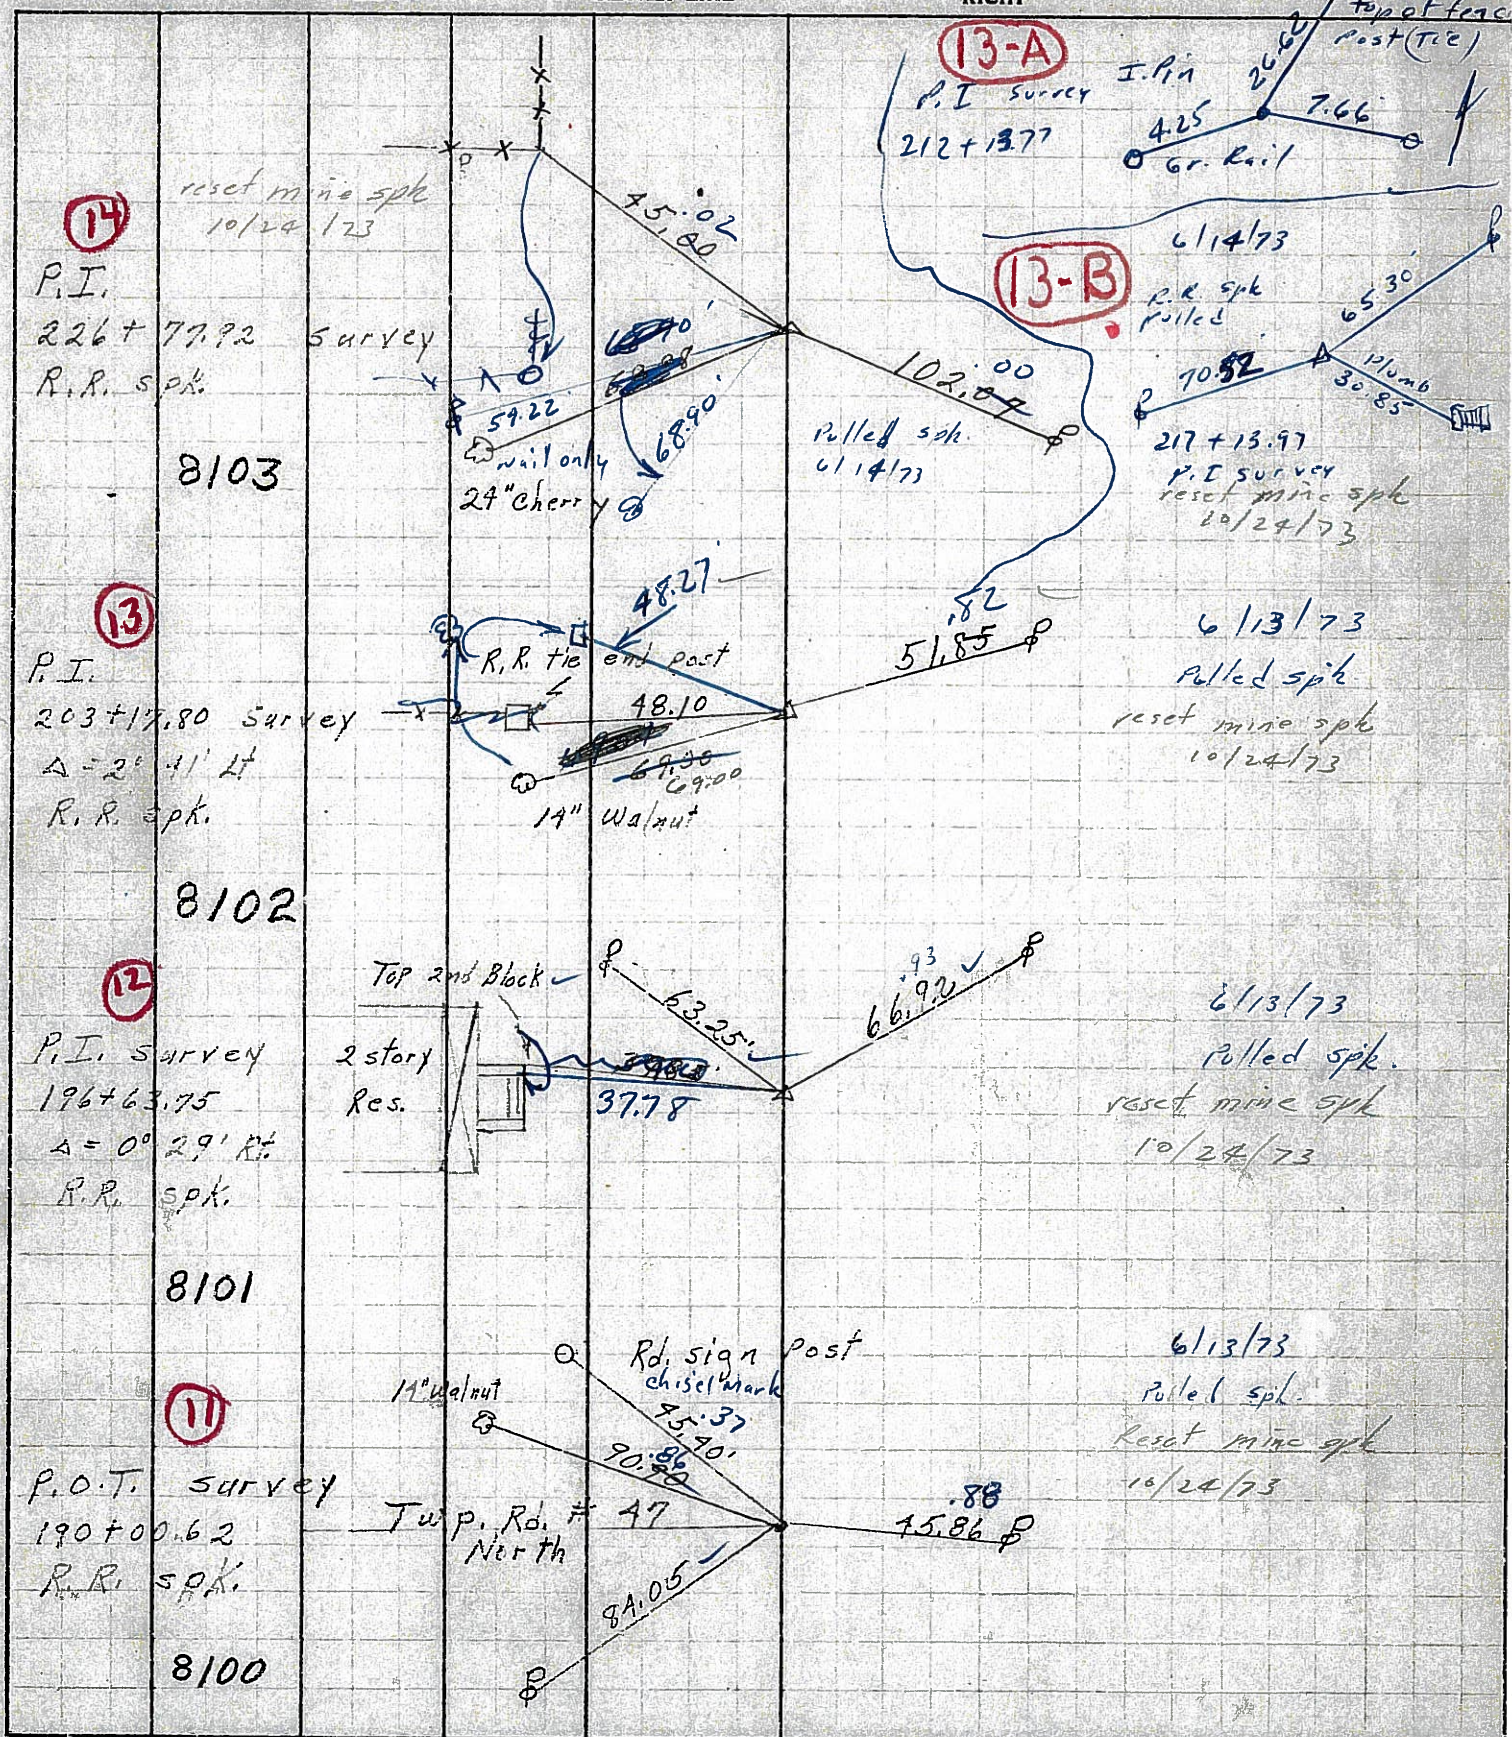

PERSONNEL	TITLE	PERSONNEL	TITLE
1	1	1	1
2	2	2	2
3	3	3	3
100	100	100	100

COUNTY Seneca

DATE Dec, 22, '58

#54

Crotonin

Leontator

12/11/21

John K.

S. R. #18 Fosteria-Bascom Pl W

WEATHER Clear

SEC. Sen-18(1.79-8.60)

TEMP. 30°

DESCRIPTION Control Point Ties - 4 surveys & Const.

JOB NO

LEFT

CENTER LINE - Survey

RIGHT

