

O.D.O.T. DISTRICT 2 SURVEY OFFICE (USE ONLY)

PERSONNEL

REFERENCE NO. 14

SHEET OF

NOTES MILLER DATE 8/5/24

H.C. NIESE WEATHER SUNNY

R.C. PRESTON-COLVIN TEMP. 80°

ASTON

DWG BY BARRIERE PID 92371

ROUTE SR 18

COUNTY SENECA

TOWNSHIP LOUDON

SECTION 15

T 2 N R 13 E

TYPE MONUMENT MAG NAIL/WASHER

ON SURFACE - BELOW ON

OFFSET Q PAVEMENT 1.6' LT LT : RT

 TO EDGE PAVEMENT

STATION: 226+77.92

HORZ.DATUM: NAD83 (2011)


GEOID: 18

GRID: NORTHING: 535688.938


EASTING: 1733203.713

LDP: NORTHING:

EASTING:

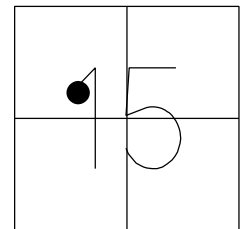

RECORD: P.I.
 $\Delta = 04^{\circ} 18' 00''$ LT
STA.226+77.92
FD P.K./WASHER
ATOP MINE SPIKE
FD P.K./WASHER
7/11/97, TMR
SET P.K./WASHER
11/6/97, MB
FD P.K./WASHER
REF14
4/22/19, JFO
SET MAG/WASHER
8/19/19, JFO
FD MAG/WASHER
9/1/21, DSA
2/15/22, JFO
2/10/23, JMR
10/6/23, DSA
SET MAG/WASHER
8/5/24, TDN

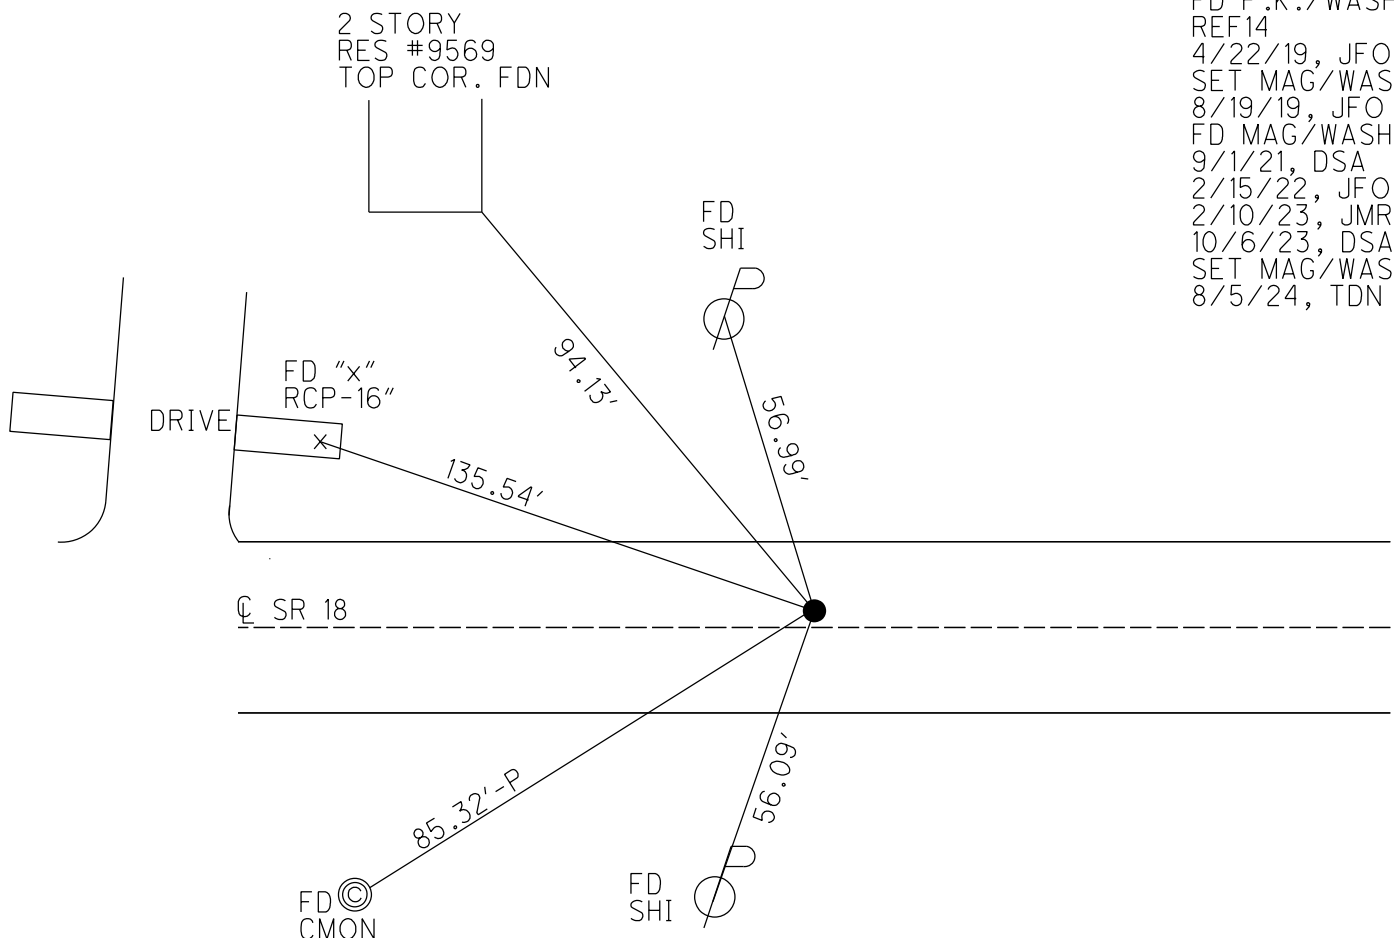

O.D.O.T. DISTRICT 2 SURVEY OFFICE (USE ONLY)

PERSONNEL

REFERENCE NO. 14

SHEET 11 OF 48

NOTES AUBLE

DATE 9/1/21

ROUTE SR 18

H.C. NIESE

WEATHER WNIDY

COUNTY SENECA

R.C. AUBLE

TEMP. 76°

TOWNSHIP LOUDON

SECTION 15

DWG BY RHOADES

PID PVTRAIN

T 2 N R 13 E

TYPE MONUMENT MAG/WASHER

ON SURFACE - ~~BELOW~~ ON

OFFSET CL PAVEMENT 1.6' LT : ~~RT~~

10.4' TO LT EDGE PAVEMENT



STATION: 226+77.92

HORZ.DATUM: NAD83(2011)

GEOID: 2012A

GRID: NORTHING: 535688.934

EASTING: 1733203.733

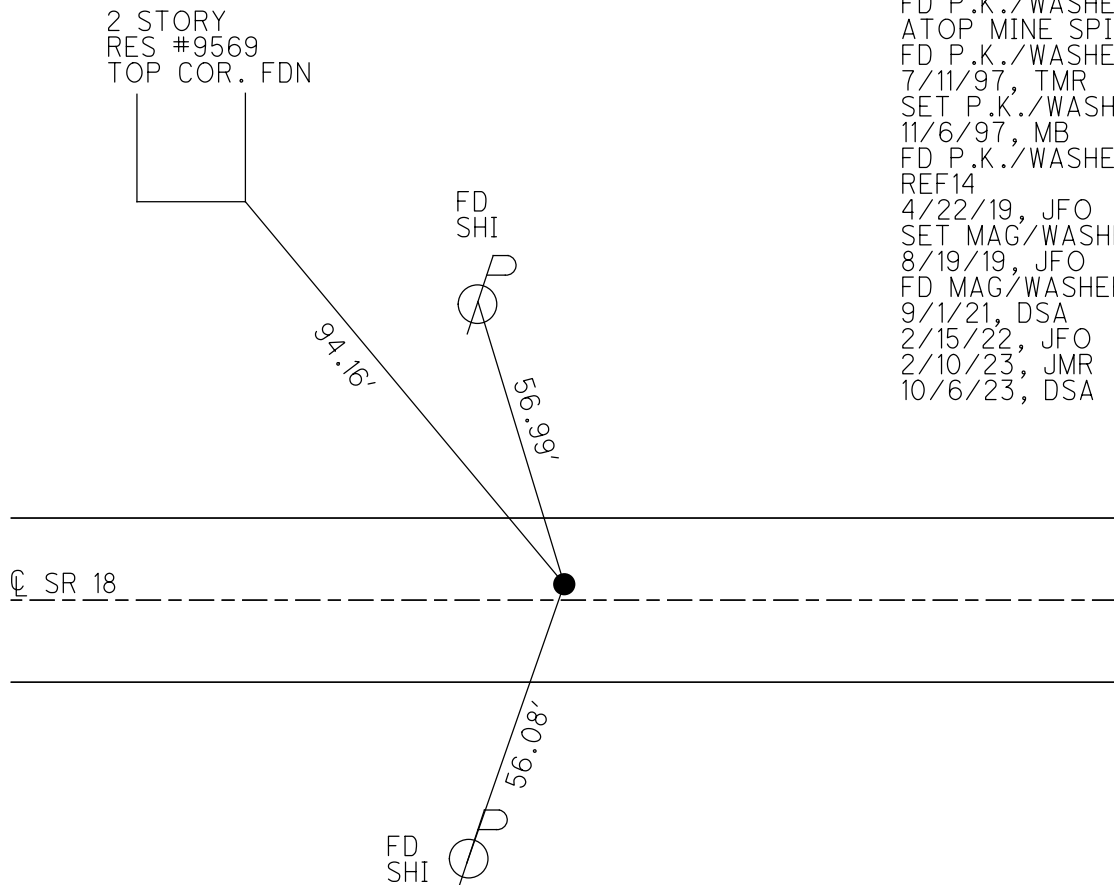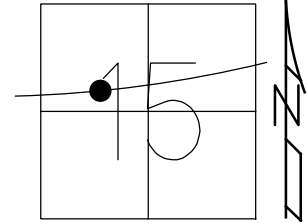

RECORD: P.I.
 $\Delta = 04^{\circ} 18' 00''$ LT
STA. 226+77.92
FD P.K./WASHER
ATOP MINE SPIKE
FD P.K./WASHER
7/11/97, TMR
SET P.K./WASHER
11/6/97, MB
FD P.K./WASHER
REF14
4/22/19, JFO
SET MAG/WASHER
8/19/19, JFO
FD MAG/WASHER
9/1/21, DSA
2/15/22, JFO
2/10/23, JMR
10/6/23, DSA

O.D.O.T. DISTRICT 2 SURVEY OFFICE (USE ONLY)

PERSONNEL

REFERENCE NO. 14

SHEET 11 OF 48

NOTES AUBLE

DATE 9/1/21

ROUTE SR 18

H.C. NIESE

WEATHER WNIDY

COUNTY SENECA

R.C. AUBLE

TEMP. 76°

TOWNSHIP LOUDON

DWG BY RHOADES

PID PVTRAIN

SECTION 15

T 2 N R 13 E

TYPE MONUMENT MAG/WASHER

ON SURFACE - ~~BELOW~~ ON

OFFSET CL PAVEMENT 1.6' LT : ~~RT~~

10.4' TO LT EDGE PAVEMENT



STATION: 226+77.92

HORIZ.DATUM: NAD83(2011)

GEOID: 2012A

GRID: NORTHING: 535688.934

EASTING: 1733203.733

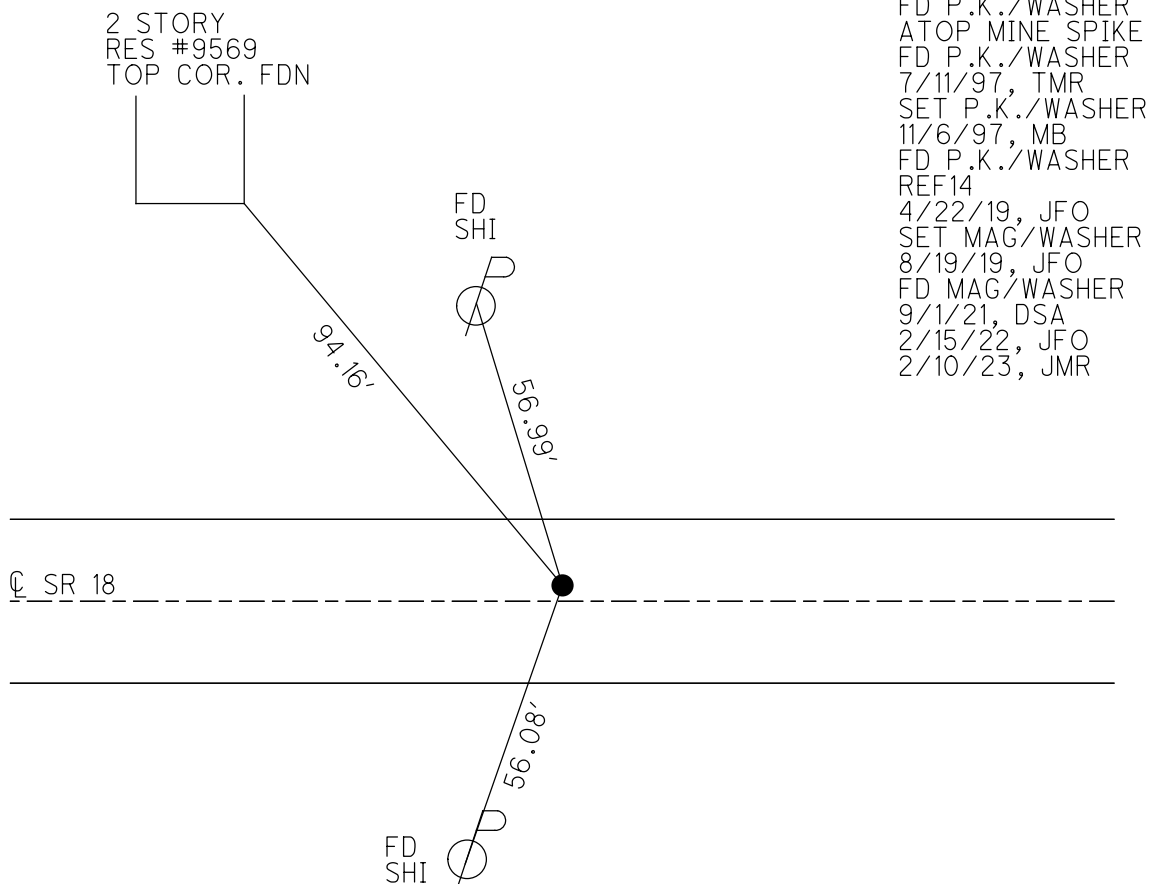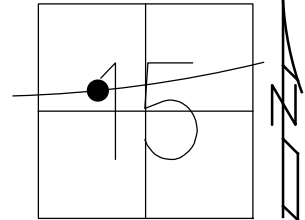

O.D.O.T. DISTRICT 2 SURVEY OFFICE (USE ONLY)

PERSONNEL

REFERENCE NO. 14

SHEET 11 OF 48

NOTES AUBLE

DATE 9/1/21

ROUTE SR 18

H.C. NIESE

WEATHER WNIDY

COUNTY SENECA

R.C. AUBLE

TEMP. 76°

TOWNSHIP LOUDON

SECTION 15

DWG BY RHOADES

PID PVTRAIN

T 2 N R 13 E

TYPE MONUMENT MAG/WASHER

ON SURFACE - ~~BELOW~~ ON

OFFSET CL PAVEMENT 1.6' LT : ~~RT~~

10.4' TO LT EDGE PAVEMENT



STATION: 226+77.92

HORIZ.DATUM: NAD83(2011)

GEOID: 2012A

GRID: NORTHING: 535688.934

EASTING: 1733203.733

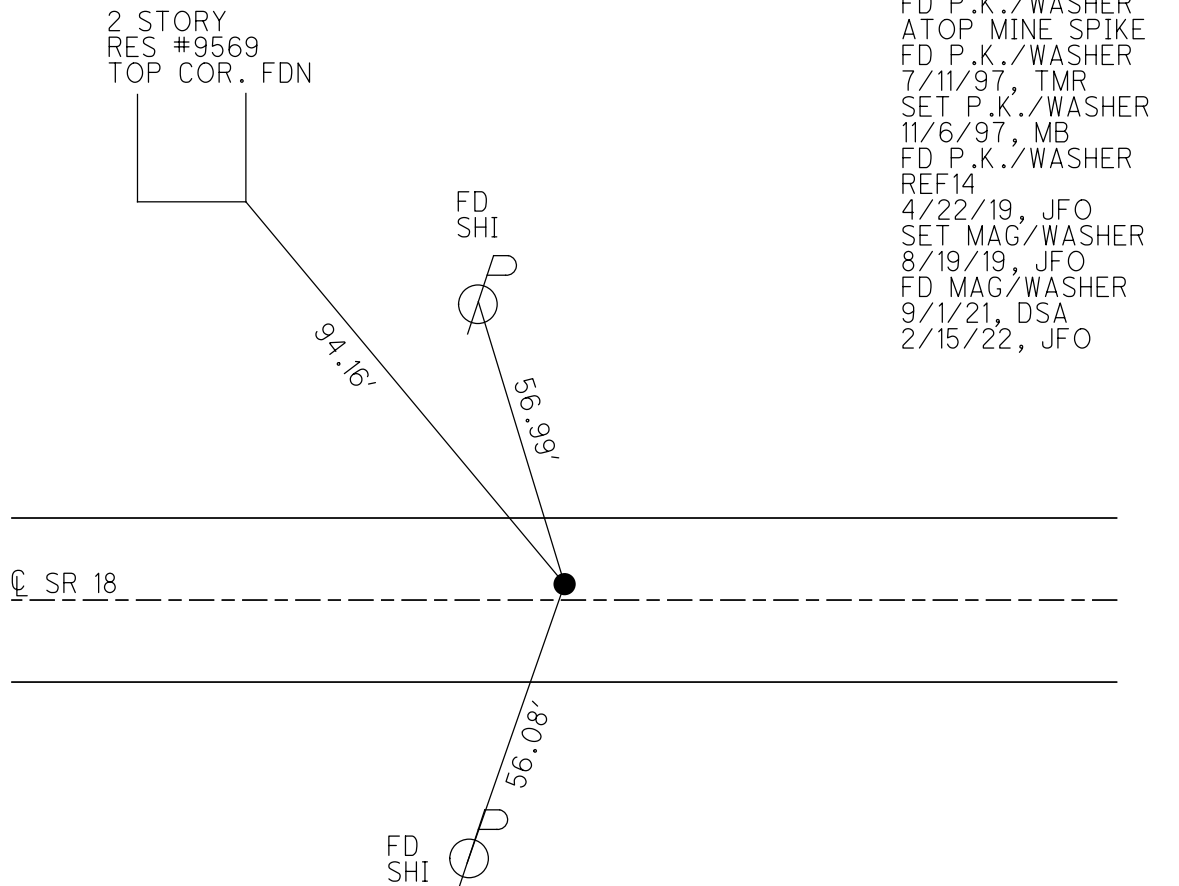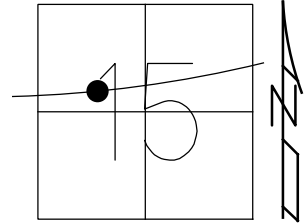

RECORD: P.I.
 $\Delta = 04^{\circ} 18' 00''$ LT
STA.226+77.92
FD P.K./WASHER
ATOP MINE SPIKE
FD P.K./WASHER
7/11/97, TMR
SET P.K./WASHER
11/6/97, MB
FD P.K./WASHER
REF14
4/22/19, JFO
SET MAG/WASHER
8/19/19, JFO
FD MAG/WASHER
9/1/21, DSA
2/15/22, JFO

O.D.O.T. DISTRICT 2 SURVEY OFFICE (USE ONLY)

PERSONNEL

REFERENCE NO. 14

SHEET 11 OF 48

NOTES RHOADES

DATE 8/19/19

ROUTE SR 18

H.C. O'DONNELL

WEATHER SUNNY

COUNTY SENECA

R.C. AUBLE

TEMP. 70°

TOWNSHIP LOUDON

DWG BY NIESE

PID NO PID

SECTION 15

T 2 N R 13 E

TYPE MONUMENT MAG/WASHER

ON SURFACE - ~~BELOW~~ ON

OFFSET Q PAVEMENT 1.6' LT : ~~RT~~

10.4' TO LT EDGE PAVEMENT


STATION: 226+77.92

HORIZ.DATUM: NAD83(2011)


GEOID: 2012A

GRID: NORTHING: 535688.934

EASTING: 1733203.733

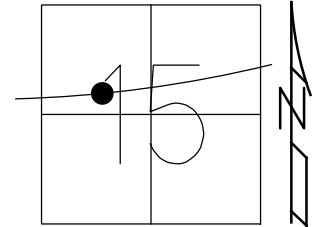

2 STORY
RES #9569
TOP COR. FDN

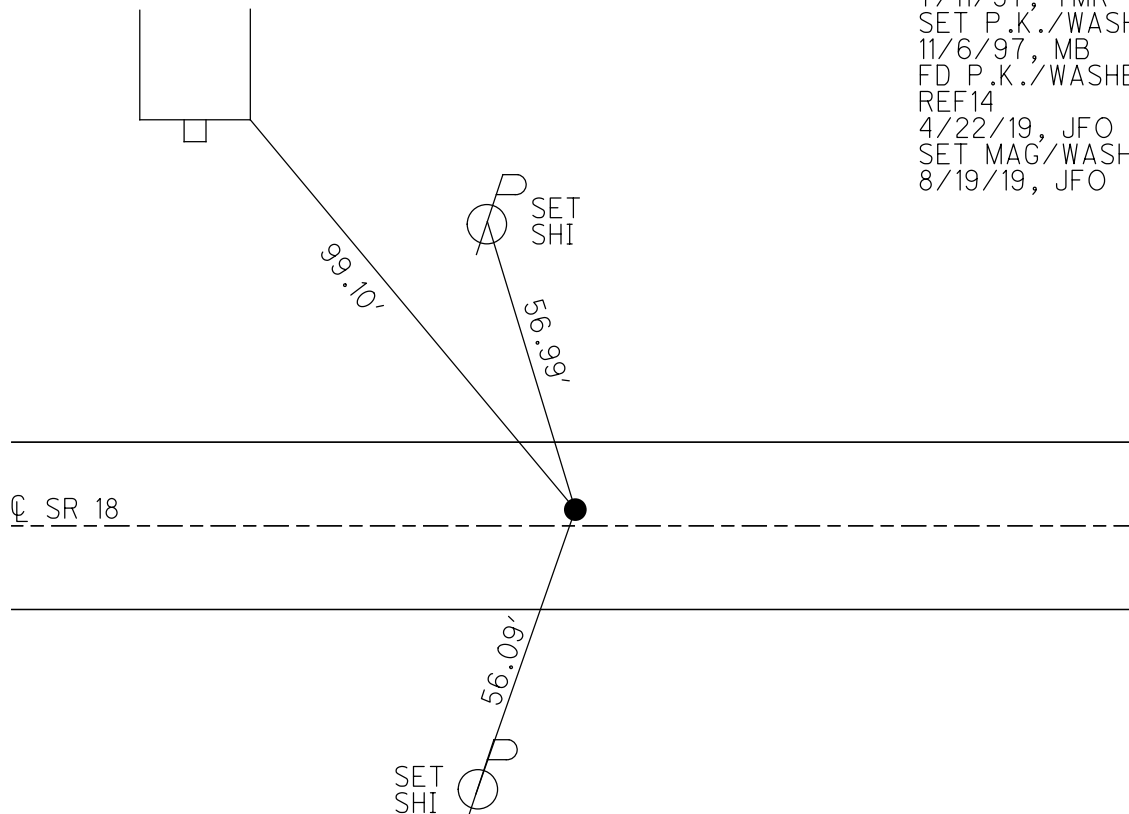

RECORD: P.I.
 $\Delta = 04^{\circ} 18' 00''$ LT
STA.226+77.92
FD P.K./WASHER
ATOP MINE SPIKE
FD P.K./WASHER
7/11/97, TMR
SET P.K./WASHER
11/6/97, MB
FD P.K./WASHER
REF14
4/22/19, JFO
SET MAG/WASHER
8/19/19, JFO

O.D.O.T. DISTRICT 2 SURVEY OFFICE

PERSONNEL

REFERENCE NO. 14

SHEET 16 OF 22

NOTES BARNHISEL

H.C. CANTERBURY

R.C. ROUSOS

P WEAVER

DRAWN BY ROUSOS

DATE 7-11-97

WEATHER SUNNY

TEMP. 77.5°

ROUTE 18

COUNTY SENECA

TOWNSHIP LODSON

SECTION 15

T2 N R 13 E


TYPE MONUMENT PK & WASHER

ON SURFACE - BELOW ~~SURFACE~~

LEFT - CL PAV'T. - RIGHT 1.6

10.4 TO LT EDGE PAVEMENT

S.L.M. 7+289.0 SLK

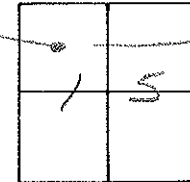

RESET PK & WASHER
11-6-97
MB


P.I. SURVEY

$\Delta = 04^{\circ} 18' 00''$ LT

226+77.92

PK & WASHER ATOP

MINE SPIKE

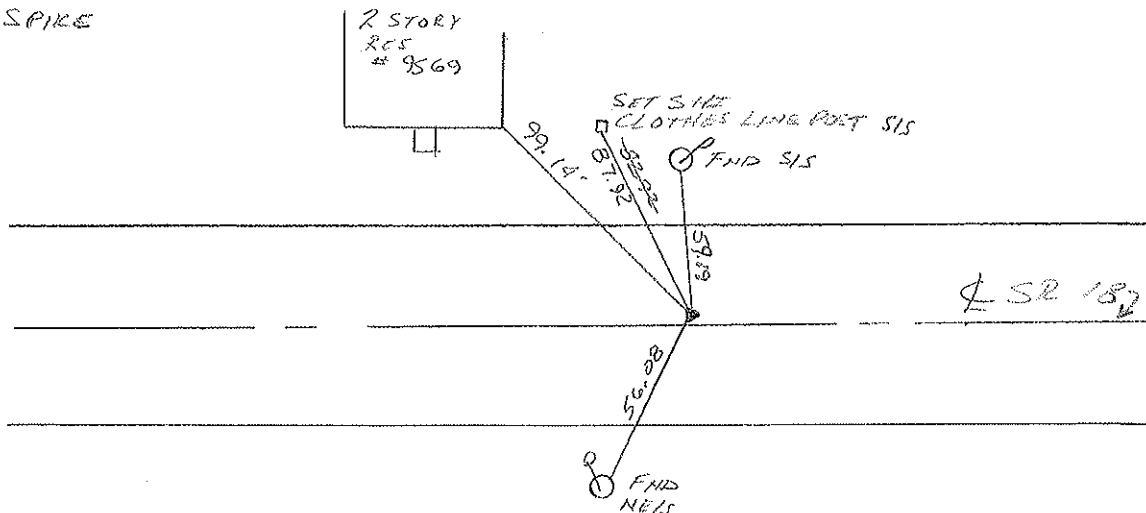

O.D.O.T. DISTRICT 2 SURVEY OFFICE

PERSONNEL


NOTES CROWIN
H.C. RIPPLE
R.C. BARBOUR
GEYMAN

REFERENCE NO. 14
DRAWN 1/19/90
DATE 1/22/90
WEATHER OVERCAST - WINDY
TEMP. 38°

SHEET 16 OF

ROUTE #18
COUNTY SENECA
TOWNSHIP LOODON
SECTION 15
T 2 N R 13 E

TYPE MONUMENT P.K. & WASHER
ON SURFACE - BELOW ON SURFACE
LEFT - PAV'T. - RIGHT 2'
TO EDGE PAVEMENT
S.L.M.

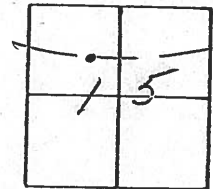

P.I. SURVEY
 $\Delta = 04^{\circ}18'00''$ LT.
226+77.92
P.K. & WASHER STOP
MINE SPIKE



PERSONNEL

TITLE

PERSONNEL

TITLE

SHEET NO.

7

Schneider

COUNTY Seneca

DATE

10-16-68

Messer

S. R. 18

WEATHER Fair-Windy

Barbour

SEC. Fosteria to Bascom

TEMP. 80°

Potts

DESCRIPTION


Ties for Control Points

LEFT

CENTER LINE

RIGHT

JOB NO.

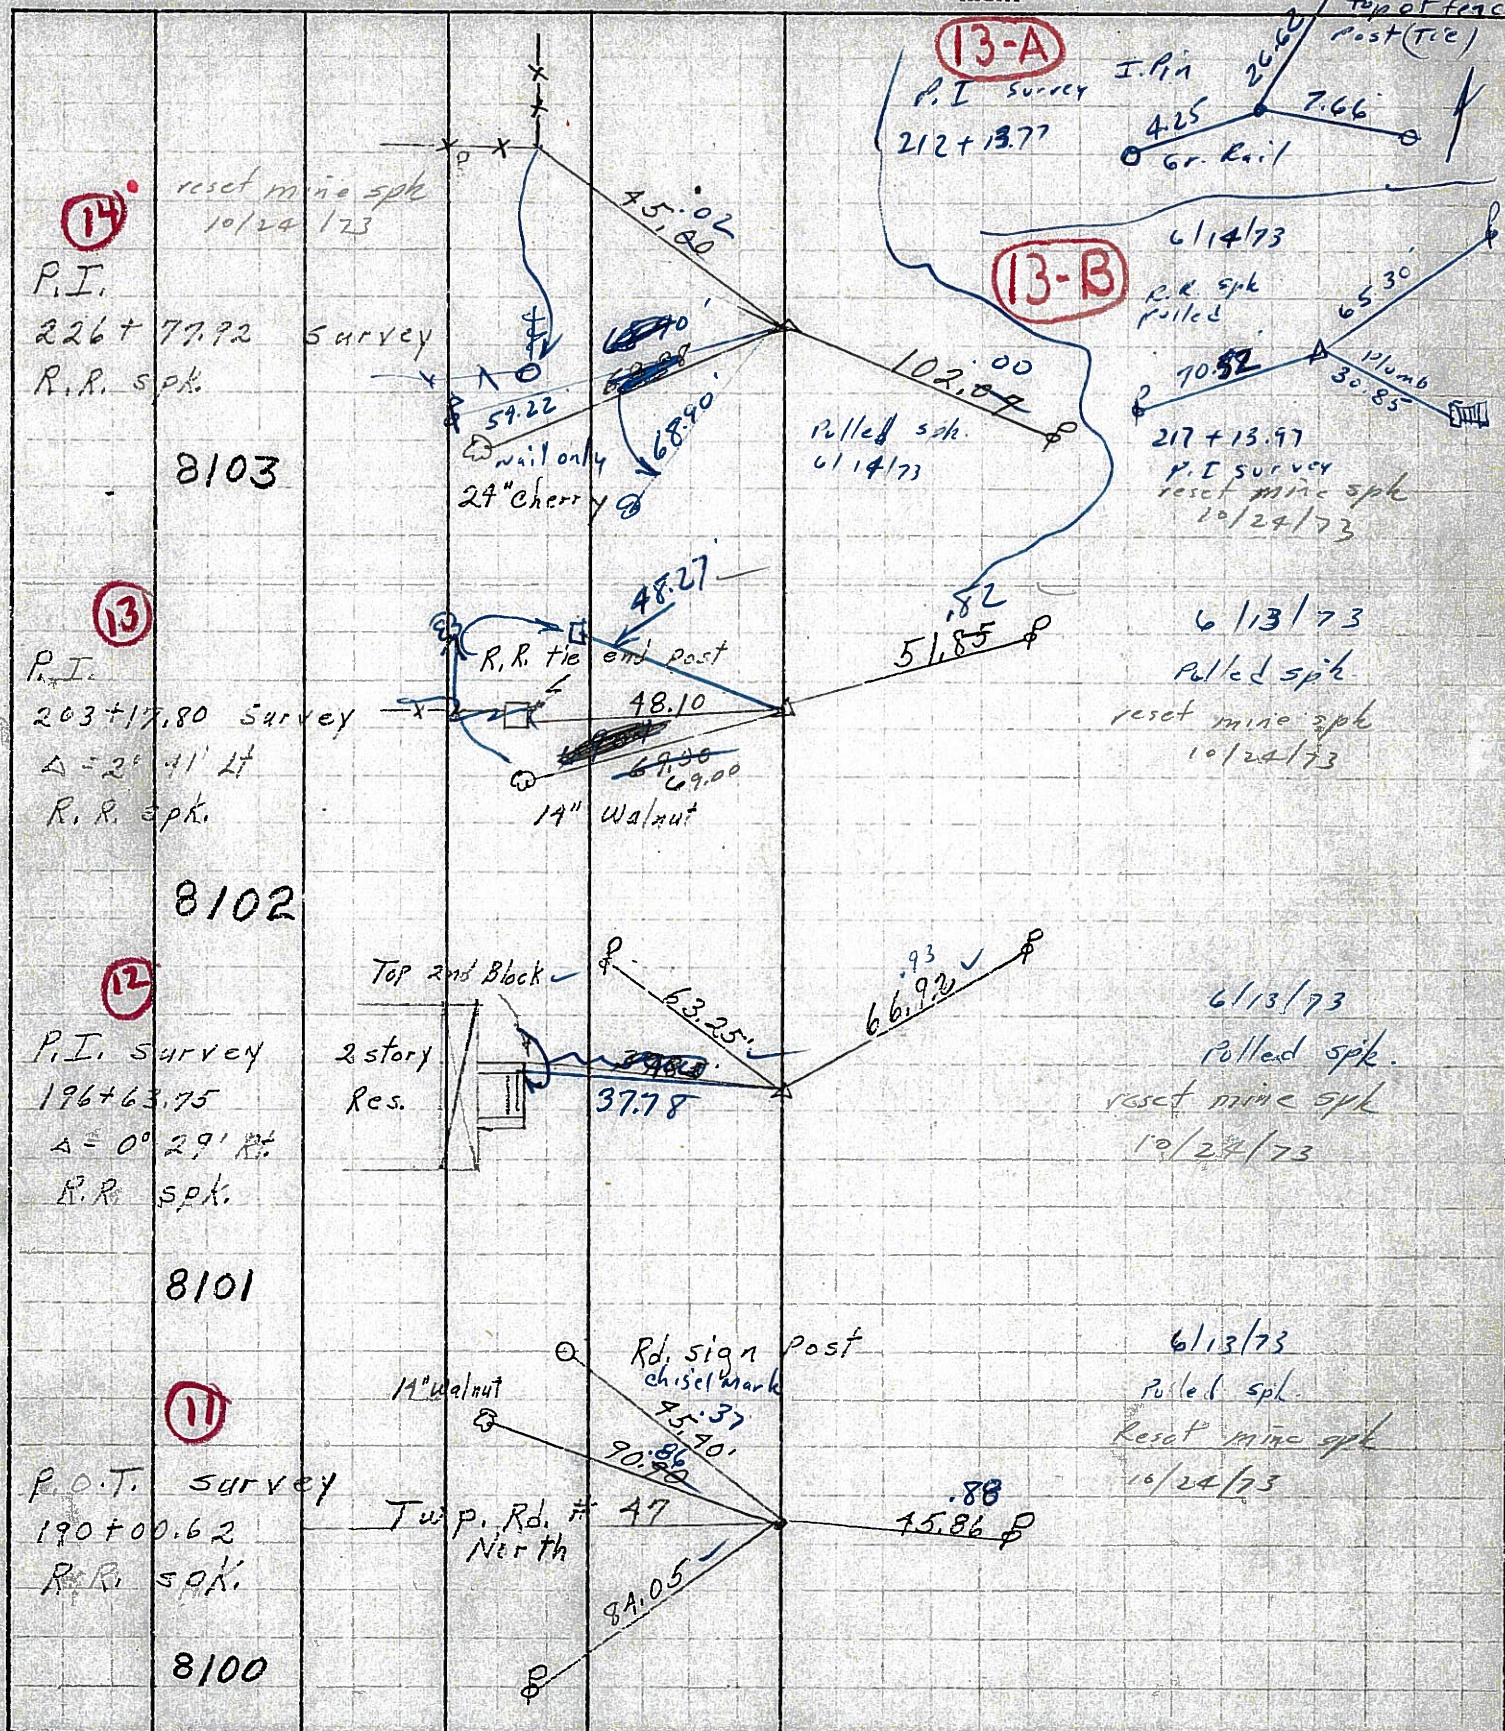

PERSONNEL	TITLE	PERSONNEL	TITLE	COUNTY	DATE
Schneider				Seneca	10-16-68
Messer				S. R.	18
Barbour				WEATHER	Fair - windy
Potts				SEC.	Fastoria to Bascom
				TEMP.	80°


DESCRIPTION Ties for Control Points JOB NO. _____

LEFT CENTER LINE RIGHT

14

P.I.
226+77.92 Survey
R.R. spk.


8103

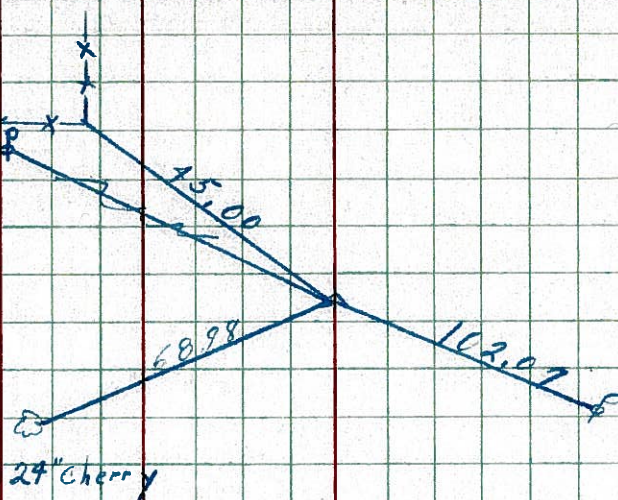

13

P.I.
203+17.80 Survey
Δ = 2° 41' Lt
R.R. spk.


8102

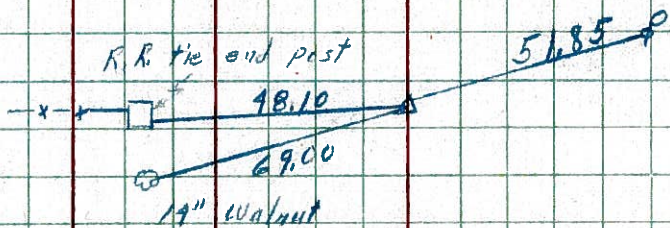

12

P.I. Survey
196+63.75
Δ = 0° 29' Rt
R.R. spk.


8101

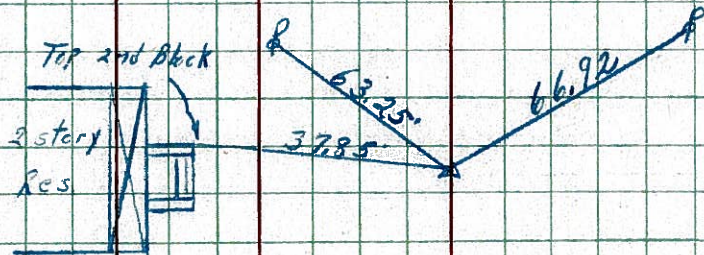

11

P.C.T. Survey
190+00.62
R.R. spk.

8100

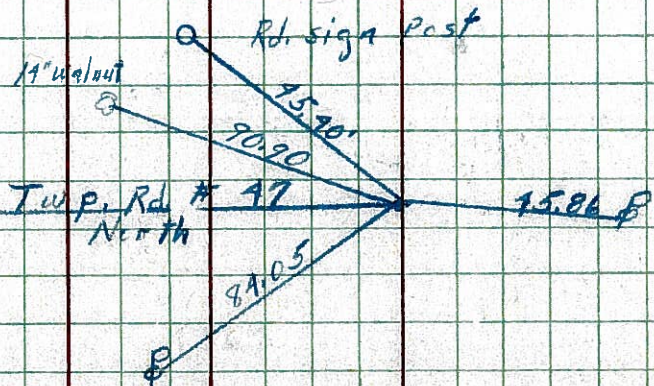

PERSONNEL TITLE PERSONNEL TITLE

Schneider

COUNTY Seneca

DATE 10-16-68

Mosser

S. R. 18

WEATHER Fair - windy

Barbour

SEC. Fostoria to Bascom

TEMP. 80°

Potts

DESCRIPTION Ties for Control Points

JOB NO.

LEFT

CENTER LINE


RIGHT

P.I.

226+77.92 Survey

R.R. spk.

(14)

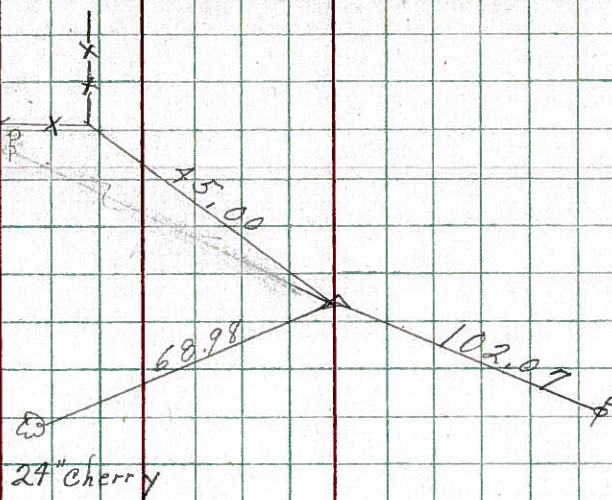

P.T.

203+17.80 Survey

 $\Delta = 2^\circ 41' \text{ Lt}$

R.R. spk.

(13)

R.R. tie end post

48.10

69.00

14" Walnut

51.85 P

P.I. Survey

196+63.75

 $\Delta = 0^\circ 29' \text{ Rt}$

R.R. spk.

(12)

Top 2nd Block

2 story

Res.

37.85

63.25

66.92 P

P.O.T. Survey

190+00.62

R.R. spk.

(11)

Rd. sign post

14" Walnut

45.40

90.90

Twp. Rd. # 47

North

81.05

75.86 P

TITLE

COUNTY Seminole

DATE Dec. 23, '58

754

Crossin

Leetmaster

 $L = L_1$

10th Nov.

S. R.

#18 Fosterie - Bascom Rd

WEATHER ১৭৬৪

SEC. 207-18 (179-8.60)

TEMP. 40

DESCRIPTION

Control Point Ties - 2 Survey + Const.

JOB NO

LEFT

CENTER LINE - Survey

RIGHT

JOB NO