

O.D.O.T. DISTRICT 2 SURVEY OFFICE (USE ONLY)

PERSONNEL

REFERENCE NO. 15

SHEET OF

NOTES BARRIERE

DATE 8/15/24

ROUTE SR 18

H.C. NIESE

WEATHER SUNNY

COUNTY SENECA

R.C. MILLER

TEMP. 77°

TOWNSHIP LOUDON

DWG BY BARRIERE

PID 92371

SECTION 15

T 2 N R 13 E

TYPE MONUMENT MAG NAIL/WASHER

ON SURFACE - BELOW ON

OFFSET $\odot$ PAVEMENT 7.2' RT LT : RT

 TO EDGE PAVEMENT

STATION: 242+80.39

HORZ.DATUM: NAD83 (2011)


GEOID: 18

GRID: NORTHING: 535676.921


EASTING: 1734805.720

LDP: NORTHING:

EASTING:

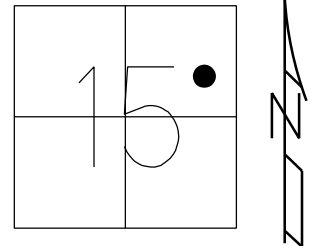

RECORD: P.I.
 $\Delta = 09^{\circ} 54' 00''$ LT
STA.242+80.39
FD P.K./WASHER
7/11/97, MB
SET P.K./WASHER
11/6/97, MB
FD P.K./WASHER
REF15
4/22/19
8/19/19, JFO
9/1/21, DSA
2/15/22, JFO
2/10/23, JMR
SET MAG/WASHER
REF15
8/15/24, TDN

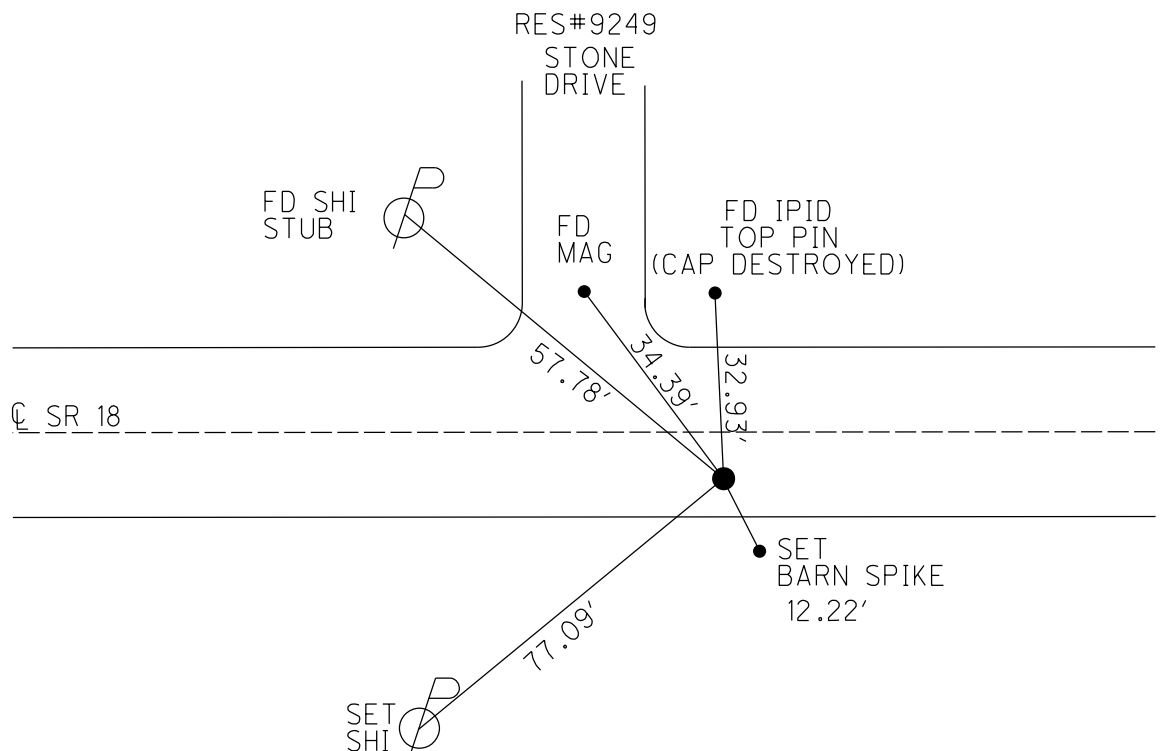

O.D.O.T. DISTRICT 2 SURVEY OFFICE (USE ONLY)

PERSONNEL

REFERENCE NO. 15

SHEET 12 OF 48

NOTES AUBLE

DATE 9/1/21

ROUTE SR 18

H.C. NIESE

WEATHER WINDY

COUNTY SENECA

R.C. AUBLE

TEMP. 76°

TOWNSHIP LOUDON

DWG BY RHOADES

PID PVTRAIN

SECTION 15

T 2 N R 13 E

TYPE MONUMENT P.K./WASHER

ON SURFACE - ~~BELOW~~ ON

OFFSET Q PAVEMENT 7.2' ~~LT~~ : RT

4.5' TO RT EDGE PAVEMENT


STATION: 242+80.39

HORIZ.DATUM: NAD83(2011)


GEOID: 2012A

GRID: NORTHING: 535676.918

EASTING: 1734805.713

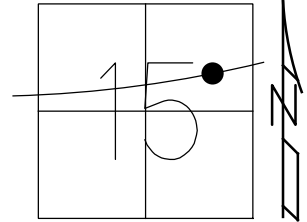


RECORD: P.I.
 $\Delta = 09^{\circ} 54' 00''$ LT
STA.242+80.39
FD P.K./WASHER
7/11/97, MB
SET P.K./WASHER
11/6/97, MB
FD P.K./WASHER
REF15
4/22/19
8/19/19, JFO
9/1/21, DSA
2/15/22, JFO
2/10/23, JMR

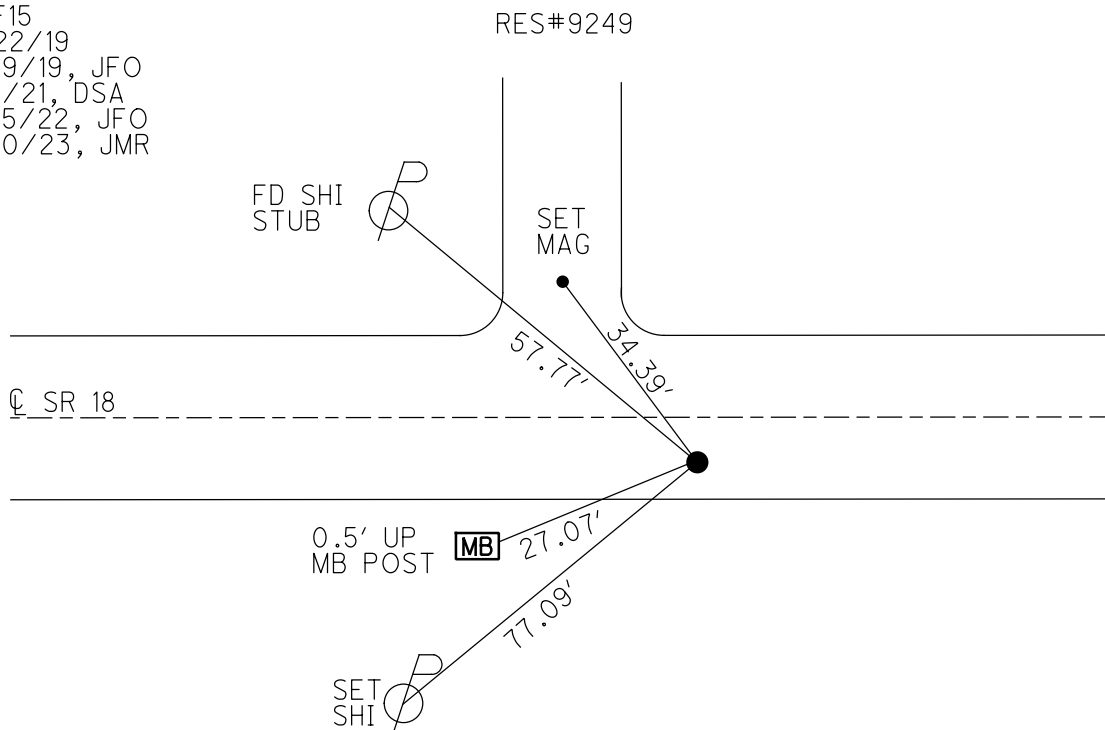


O.D.O.T. DISTRICT 2 SURVEY OFFICE (USE ONLY)

PERSONNEL	REFERENCE NO. <u>15</u>	SHEET <u>12</u> OF <u>48</u>
NOTES <u>AUBLE</u>	DATE <u>9/1/21</u>	ROUTE <u>SR 18</u>
H.C. <u>NIESE</u>	WEATHER <u>WINDY</u>	COUNTY <u>SENECA</u>
R.C. <u>AUBLE</u>	TEMP. <u>76°</u>	TOWNSHIP <u>LOUDON</u>
		SECTION <u>15</u>
DWG BY <u>RHOADES</u>	PID <u>PVTRAIN</u>	T <u>2</u> N R <u>13</u> E
TYPE MONUMENT <u>P.K./WASHER</u>		
ON SURFACE - BELOW <u>ON</u>		
OFFSET <u>CL</u> PAVEMENT <u>7.2'</u> LT : RT		
<u>4.5'</u> TO RT EDGE PAVEMENT		
STATION: <u>242+80.39</u>		
HORZ.DATUM: <u>NAD83(2011)</u>		GEOID: <u>2012A</u>
GRID: NORTHING: <u>535676.918</u>		EASTING: <u>1734805.713</u>

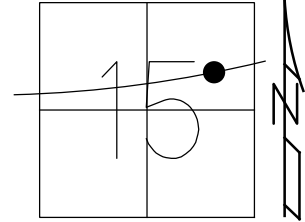

RECORD: P.I.
 $\Delta = 09^\circ 54' 00''$ LT
 STA. 242+80.39
 FD P.K./WASHER
 7/11/97, MB
 SET P.K./WASHER
 11/6/97, MB
 FD P.K./WASHER
 REF15
 4/22/19
 8/19/19, JFO
 9/1/21, DSA
 2/15/22, JFO

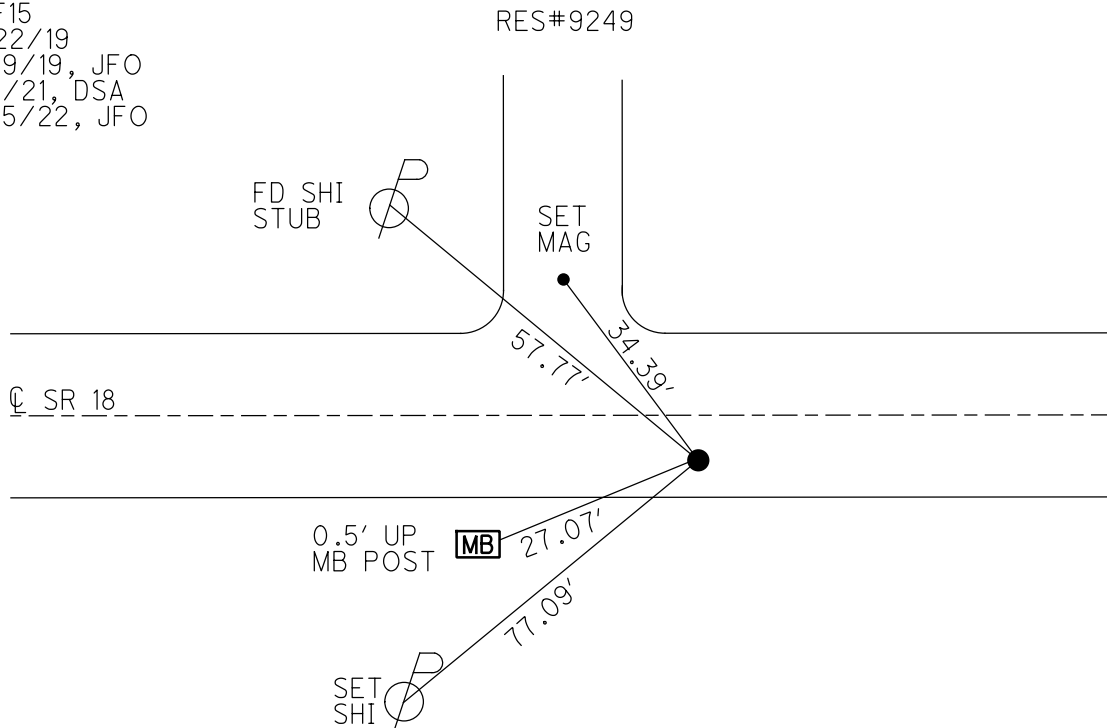

O.D.O.T. DISTRICT 2 SURVEY OFFICE (USE ONLY)

PERSONNEL

REFERENCE NO. 15

SHEET 12 OF 48

NOTES BARNHISEL

DATE 7/11/97

ROUTE SR 18

H.C. CANTERBURY

WEATHER SUNNY

COUNTY SENECA

R.C. ROUSOS

TEMP. 75°

TOWNSHIP LOUDON

SECTION 15

DWG BY NIESE PID NO PID

T 2 N R 13 E

TYPE MONUMENT P.K./WASHER

ON SURFACE - ~~BELOW~~ ON

OFFSET CL PAVEMENT 7.2' ~~LT~~ : RT

4.5' TO RT EDGE PAVEMENT


STATION: 242+80.39

HORIZ.DATUM: NAD83(2011)

GEOID: 2012A


GRID: NORTHING: 535676.918

EASTING: 1734805.713

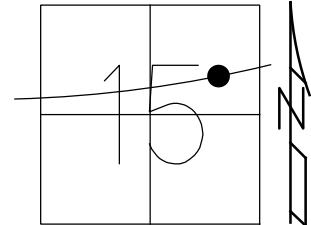

RECORD: P.I.
 $\Delta = 09^{\circ} 54' 00''$ LT
STA.242+80.39
FD P.K./WASHER
7/11/97, MB
SET P.K./WASHER
11/6/97, MB
FD P.K./WASHER
REF15
4/22/19
8/19/19, JFO

RES#9249

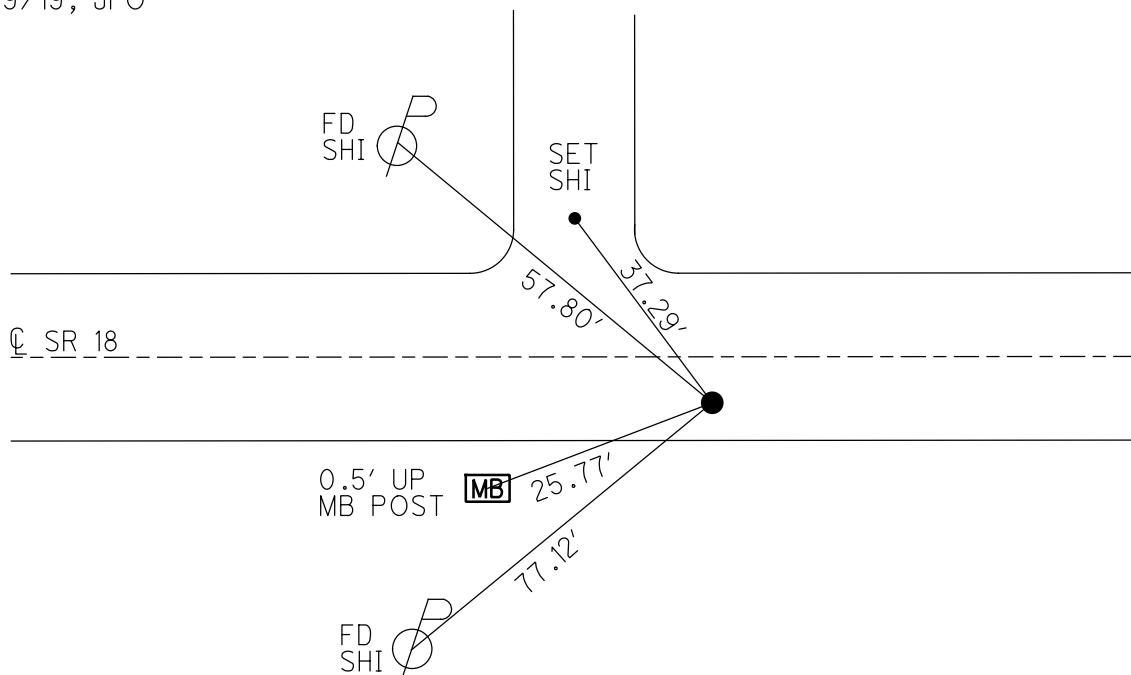

O.D.O.T. DISTRICT 2 SURVEY OFFICE

PERSONNEL

REFERENCE NO. 15

SHEET 17 OF 22

NOTES BARNHART

H.C. CANTERBURY

R.C. Rousar

P. WEAVER

DRAWN BY Rousar

DATE 7-11-97

WEATHER SUNNY

TEMP. +75°

ROUTE 18

COUNTY SENECA

TOWNSHIP LODON

SECTION 15

T. 2 N. R. 13 E.


TYPE MONUMENT PK WASHER

ON SURFACE - ~~BELOW~~ ON SURFACE

LEFT ~~C~~ PAN'T. - RIGHT 7.2 RT

4.5 TO RT EDGE PAVEMENT

S.L.M. 71 777.7 SLK

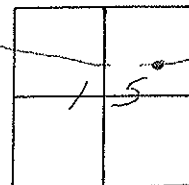


RESET PK/WASHER
11-6-97
MB

PI SURVEY

$\Delta = 09^{\circ}54'00.17$

292+80.39

RES #9249

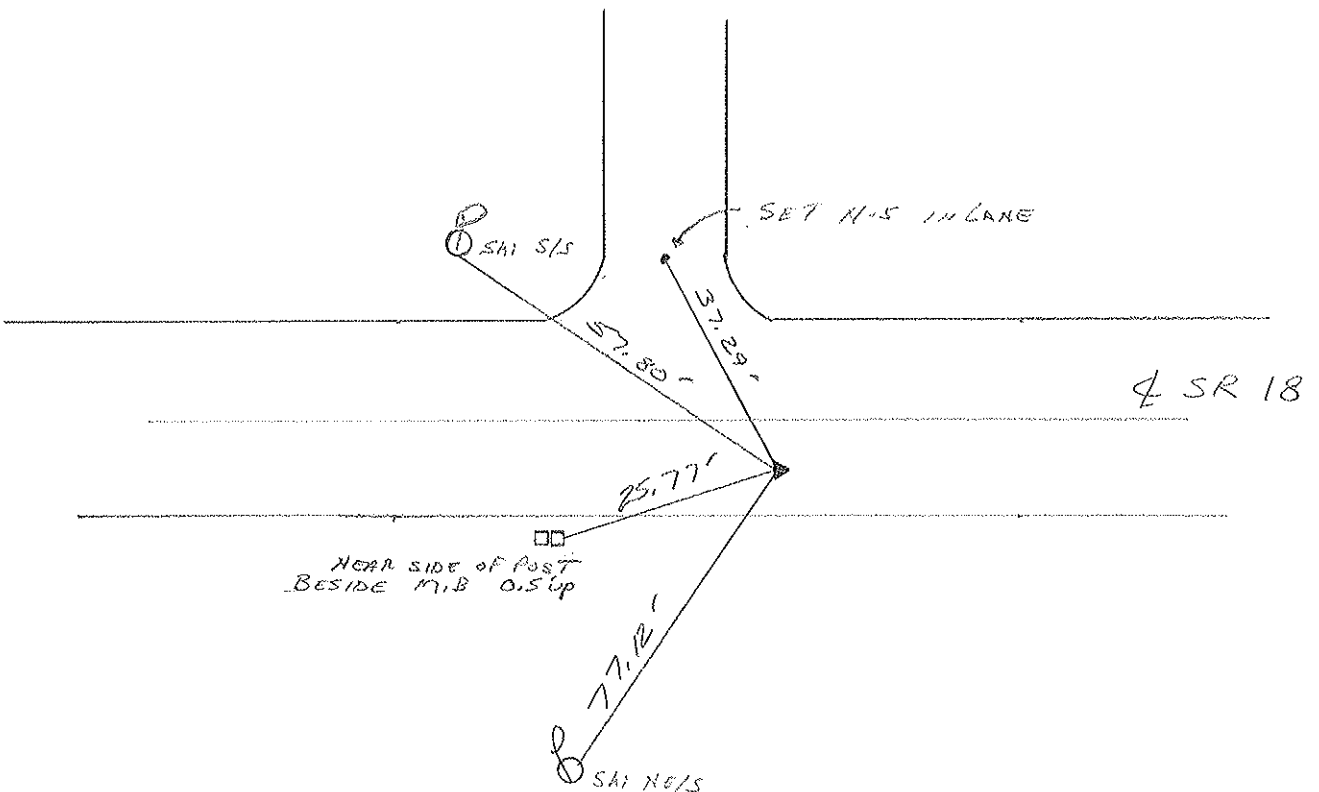

O.D.O.T. DISTRICT 2 SURVEY OFFICE

PERSONNEL

NOTES

H.C.

R.C.

REFERENCE NO. 15

DRAWN

DATE

WEATHER

TEMP.

SHEET 17 OF

ROUTE

COUNTY

TOWNSHIP

SECTION

T 2 N R 13 E

TYPE MONUMENT

ON SURFACE - BELOW

LEFT - & PAV'T. - RIGHT

TO

EDGE PAVEMENT

S.L.M.

11/19/90

1/22/90

OVERCAST-WINDY

37°

#18


SENECA

LOVDON

15

P.K. WASHER

7±

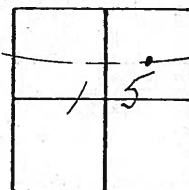

P.E. SURVEY

A = 09° 54' 00" LT.

242+80.39

N.E.S. in
LANE


42.69'

57.79'

77.09'

2.50R S.R. #18

PERSONNEL	TITLE	PERSONNEL	TITLE	COUNTY	DATE	S. R.	WEATHER	TEMP.	JOB NO.
Schneider		Potts		Seneca	10-17-68	18	Cloudy	60°	
Mosser									
Barbour									
Redding									
DESCRIPTION				Ties for Control Points					

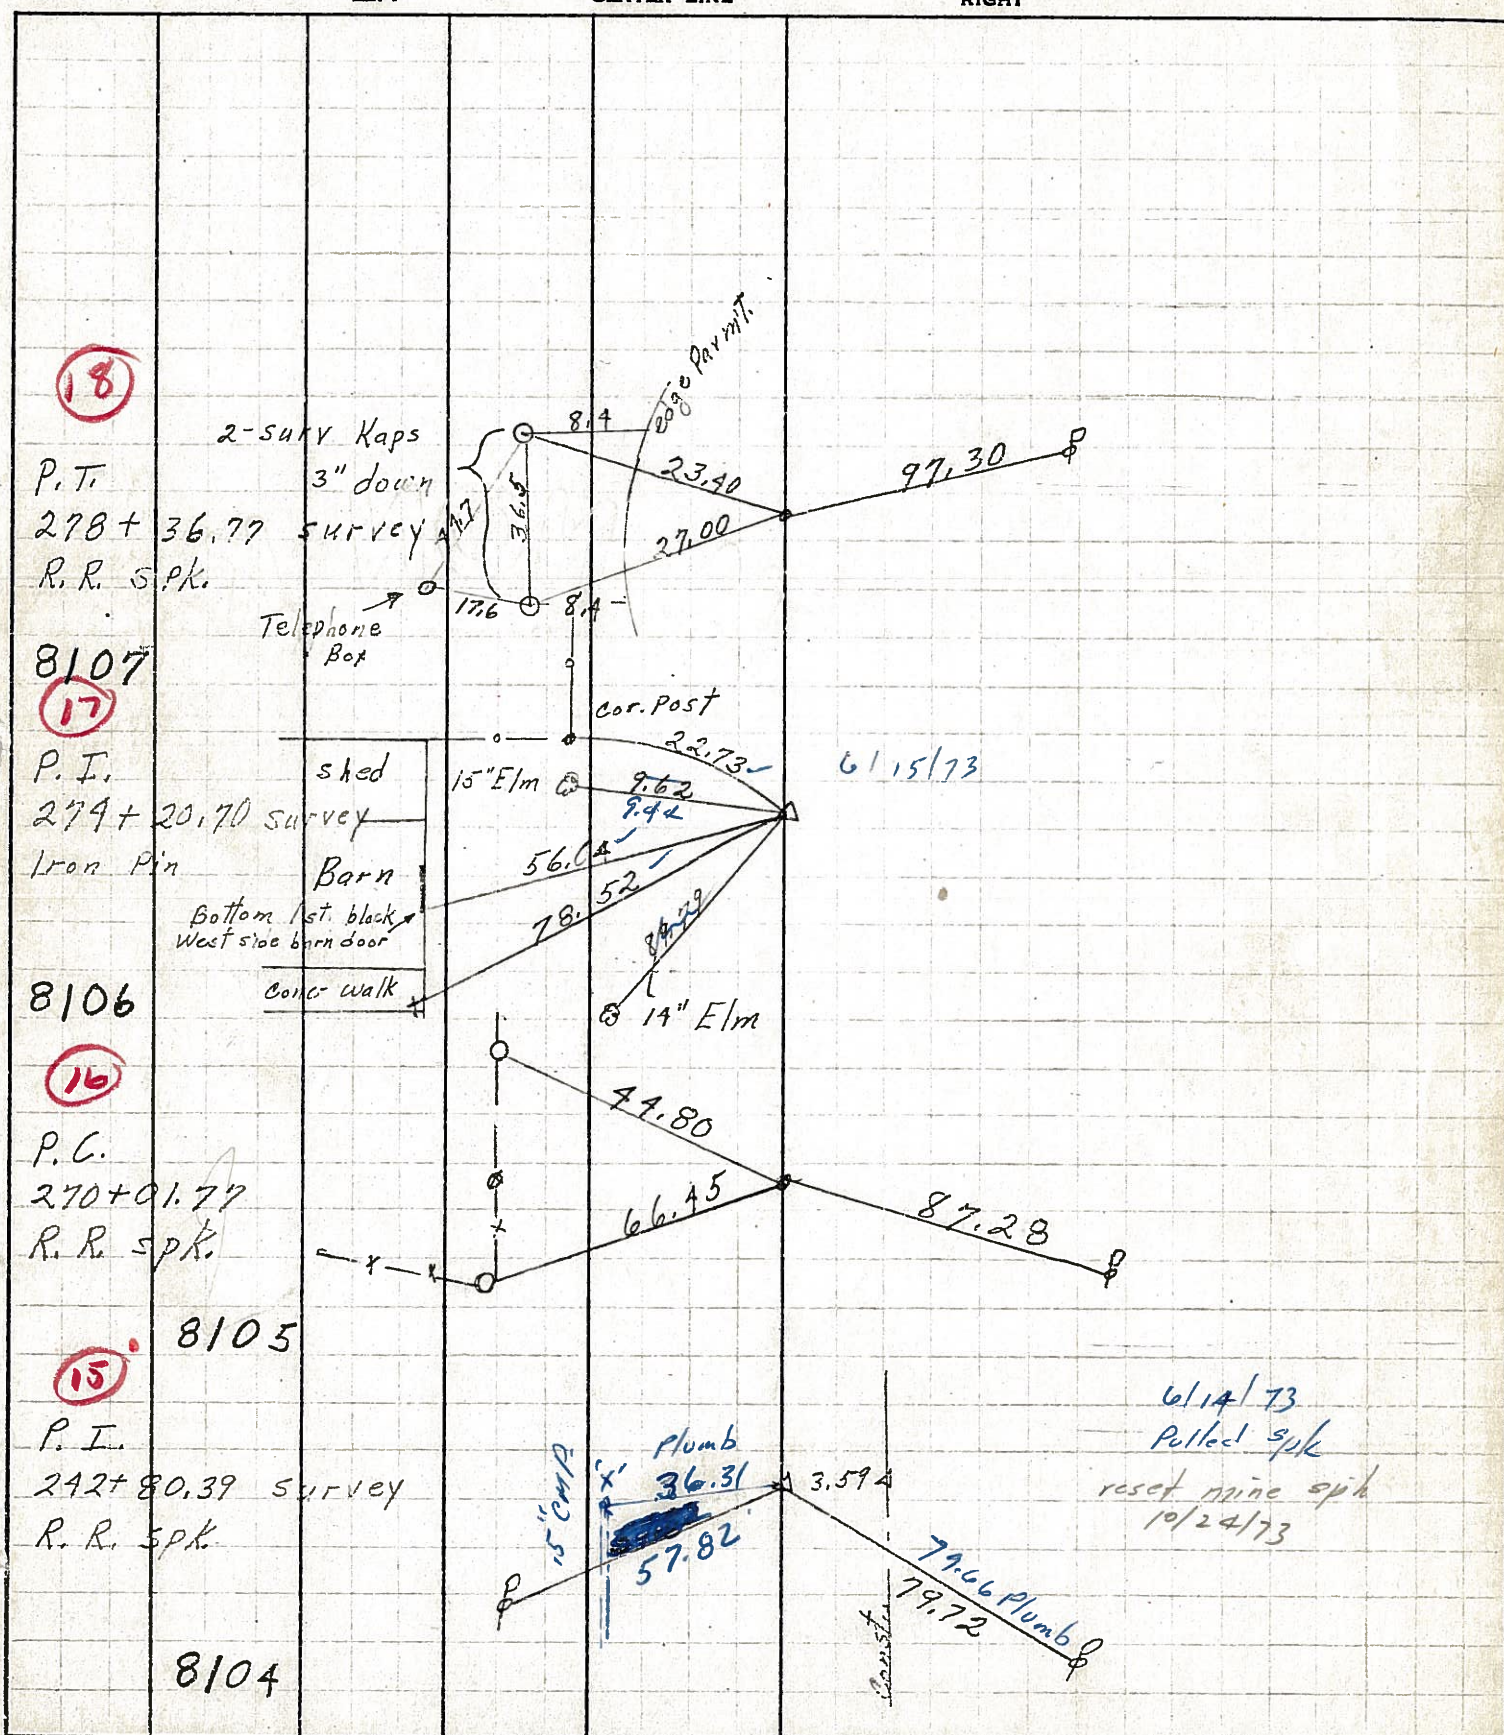

PERSONNEL TITLE PERSONNEL TITLE

Schneider

Potts

COUNTY Seneca

DATE 10-17-68

Mosser

S. R. 18

WEATHER Cloudy

Barbour

SEC. Fostoria To Bascom

TEMP. 60°

Redding

DESCRIPTION Tied for Control Points

JOB NO.

LEFT

CENTER LINE

RIGHT

2-SURV Kaps

3" down

P.T.

278+36.77 Survey

R.R. SPK.

8107

Telephone Box

Cor. Post

P.I.

279+20.70 Survey

Iron Pin

8106

Shed

15" E/m C.

Barn

Bottom 1st. black
West side barn door

Cong. Walk

P.C.

270+01.77

R.R. SPK.


8105

P.I.

292+80.39 Survey

R.R. SPK.

8104

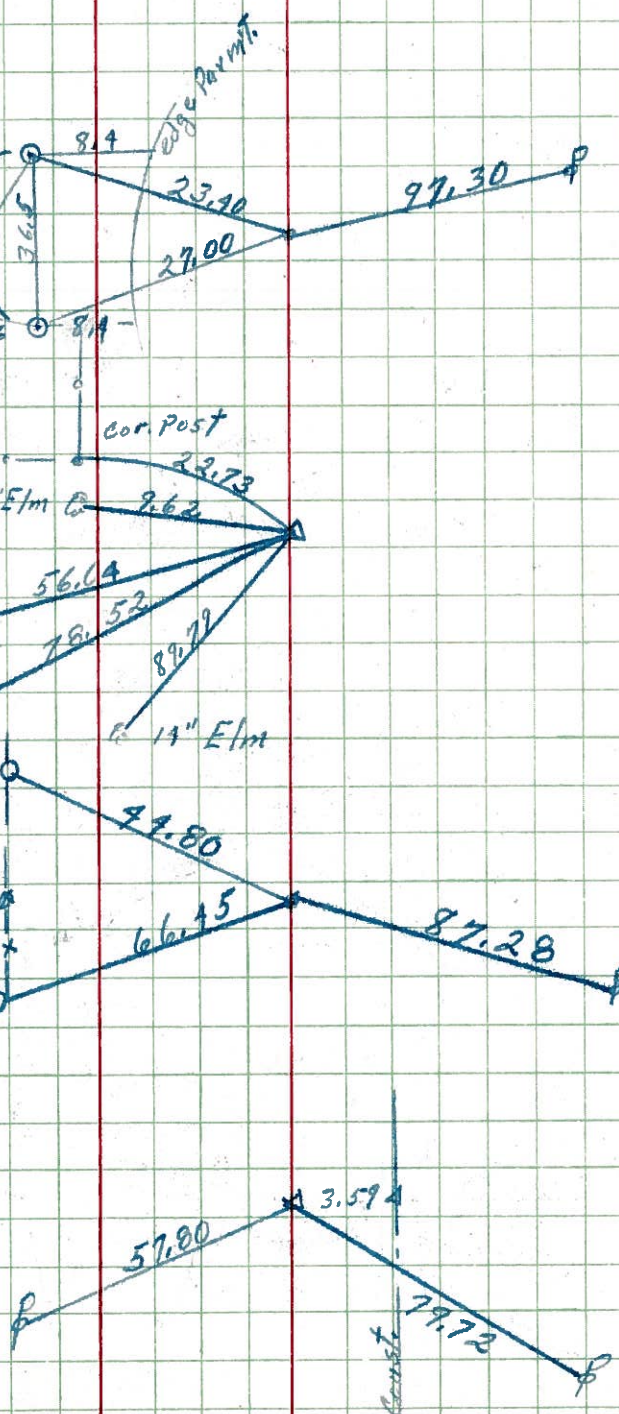


PERSONNEL	TITLE	PERSONNEL	TITLE	COUNTY	DATE	S. R.	WEATHER	TEMP.
Schneider		Potts		Seneca	10-17-68	18	Cloudy	60°
Mosser								
Barbour								
Redding								
DESCRIPTION				Ties for Control Points		JOB NO.		

LEFT

CENTER LINE

RIGHT

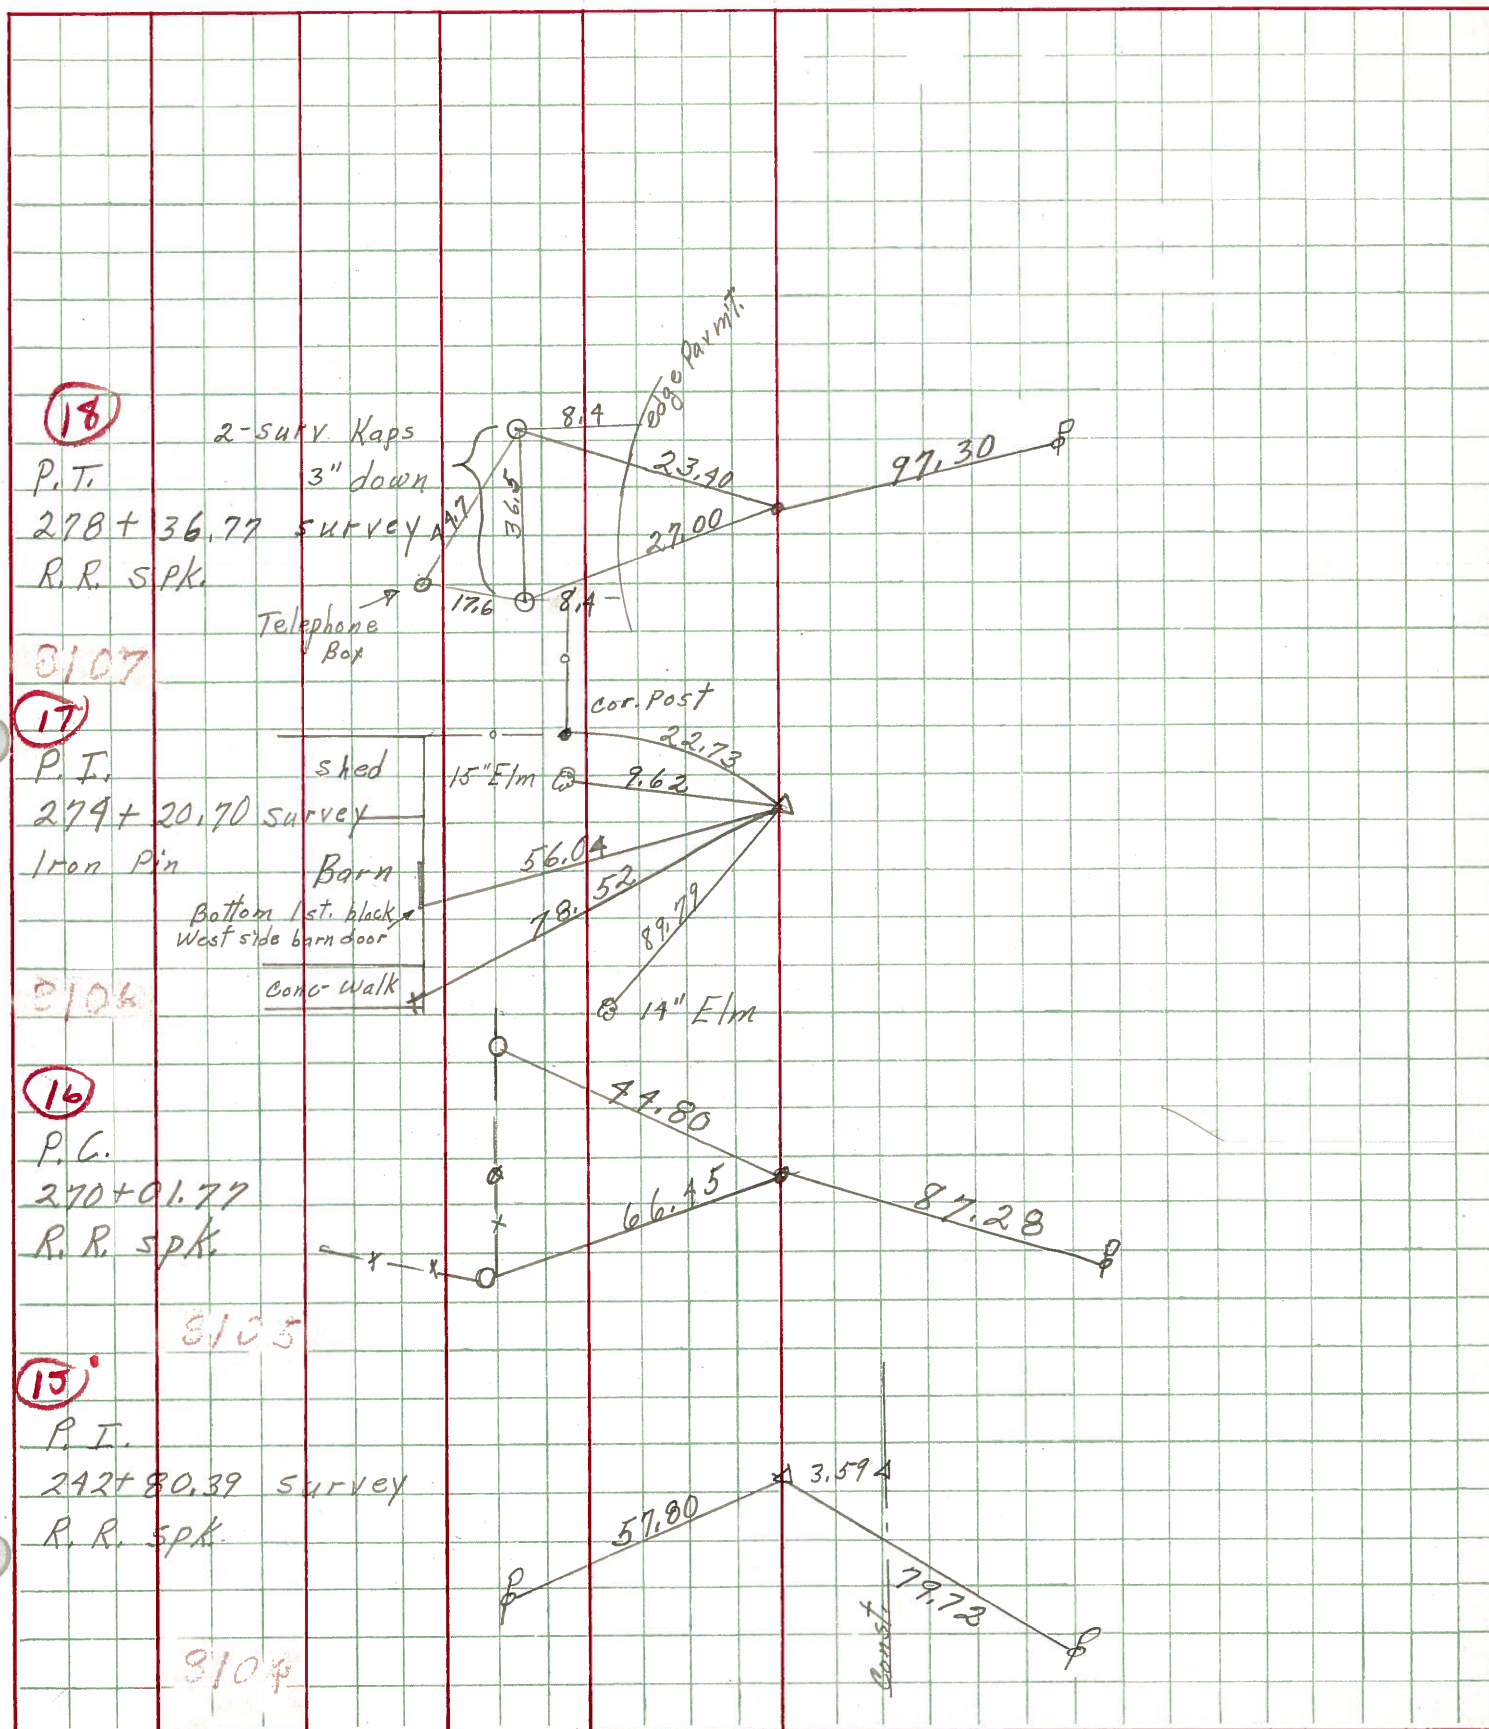

PERSONNEL TITLE PERSONNEL TITLE

COUNTY Seneca

DATE Dec. 23, '58

HSH
Cromin
LeemasterLahr
John K.

S. R. #18 Fosteriz-Brown Rd. WEATHER Clear

SEC. Sen.-18(179-860) TEMP. 40°

DESCRIPTION Control Point Ties - Survey + Const.

JOB NO.

LEFT

CENTER LINE Survey

RIGHT

