

O.D.O.T. DISTRICT 2 SURVEY OFFICE (USE ONLY)

PERSONNEL

REFERENCE NO. 17A

SHEET OF

NOTES BARRIERE

DATE 8/15/24

ROUTE SR 18

H.C. NIESE

WEATHER SUNNY

COUNTY SENECA

R.C. MILLER

TEMP. 76°

TOWNSHIP LOUDON

DWG BY BARRIERE

PID 92371

SECTION 14

T 2 N R 13 E

TYPE MONUMENT MAG NAIL/WASHER

ON SURFACE - BELOW ON

OFFSET $\mathcal{C}$ PAVEMENT 14' LT LT : RT

 TO EDGE PAVEMENT

STATION: 282+31.06

HORZ.DATUM: NAD83 (2011)


GEOID: 18

GRID: NORTHING: 536080.718


EASTING: 1738722.920

LDP: NORTHING:

EASTING:

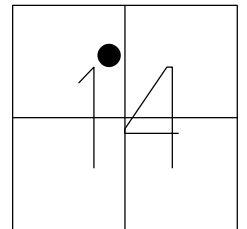

RECORD: P.I.
 $\Delta = 07^{\circ}20'00''$ RT
 STA.282+31.06
 FD R.R.SPIKE
 4" DOWN
 7/1/97, MB
 SET P.K./WASHER
 11/6/97, MB
 FD R.R.SPIKE
 4" DOWN
 REF18
 3/23/18, JLL
 REFA17
 4/22/19
 8/19/19, JFO
 9/1/21, DSA
 2/15/22, JFO
 2/10/23, JMR
 SET MAG/WASHER
 REF17A
 8/15/24, TDN

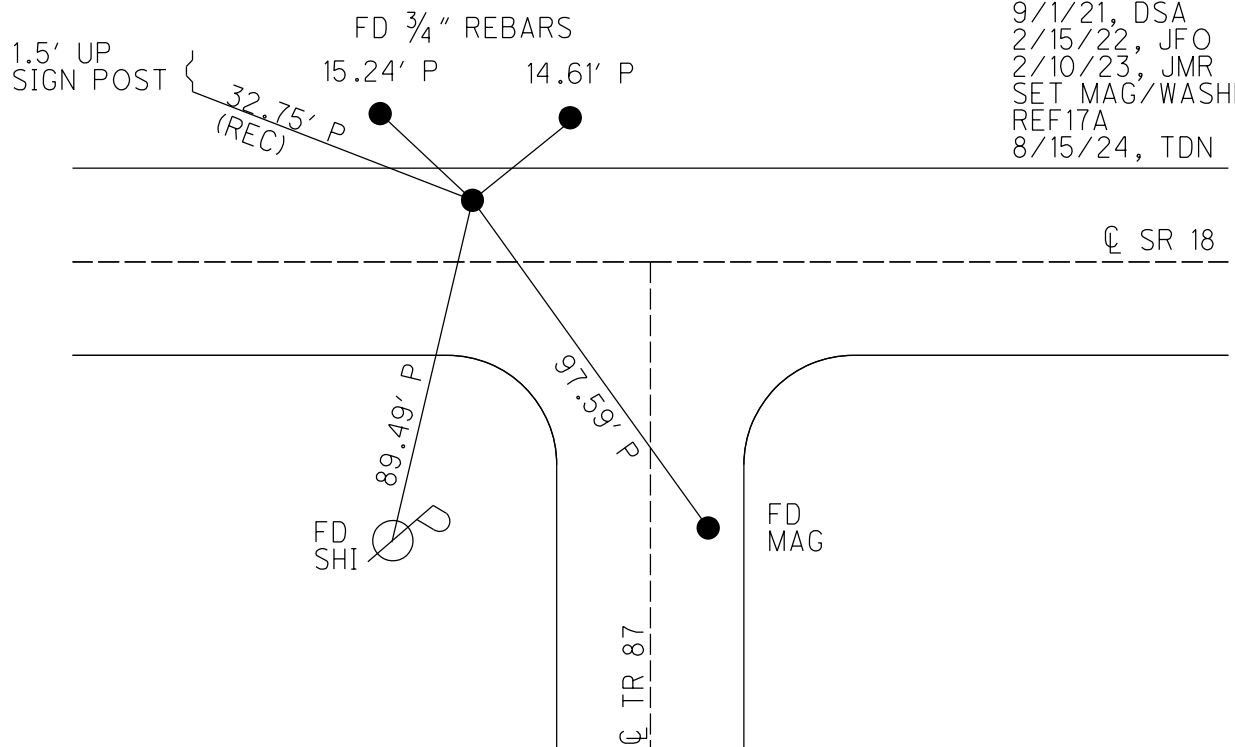

O.D.O.T. DISTRICT 2 SURVEY OFFICE (USE ONLY)

PERSONNEL

REFERENCE NO. 17 A

SHEET 15 OF 48

NOTES AUBLE

DATE 9/1/21

ROUTE SR 18

H.C. NIESE

WEATHER WINDY

COUNTY SENECA

R.C. AUBLE

TEMP. 76°

TOWNSHIP LOUDON

SECTION 14

DWG BY RHOADES PID PVTRAIN

T 2 N R 13 E

TYPE MONUMENT R.R. SPIKE

~~ON SURFACE~~ - BELOW 4"

OFFSET CL PAVEMENT 14' LT : ~~RT~~

2.7' LT TO LT EDGE PAVEMENT


STATION: 282+31.06

HORIZ.DATUM: NAD83(2011)


GEOID: 2012A

GRID: NORTHING: 536080.704

EASTING: 1738722.951

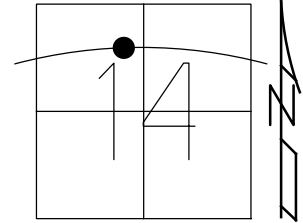

RECORD: P.I.
 $\Delta = 07^{\circ}20'00''$ RT
STA.282+31.06
FD R.R.SPIKE
4" DOWN
7/1/97, MB
SET P.K./WASHER
11/6/97, MB
FD R.R.SPIKE
4" DOWN
REF18
3/23/18, JLL
REF17
4/22/19
8/19/19, JFO
9/1/21, DSA
2/15/22, JFO
2/10/23, JMR

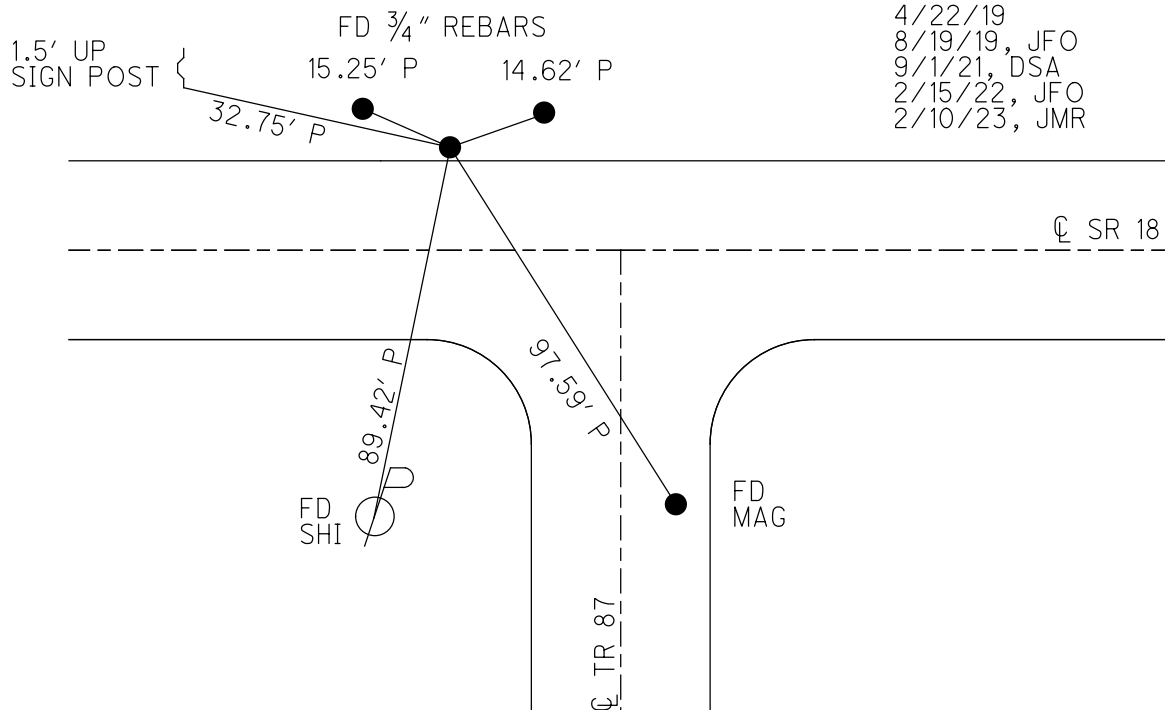

O.D.O.T. DISTRICT 2 SURVEY OFFICE (USE ONLY)

PERSONNEL

REFERENCE NO. 17 A

SHEET 15 OF 48

NOTES AUBLE

DATE 9/1/21

ROUTE SR 18

H.C. NIESE

WEATHER WINDY

COUNTY SENECA

R.C. AUBLE

TEMP. 76°

TOWNSHIP LOUDON

SECTION 14

DWG BY RHOADES

PID PVTRAIN

T 2 N R 13 E

TYPE MONUMENT R.R. SPIKE

~~ON SURFACE~~ - BELOW 4"

OFFSET Q PAVEMENT 14' LT : ~~RT~~

2.7' TO LT EDGE PAVEMENT


STATION: 282+31.06

HORZ.DATUM: NAD83(2011)


GEOID: 2012A

GRID: NORTHING: 536080.704

EASTING: 1738722.951

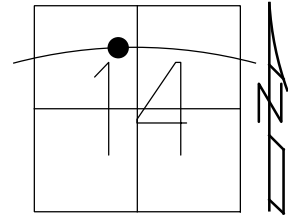

RECORD: P.I.
 $\Delta = 07^{\circ}20'00''$ RT
STA.282+31.06
FD R.R.SPIKE
4" DOWN
7/1/97, MB
SET P.K./WASHER
11/6/97, MB
FD R.R.SPIKE
4" DOWN
REF18
3/23/18, JLL
REF17
4/22/19
8/19/19, JFO
9/1/21, DSA
2/15/22, JFO

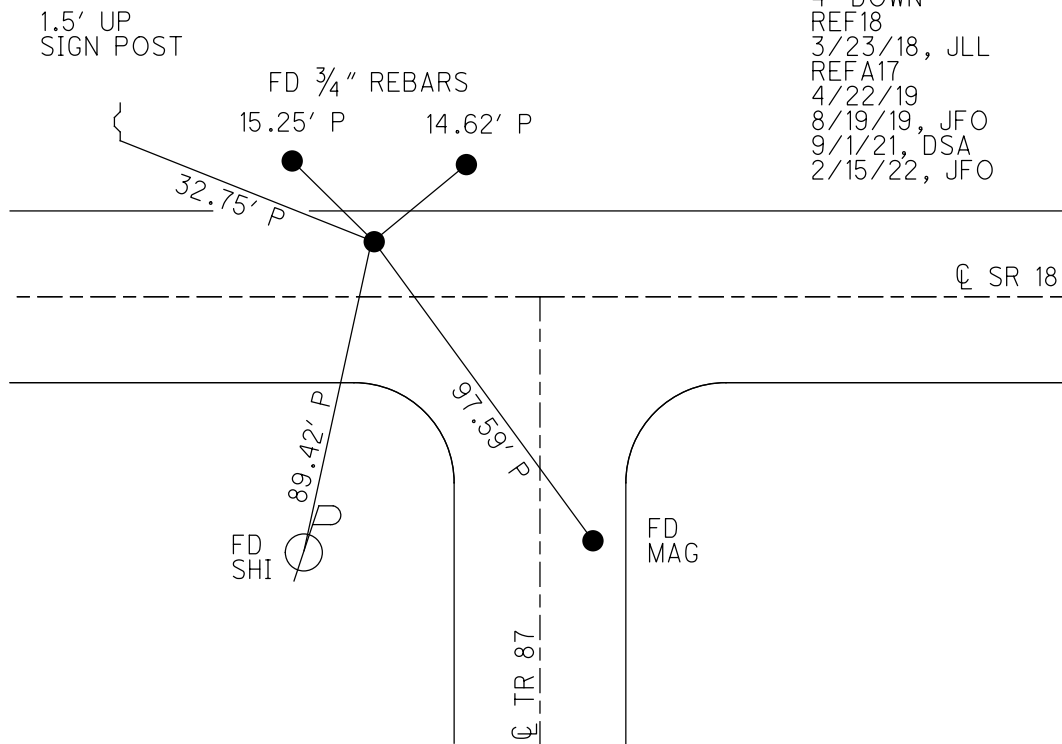

O.D.O.T. DISTRICT 2 SURVEY OFFICE (USE ONLY)

PERSONNEL

REFERENCE NO. 17 A

SHEET 15 OF 48

NOTES AUBLE

DATE 3/23/18

ROUTE SR 18

H.C. LEU

WEATHER SUNNY

COUNTY SENECA

R.C. AUBLE

TEMP. 34°

TOWNSHIP LOUDON

SECTION 14

DWG BY NIESE PID 101340

T 2 N R 13 E

TYPE MONUMENT R.R. SPIKE

~~ON SURFACE~~ - BELOW 4"

OFFSET Q PAVEMENT 14' LT : ~~RT~~

2.7' TO LT EDGE PAVEMENT


STATION: 282+31.06

HORIZ.DATUM: NAD83(2011)


GEOID: 2012A

GRID: NORTHING: 536080.704

EASTING: 1738722.951

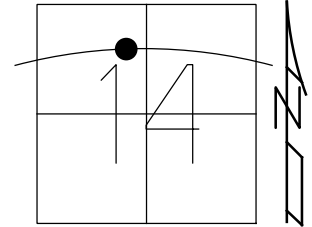

RECORD: P.I.
 $\Delta = 07^{\circ}20'00''$ RT
STA. 282+31.06
FD R.R. SPIKE
4" DOWN
7/1/97, MB
SET P.K./WASHER
11/6/97, MB
FD R.R. SPIKE
4" DOWN
REF18
3/23/18, JLL
REFA17
4/22/19
8/19/19, JFO

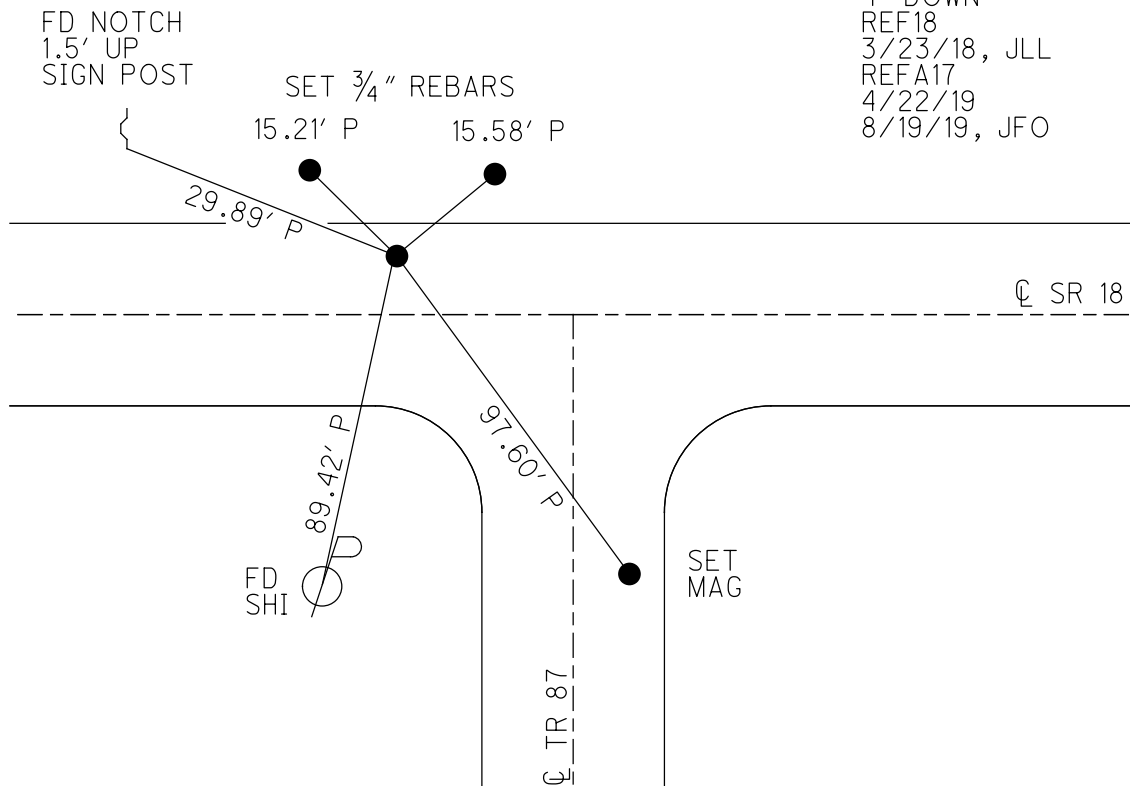

O.D.O.T. DISTRICT 2 SURVEY OFFICE

PERSONNEL

REFERENCE NO. _____

SHEET 20 OF 22

NOTES Barnhisel

H.C. Canterbury

R.C. Rousar

W. Weaver

Drawn By Rousar

DATE 7-11-97

WEATHER Sunny

TEMP. 17.5°

ROUTE 18

COUNTY SENECA

TOWNSHIP London

SECTION 14

T 2 N R 13 E


TYPE MONUMENT RR Spike

ON SURFACE - BELOW 4.0"

LEFT - CL PAW'T. - RIGHT 19.0'

2.7 TO LT EDGE PAVEMENT

S.L.M. 8+980.5

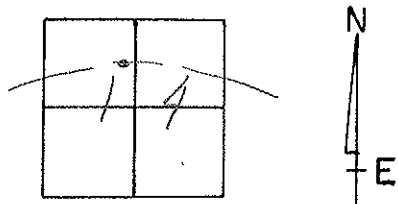

RESET P.K. & WASHER


11-6-97

M.B.

P.I. SURVEY

$\Delta = 07^{\circ}20'00''$ Rt

282131.06

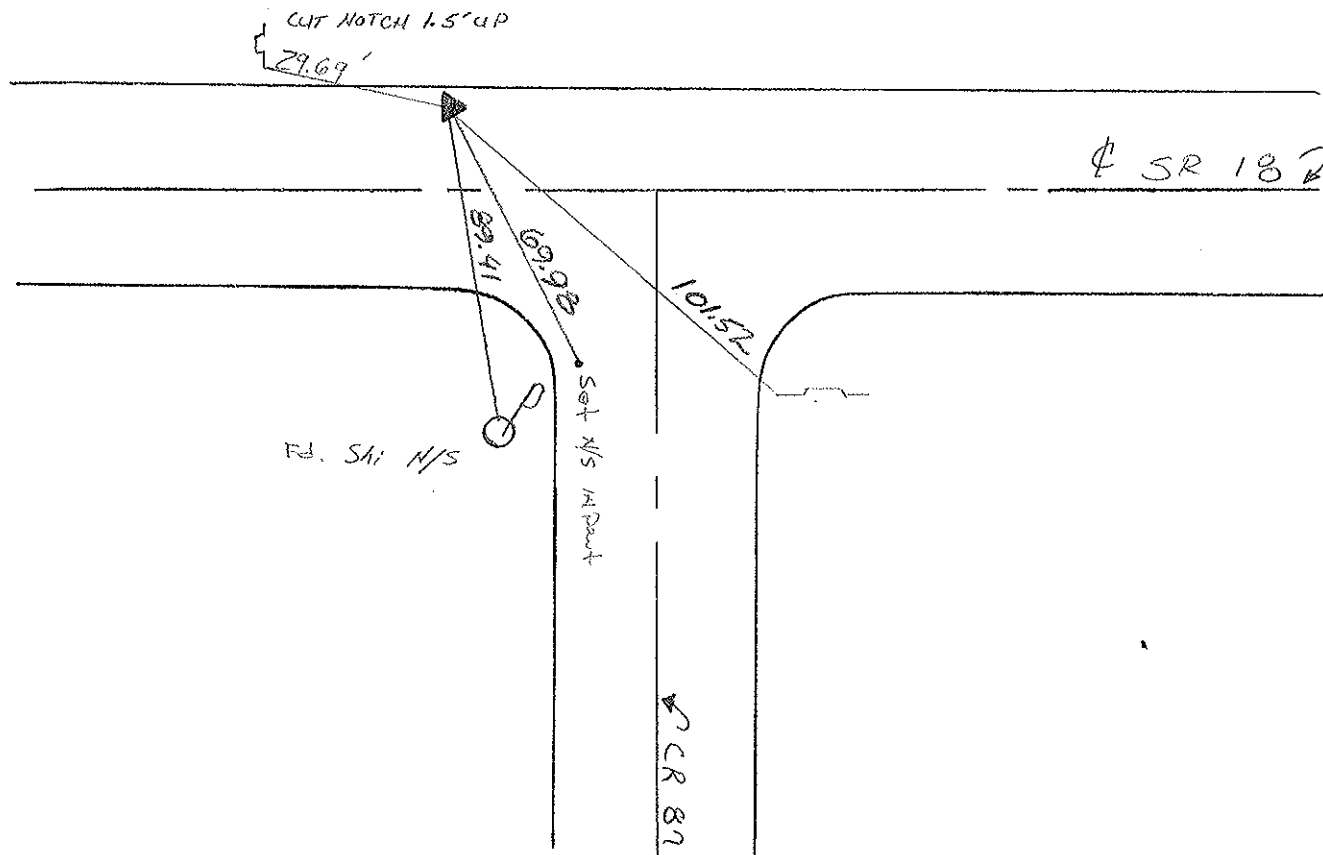

O.D.O.T. DISTRICT 2 SURVEY OFFICE

PERSONNEL

NOTES CROWN

H.C. RIPPLE

R.C. GARBOUR

GEYMAN

REFERENCE NO. 19

DRAWN 1/19/90

DATE 1/22/90

WEATHER OVERCAST

TEMP. 37°

SHEET 20 OF

ROUTE #18

COUNTY SENECA

TOWNSHIP LODGE

SECTION 14

T. 2 N. R. 13 E.

TYPE MONUMENT I.P.N. OR R.R. SPIKE


ON SURFACE - BELOW 6"±

LEFT - CL PAV'T. - RIGHT 14±

TO EDGE PAVEMENT

S.L.M.


17-A

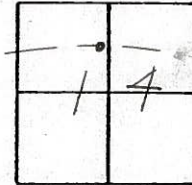

P.I. SURVEY


A = 07°20'00" Rt.

282+31.06

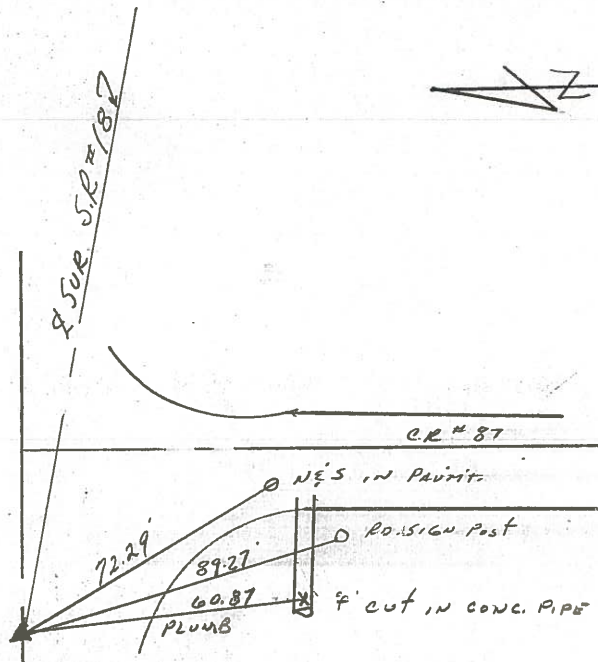


PERSONNEL	TITLE	PERSONNEL	TITLE	COUNTY	DATE	S. R.	WEATHER	TEMP.
Schneider		Potts		Seneca	10-17-68	18	Cloudy	70°
Nasser								
Barbour								
Redding								
DESCRIPTION				Tie for Control Points		JOB NO.		
LEFT		CENTER LINE		RIGHT				

(22) P.I.
352+29.75
Iron Pin
8111

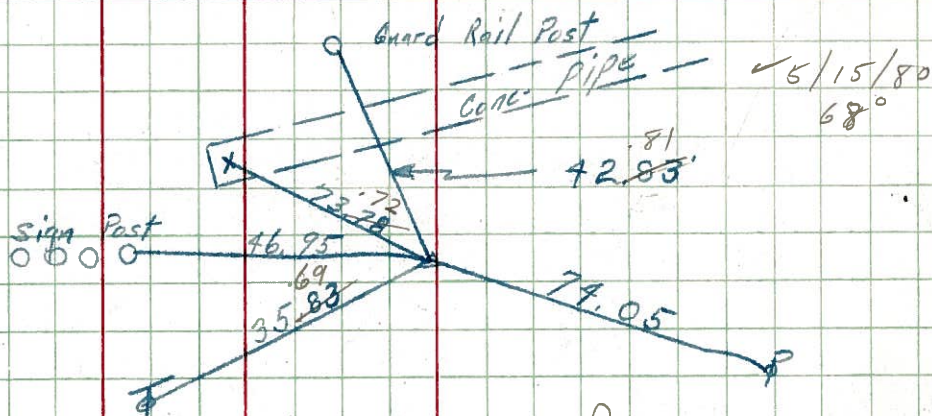


(21) P.I.
339+11.05
Iron Pin
8110

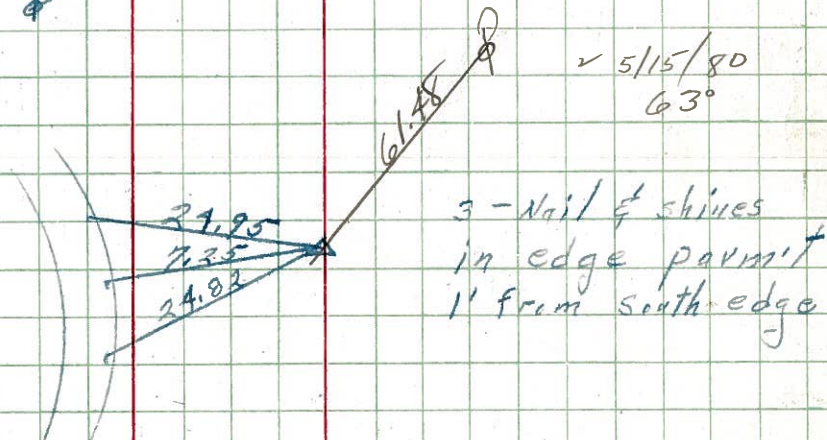

(20) P.I.
327+63.25 (Survey)
R.R. spk.
8109



et I. Pipe on Top
(X) P.I.
282+31.67 (Survey)
R.R. spk. 7" down
1 1/2' off edge Parmit.
8108

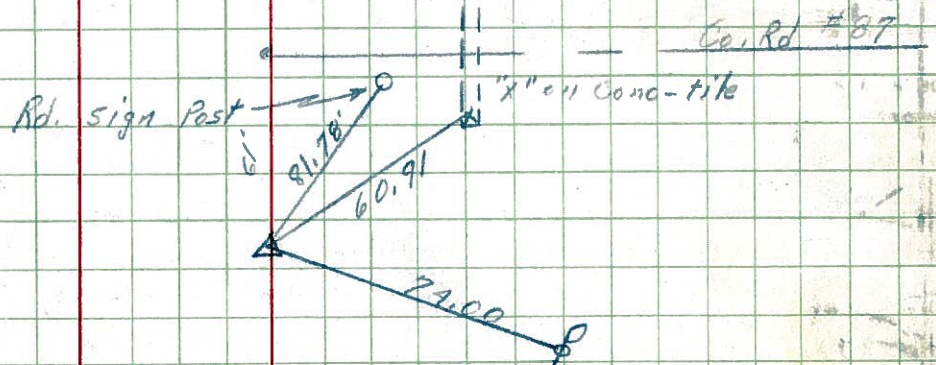

608 LW
Tried to hit flag man

Resurveyed 2001

SHEET NO. 6

PERSONNEL	TITLE	PERSONNEL	TITLE	COUNTY	DATE	WEATHER	TEMP.
Schneider		Potts		Seneca	10-17-68	cloudy	70°
Mosser				S. R. 18			
Barbour				SEC. Fostoria to Bascom			
Redding							

DESCRIPTION Tie for Control Points JOB NO. _____

