

O.D.O.T. DISTRICT 2 SURVEY OFFICE (USE ONLY)

PERSONNEL

REFERENCE NO. 20

SHEET OF

NOTES BARRIERE

DATE 8/15/24

ROUTE SR 18

H.C. NIESE

WEATHER CLDY/WNDY

COUNTY SENECA

R.C. MILLER

TEMP. 63°

TOWNSHIP LOUDON

DWG BY BARRIERE

PID 92371

T 2 N R 13 E

TYPE MONUMENT MAG NAIL/WASHER

ON SURFACE - BELOW ON

OFFSET $\varnothing$ PAVEMENT 4' LT LT : RT

 TO EDGE PAVEMENT

STATION: 340+23

HORIZ.DATUM: NAD83 (2011)


GEOID: 18

GRID: NORTHING: 535098.180

EASTING: 1743113.553


LDP: NORTHING:

EASTING:

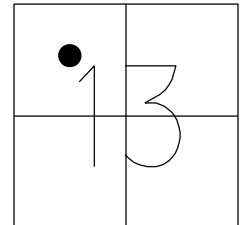

RECORD: P.I.
RR SPIKE
P.K./SHI
R.R.SPIKE
FD P.K./WASHER
6/28/01, JFO
SET P.K./WASHER
7/31/01, SAH
FD P.K./WASHER
REF20
4/22/19
8/19/19, JFO
FD RR SPIKE
3" DOWN
REF20
9/28/22, TDN
SET MAG/WASHER
REF20
8/15/24, TDN

REF 20A
FD MAG NAIL
REFA20
4/22/19, JFO
NORTHING: 535098.138
EASTING: 1743118.440
D.N.F.
9/22/22, TDN

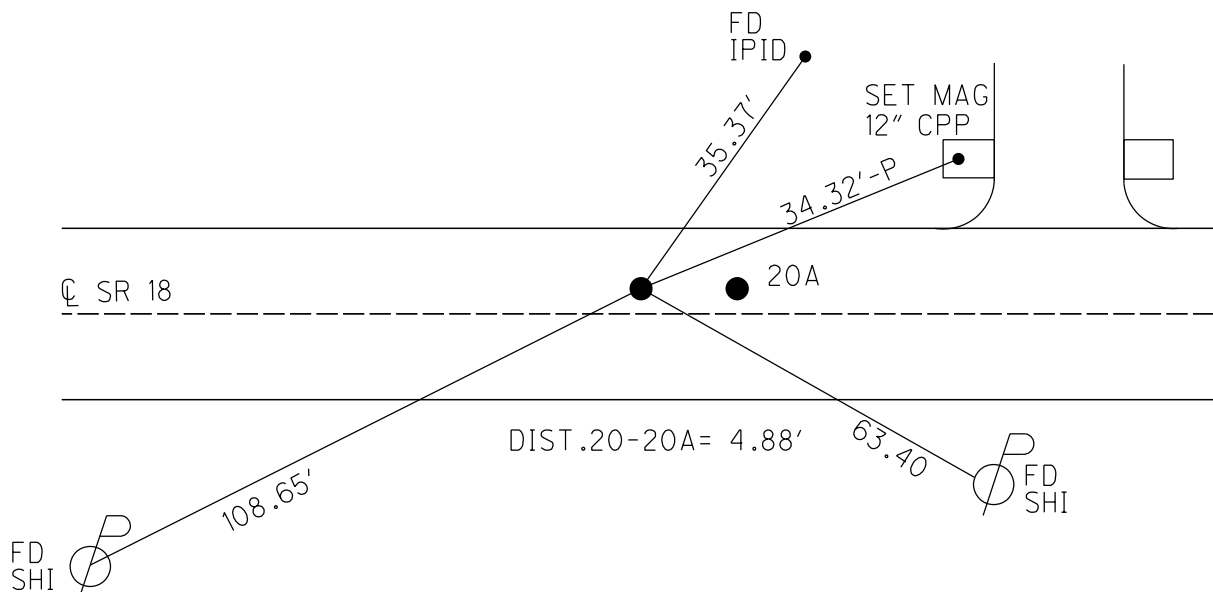

O.D.O.T. DISTRICT 2 SURVEY OFFICE (USE ONLY)

PERSONNEL

REFERENCE NO. 20

SHEET 19 OF 48

NOTES CORDES
H.C. HOMAN
R.C. VAN DUSEN
CANTERBURY

DATE 6/28/01
WEATHER SUNNY
TEMP. 90°

ROUTE SR 18
COUNTY SENECA
TOWNSHIP LOUDON
SECTION 13
T 2 N R 13 E

DWG BY NIESE PID NO PID

TYPE MONUMENT P.K./WASHER

ON SURFACE - ~~BELOW~~ ON

OFFSET Q PAVEMENT 4.0' LT : ~~RT~~

8.0' TO LT EDGE PAVEMENT


STATION: 340+23

HORZ.DATUM: NAD83(2011)

GEOID: 2012A


GRID: NORTHING: 535098.191

EASTING: 1743113.562

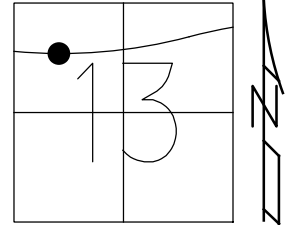

RECORD: P.I.
RR SPIKE
P.K./SHI
R.R.SPIKE
FD P.K./WASHER
6/28/01, JFO
SET P.K./WASHER
7/31/01, SAH
FD P.K./WASHER
REF20
4/22/19
8/19/19, JFO

REF 20A
FD MAG NAIL
REFA20
4/22/19, JFO
NORTHING: 535098.138
EASTING: 1743118.440

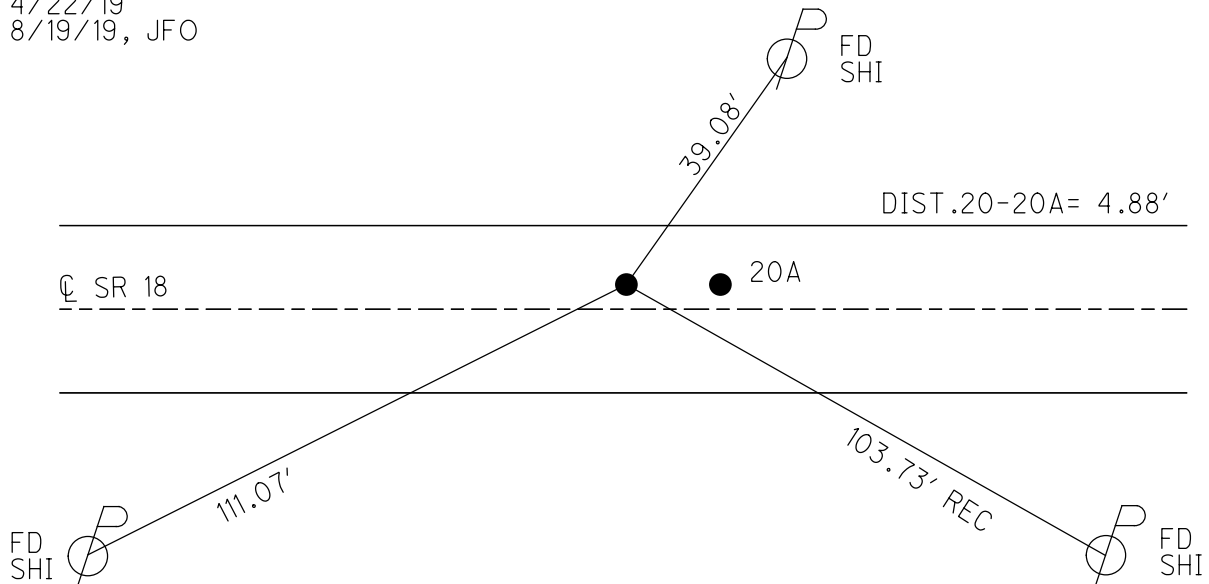

O.D.O.T. DISTRICT 2 SURVEY OFFICE

PERSONNEL

REFERENCE NO. 20

SHEET 1 OF 26

NOTES B. CORDES

H.C. D. HOMAN

DATE 6-28-01

ROUTE 18

R.C. B. VAN DUSEN

WEATHER SUNNY

COUNTY SENECA

M. CANTERBURY

TEMP. +90°F

TOWNSHIP LOUDON

SECTION 13

T2 NR 13 E


TYPE MONUMENT PK/WASHER

ON SURFACE - BELOW YES

LEFT- & PAW'T. - RIGHT 4'

8.0' TO LT. EDGE PAVEMENT

S.L.M. 340+23

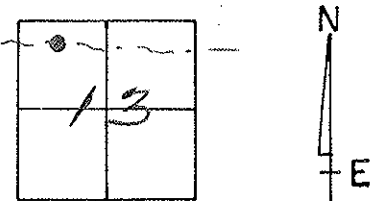

REC:

P.I. - PREVIOUS MONUMENTS

R.R. SPK.

PK/SHI.

R.R. SPK.


SET PK/WASHER

7-31-01

S.A.H.

& PAVEMENT

S.R. 18

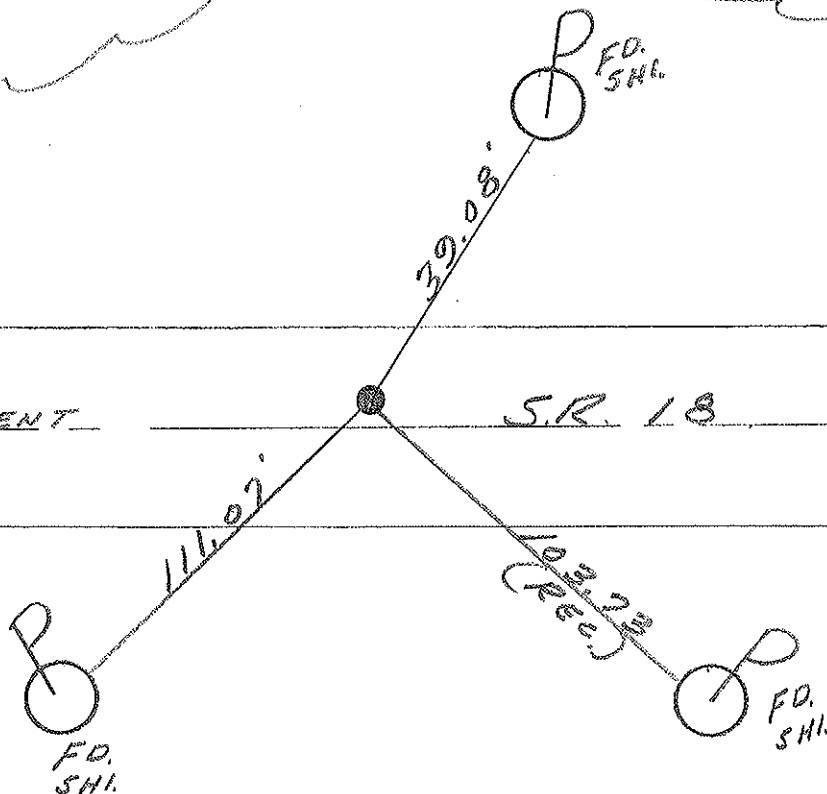

O.D.O.T. DISTRICT 2 SURVEY OFFICE

PERSONNEL

REFERENCE NO. 20

SHEET 1 OF 27

NOTES CHENEY

H.C. BARBOUR

R.C. RIPPLE

DATE 10-9-1991

WEATHER SUNNY

TEMP. 70°

ROUTE 18

COUNTY SENECA

TOWNSHIP LOUDON

SECTION 13

T2N R13E


TYPE MONUMENT SET PK/WASHER

ON SURFACE - BELOW

LEFT- & PAV'T. - RIGHT 4'

15.5 TO S. EDGE PAVEMENT

S.L.M. 340+10

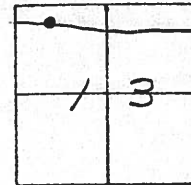


P.I. - PREVIOUS MONUMENTS:

R.R. SPK.

PK/SHI.

R.R. SPK.

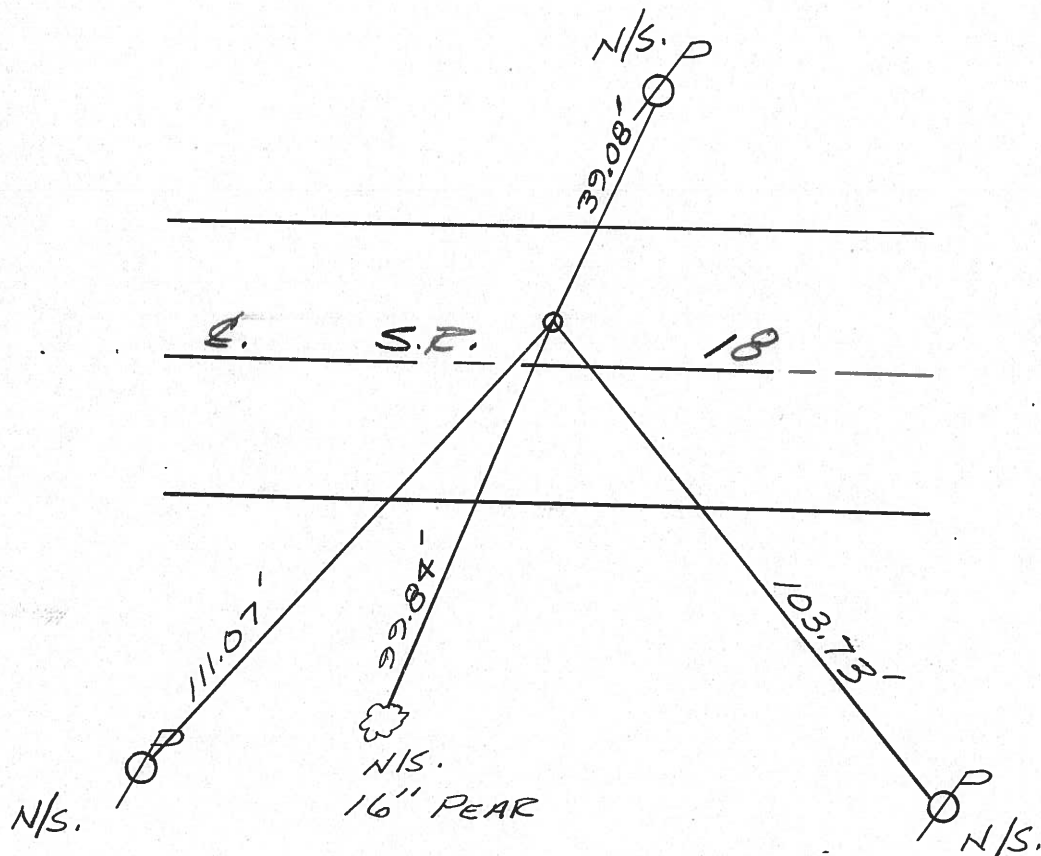

QD.O.T. DISTRICT 2 SURVEY OFFICE

Sht. of

County Seneca S.R. # 18

Township London

Section 13

T₂N, R₃E

Personnel Schneider

Mosser

Barbour


Cronin

Ripple Geyman

Date OK-9-10-80 C.W.S.
5-15-80

Weather Fair


Temp. 58°

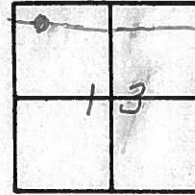

20



S.R. # 18

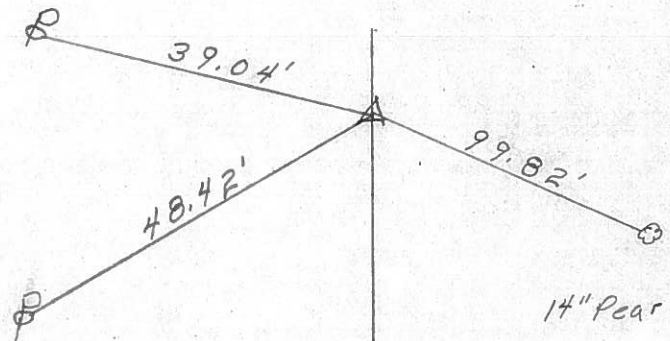

P.I.

327+63.25 SURVEY

R.R. SPK.


SET P.K. & SHI.

PERSONNEL	TITLE	PERSONNEL	TITLE	COUNTY	DATE	S. R.	WEATHER	TEMP.
Schneider		Pattis		Seneca	10-17-68	18	cloudy	70°
Masser								
Barbour								
Redding								
DESCRIPTION Tie for Control Points				SEC. Fosteria to Baseom		JOB NO.		
LEFT		CENTER LINE		RIGHT				

(22)

P.I.
352+29.75
Iron Pin


8111

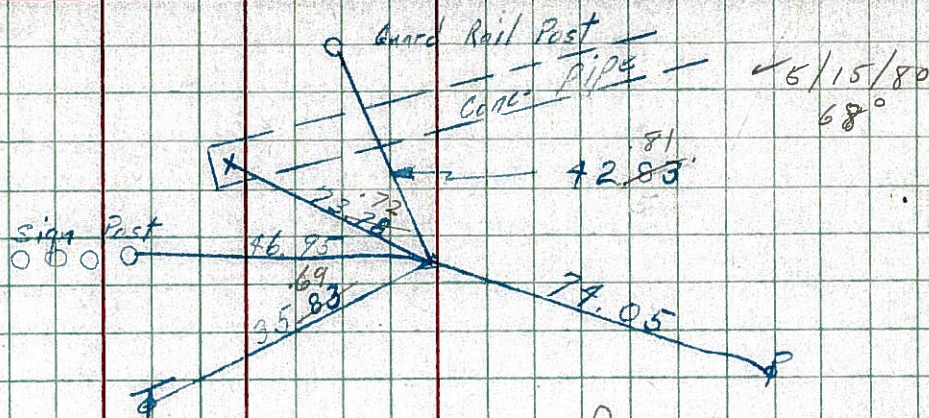

(21)

P.I.
339+11.05
Iron Pin


8110

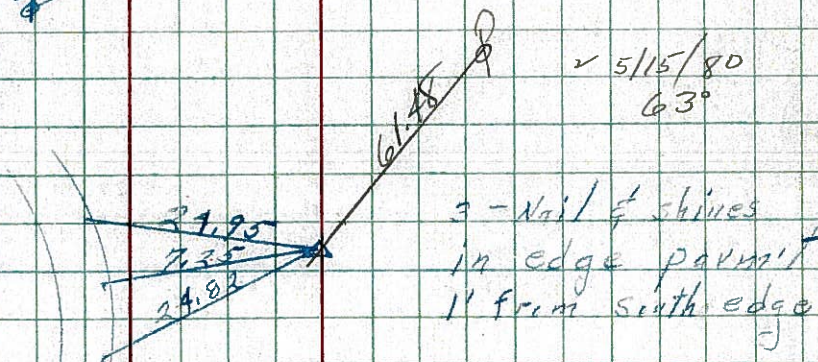

(20)

P.I.
327+63.25 (Survey)
R.R. Spk.

8109

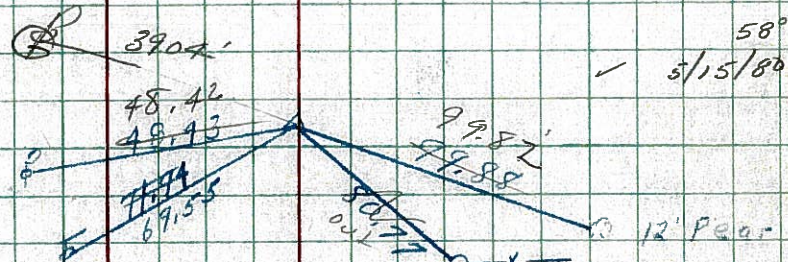


et I. Pipe on Top

(19)

P.I.
282+31.67 (Survey)
FA Spk. 7" down
1 1/2' off edge Parm. T.

8108

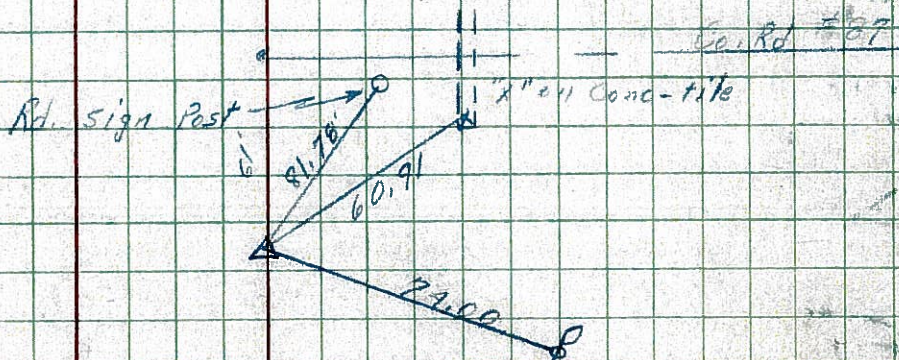

(17-A)

608 L W
Tried to hit flag man

Resurveyed 2001

SHEET NO. 6

PERSONNEL

TITLE

PERSONNEL

TITLE

Schneider

Potts

COUNTY Seneca

DATE 10-17-68

Mosser

S. R. 18

WEATHER cloudy

Barbour

SEC. Foster to Baseom TEMP 70°

Redding

DESCRIPTION Tie for Control Points

LEFT

CENTER LINE

RIGHT

JOB NO.

22

P.I.

352+09.75

Iron Pin

8111

Sign Post

Guard Rail Post

Conc. Pipe

42.83'

46.95'

35.83'

74.05'

21

P.I.

339+44.05

Iron Pin

8110

24.90'

7.35'

24.82'

3 - Nail & shines
in edge permit
1' from south edge

20

P.I.

327+63.25 (survey)

R.R. Spk.

8109

48.43'

69.55'

99.88'

80.77'

12" Pear

Co. Rd #87

Rd. sign Post

"X" on Conc. tile

81.78'

60.91'

24.00'

17A

19

P.I.

282+31.67 (survey)

R.R. Spk. 4" down

1 1/2' off edge Perm't.

8108

PERSONNEL TITLE PERSONNEL TITLE

Hsh

Cronin

Leemaster

L.Hr

John K.

COUNTY Seneca

DATE Jan. 6, '59

S. R. #18 Fostoria - Broom Rd. WEATHER Clear

SEC. Sen 18 (1.79-8.60) TEMP. 20°

DESCRIPTION

Control Point Ties - & Survey & Const.

JOB NO.

LEFT

CENTER LINE Survey

RIGHT

