

O.D.O.T. DISTRICT 2 SURVEY OFFICE (USE ONLY)

PERSONNEL

REFERENCE NO. 21

SHEET OF

NOTES BARRIERE

DATE 8/15/24

ROUTE SR 18

H.C. NIESE

WEATHER CLDY/WNDY

COUNTY SENECA

R.C. MILLER

TEMP. 63°

TOWNSHIP LOUDON

DWG BY BARRIERE

PID 92371

SECTION 13

T 2 N R 13 E

TYPE MONUMENT 1" IPIN

ON SURFACE - BELOW 3" BELOW

OFFSET Q PAVEMENT 22.9' RT LT : RT

 TO EDGE PAVEMENT

STATION: 351+88

HORZ.DATUM: NAD83 (2011)


GEOID: 18

GRID: NORTHING: 535083.681


EASTING: 1744291.202

LDP: NORTHING:

EASTING:

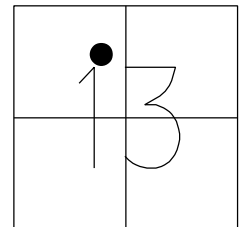

RECORD: P.I.
FD 1" IPIN
6/28/01, DCH
FD 1" IPIN
3" DOWN
REF21
4/22/19, JFO
9/22/22, TDN

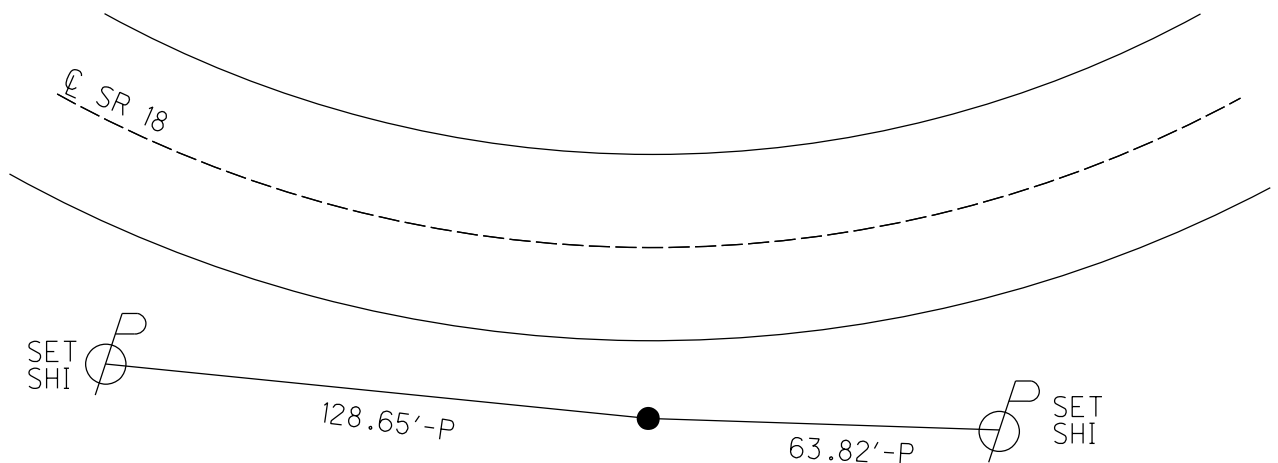

O.D.O.T. DISTRICT 2 SURVEY OFFICE (USE ONLY)

PERSONNEL

REFERENCE NO. 21

SHEET 20 OF 48

NOTES CORDES

DATE 6/28/01

ROUTE SR 18

H.C. HOMAN

WEATHER SUNNY

COUNTY SENECA

R.C. VAN DUSEN

TEMP. 90°

TOWNSHIP LOUDON

CANTERBURY

SECTION 13

DWG BY NIESE PID NO PID

T 2 N R 13 E

TYPE MONUMENT 1" IPIN

ON SURFACE - ~~BELOW~~ ON

OFFSET CL PAVEMENT 22.9' ~~LT~~ : RT

11.6' TO RT EDGE PAVEMENT


STATION: 351+88

HORZ.DATUM: NAD83(2011)


GEOID: 2012A

GRID: NORTHING: 535083.698

EASTING: 1744291.189

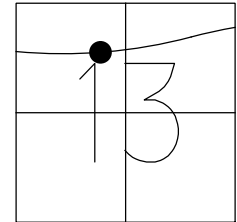

RECORD: P.I.
FD 1" IPIN
6/28/01, DCH
FD 1" IPIN
3" DOWN
REF21
4/22/19, JFO

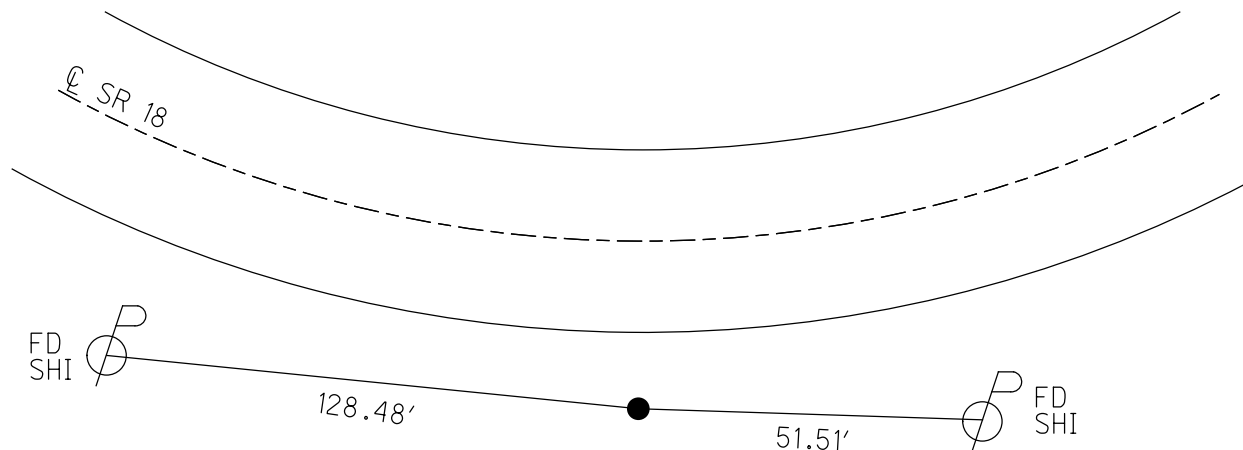

O.D.O.T. DISTRICT 2 SURVEY OFFICE

PERSONNEL

REFERENCE NO. 21

SHEET 2 OF 26

NOTES B. GORDON

H.C. D. HOMAN

DATE 6-28-01

ROUTE 18

R.C. B. VAN DUSEN

WEATHER SUNNY

COUNTY SENECA

M. CANTERBURY

TEMP. +90°F

TOWNSHIP LOUDON

SECTION 13

T2 N R 13 E


TYPE MONUMENT 1" IRON PIN

ON SURFACE - BELOW YES

~~LEFT~~ - & PAV'T. - RIGHT 22.9


11.6 TO S. EDGE PAVEMENT

S.L.M. 351+88

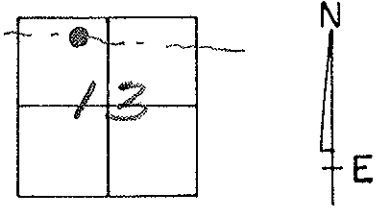

P.I. REC:
FD. 1" IRON PIN

& PAVEMENT S.R. 18

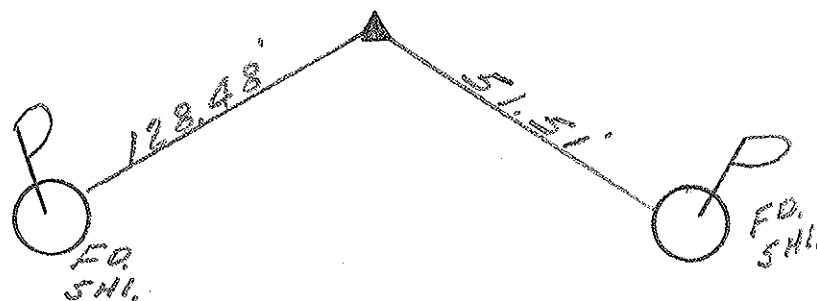

O.D.O.T. DISTRICT 2 SURVEY OFFICE

PERSONNEL

REFERENCE NO. 21

SHEET 2 OF 27

NOTES CHENEY

H.C. RIPPLE

R.C. BARBOUR

DATE 10-9-1991

WEATHER SUNNY

TEMP. 70°

ROUTE 18

COUNTY SENECA

TOWNSHIP LOUDDON

SECTION 13

T2N R13E


TYPE MONUMENT SET PK/WASHER

ON SURFACE - BELOW

LEFT - C PAV'T. - RIGHT 22.9'

11.6' TO S. EDGE PAVEMENT


S.L.M. 351+88

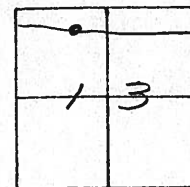

P.I.

FO. 1" IRON PIN

C. PAV'T. - S.R. 18

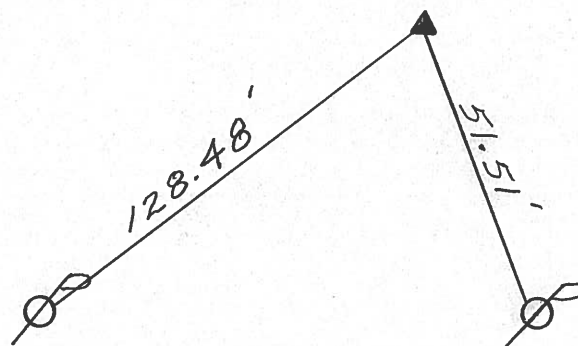

Q.D.O.T. DISTRICT 2 SURVEY OFFICE

Sht. of

County Seneca : S.R. # 18

Township Loudon

Section 13

T 2 N, R 13 E

Personnel Schneider

Messer

Barbour


Cronin

Ripple Geyman

Date 5-15-80

Weather Fair


Temp. 63°

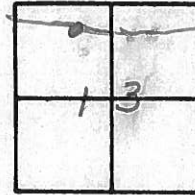

(20)



S.R. #18

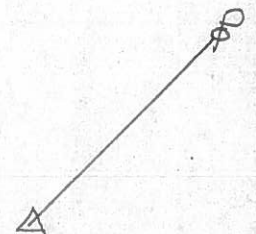

P.I.

339+44.05

Iron Pin

PERSONNEL TITLE PERSONNEL TITLE

COUNTY Seneca

DATE 10-17-68

Schneider

Bootts

Nasser

S. R. 18

WEATHER Cloudy

Barbour

Redding

SEC. Easteria to Bascom

TEMP. 70°

DESCRIPTION Tie for Control Points

JOB NO.

LEFT

CENTER LINE

RIGHT


(22)

P.I.

352+29.75

Iron Pin

8111

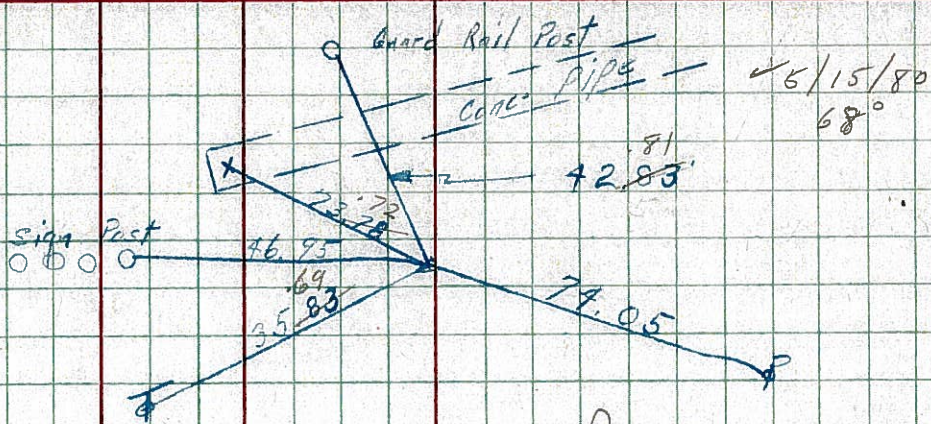


(21)

P.I.

339+11.05

Iron Pin

8110

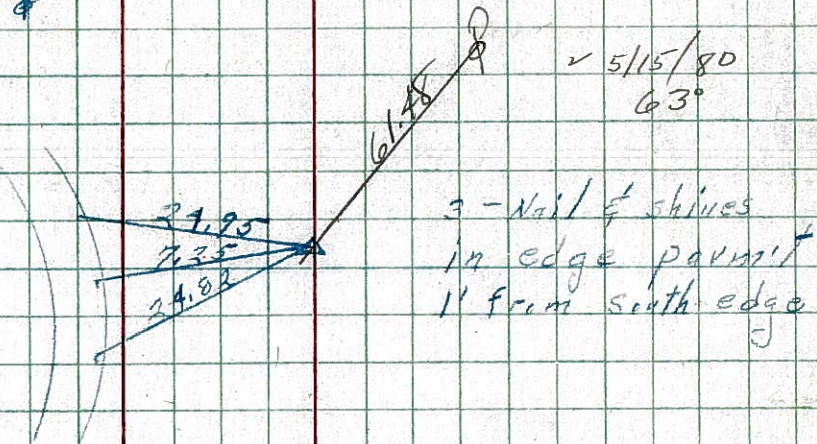


(20)

P.I.

337+63.25 (Survey)

R.R. Spk.

8109

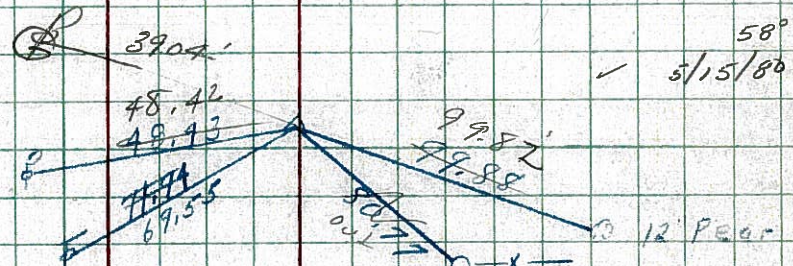


(19)

P.I.

282+31.67 (Survey)

FA Spk. 7" down
1 1/2' off edge parmit.

8108

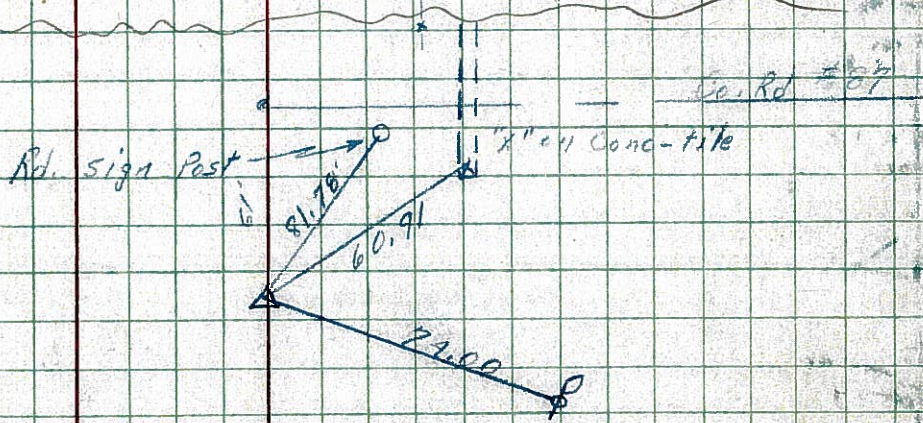

(17-A)

608 LW
ST-66 to hill flagman

Resurveyed 2001

SHEET NO. 6

PERSONNEL

TITLE

PERSONNEL

TITLE

Schneider

Potts

COUNTY Seneca

DATE 10-17-68

Mosser

S. R. 18

WEATHER cloudy

Barbour

Redding

SEC. Eastoria to Baseom TEMP 70°

DESCRIPTION

Tie for Control Points

LEFT

CENTER LINE

RIGHT

JOB NO.


22

P.I.

352+09.75

Iron Pin

8111

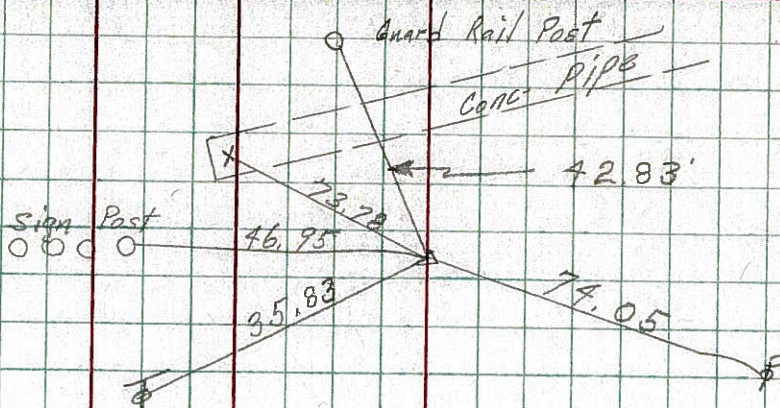


21

P.I.

339+44.05

Iron Pin

8110

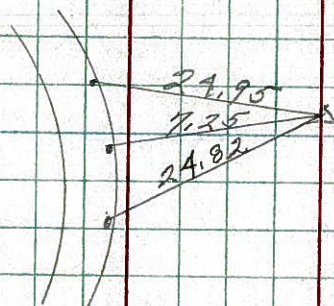

3 - Nail & shins
in edge permit
1' from south edge


20

P.I.

327+63.25 (survey)

R.R. SPK.

8109

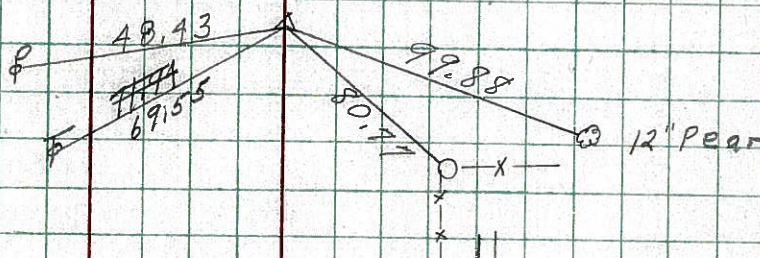

Co. Rd #87

17A 19

P.I.

282+31.67 (survey)

R.R. SPK. 4" down

1 1/2' off edge Parm't.

8108

