

O.D.O.T. DISTRICT 2 SURVEY OFFICE (USE ONLY)

PERSONNEL

REFERENCE NO. 23

SHEET OF

NOTES BARRIERE
H.C. NIESE
R.C. MILLER

DATE 8/15/24
WEATHER CLDY/WNDY
TEMP. 75°

ROUTE SR 18
COUNTY SENECA
TOWNSHIP LOUDON
SECTION 13
T 2 N R 13 E

DWG BY BARRIERE PID 92371

TYPE MONUMENT MAG NAIL/WASHER

ON SURFACE - BELOW ON

OFFSET $\mathcal{Q}$ PAVEMENT 7.5' LT LT : RT

 TO EDGE PAVEMENT

STATION: 378+17

HORIZ.DATUM: NAD83 (2011)


GEOID: 18

GRID: NORTHING: 535432.817


EASTING: 1746878.574

LDP: NORTHING:

EASTING:

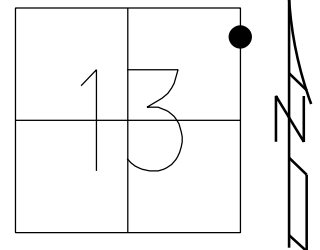

RECORD P.I.
STA. 365+70.33
 $\Delta = 2^\circ 21' 00''$ RT
D = $1^\circ 0' 00''$
R = 5729.58'
L = 235.00'
T = 117.51'
E = 1.21'
PREV. MONUMENTS:
P.K./SHI
R.R.SPIKE
FD P.K./WASHER
6/28/01, DCH
REF23
4/22/19
8/19/19, JFO
FD PK SHANK
REF23
9/22/22, TDN
SET MAG/WASHER
REF23
8/15/24, TDN

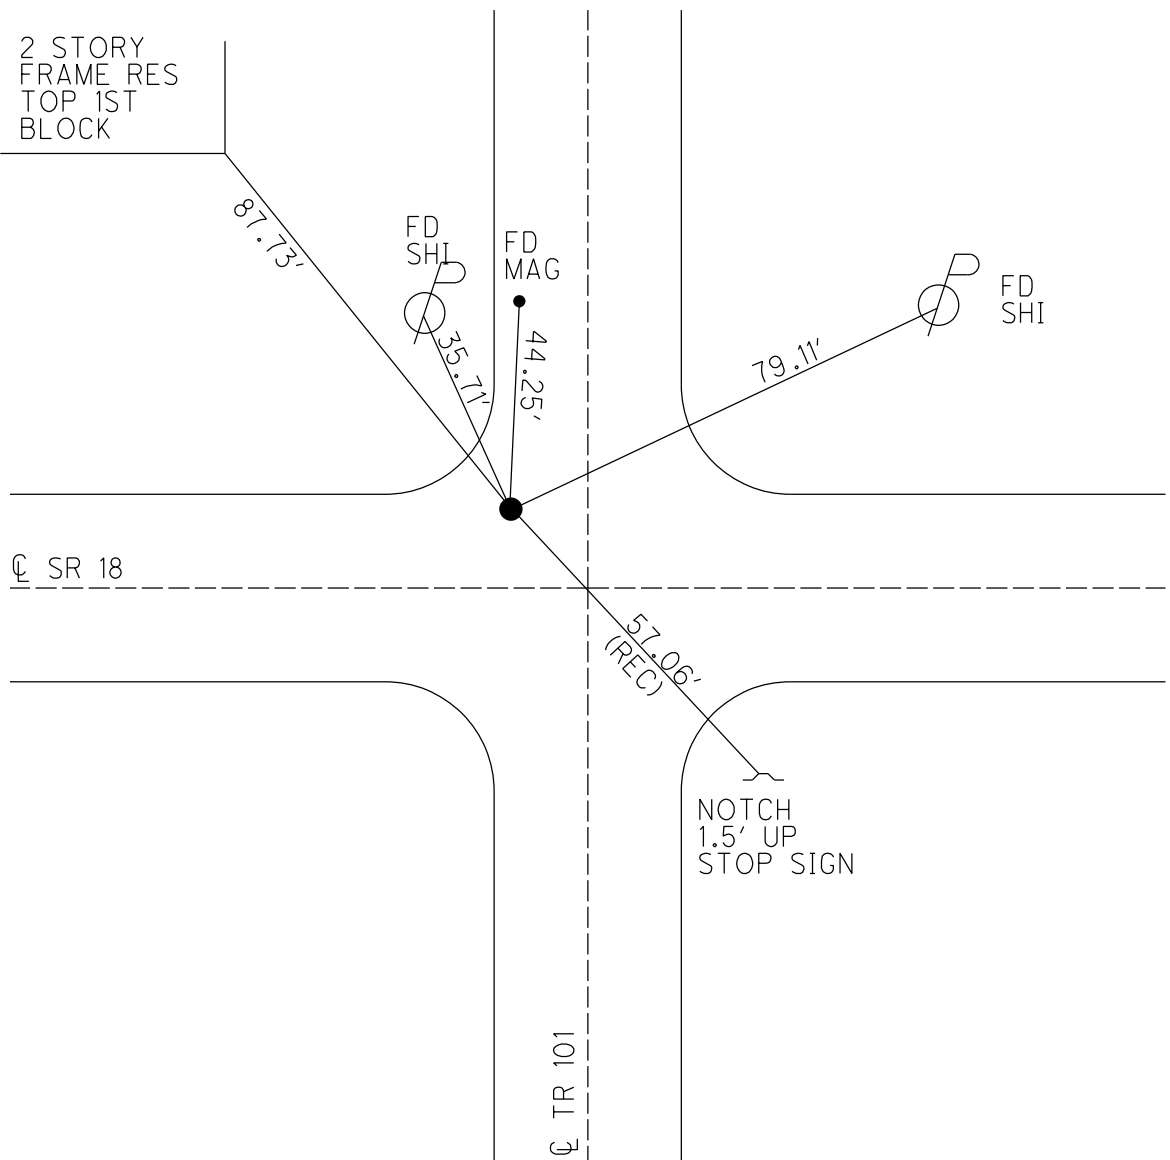

O.D.O.T. DISTRICT 2 SURVEY OFFICE (USE ONLY)

PERSONNEL

REFERENCE NO. 23

SHEET 22 OF 48

NOTES CORDES

DATE 6/28/01

ROUTE SR 18

H.C. HOMAN

WEATHER SUNNY

COUNTY SENECA

R.C. VAN DUSEN
CANTERBURY

TEMP. 90°F

TOWNSHIP LOUDON

DWG BY NIESE PID NO PID

SECTION 13

T 2 N R 13 E

TYPE MONUMENT P.K./WASHER

ON SURFACE - ~~BELOW~~ ON

OFFSET CL PAVEMENT 7.5' LT : RT

- TO - EDGE PAVEMENT



STATION: 378+17

HORZ.DATUM: NAD83(2011)

GEOID: 2012A

GRID: NORTHING: 535432.822

EASTING: 1746878.518

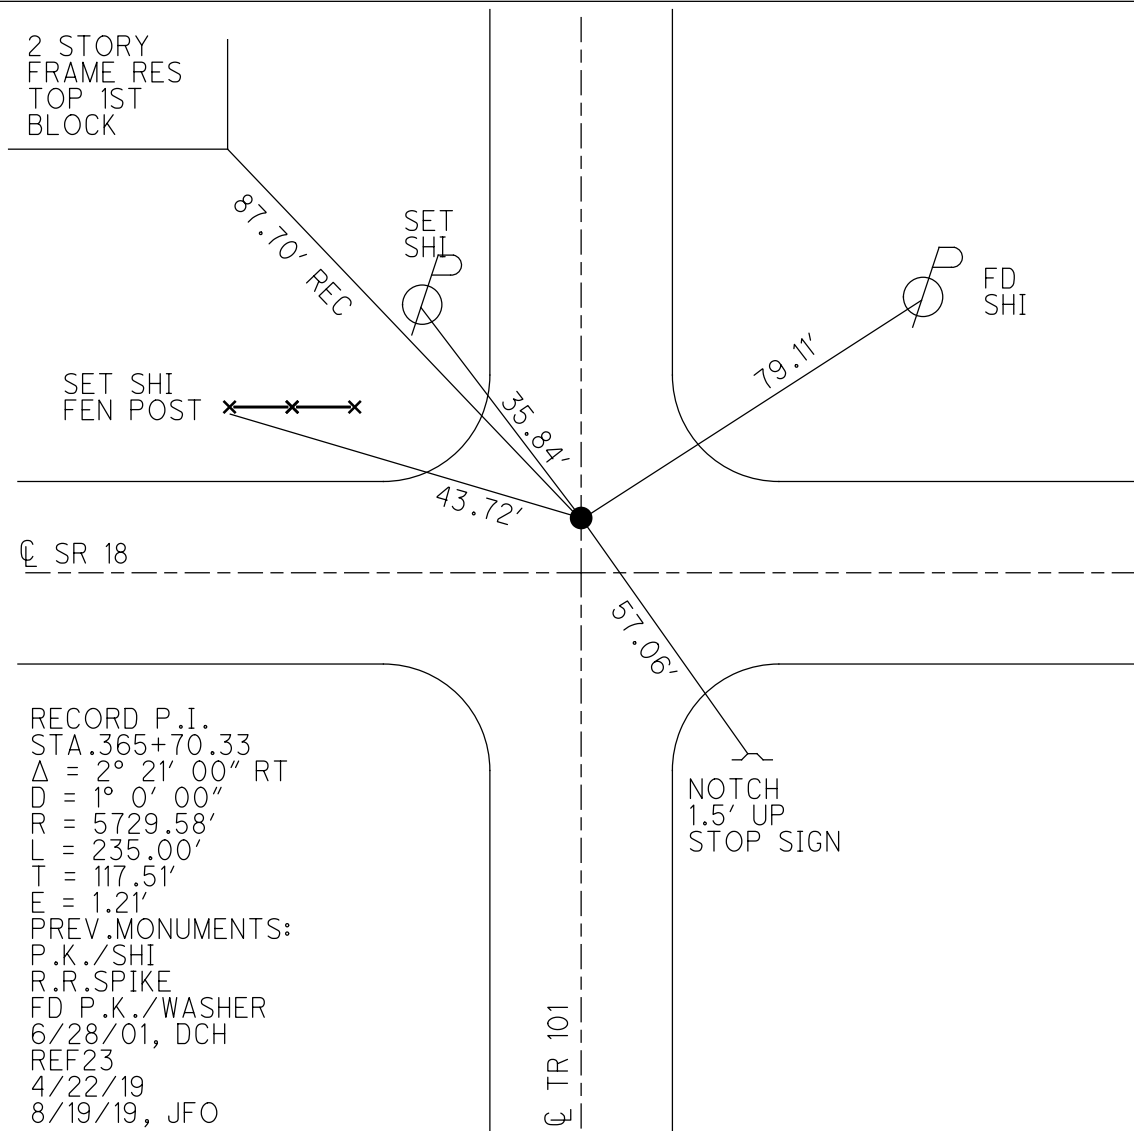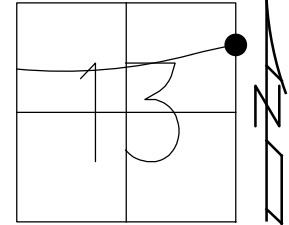

RECORD P.I.
STA. 365+70.33
 $\Delta = 2^\circ 21' 00''$ RT
D = 1° 0' 00"
R = 5729.58'
L = 235.00'
T = 117.51'
E = 1.21'
PREV. MONUMENTS:
P.K./SHI
R.R. SPIKE
FD P.K./WASHER
6/28/01, DCH
REF23
4/22/19
8/19/19, JFO

CL TR 101

O.D.O.T. DISTRICT 2 SURVEY OFFICE

PERSONNEL

REFERENCE NO. 23

SHEET 4 OF 26

NOTES B. CORDES

H.C. D. HOMAN

DATE 6-28-01

ROUTE 18

R.C. B. VAN DUSEN

WEATHER SUNNY

COUNTY SENECA

M. CANTERBURY

TEMP. +90° F.

TOWNSHIP LODDON & HOPEWELL

SECTION 13 & 18

T. 2 N R. 13 E 14 E

TYPE MONUMENT PK / WASHER


ON SURFACE - BELOW YES

LEFT - 1 PAV'T. - RIGHT 7.5

- TO - EDGE PAVEMENT

S.L.M. 378+17

13	18
R13E	R14E

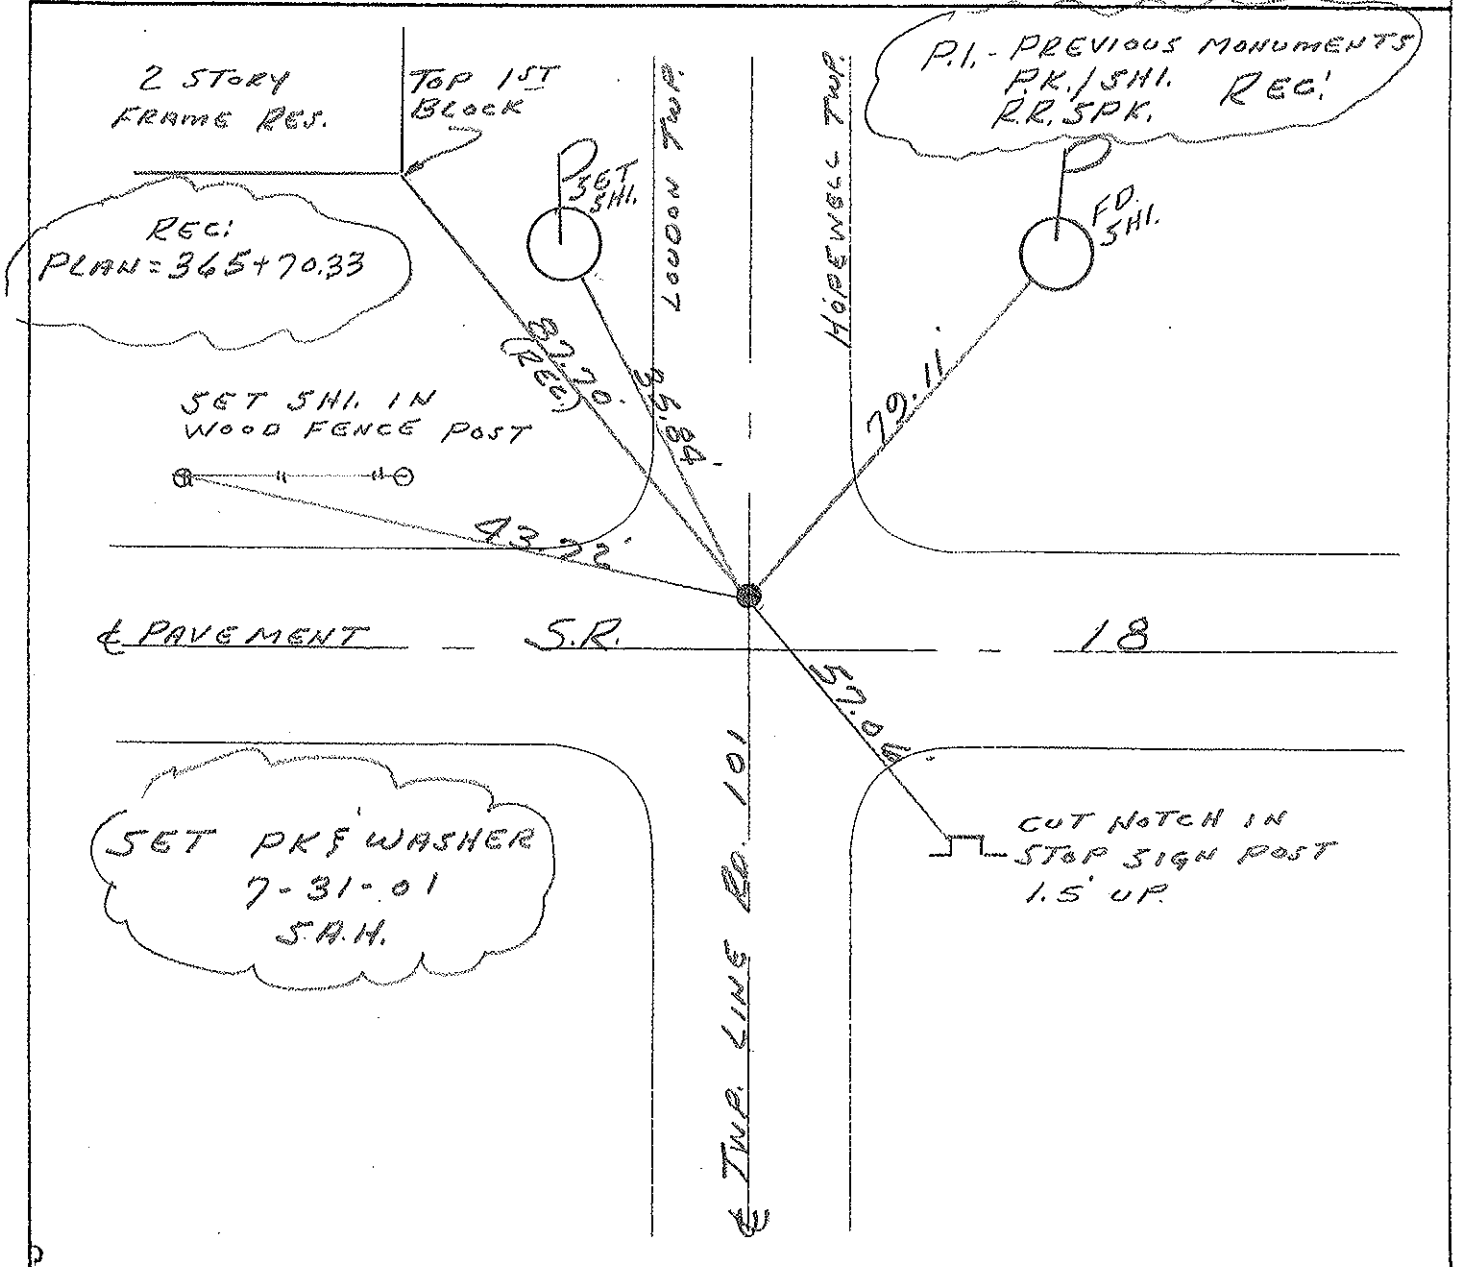

O.D.O.T. DISTRICT 2 SURVEY OFFICE

PERSONNEL

REFERENCE NO. 23

SHEET 4 OF 27

NOTES CHENEY

H.C. BARBOUR

R.C. RIPPLE

DATE 10-9-1991

WEATHER SUNNY

TEMP. 70°

ROUTE 18

COUNTY SENECA

TOWNSHIP LOU DON E
HOREWELL

SECTION 13 E 18

T2 N R 13 E 14 E

TYPE MONUMENT SET PK/WASHER

ON SURFACE - BELOW

LEFT- & PAV'T. - RIGHT 7.5'

TO EDGE PAVEMENT

S.L.M. 378+17

13	18
R13E	R14E




PLAN 365+70.33

2 STORY
FRAME RES.

TOP 1ST.
BLOCK

P.I. - PREVIOUS MONUMENTS:

P.K./SHI.
R.R. SPK.

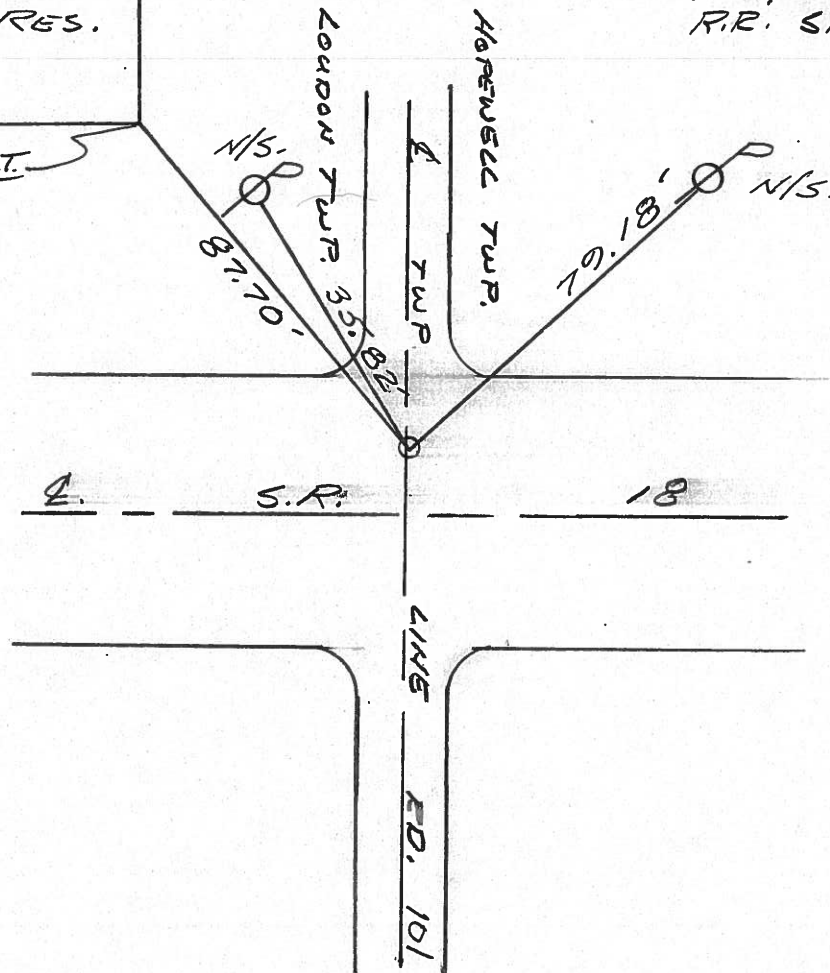

Q.D.O.T. DISTRICT 2 SURVEY OFFICE

Sht. of

County Seneca S.R. # 18

Township Landon & Hopewell

Section 13 & 18

T2N, R13E

Personnel Schneider

Mosser

Barbour


Cronin

Ripple Geyman

Date OK-9-10-80-G.W.S.
5-15-80

Weather Fair

Temp. 63°

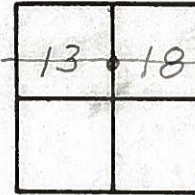

(23)



P. I.


365+70.33 Survey

R. R. Spk.

SET P.K. & SHI.

Hopewell Twp.
Landon Twp.


Twp. Line Rd.
101

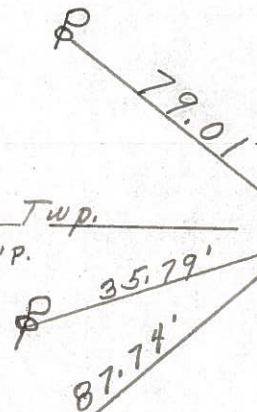

1 1/2 story
Frame Res.

PERSONNEL	TITLE	PERSONNEL	TITLE	COUNTY	DATE	S. R.	WEATHER	SEC.	TEMP.
Schneider		Potts		Seneca	10-17-68	18	Fair	Fostoria to Bascom	75°
Mosser									
Barbour									
Redding									

DESCRIPTION: Ties for Control Points

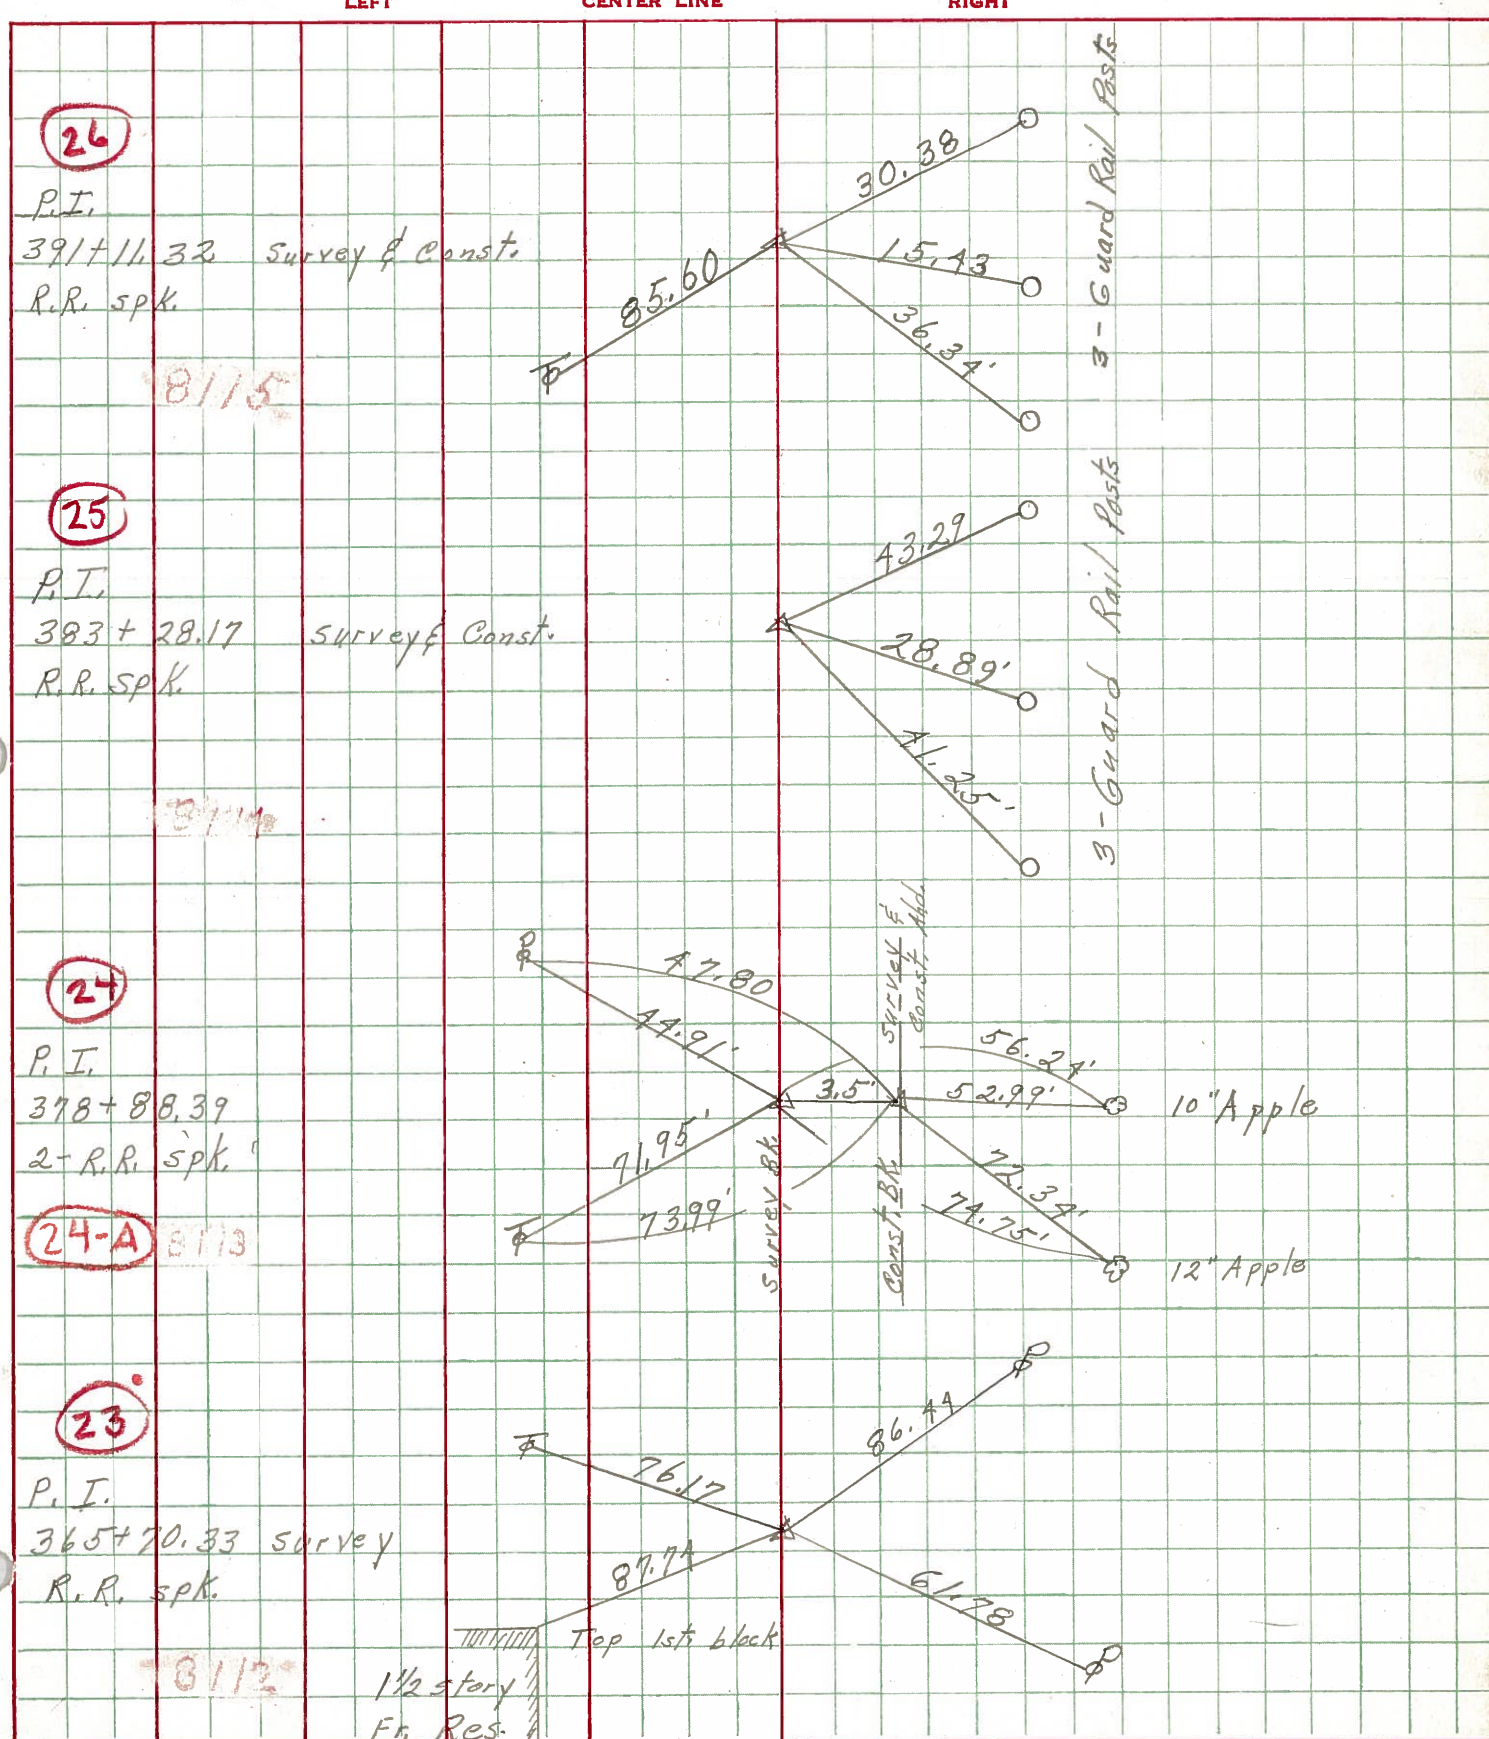

PERSONNEL	TITLE	PERSONNEL	TITLE
1	2	3	4
5	6	7	8
9	10	11	12
13	14	15	16
17	18	19	20
21	22	23	24
25	26	27	28
29	30	31	32
33	34	35	36
37	38	39	40
41	42	43	44
45	46	47	48
49	50	51	52
53	54	55	56
57	58	59	60
61	62	63	64
65	66	67	68
69	70	71	72
73	74	75	76
77	78	79	80
81	82	83	84
85	86	87	88
89	90	91	92
93	94	95	96
97	98	99	100

COUNTY Sentola

DATE 7 Mar. 24, '59

ASH

Crozza

Leemaster

John A.

S. R. #18 Fosteria-Bzscorn Rd.

WEATHER *Clear*

SEC. Sen.-18 (1.79-8.60)

TEMP. 50°

DESCRIPTION COM/401 POINT 1105 - E Survey & Const.

JOB NO.

LEFT

CENTER LINE Survey

RIGHT

2003 NO.

