

O.D.O.T. DISTRICT 2 SURVEY OFFICE (USE ONLY)

PERSONNEL

REFERENCE NO. 25

SHEET OF

NOTES BARRIERE

DATE 8/15/24

ROUTE SR 18

H.C. NIESE

WEATHER CLDY/WNDY

COUNTY SENECA

R.C. MILLER

TEMP. 74°

TOWNSHIP HOPEWELL

DWG BY BARRIERE

PID 92371

SECTION 18

T 2 N R 14 E

TYPE MONUMENT MAG NAIL/WASHER

ON SURFACE - BELOW ON

OFFSET C PAVEMENT 8.5' LT LT : RT

 TO EDGE PAVEMENT

STATION: 396+10

HORIZ.DATUM: NAD83 (2011)


GEOID: 18

GRID: NORTHING: 535360.875

EASTING: 1748634.266

LDP: NORTHING:

EASTING:

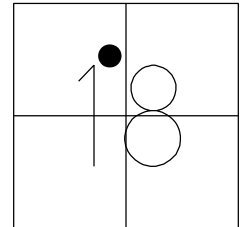

RECORD P.I.:

STA 383+28.17

$\Delta = 7^{\circ}05'00''$ RT

D = $1^{\circ}20'00''$

R = 4297.18'

L = 531.25'

T = 265.96'

E = 8.22'

PREV. MONUMENTS

P.K./SHI

R.R.SPIKE

FD P.K./WASHER

6/28/01, DCH

SET P.K./WASHER

7/31/01, SAH

FD P.K./WASHER

REF25

4/22/19


8/19/19, JFO

9/22/22, TDN

SET MAG/WASHER

REF25

8/15/24, TDN

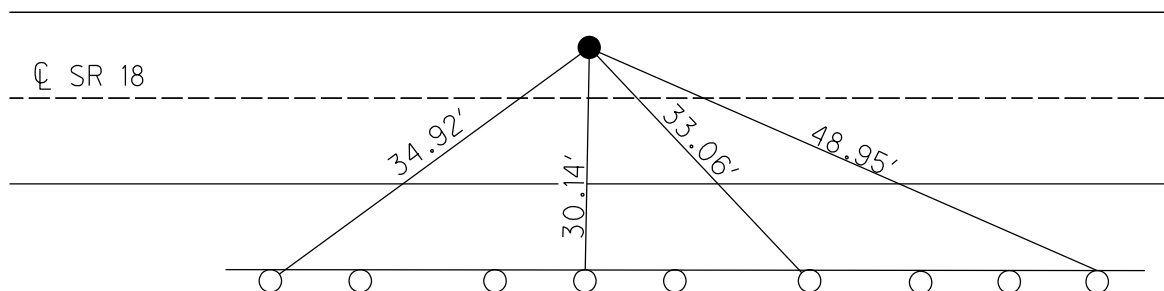

SET SHI
GR POSTS

O.D.O.T. DISTRICT 2 SURVEY OFFICE (USE ONLY)

PERSONNEL

REFERENCE NO. 25

SHEET 25 OF 48

NOTES CORDES
H.C. HOMAN
R.C. VAN DUSEN
CANTERBURY

DATE 6/28/01
WEATHER SUNNY
TEMP. 90°

ROUTE SR 18
COUNTY SENECA
TOWNSHIP HOPEWELL
SECTION 18
T 2 N R 14 E

DWG BY NIESE PID NO PID

TYPE MONUMENT P.K./WASHER

ON SURFACE - ~~BELOW~~ ON

OFFSET CL PAVEMENT 8.5' LT : ~~RT~~

3.0' TO LT EDGE PAVEMENT


STATION: 396+10

HORIZ.DATUM: NAD83(2011)


GEOID: 2012A

GRID: NORTHING: 535360.868

EASTING: 1748634.311

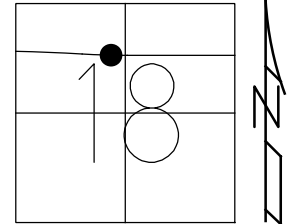

RECORD P.I.:
STA 383+28.17
 $\Delta=7^{\circ}05'00''$ RT
 $D=1^{\circ}20'00''$
 $R=4297.18'$
 $L=531.25'$
 $T=265.96'$
 $E=8.22'$
PREV. MONUMENTS
P.K./SHI
R.R.SPIKE
FD P.K./WASHER
6/28/01, DCH
SET P.K./WASHER
7/31/01, SAH
FD P.K./WASHER
REF25
4/22/19
8/19/19, JFO

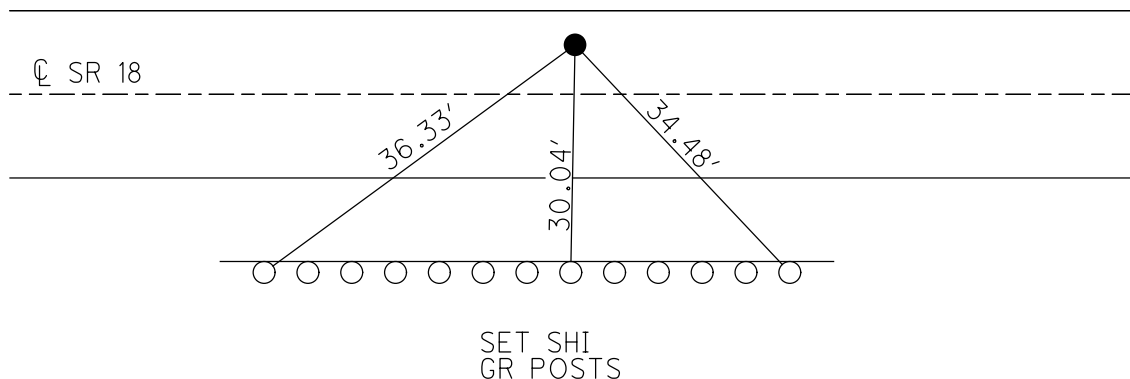

O.D.O.T. DISTRICT 2 SURVEY OFFICE

PERSONNEL

REFERENCE NO. 25

SHEET 6 OF 26

NOTES B. Cordes

H.C. D. Homan

DATE 6-28-01

ROUTE 18

R.C. B. Van Dusen

WEATHER SUNNY

COUNTY SENECA

M. Canterbury

TEMP. +20° F

TOWNSHIP HOPEWELL

SECTION 18

T2 NR 14 E


TYPE MONUMENT PKE WASHER

ON SURFACE - BELOW YES

LEFT - & PAV'T. - RIGHT 8.5

3' JOLT. EDGE PAVEMENT

S.L.M. 306+10

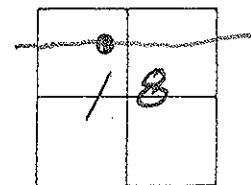

PREVIOUS MONUMENTS

PK/SHI. REC!

R.R. SPK.

P.I.

PLAN STA. 383+28.17


SET PKE WASHER

7-31-01

J.A.H.

& PAVEMENT SR.

18

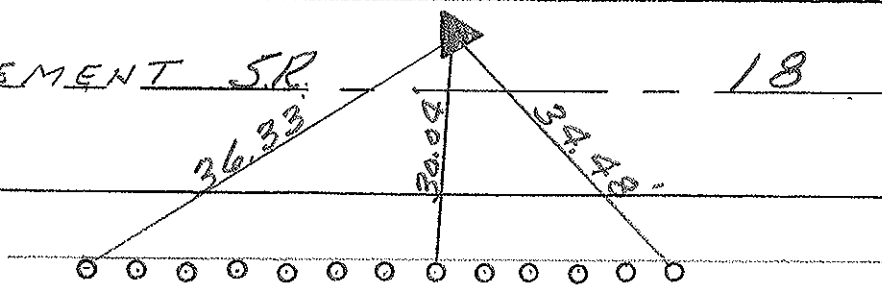

SET NAIL SHI.
IN FACE OF
GUARD RAIL POSTS

O.D.O.T. DISTRICT 2 SURVEY OFFICE

PERSONNEL

REFERENCE NO. 25

SHEET 6 OF 27

NOTES CHENEY

H.C. BARBOUR

R.C. RIPPLE

DATE 10-9-1991

WEATHER PARTLY CLOUDY

TEMP. 70°

ROUTE 18

COUNTY SENECA

TOWNSHIP HOPWELL

SECTION 18

T. 2 N. R. 14 E.


TYPE MONUMENT SET PK/WASHER

ON SURFACE - BELOW

LEFT- & PAV'T. - RIGHT 8.5'

3' TO N. EDGE PAVEMENT

S.L.M. 395+75

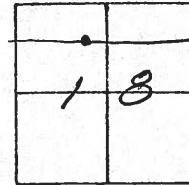


PREVIOUS MONUMENTS:

PK/SHI.

R.R. SPK.

PLAN STA 383+28.17

P. 1.

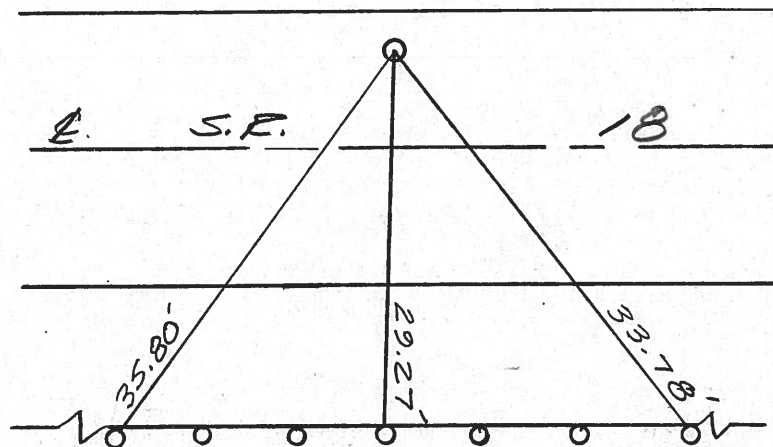

USED BOLT HEADS IN
G.R. POSTS

* NOTE: SET SHINER IN TOP
OF POSTS-USED FOR
LOCATION PURPOSES
ONLY.