

O.D.O.T. DISTRICT 2 SURVEY OFFICE (USE ONLY)

PERSONNEL

REFERENCE NO. 26

SHEET OF

NOTES BARRIERE
H.C. NIESE
R.C. MILLER

DATE 8/15/24
WEATHER CLDY/WNDY
TEMP. 74°

ROUTE SR 18
COUNTY SENECA
TOWNSHIP HOPEWELL
SECTION 18

DWG BY BARRIERE PID 92371

T 2 N R 14 E

TYPE MONUMENT MAG NAIL/WASHER

ON SURFACE - BELOW ON

OFFSET CL PAVEMENT 9' RT LT : RT

 TO EDGE PAVEMENT

STATION: 404+01

HORIZ.DATUM: NAD83 (2011)



GEOID: 18

GRID: NORTHING: 535233.426


EASTING: 1749407.419

LDP: NORTHING:

EASTING:

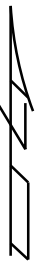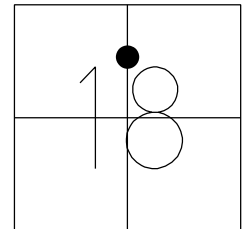

RECORD P.I.:
STA 391+11.32
 $\Delta=8^{\circ}25'00''$ LT
D=2°30'00"
R =2291.83'
L =300.00'
T =318.74'
L =36.67'
E =7.83'
S.C.=390+92.58
C.S.=391+29.25
PREV MONUMENTS
PK/SHI
RR SPIKE
SET PK/WASHER
7/31/01, SAH
FD PK/WASHER
REF26
4/22/19
8/19/19, JFO
9/22/22, TDN
SET MAG/WASHER
REF26
8/15/24, TDN

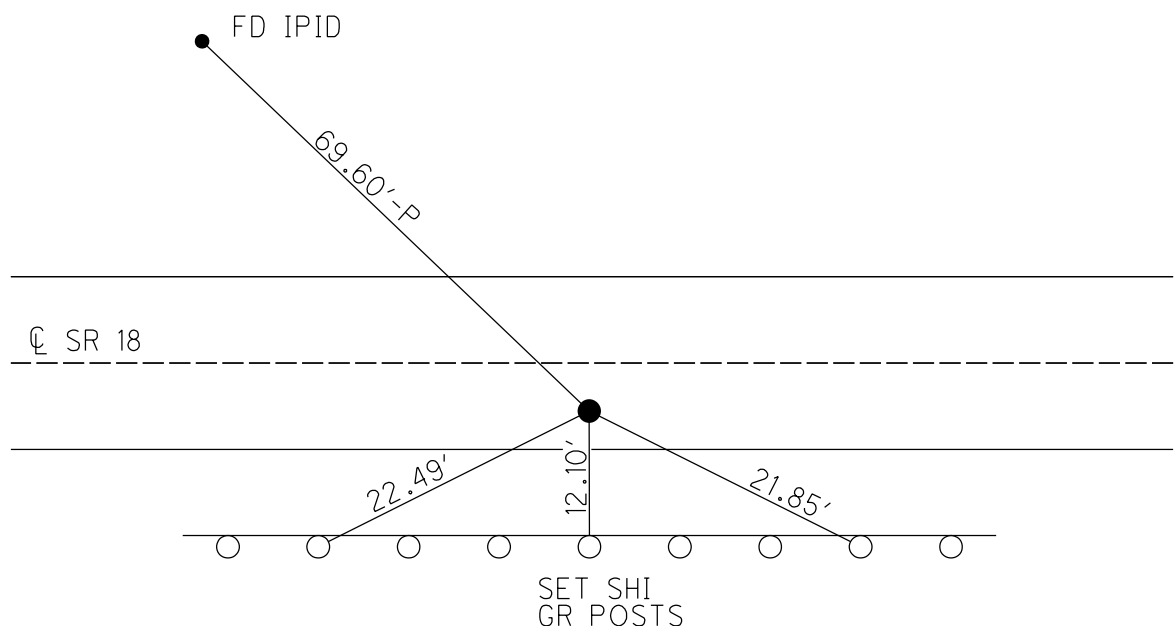

O.D.O.T. DISTRICT 2 SURVEY OFFICE (USE ONLY)

PERSONNEL

REFERENCE NO. 26

SHEET 26 OF 48

NOTES CORDES
H.C. HOMAN
R.C. CANTERBURY
VAN DUSEN

DATE 6/28/01
WEATHER SUNNY
TEMP. 90°

ROUTE SR 18
COUNTY SENECA
TOWNSHIP HOPEWELL
SECTION 18
T 2 N R 14 E

DWG BY NIESE PID NO PID

TYPE MONUMENT P.K./WASHER

ON SURFACE - ~~BELOW~~ ON


OFFSET CL PAVEMENT 9.0' ~~LT~~ : RT

3.0' TO RT EDGE PAVEMENT


STATION: 404+01

HORIZ.DATUM: NAD83(2011) GEOID: 2012A

GRID: NORTHING: 535233.424 EASTING: 1749407.419

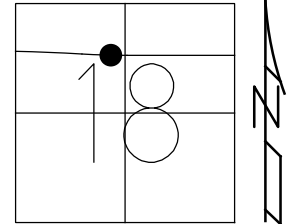

RECORD P.I.:
STA 391+11.32
 $\Delta=8^{\circ}25'00''$ LT
D=2°30'00"
R =2291.83'
L =300.00'
T =318.74'
L =36.67'
E =7.83'
S.C.=390+92.58
C.S.=391+29.25
PREV MONUMENTS
PK/SHI
RR SPIKE
SET PK/WASHER
7/31/01, SAH
FD PK/WASHER
REF26
4/22/19
8/19/19, JFO

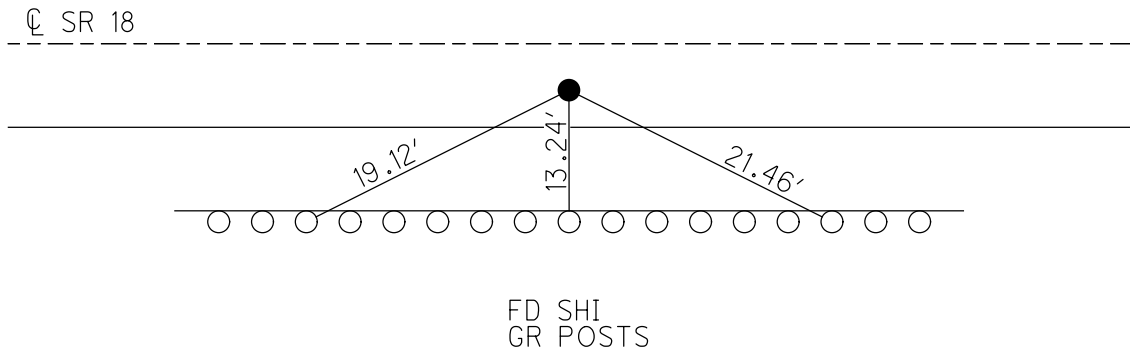

O.D.O.T. DISTRICT 2 SURVEY OFFICE

PERSONNEL

REFERENCE NO. 26

SHEET 7 OF 26

NOTES CORDES

H.C. HOMAN

DATE 6-28-01

ROUTE 18

R.C. CANTERBURY

WEATHER SUNNY

COUNTY SENECA

VAN DUSEN

TEMP. + 90° F

TOWNSHIP HOPEWELL

SECTION 18

T. 2 N. R. 14 E.


TYPE MONUMENT PK/WASHER

ON SURFACE - BELOW YES

LEFT - & PAV'T. - RIGHT 9.0'

3.0' TO RT. EDGE PAVEMENT

S.L.M. 404+01

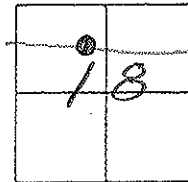

P.I. - PREVIOUS MONUMENT:


P.K. / S.H.I. REC:

R.R. SPK.

PLAN STA. : 391+11.32

SET PK & WASHER
7-31-01
JAH

& PAVEMENT S.R. 18

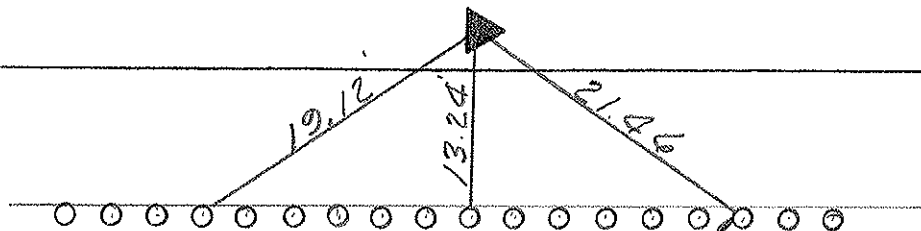

FD. NAILS & SHIS THUS
IN GUARD RAIL POSTS

O.D.O.T. DISTRICT 2 SURVEY OFFICE

PERSONNEL

REFERENCE NO. 26

SHEET 7 OF 27

NOTES CHENEY

H.C. BARBOUR

R.C. RIPPLE

DATE 10-9-1991

WEATHER PARTLY CLOUDY

TEMP. 70°

ROUTE 18

COUNTY SENECA

TOWNSHIP HOPEWELL

SECTION 18

T 2 N R 14 E


TYPE MONUMENT SET PK/WASHER

ON SURFACE - BELOW

~~LEFT~~ - & PAV'T. - RIGHT 9'

3' TO S. EDGE PAVEMENT

S.L.M. 403+56

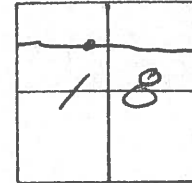


P.I. - PREVIOUS MONUMENTS:

PLAN STA = 391+11.32

P.K./SHI.

R.R. SPK.

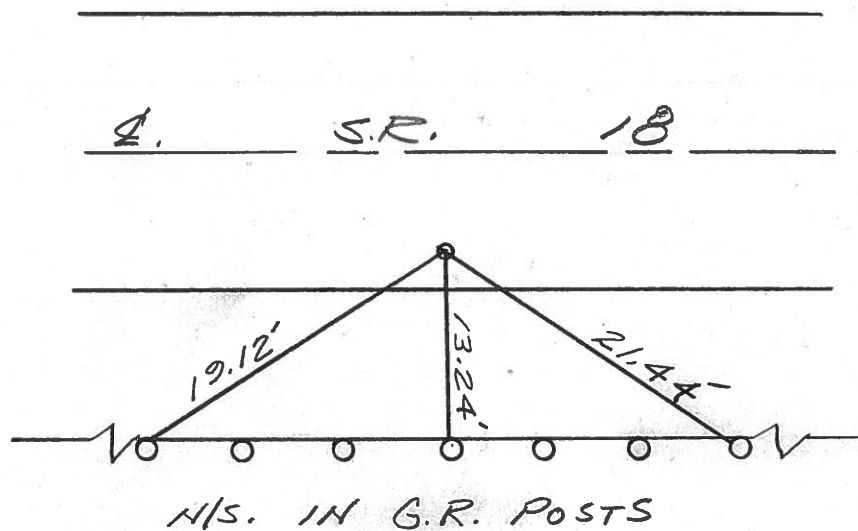

Q.D.O.T. DISTRICT 2 SURVEY OFFICE

Sht. ____ of ____

County Seneca S.R. # 18

Township Hopewell

Section 18

T2N, R4E

Personnel Schneider

Mosser

Barbour


Gronin

Ripple Geyman

Date OK-9-11-80 G.W.S.
5-15-80

Weather Fair

Temp. 63°

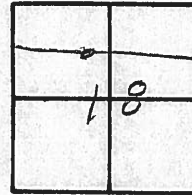

26




P. I.

391+11.32

R. R. spk.

SET P.K. NAIL & SHI.

Surve & Const.

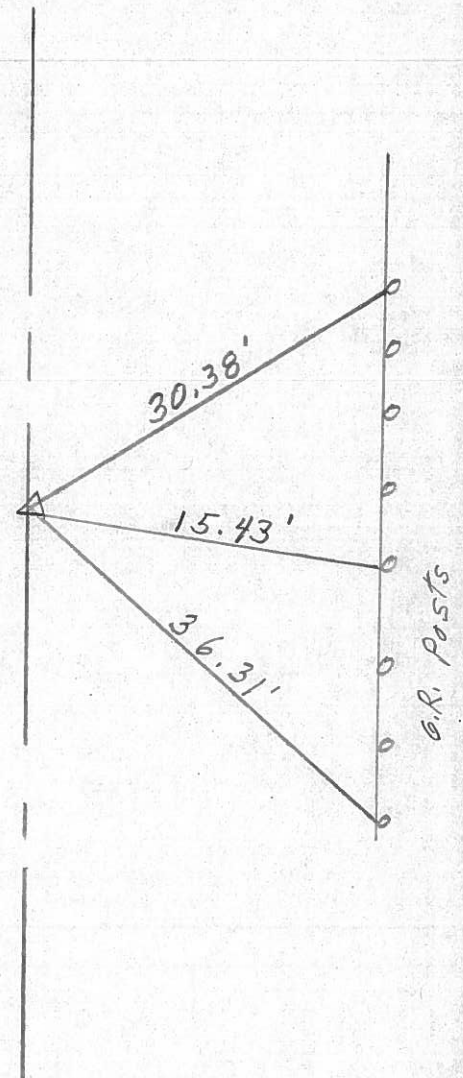

DATE 10-17-68

S. R. 18

WEATHER Fair

SEC. Fostoria to Bascom TEMP 75°

Barbour

SEC. Fostoria to Bascom

TEMP 75°

Redding

100

SEC. Fostoria to Bascom

TEMP 75°

DESCRIPTION


Ties for Control Points

LEFT

CENTER LINE

RIGHT

JOB NO.

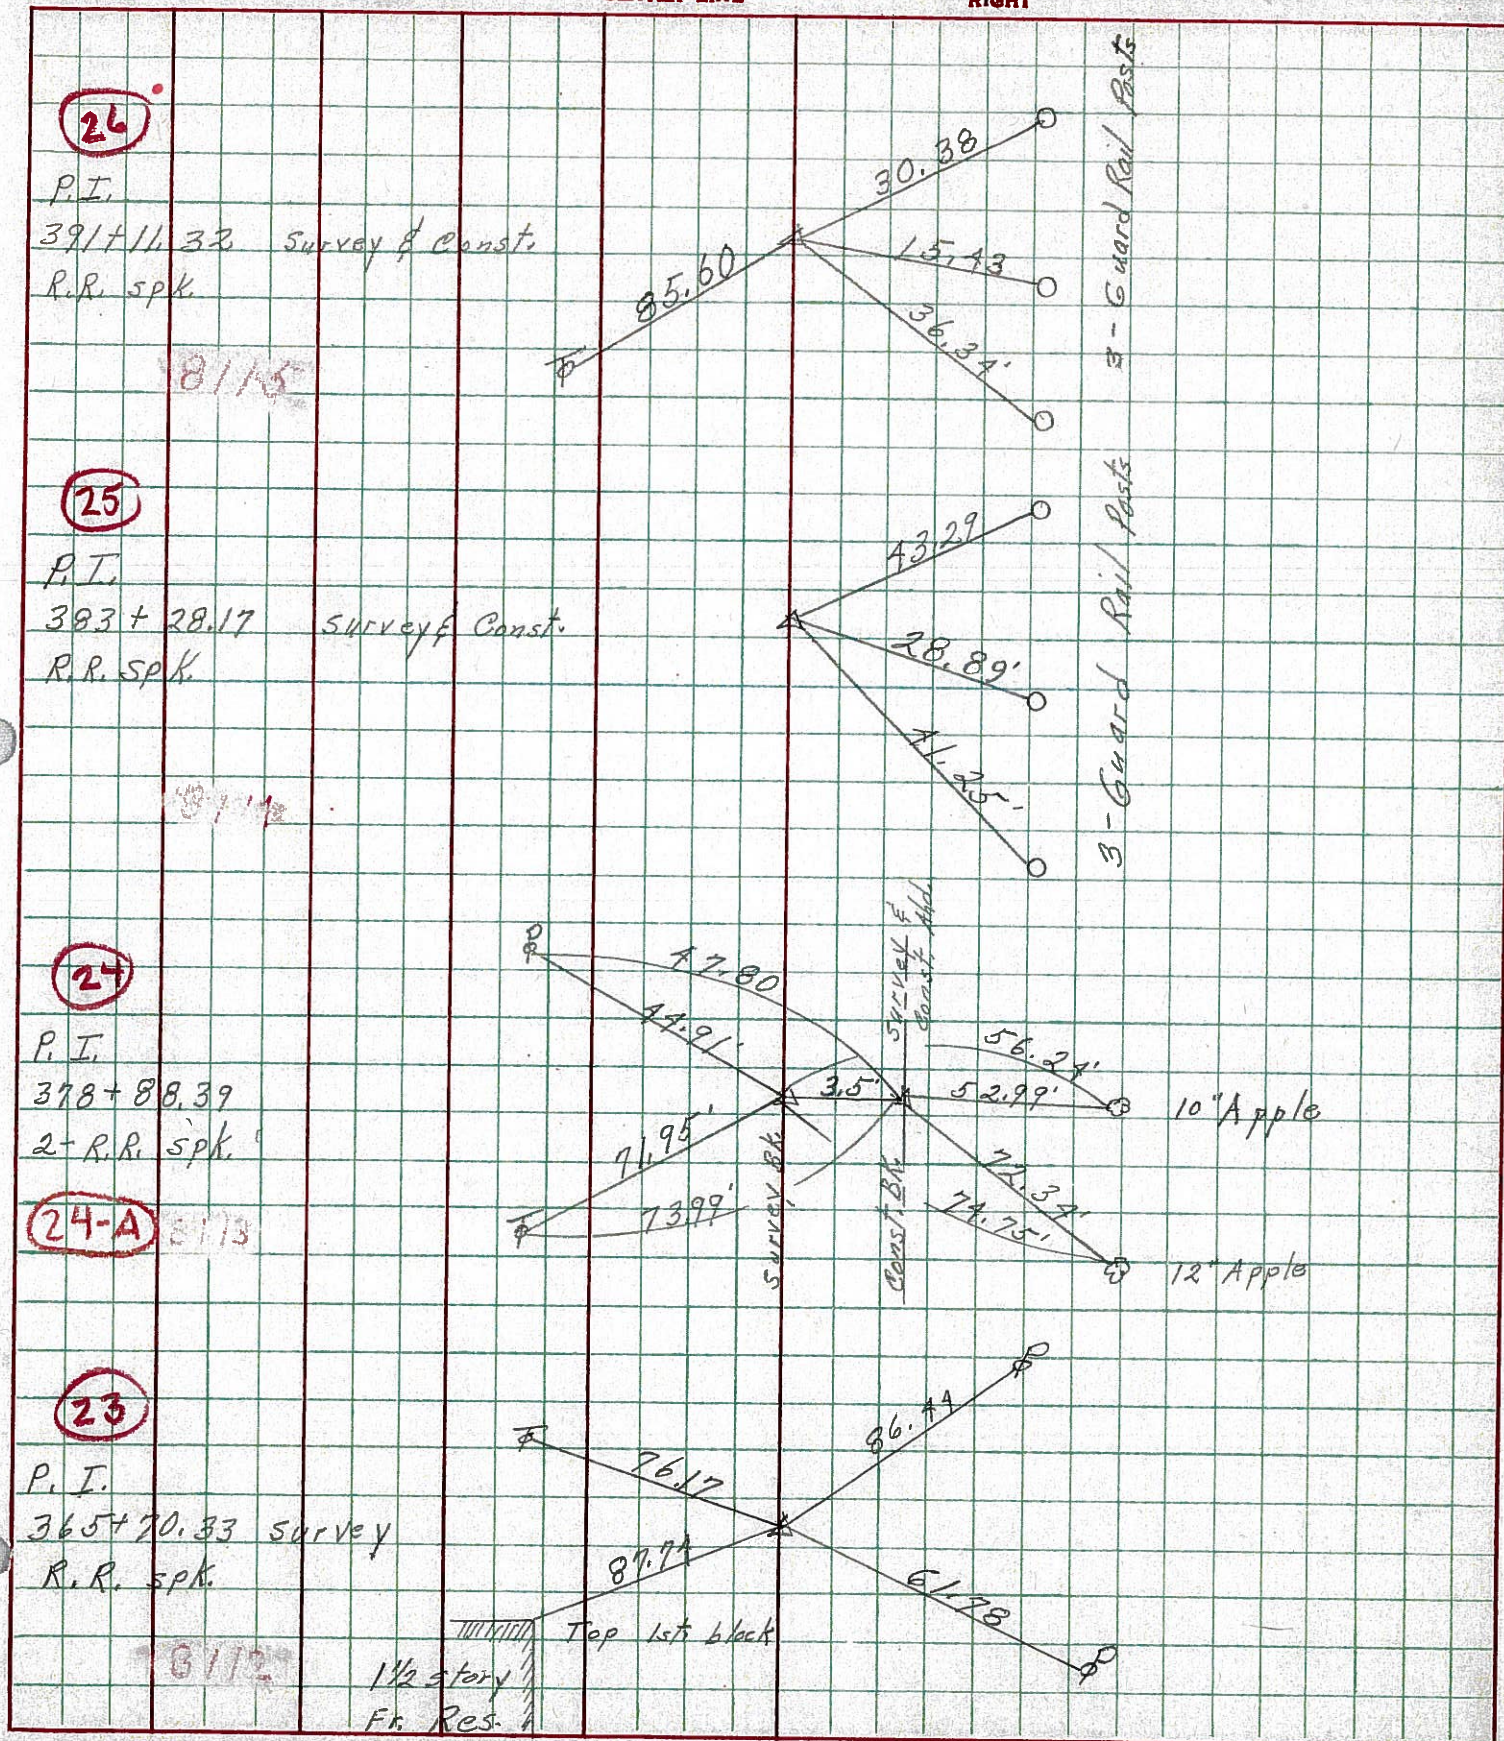

PERSONNEL	TITLE	PERSONNEL	TITLE
1	2	3	4
5	6	7	8
9	10	11	12
13	14	15	16
17	18	19	20
21	22	23	24
25	26	27	28
29	30	31	32
33	34	35	36
37	38	39	40
41	42	43	44
45	46	47	48
49	50	51	52
53	54	55	56
57	58	59	60
61	62	63	64
65	66	67	68
69	70	71	72
73	74	75	76
77	78	79	80
81	82	83	84
85	86	87	88
89	90	91	92
93	94	95	96
97	98	99	100

COUNTY Seneca

DATE Apr. 23, '59

Fish
Commit

Comin

Leemaster

John K.

S. R. #18 Foster - Bascom Rd. WEATHER Clear

SEC. 507-18 (179-8.60)

TEMP. 50°

DESCRIPTION: Control Point ties - 2 Survey & Const.

JOB NO.

LEFT

CENTER LINE Survey

RIGHT

9-14-59 R.P. Smith

(Sta. Eq.)

$$CT = 394 + 29.25 \text{ Const. } BK$$

394 + 54.94 Survey

9-14-59 P.P.S.H

$Q_s = P.I. \text{ Spitzl}$ Survey
 $P.K. \text{ Nail}$ Const.

9-14-59 P.P.S. 1/2

C.S. 39/A 29.25 Surrey

P.K. Nail

9/4/59 R.R. Spk.

✓ P.I. 391 + 11.32 SURVEY + COME

P. P. 50 1/4

✓ 9-4-59 R.R.S. Survey

S.C. 390 + 92.58

P. K. Nair

9/4/59 R.R. 5th

✓ Qs = P.I. Spiral / Survey

P.A. Neil

9/4/59 R.R. Sol.

$T = 387 + 97.50$

Tacked 57¢

26

Found R.R. Spk on Top
Relied by Croning Crew
11/2/65

