

O.D.O.T. DISTRICT 2 SURVEY OFFICE (USE ONLY)

PERSONNEL

REFERENCE NO. 34

SHEET OF

NOTES BARRIERE

DATE 8/15/24

ROUTE SR 18

H.C. NIESE

WEATHER CLDY/WNDY

COUNTY SENECA

R.C. MILLER

TEMP. 74°

TOWNSHIP HOPEWELL

DWG BY BARRIERE

PID 92371

SECTION 17

T 2 N R 14 E

TYPE MONUMENT MAG NAIL/WASHER

ON SURFACE - BELOW ON

OFFSET $\odot$ PAVEMENT 0.5' LT LT : RT

 TO EDGE PAVEMENT

STATION: 471+38

HORZ.DATUM: NAD83 (2011)


GEOID: 18

GRID: NORTHING: 534760.742


EASTING: 1756133.191

LDP: NORTHING:

EASTING:

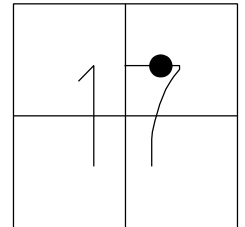

RECORD:
PREV MONUMENTS:
P.K./SHINER
R.R.SPIKE
FD P.K./WASHER
6/4/01, BVD
SET P.K./WASHER
8/1/01, SAH
FD P.K.NAIL
REF34
4/23/19
8/19/19, JFO
FD PK SHANK
REF34
9/27/22, TDN
SET MAG/WASHER
9/11/24, TDN

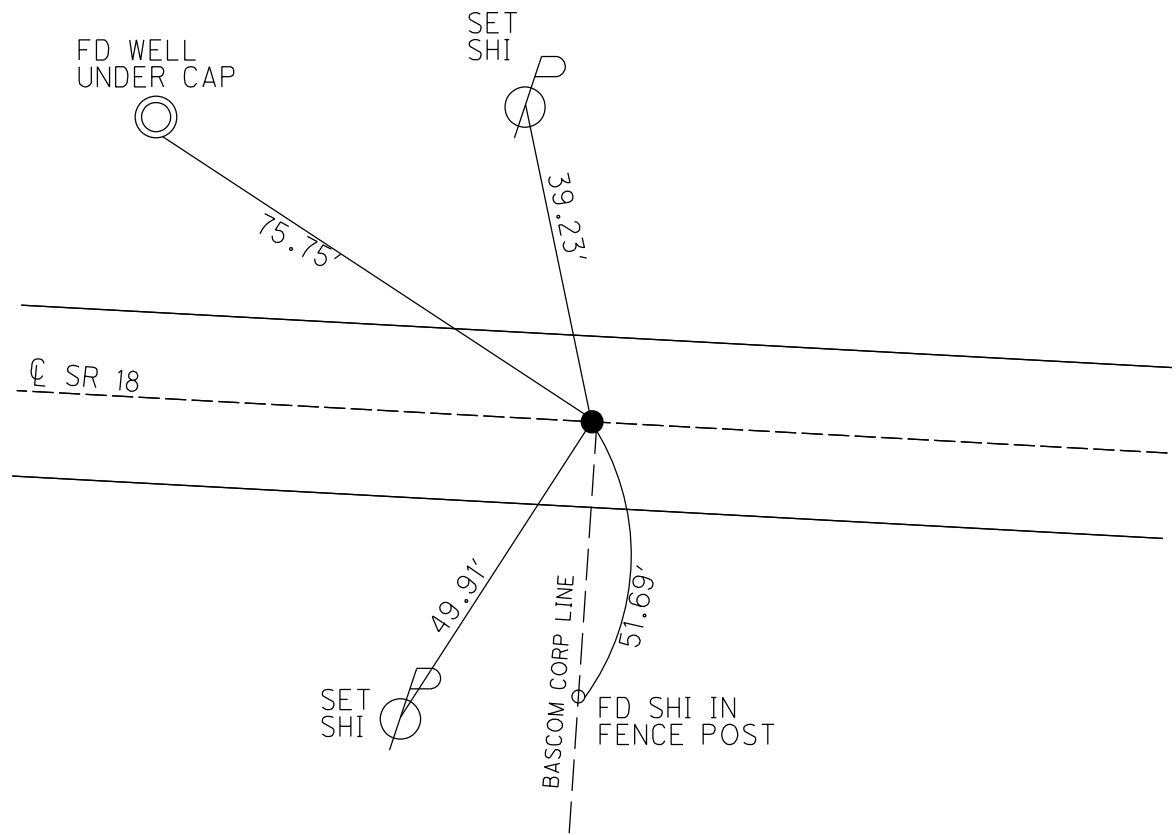

O.D.O.T. DISTRICT 2 SURVEY OFFICE (USE ONLY)

PERSONNEL

REFERENCE NO. 34

SHEET 36 OF 48

NOTES VAN DUSEN

DATE 6/4/01

ROUTE SR 18

H.C. ROUSOS

WEATHER SUNNY

COUNTY SENECA

R.C. BROWN

TEMP. 60°

TOWNSHIP HOPEWELL

SECTION 17

DWG BY NIESE

PID NO PID

T 2 N R 14 E

TYPE MONUMENT P.K./WASHER

ON SURFACE - ~~BELOW~~ ON

OFFSET Q PAVEMENT 0.5' LT : ~~RT~~

10.5' TO LT EDGE PAVEMENT



STATION: 471+38

HORZ.DATUM: NAD83(2011)

GEOID: 2012A

GRID: NORTHING: 534760.742

EASTING: 1756133.195

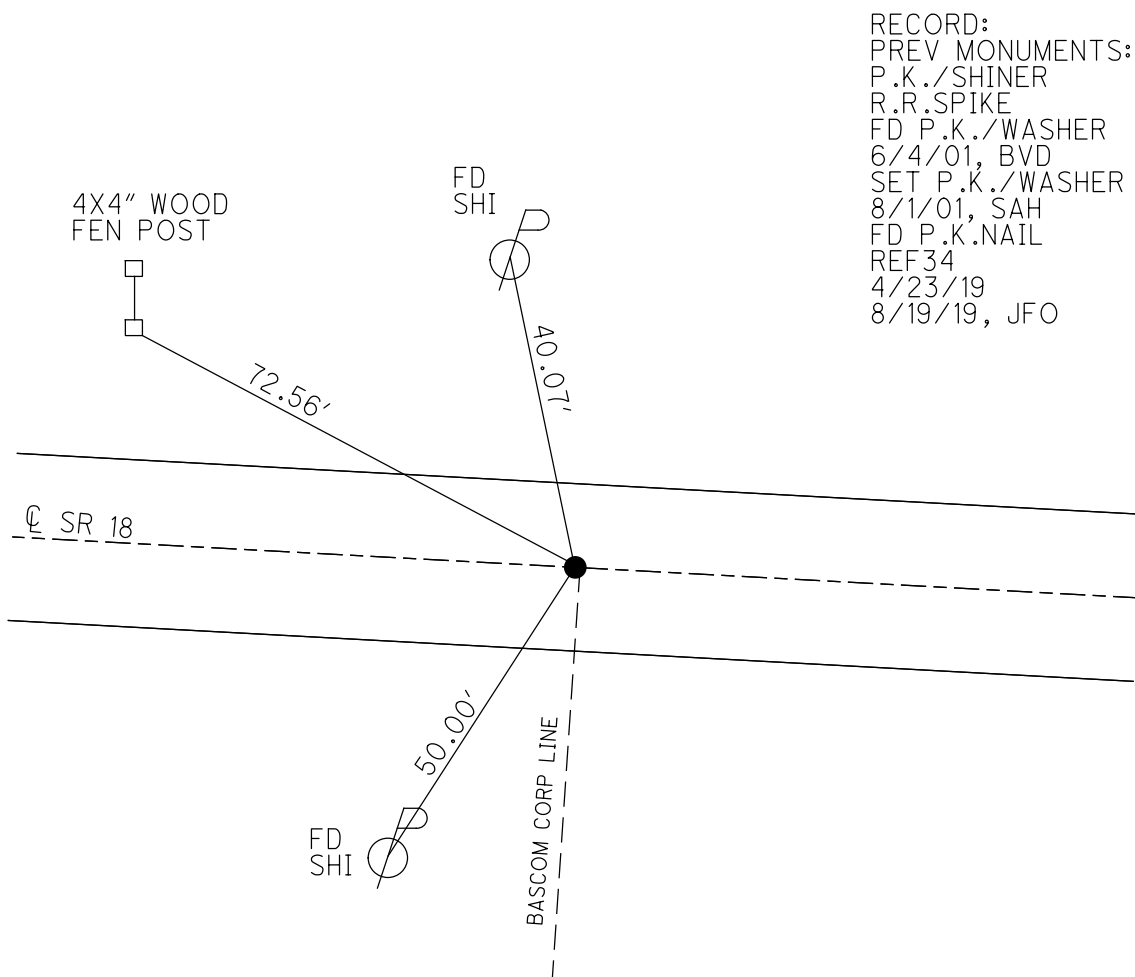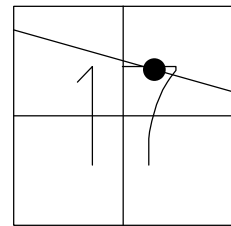

RECORD:
PREV MONUMENTS:
P.K./SHINER
R.R.SPIKE
FD P.K./WASHER
6/4/01, BVD
SET P.K./WASHER
8/1/01, SAH
FD P.K.NAIL
REF34
4/23/19
8/19/19, JFO

O.D.O.T. DISTRICT 2 SURVEY OFFICE

PERSONNEL

REFERENCE NO. 34

SHEET 15 OF 26

NOTES VAN DUSEN

H.C. KOUSOS

R.C. ADAM B.

DATE 6-4-01

WEATHER JUNNY

TEMP. +60° F

ROUTE 18

COUNTY SENGCA

TOWNSHIP HOPGWELL

SECTION 17

T2 N R 14 E


TYPE MONUMENT PKF WASHER

ON SURFACE - BELOW YES

LEFT- & PAW'T. - RIGHT 0.5'


10.5 TO LT. EDGE PAVEMENT

S.L.M. 471+38

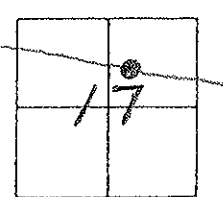

PREVIOUS MONUMENTS:
P.K./SHINER REG;
R.R. SPK.

SET PKF WASHER
8-1-01
SAH

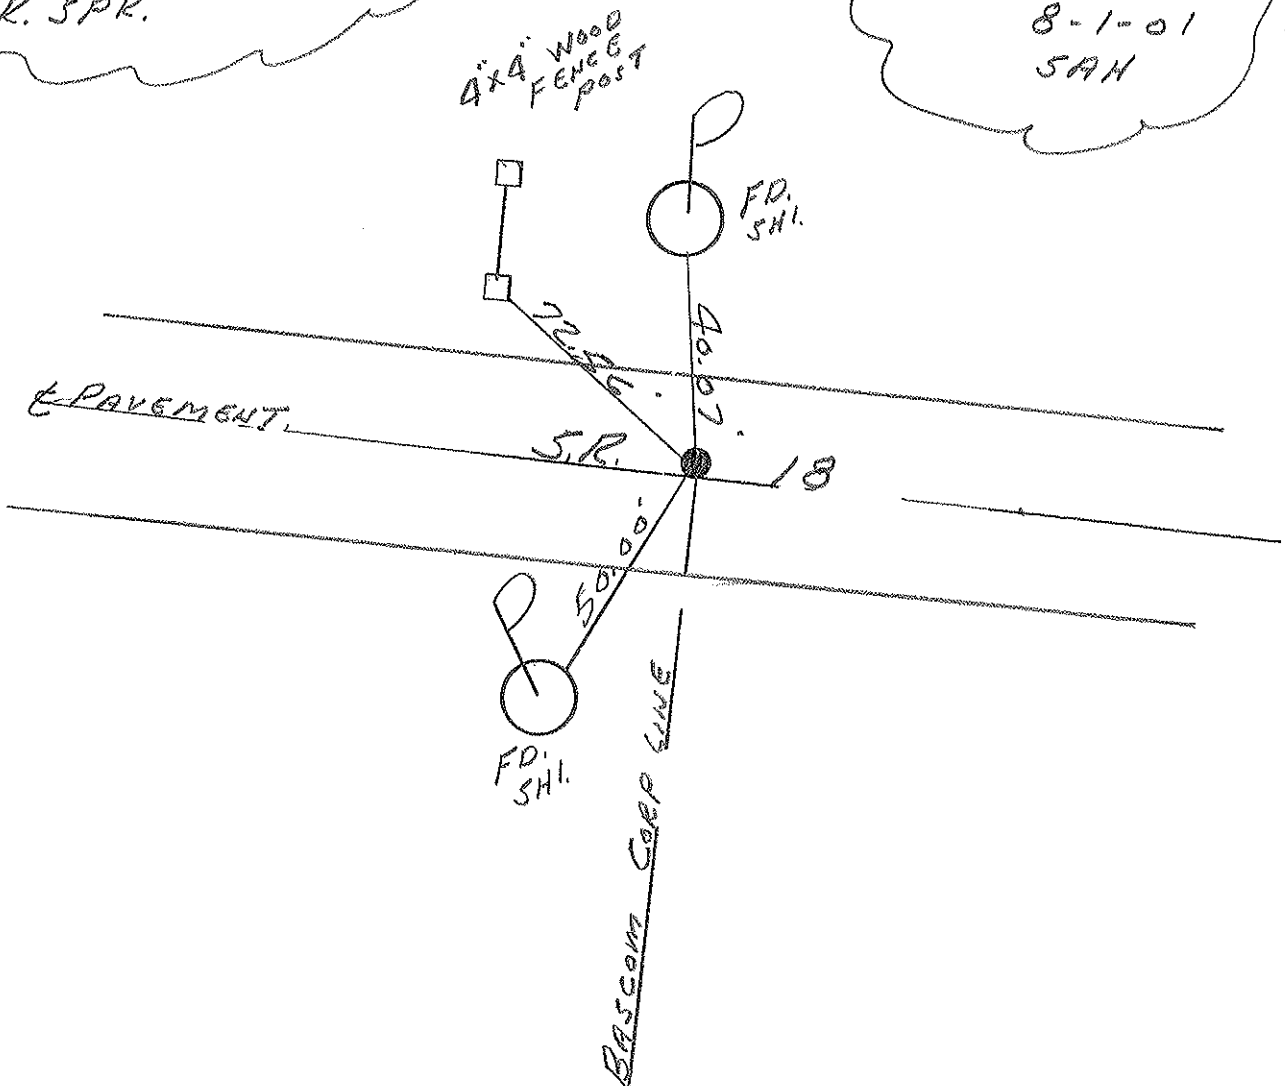

O.D.O.T. DISTRICT 2 SURVEY OFFICE

PERSONNEL

REFERENCE NO. 34

SHEET 15 OF 27

NOTES CHENEY

H.C. RIPPLE

R.C. BARBOUR

GEYMAN

DATE 11-5-1991

WEATHER PARTLY CLOUDY

TEMP. 25°

ROUTE 18

COUNTY SENECA

TOWNSHIP HOPEWELL

SECTION 17

T. 2 N R. 14 E


TYPE MONUMENT SET PK/WASHER

ON SURFACE - BELOW

LEFT- & PAW'T. - RIGHT 0.5'

10.5' TO N. EDGE PAVEMENT


S.L.M. 471+10

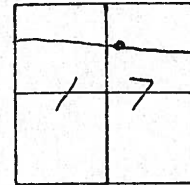

PREVIOUS MONUMENTS:

P.K./SHINER

P.F. SPK.

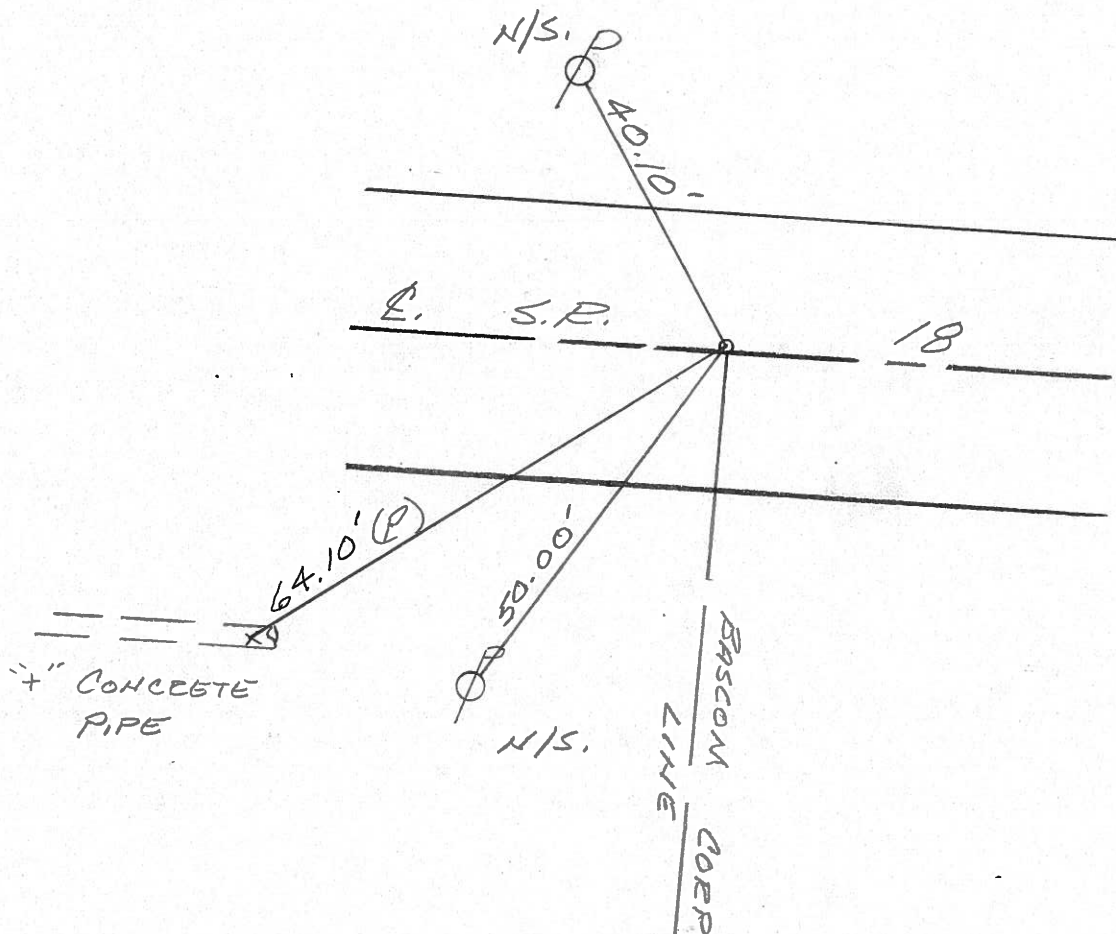

Q.D.O.T. DISTRICT 2 SURVEY OFFICE

Sht. 15 of

County Seneca S.R. # 18

Township Hopewell

Section 17

T2N, R14E

Personnel Schneider

Mosser

Barbour


Gronin

Ripple Geyman

Date OK-9-12-80 G.W.S.
5-19-80

Weather Cloudy

Temp. 58°

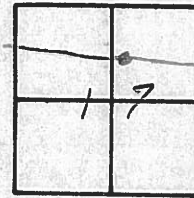


(34)



R.R. SPK.

SET P.K. & SHI.

SR. # 18

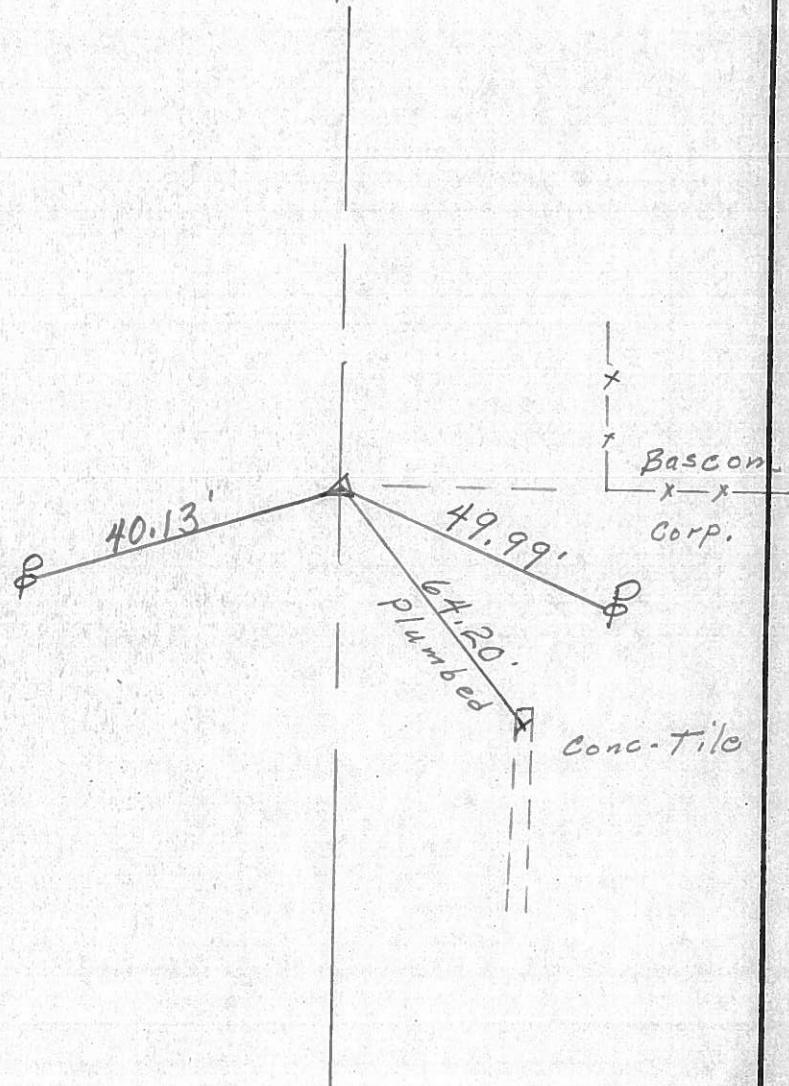

PERSONNEL	TITLE	PERSONNEL	TITLE	COUNTY	DATE	WEATHER	TEMP.
Schneider		Potts		Seneca	10-24-68	Cloudy-Rain	50°
Mosser				S. R. 1.8			
Barbour				SEC. Bascom to Tiffin			
Redding							

DESCRIPTION Ties for Control Points JOB NO. _____

