

O.D.O.T. DISTRICT 2 SURVEY OFFICE (USE ONLY)

PERSONNEL

REFERENCE NO. 35

SHEET OF

NOTES RHOADES

DATE 4/10/24

ROUTE SR 18

H.C. NIESE

WEATHER CLOUDY

COUNTY SENECA

R.C. MILLER

TEMP. 62°

TOWNSHIP HOPEWELL

DWG BY BARRIERE

PID 92371

SECTION 17

T 2 N R 14 E

TYPE MONUMENT 1" IPIN

ON SURFACE - BELOW 4" BELOW

OFFSET CL PAVEMENT 18.5' LT LT : RT

 TO EDGE PAVEMENT

STATION: 476+50.21

HORIZ.DATUM: NAD83 (2011)


GEOID: 18

GRID: NORTHING: 534700.434


EASTING: 1756698.285

LDP: NORTHING:

EASTING:

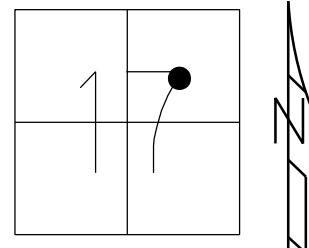

RECORD: P.I.
CONSTRUCTION
STA. 464+50.21
FD BOLT
± DOWN
6/4/01, BVD
FD 1" IPIN
4" DOWN
REF35
4/23/19, JFO
9/27/22, TDN

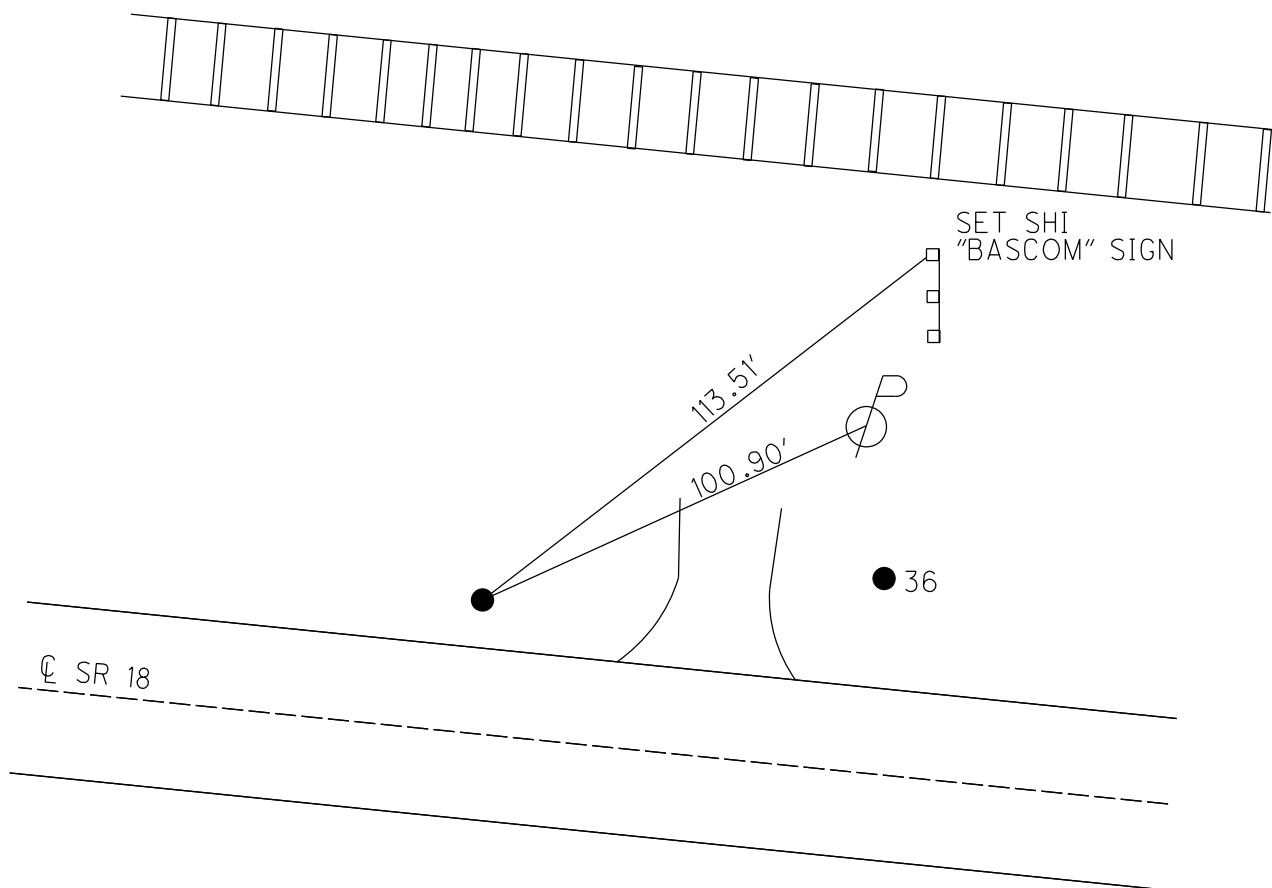

DIST. 35-36 = 111.85' (GPS INV)

O.D.O.T. DISTRICT 2 SURVEY OFFICE (USE ONLY)

PERSONNEL

REFERENCE NO. 35

SHEET 37 OF 48

NOTES VAN DUSEN

DATE 6/4/01

ROUTE SR 18

H.C. ROUSOS

WEATHER SUNNY

COUNTY SENECA

R.C. BROWN

TEMP. 60°

TOWNSHIP HOPEWELL

DWG BY NIESE

PID NO PID

SECTION 17

T 2 N R 14 E

TYPE MONUMENT BOLT

~~ON SURFACE~~ - BELOW ±

OFFSET Q PAVEMENT 18.5' LT : ~~RT~~

8.0' TO LT EDGE PAVEMENT


STATION: 476+50.21

HORZ.DATUM: NAD83(2011)


GEOID: 2012A

GRID: NORTHING: 534700.416

EASTING: 1756698.294

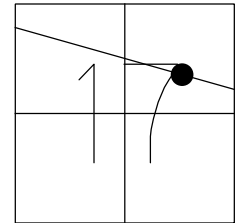

RECORD: P.I.
CONSTRUCTION
STA.464+50.21
FD BOLT
± DOWN
6/4/01, BVD
FD 1" IPIN
4" DOWN
REF35
4/23/19, JFO

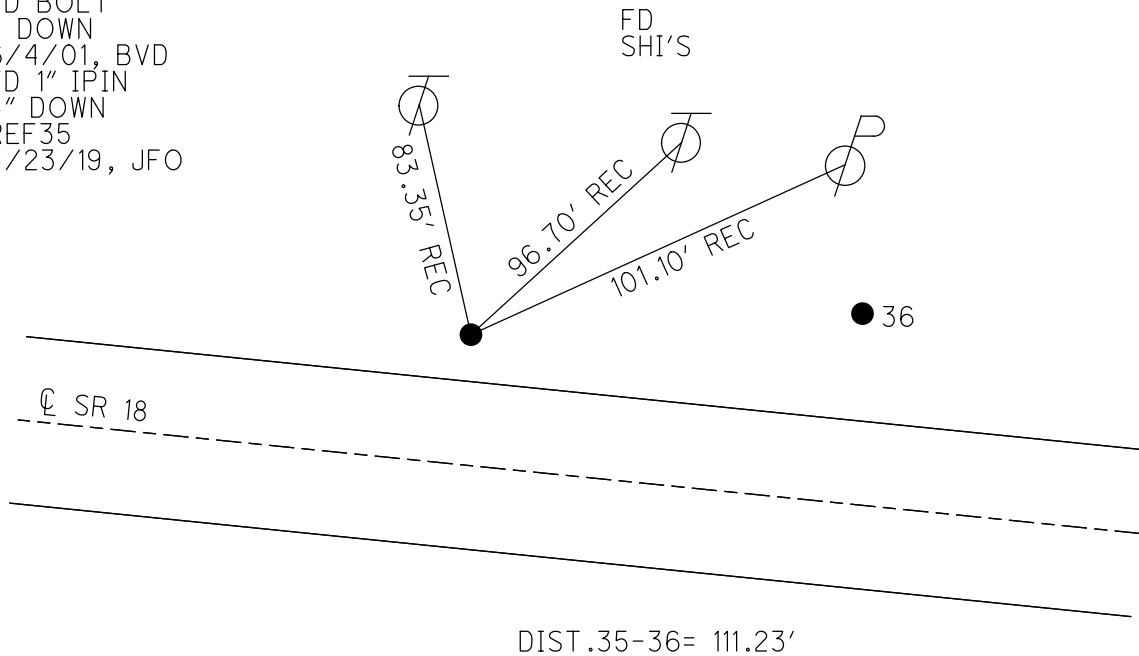

O.D.O.T. DISTRICT 2 SURVEY OFFICE

PERSONNEL

REFERENCE NO. 35436

SHEET 16 OF 26

NOTES VanDusen

H.C. Rousos

R.C. Brown

DATE 6-4-01

WEATHER Sunny

TEMP. 60°F.

ROUTE 18

COUNTY Sherida

TOWNSHIP Hopewell

SECTION 17

T 2 N R 14 E

TYPE MONUMENT


(A) - Bolt.
(B) - 1" Iron Pin

ON SURFACE - (BELOW)

LEFT PAV'T RIGHT A = 18.5' B = 36.5'

A = 8.7'
B = 25.5' TO N EDGE PAVEMENT


S.L.M. (A) 476179 (B) 477188

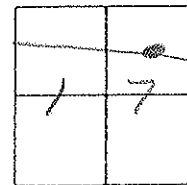

Record:

(A) Plan Sta. = 464+50.21

(B) Plan Sta. = 465+61.90

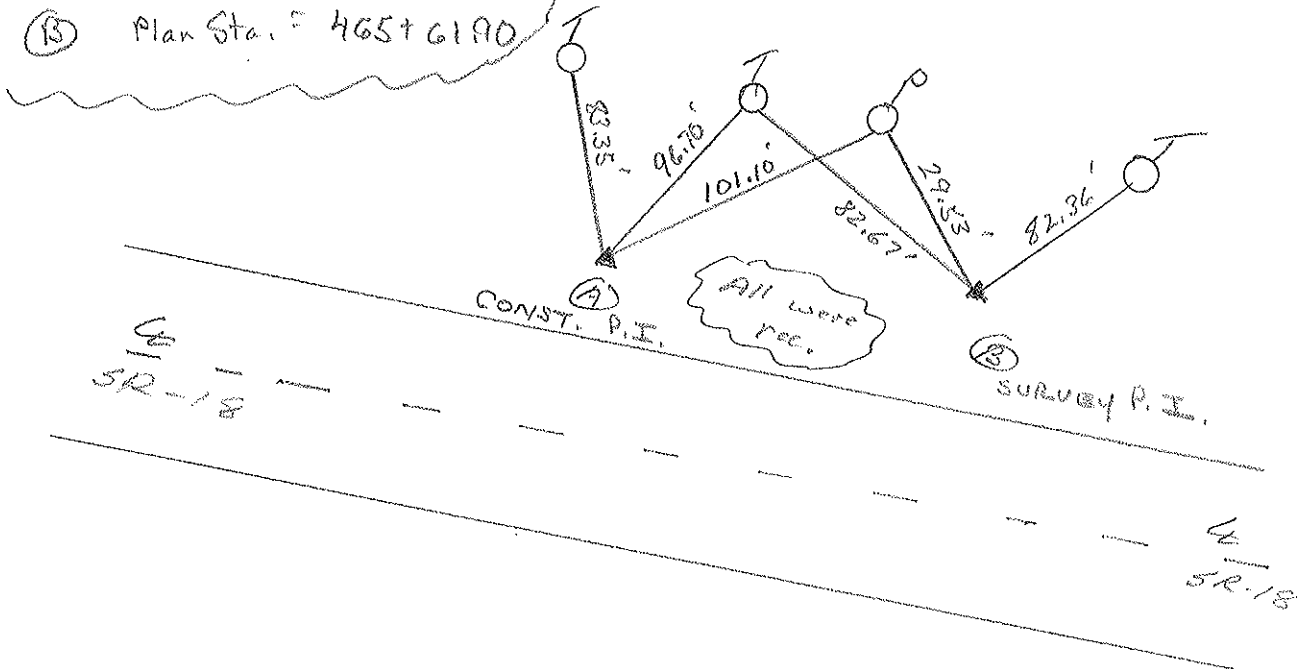

O.D.O.T. DISTRICT 2 SURVEY OFFICE

PERSONNEL

REFERENCE NO. 35+36

SHEET 16 OF 27

NOTES CHENEY

H.C. RIPPLE

DATE 11-5-1991

ROUTE 18

R.C. BARDOUT

WEATHER PARTLY CLOUDY

COUNTY SENECA

GEYMAN

TEMP. 25°

TOWNSHIP HOPEWELL

SECTION 17

T 2 N R 14 E



TYPE MONUMENT 1" I. PIN - E. SURVEY - P.I.
BOLT - E. CONST. - P.I.

~~ON SURFACE~~ - BELOW

LEFT - & PAV'T. - ~~RIGHT~~ 36.5' - SURVEY
18.5' - CONST.

TO N. EDGE PAVEMENT

S.L.M. 477+88 - SURV., 476+79 - CONST.

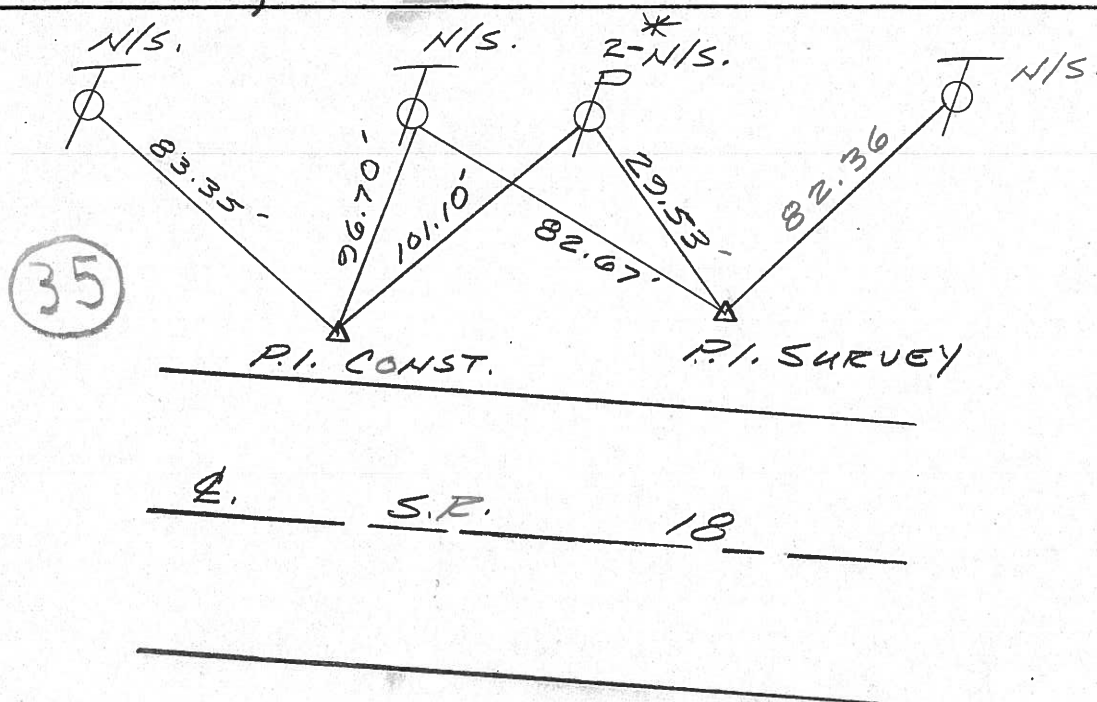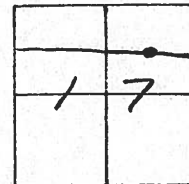

PLAN STA = 464+5021

PLAN STA 465+61.90

Q.D.O.T. DISTRICT 2 SURVEY OFFICE

Sht. of

OK-9-12-80-G.W.S.

County Seneca S.R. # 18

Date 5-19-80

Township Hopewell

Weather Cloudy

Section 17

Temp. 58°

T2N, R14E


Personnel Schneider

Mosser

Barbour

Cronin

Ripple Geyman

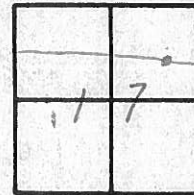


(36)

OK
P.I. Survey
465 + 61.90
Iron Pin

OK
P.I. Const.-
464 + 50.21
sq. bolt

(35)

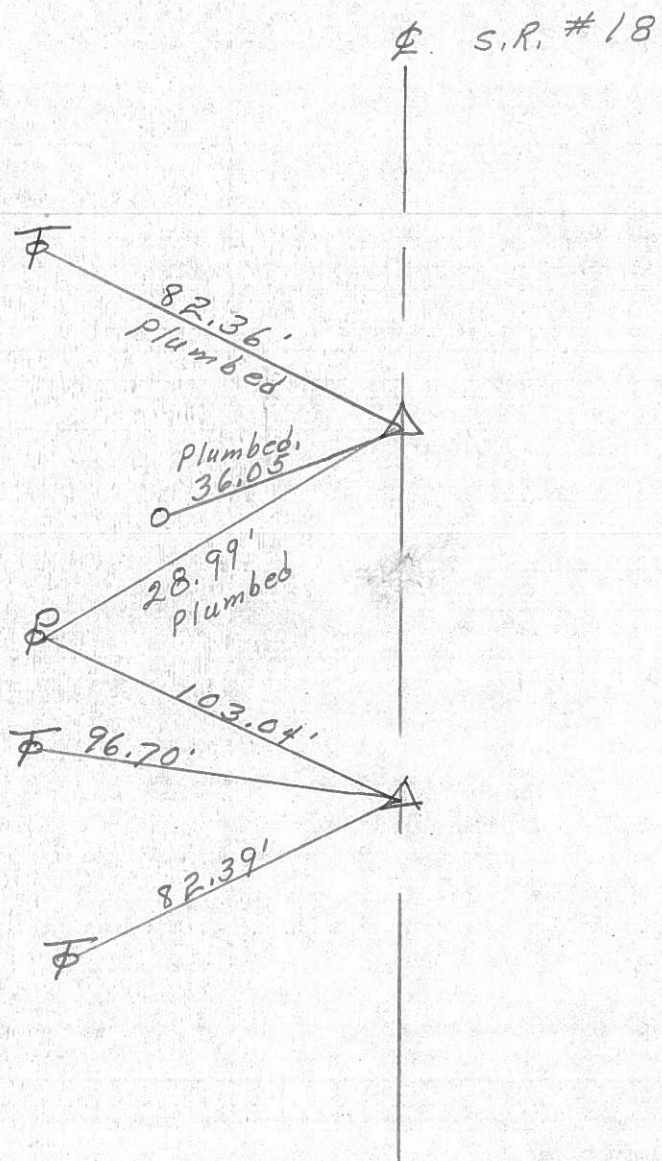

PERSONNEL	TITLE	PERSONNEL	TITLE	COUNTY	DATE	WEATHER	TEMP.
Schneider		Potts		Seneca	10-24-68	Cloudy-Rain	50°
Mosser				S. R. 18			
Barbour				SEC. Bascom to Tiffin			
Redding							

DESCRIPTION Ties for Control Points JOB NO. _____

