

O.D.O.T. DISTRICT 2 SURVEY OFFICE (USE ONLY)

PERSONNEL

REFERENCE NO. 37

SHEET OF

NOTES RHOADES

H.C. NIESE

R.C. MILLER

DATE 4/10/24

WEATHER CLOUDY

TEMP. 62°

ROUTE SR 18

COUNTY SENECA

TOWNSHIP HOPEWELL

SECTION 16

DWG BY BARRIERE PID 92371

T 2 N R 14 E

TYPE MONUMENT MAG NAIL/WASHER

ON SURFACE - BELOW ON

OFFSET $\mathcal{C}$ PAVEMENT 22.5' RT LT : RT

 TO EDGE PAVEMENT

STATION: 485+30

HORIZ.DATUM: NAD83 (2011)


GEOID: 18

GRID: NORTHING: 534382.777


EASTING: 1757469.237

LDP: NORTHING:

EASTING:

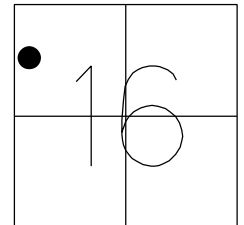

RECORD P.I.
STA 472+87.33
 $\Delta = 17^{\circ} 26' 00''$ LT
D = $12^{\circ} 00' 00''$
R = 477.46'
L = 145.28'
T = 73.21'
E = 5.58'
PREV MONUMENTS:
P.K./SHINER
R.R.SPIKE
FD P.K./WASHER
6/4/01, BVD
SET P.K./WASHER
8/1/01, SAH
FD P.K.SHANK
1 1/2" DOWN
REF37
4/23/19
8/19/19, JFO
9/2/21, DSA
2/16/22, JFO
9/27/22, TDN
SET MAG/WASHER
9/11/24, TDN

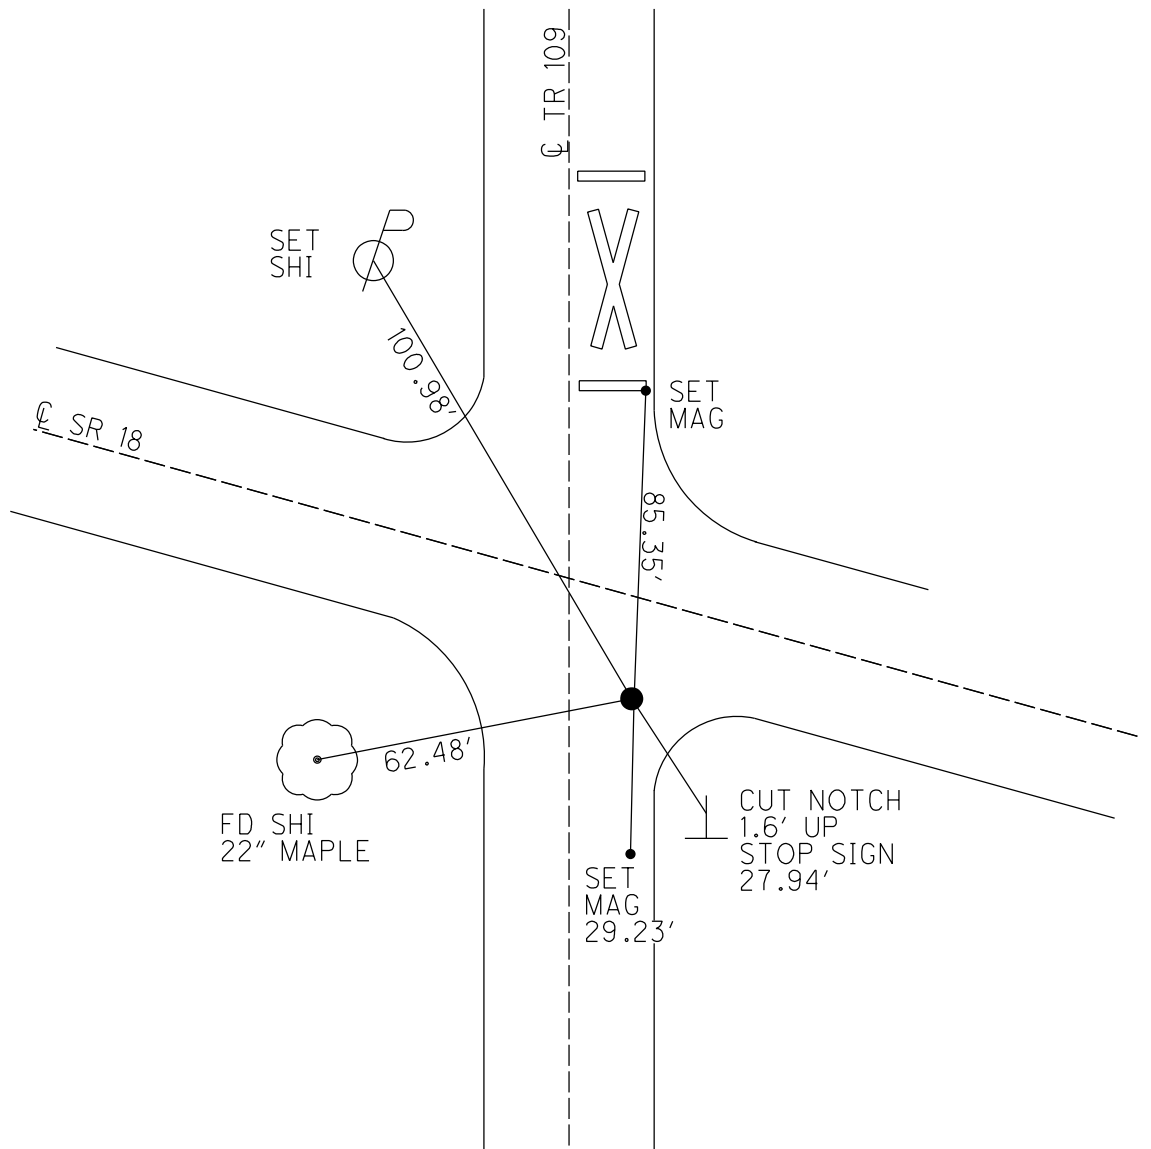

O.D.O.T. DISTRICT 2 SURVEY OFFICE (USE ONLY)

PERSONNEL

REFERENCE NO. 37

SHEET 39 OF 48

NOTES SAVAGE

DATE 9/2/21

ROUTE SR 18

H.C. AUBLE

WEATHER SUNNY

COUNTY SENECA

R.C. NIESE

TEMP. 64°

TOWNSHIP HOPEWELL

SECTION 16

DWG BY RHOADES PID PAVTRAIN

T 2 N R 14 E

TYPE MONUMENT P.K.SHANK

~~ON SURFACE~~ - BELOW 1 1/2"

OFFSET Q PAVEMENT 22.5' ~~LT~~ : RT

12.0' TO RT EDGE PAVEMENT



STATION: 485+30

HORZ.DATUM: NAD83(21011)

GEOID: 2012A

GRID: NORTHING: 534382.771

EASTING: 1757469.238

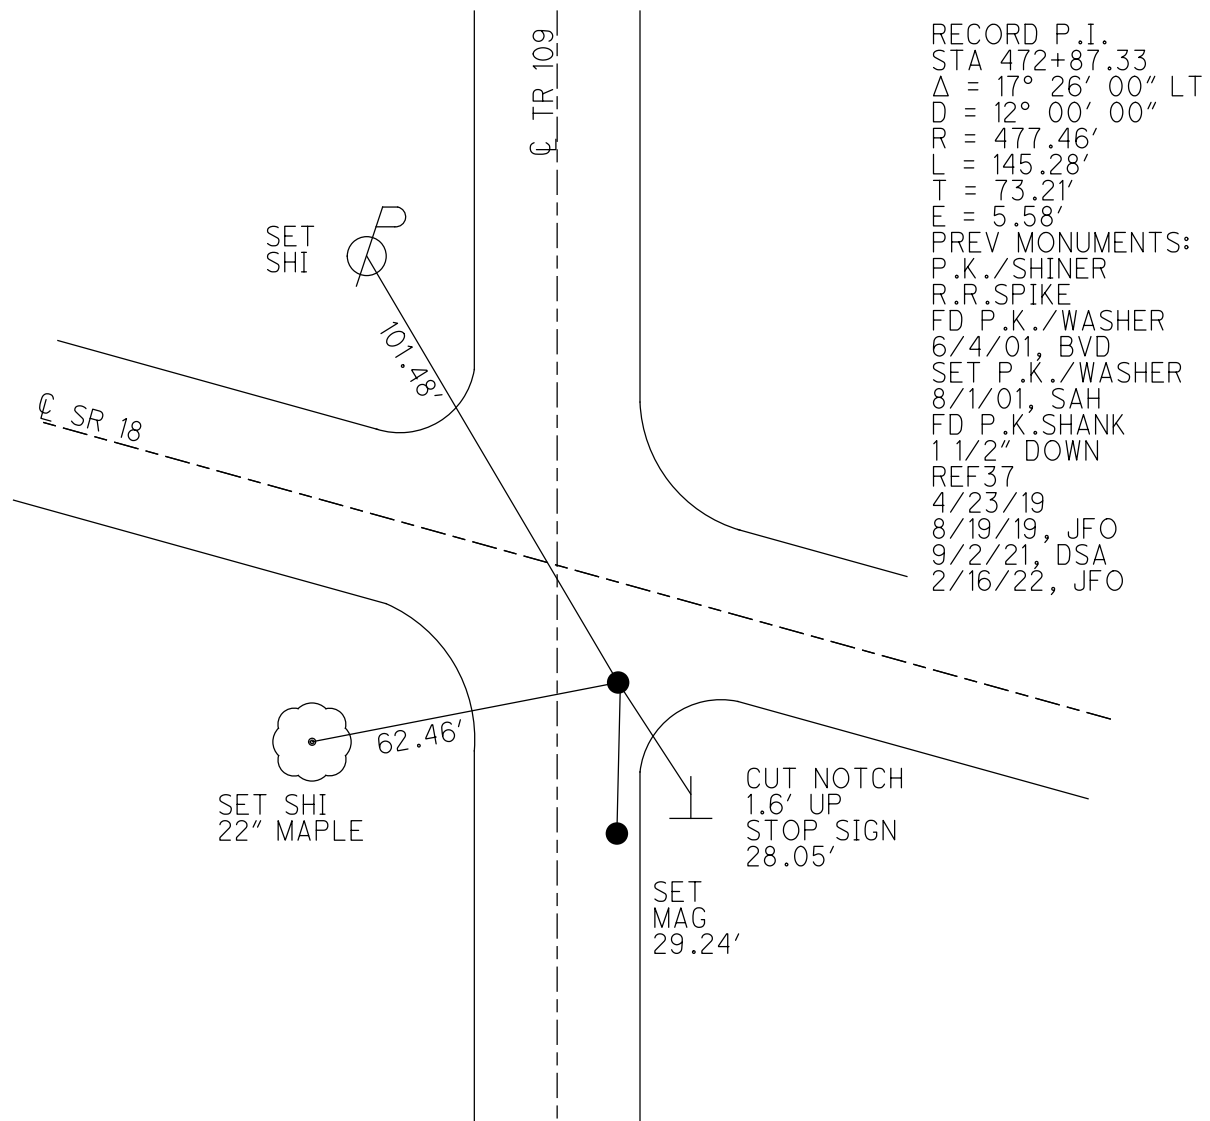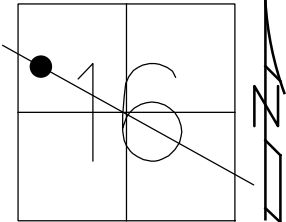

O.D.O.T. DISTRICT 2 SURVEY OFFICE (USE ONLY)

PERSONNEL

REFERENCE NO. 37

SHEET 39 OF 48

NOTES VAN DUSEN

DATE 6/4/01

ROUTE SR 18

H.C. ROUSOS

WEATHER SUNNY

COUNTY SENECA

R.C. BROWN

TEMP. 60°

TOWNSHIP HOPEWELL

SECTION 16

DWG BY NIESE PID NO PID

T 2 N R 14 E

TYPE MONUMENT P.K./WASHER

ON SURFACE - ~~BELOW~~ ON

OFFSET CL PAVEMENT 22.5' ~~LT~~ : RT

12.0' TO RT EDGE PAVEMENT



STATION: 485+30

HORIZ.DATUM: NAD83(21011)

GEOID: 2012A

GRID: NORTHING: 534382.771

EASTING: 1757469.238

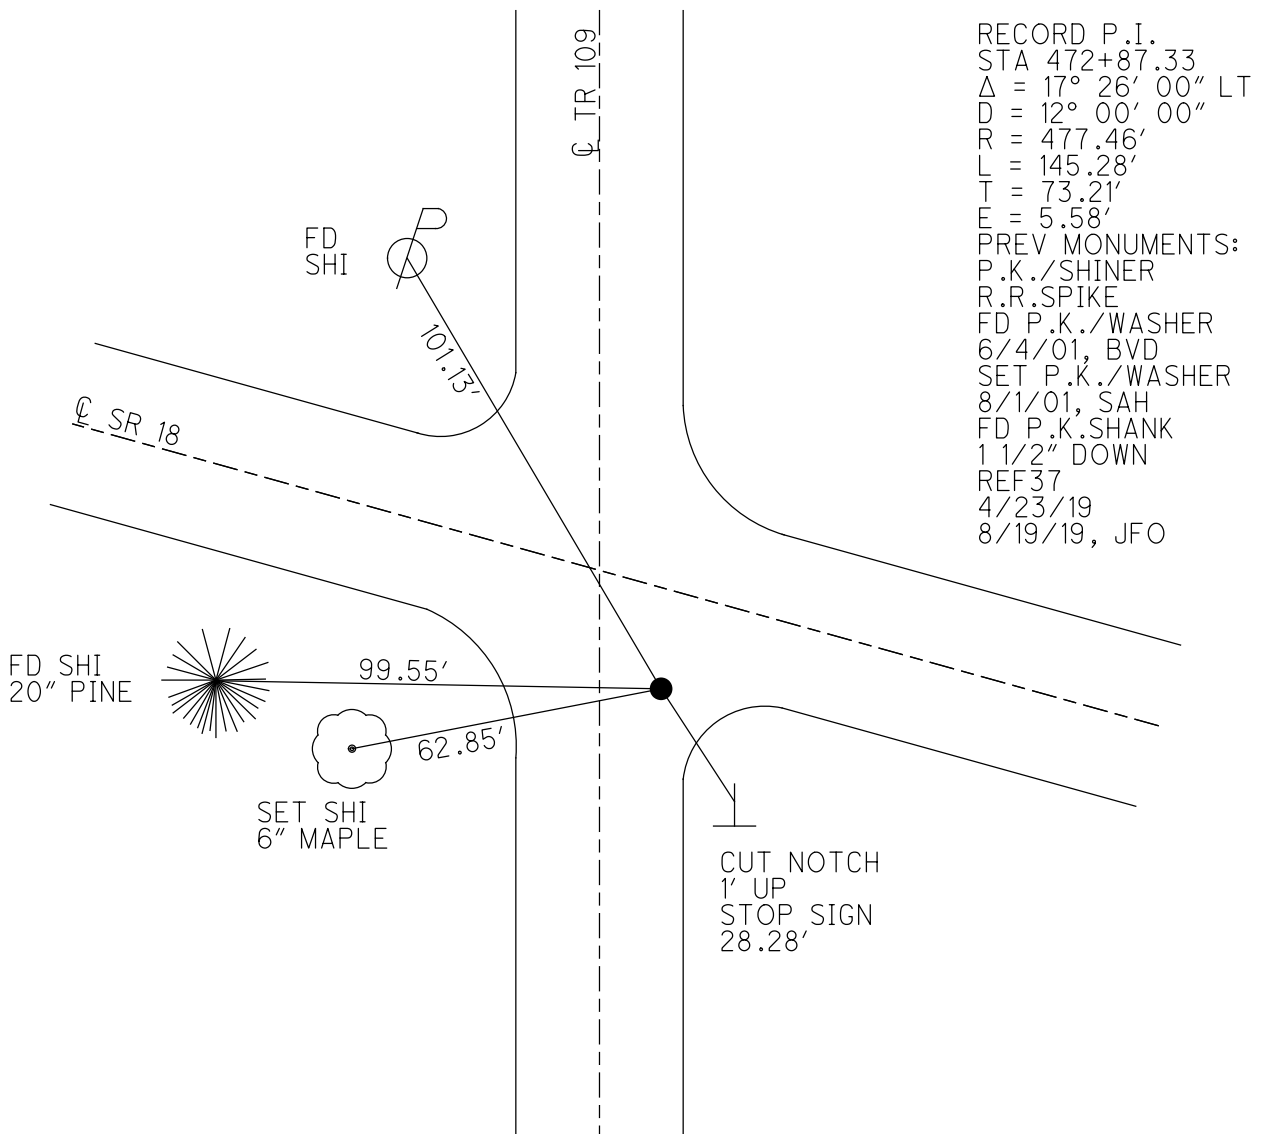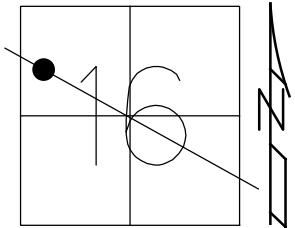

RECORD P.I.
STA 472+87.33
 $\Delta = 17^\circ 26' 00''$ LT
D = 12° 00' 00"
R = 477.46'
L = 145.28'
T = 73.21'
E = 5.58'
PREV MONUMENTS:
P.K./SHINER
R.R.SPIKE
FD P.K./WASHER
6/4/01, BVD
SET P.K./WASHER
8/1/01, SAH
FD P.K.SHANK
1 1/2" DOWN
REF37
4/23/19
8/19/19, JFO

O.D.O.T. DISTRICT 2 SURVEY OFFICE

PERSONNEL

REFERENCE NO. 37

SHEET 17 OF 26

NOTES VAN DUSEN

H.C. ROUSOS

R.C. ADAM B.

DATE 6-4-01

WEATHER SUNNY

TEMP. +60°F

ROUTE 18

COUNTY SENECA

TOWNSHIP HOPEWELL

SECTION 16

T2 N R 14 E


TYPE MONUMENT PK & WASHER

ON SURFACE - BELOW YES

LEFT - CL PAV'T. - RIGHT 22.5


12' TO S. EDGE PAVEMENT

S.L.M. 485+30

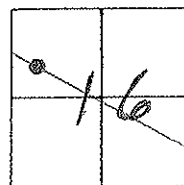

SET PK/WASHER
SAH 8-1-01

PREVIOUS MONUMENTS:
P.K. / SHINER
R.R. SPK.
PLAN STA. = 472+87.33
PLAN STA. 472+66.22

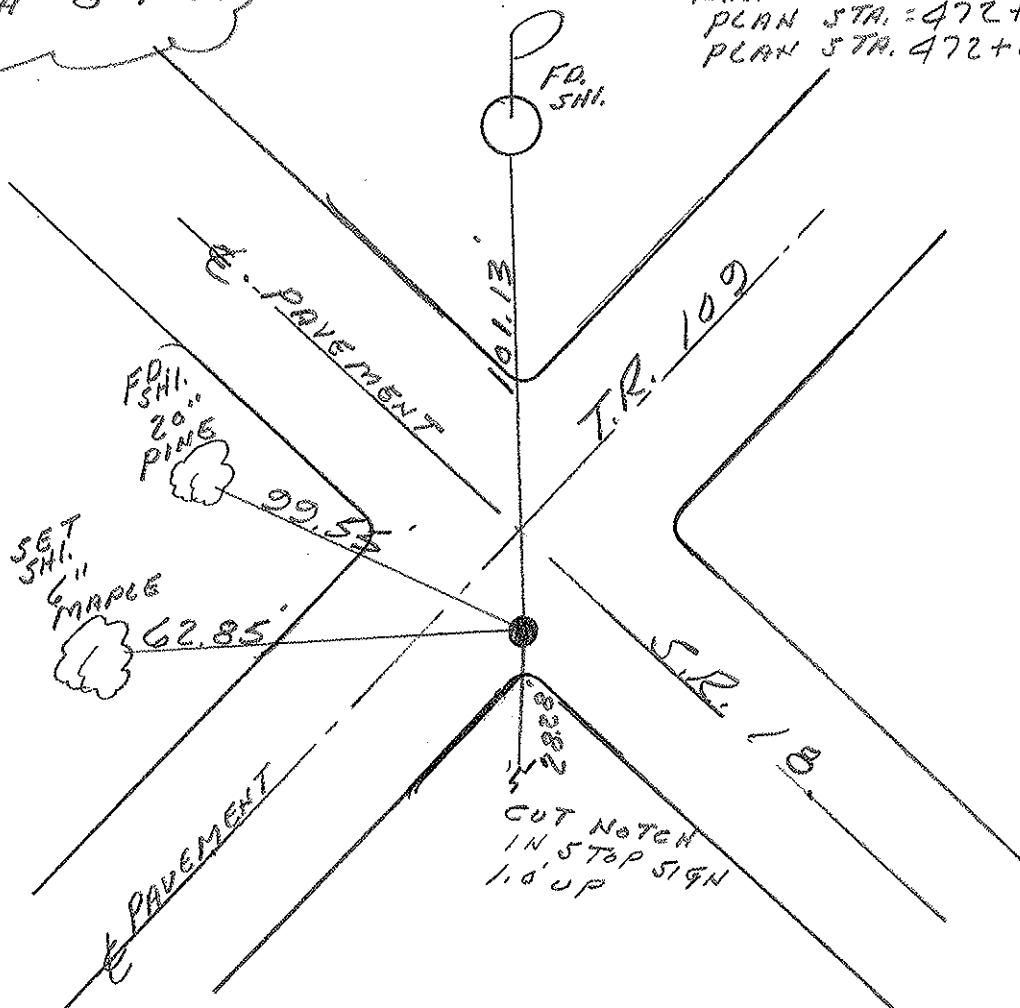

O.D.O.T. DISTRICT 2 SURVEY OFFICE

PERSONNEL

REFERENCE NO. 37

SHEET 17 OF 27

NOTES CHENEY

H.C. RIPPLE

R.C. BARBOUR

GEYMAN

DATE 11-5-1991

WEATHER BTLY CLOUDY

TEMP. 30°

ROUTE 18

COUNTY SENECA

TOWNSHIP HOPEWELL

SECTION 10

T 2 N R 14 E


TYPE MONUMENT SET PK/WASHER

ON SURFACE - BELOW

LEFT - & PAU'T. - RIGHT 22.5'

12' TO S. EDGE PAVEMENT

S.L.M. 485+08

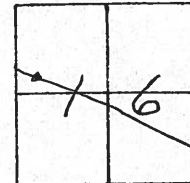


PREVIOUS MONUMENTS:

P.K. / SHINER

R.R. SPK.

PLAN STA - 472+87.33

PLAN STA - 472+66.22

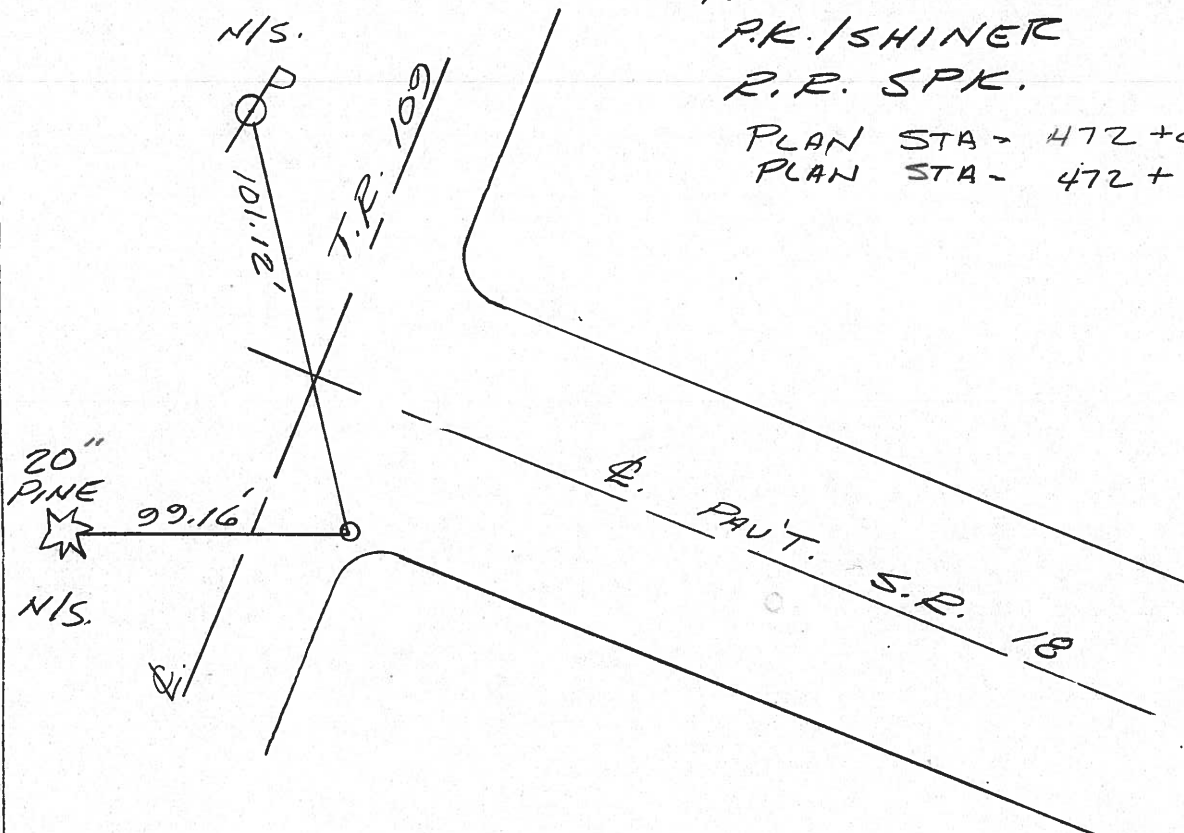

QD.O.T. DISTRICT 2 SURVEY OFFICE

Sht. 17 of

County Seneca S.R. #18

Township Hopewell

Section 16

T2N, R14E

Personnel Schneider

Mosser

Barbour



Cronin

Ripple Geyman

Date OK-9-12-80 G.W.S.
5-19-80

Weather Cloudy

Temp. 58°

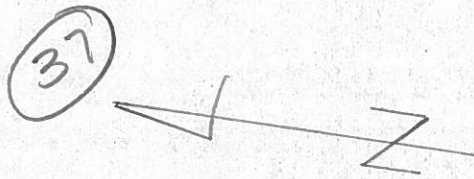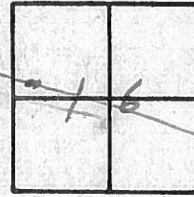

S.R. #18


472+87.33

R.R. SPK.

472+66.22

R.R. SPK.

SET P.K. & SHI.

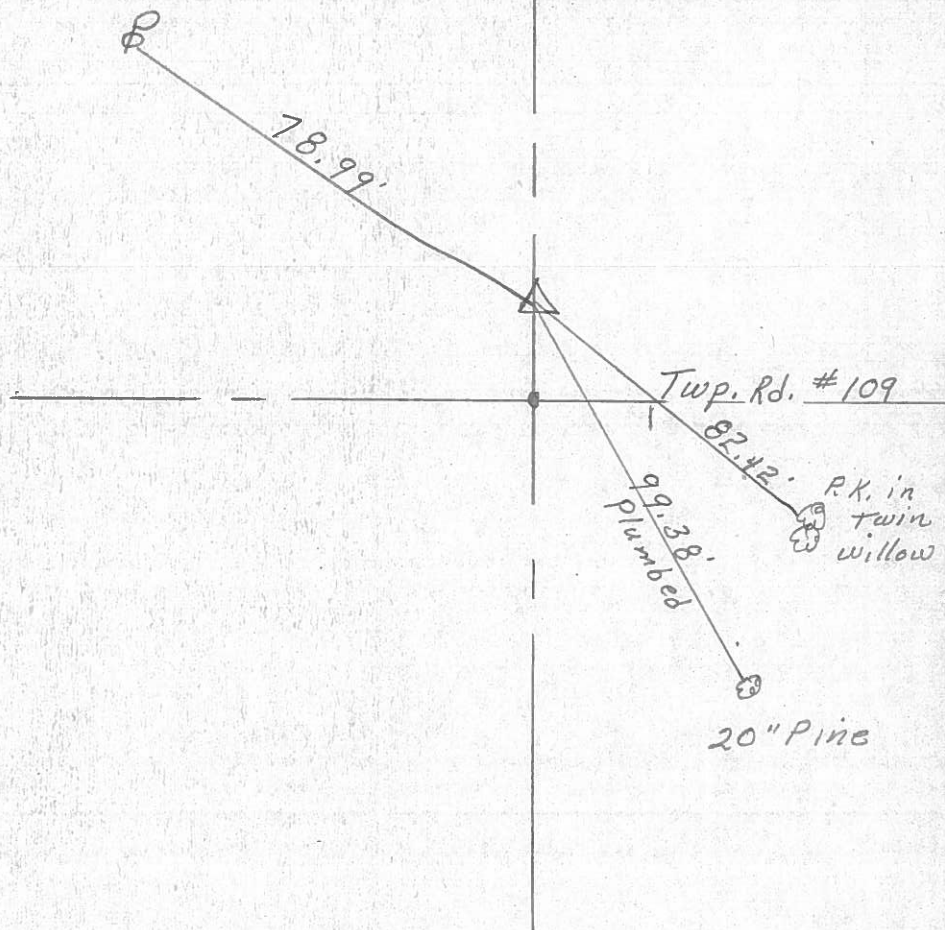

PERSONNEL	TITLE	PERSONNEL	TITLE	COUNTY	DATE	WEATHER	TEMP.
Schneider		Potts		Seneca	10-24-68	Cloudy - Rain	50°
Mosser				S. R. 18			
Barbour				SEC. Bascom to Tiffin			
Redding							

DESCRIPTION Ties for Control Points JOB NO. _____

