

O.D.O.T. DISTRICT 2 SURVEY OFFICE (USE ONLY)

PERSONNEL

REFERENCE NO. 38

SHEET OF

NOTES RHOADES

DATE 4/10/24

ROUTE SR 18

H.C. NIESE

WEATHER CLOUDY

COUNTY SENECA

R.C. MILLER

TEMP. 55°

TOWNSHIP HOPEWELL

DWG BY BARRIERE

PID 92371

SECTION 16

T 2 N R 14 E

TYPE MONUMENT MAG NAIL/WASHER

ON SURFACE - BELOW ON

OFFSET $\odot$ PAVEMENT 1.6' RT LT : RT

 TO EDGE PAVEMENT

STATION: 491+59

HORIZ.DATUM: NAD83 (2011)


GEOID: 18

GRID: NORTHING: 534301.811


EASTING: 1758089.246

LDP: NORTHING:

EASTING:

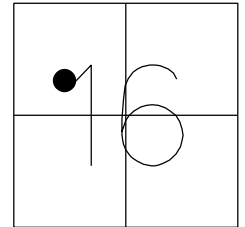

RECORD:
STA 479+11.18
PREV MONUMENTS:
P.K./WASHER
R.R.SPIKE
FD P.K./WASHER
6/4/01, BVD
SET P.K./WASHER
8/1/01, SAH
FD P.K./WASHER
REF38
4/23/19
8/19/19, JFO
D.N.F
2/16/22, JFO
SET MAG/WASHER
REF38
7/25/22, DSA
FD MAG/WASHER
REF38
9/27/22, TDN
SET MAG/WASHER
9/11/24, TDN

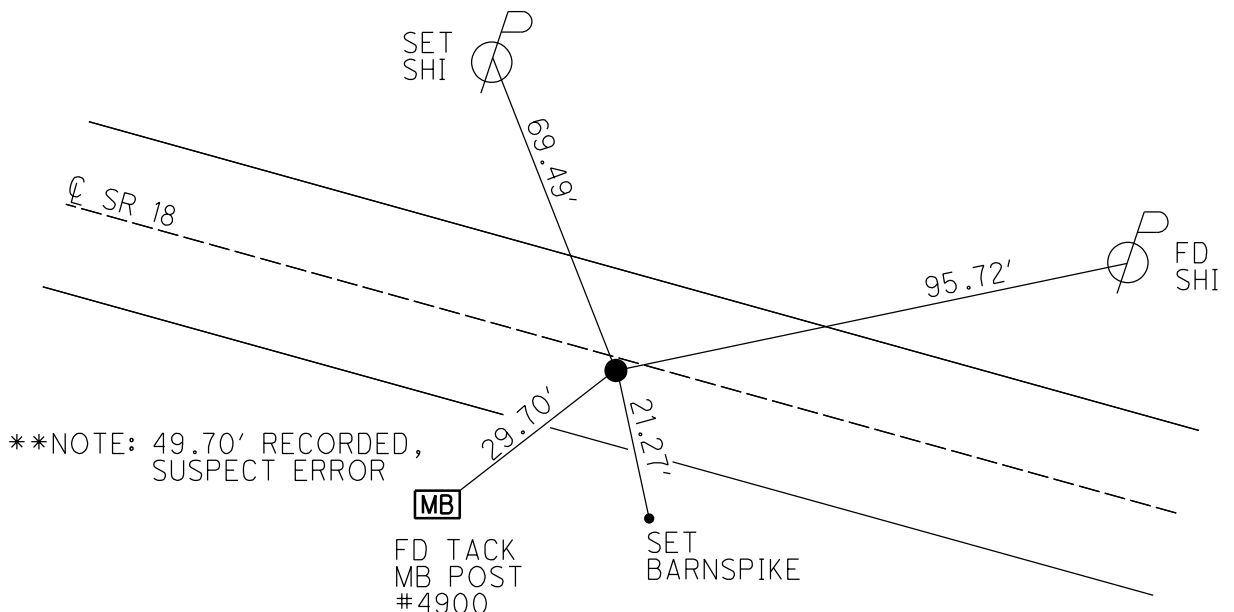

O.D.O.T. DISTRICT 2 SURVEY OFFICE (USE ONLY)

PERSONNEL

REFERENCE NO. 38

SHEET 40 OF 48

NOTES MMS

DATE 9/2/21

ROUTE SR 18

H.C. AUBLE

WEATHER SUNNY

COUNTY SENECA

R.C. MIESE

TEMP. 64°

TOWNSHIP HOPEWELL

DWG BY WHITAKER PID PVTRN

SECTION 16

T 2 N R 14 E

TYPE MONUMENT P.K./WASHER

ON SURFACE - ~~BELOW~~ ON

OFFSET CL PAVEMENT 1.0' ~~LT~~ : RT

10.0' TO RT EDGE PAVEMENT


STATION: 491+59

HORZ.DATUM: NAD83(2011)


GEOID: 2012A

GRID: NORTHING: 534301.799

EASTING: 1758089.243

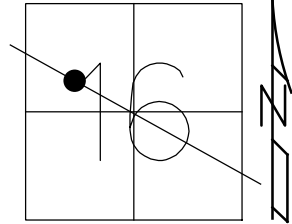

RECORD:
STA 479+11.18
PREV MONUMENTS:
P.K./WASHER
R.R.SPIKE
FD P.K./WASHER
6/4/01, BVD
SET P.K./WASHER
8/1/01, SAH
FD P.K./WASHER
REF38
4/23/19
8/19/19, JFO
D.N.F
2/16/22, JFO
SET MAG/WASHER
REF38
7/25/22, DSA

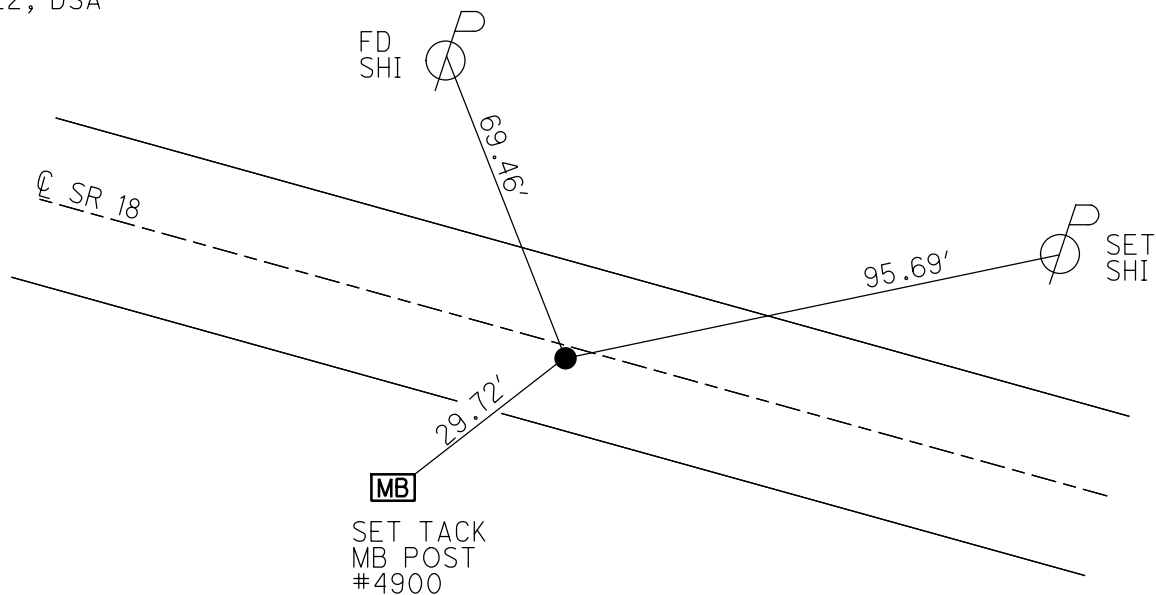

O.D.O.T. DISTRICT 2 SURVEY OFFICE (USE ONLY)

PERSONNEL

REFERENCE NO. 38

SHEET 40 OF 48

NOTES VAN DUSEN

DATE 6/4/01

ROUTE SR 18

H.C. ROUSOS

WEATHER SUNNY

COUNTY SENECA

R.C. BROWN

TEMP. 60°

TOWNSHIP HOPEWELL

SECTION 16

DWG BY NIESE PID NO PID

T 2 N R 14 E

TYPE MONUMENT P.K./WASHER

ON SURFACE - ~~BELOW~~ ON

OFFSET 1.0' RT : RT

10.0' TO RT EDGE PAVEMENT


STATION: 491+59

HORIZ.DATUM: NAD83(2011)


GEOID: 2012A

GRID: NORTHING: 534301.799

EASTING: 1758089.243

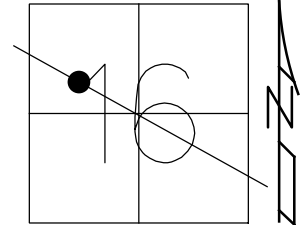

RECORD:
STA 479+11.18
PREV MONUMENTS:
P.K./WASHER
R.R.SPIKE
FD P.K./WASHER
6/4/01, BVD
SET P.K./WASHER
8/1/01, SAH
FD P.K./WASHER
REF38
4/23/19
8/19/19, JFO

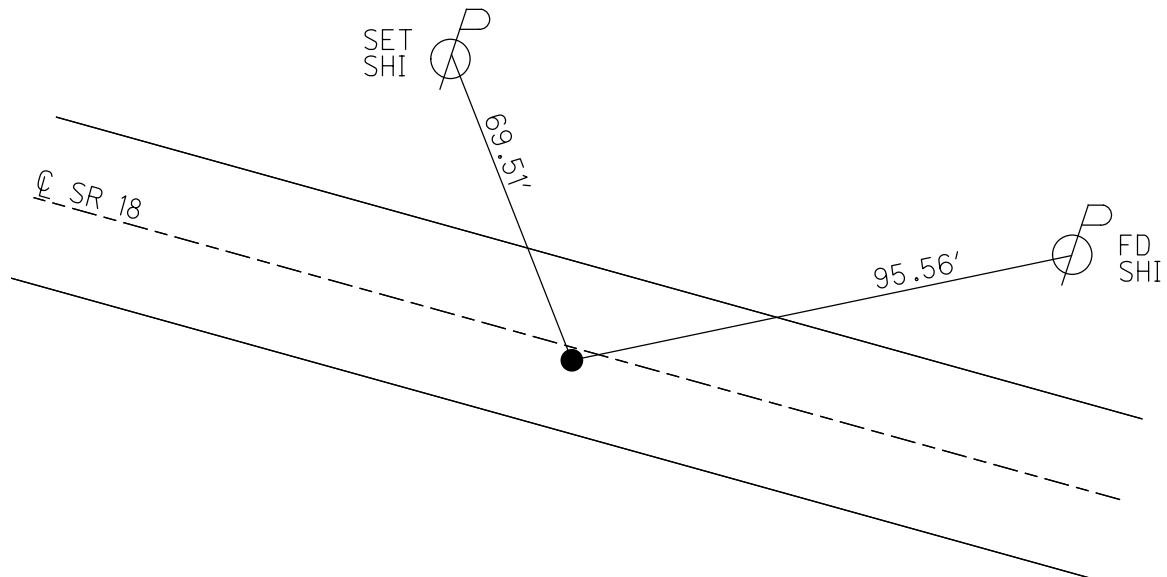

O.D.O.T. DISTRICT 2 SURVEY OFFICE

PERSONNEL

REFERENCE NO. 38

SHEET 18 OF 26

NOTES Dan Wuseu

H.C. Rousos

R.C. Brown

DATE 6-4-01

WEATHER Sunny

TEMP. 60°

ROUTE 18

COUNTY Seneca

TOWNSHIP Hopewell

SECTION 16

T 2 N R 11 E


TYPE MONUMENT PK/W

(ON SURFACE) - ~~BELOW~~ Surface

~~LEFT~~ - (E) PAW'T. - RIGHT 1'


10' TO 5' EDGE PAVEMENT

S.L.M. 491 + 59

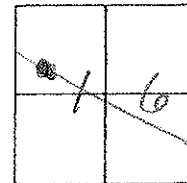

Record:
Plan Sta - 479 + 11.18
Prev. - PK/W, RR Spk.

Set PM/W
8-1-01
SAH

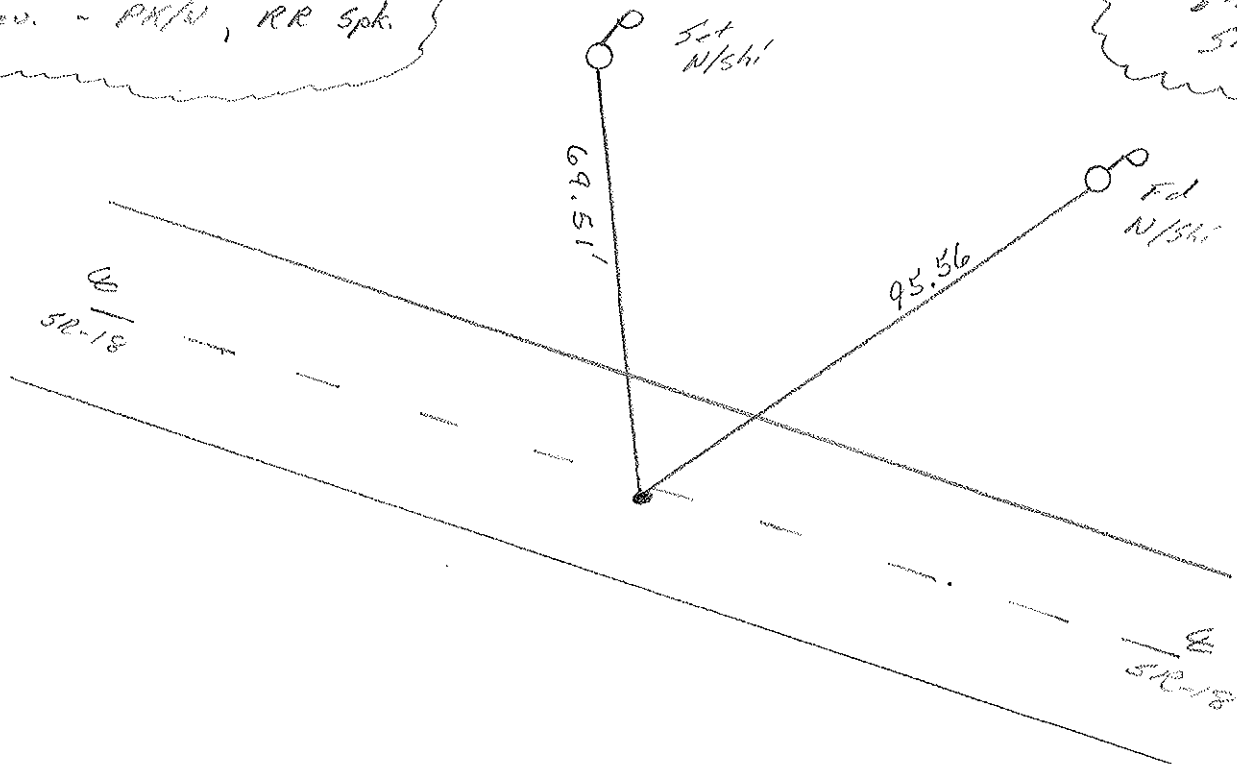

O.D.O.T. DISTRICT 2 SURVEY OFFICE

PERSONNEL

REFERENCE NO. 3738 SHEET 18 OF 27

NOTES CHENEY

H.C. RIPPLE

R.C. BARBOUR

GEYMAN

DATE 11-5-1991

WEATHER PARTLY CLOUDY

TEMP. 30°

ROUTE 18

COUNTY SENECA

TOWNSHIP HOPEWELL

SECTION 16

T2N R14E


TYPE MONUMENT SET PK/WASHER

ON SURFACE - BELOW

~~LEFT~~ - & PAW'T. - RIGHT 1'

10' TO S. EDGE PAVEMENT

S.L.M. 491+31

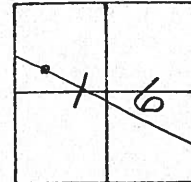


P.I.

PLAN STA - 479+11.18

PREVIOUS MONUMENTS:

P.K./SHINER

R.P. SPK.

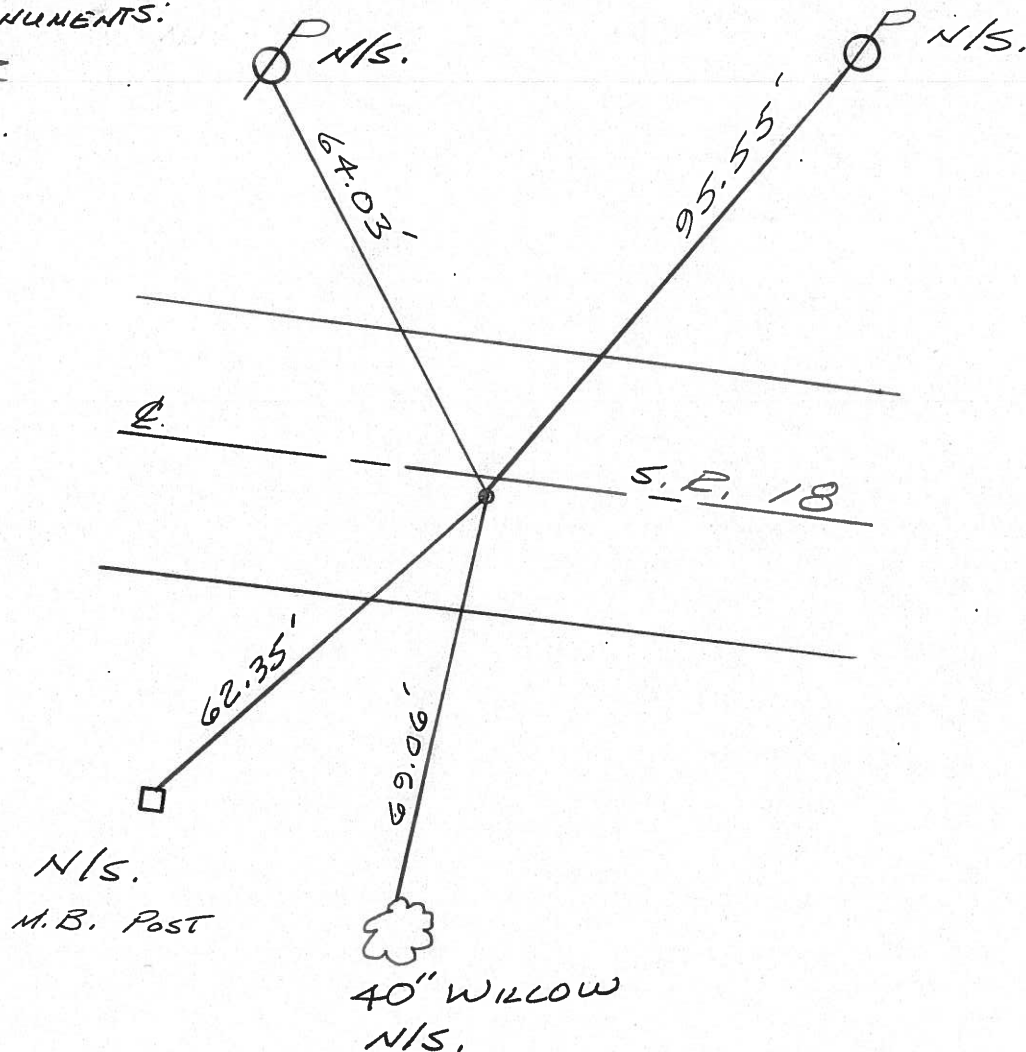

Q.D.O.T. DISTRICT 2 SURVEY OFFICE

Sht. 18 of 18

GK-9-12-80 G.W.S.

County Seneca S.R. # 18

Date 5-19-80

Township Hopewell

Weather Cloudy

Section 16

Temp. 58°

T2N, R14E


Personnel Schneider

Mosser

Barbour

Gronin

Rippa Geyman

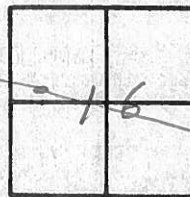


(38)

P.I.

479+ 11.18

R. R. SPK.

SET P.K. & Shi.

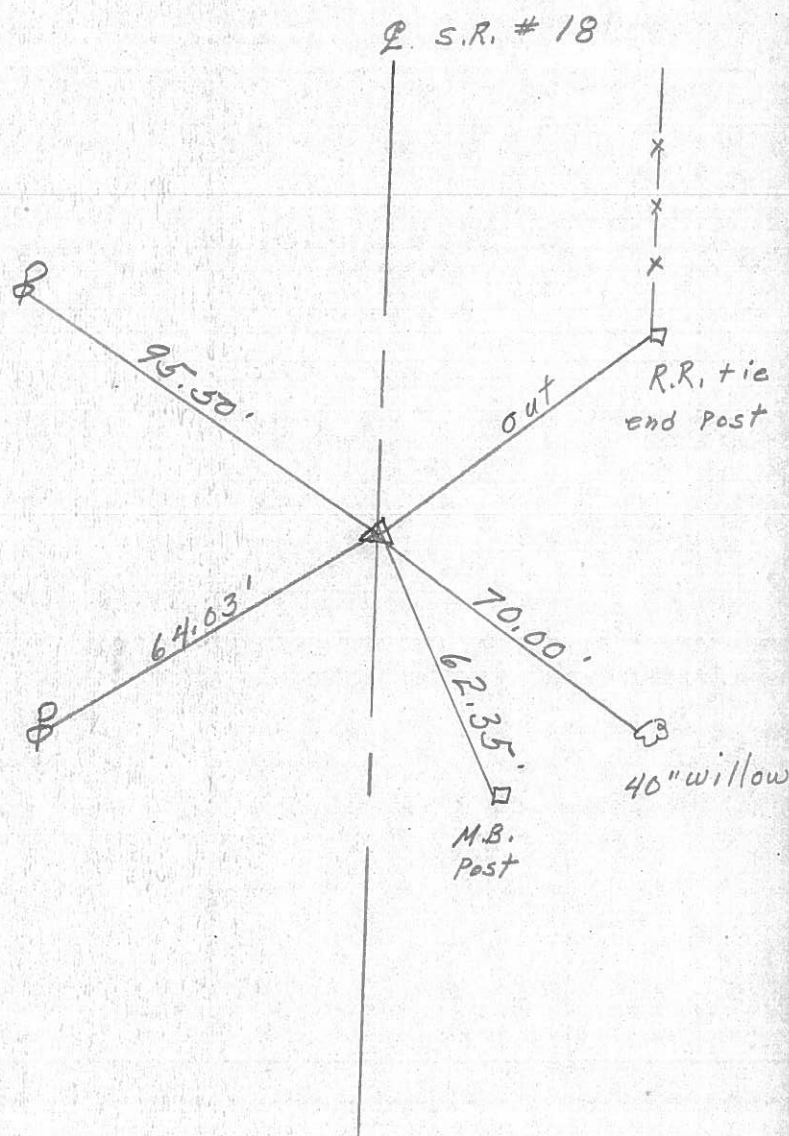

PERSONNEL	TITLE	PERSONNEL	TITLE	COUNTY	DATE	WEATHER	TEMP.
Schneider		Potts		Seneca	10-21-68	Cloudy-Rain	15°
Masser				S. R.	18		
Barbour				SEC.	Bascom to Tiffin		
Redding							

DESCRIPTION Ties for Control Points JOB NO. _____

LEFT CENTER LINE RIGHT

