

O.D.O.T. DISTRICT 2 SURVEY OFFICE (USE ONLY)

PERSONNEL

REFERENCE NO. 40

SHEET OF

NOTES RHOADES

DATE 4/10/24

ROUTE SR 18

H.C. NIESE

WEATHER CLOUDY

COUNTY SENECA

R.C. MILLER

TEMP. 55°

TOWNSHIP HOPEWELL

DWG BY BARRIERE

PID 92371

SECTION 16

T 2 N R 14 E

TYPE MONUMENT MAG NAIL/WASHER

ON SURFACE - BELOW ON

OFFSET $\odot$ PAVEMENT ON LT : RT

 TO EDGE PAVEMENT

STATION: 517+69

HORZ.DATUM: NAD83 (2011)


GEOID: 18

GRID: NORTHING: 533953.788

EASTING: 1760676.059


LDP: NORTHING:

EASTING:

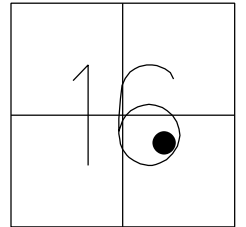

RECORD: P.C.
STA. 505+48.59
PREV MONUMENTS:
P.K./SHINER
R.R.SPIKE
FD P.K./WASHER
6/4/01, BVD
SET P.K./WASHER
8/1/01, SAH
FD P.K.NAIL
REF40
4/22/19
8/19/19, JFO
FD P.K./WASHER
REF40
9/2/21, DSA
2/16/22, JFO
9/27/22, TDN
SET MAG/WASHER
9/11/24, TDN

FD "+" CUTS
IN CURB

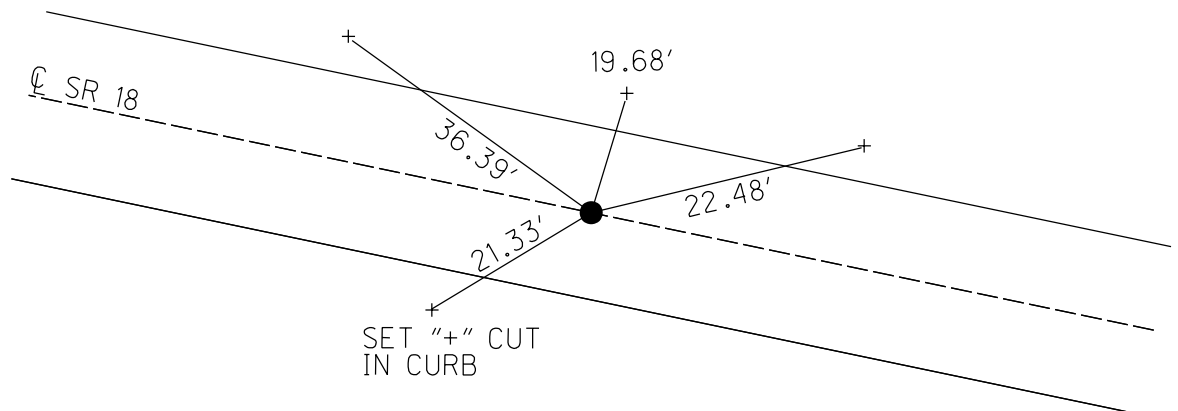

O.D.O.T. DISTRICT 2 SURVEY OFFICE (USE ONLY)

PERSONNEL

REFERENCE NO. 40

SHEET 42 OF 48

NOTES SAVAGE

DATE 9/2/21

ROUTE SR 18

H.C. AUBLE

WEATHER SUNNY

COUNTY SENECA

R.C. NIESE

TEMP. 64°

TOWNSHIP HOPEWELL

SECTION 16

DWG BY RHOADES

PID PVTRAIN

T 2 N R 14 E

TYPE MONUMENT P.K./WASHER

ON SURFACE - ~~BELOW~~ ON

OFFSET CL PAVEMENT ON LT : RT

10.5' TO LT EDGE PAVEMENT


STATION: 517+69

HORZ.DATUM: NAD83(2011)

GEOID: 2012A


GRID: NORTHING: 533953.778

EASTING: 1760676.042

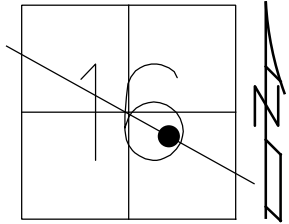

RECORD: P.C.
STA.505+48.59
PREV MONUMENTS:
P.K./SHINER
R.R.SPIKE
FD P.K./WASHER
6/4/01, BVD
SET P.K./WASHER
8/1/01, SAH
FD P.K.NAIL
REF40
4/22/19
8/19/19, JFO
FD P.K./WASHER
REF40
9/2/21, DSA
2/16/22, JFO

SET "+" CUTS
CURB

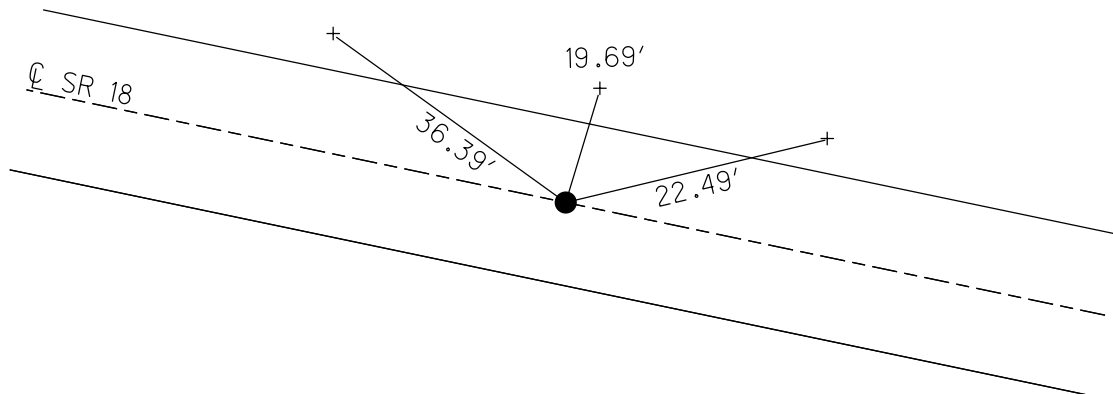

O.D.O.T. DISTRICT 2 SURVEY OFFICE (USE ONLY)

PERSONNEL

REFERENCE NO. 40

SHEET 42 OF 48

NOTES VAN DUSEN

DATE 6/4/01

ROUTE SR 18

H.C. ROUSOS

WEATHER SUNNY

COUNTY SENECA

R.C. BROWN

TEMP. 60°

TOWNSHIP HOPEWELL

SECTION 16

DWG BY NIESE

PID NO PID

T 2 N R 14 E

TYPE MONUMENT P.K./WASHER

ON SURFACE - ~~BELOW~~ ON

OFFSET Q PAVEMENT ON LT : RT

10.5' TO LT EDGE PAVEMENT


STATION: 517+69

HORIZ.DATUM: NAD83(2011)


GEOID: 2012A

GRID: NORTHING: 533953.778

EASTING: 1760676.042

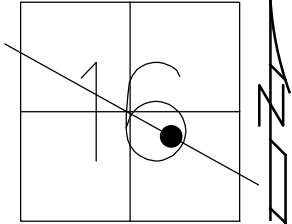

RECORD: P.C.
STA.505+48.59
PREV MONUMENTS:
P.K./SHINER
R.R.SPIKE
FD P.K./WASHER
6/4/01, BVD
SET P.K./WASHER
8/1/01, SAH
FD P.K.NAIL
REF40
4/22/19
8/19/19, JFO

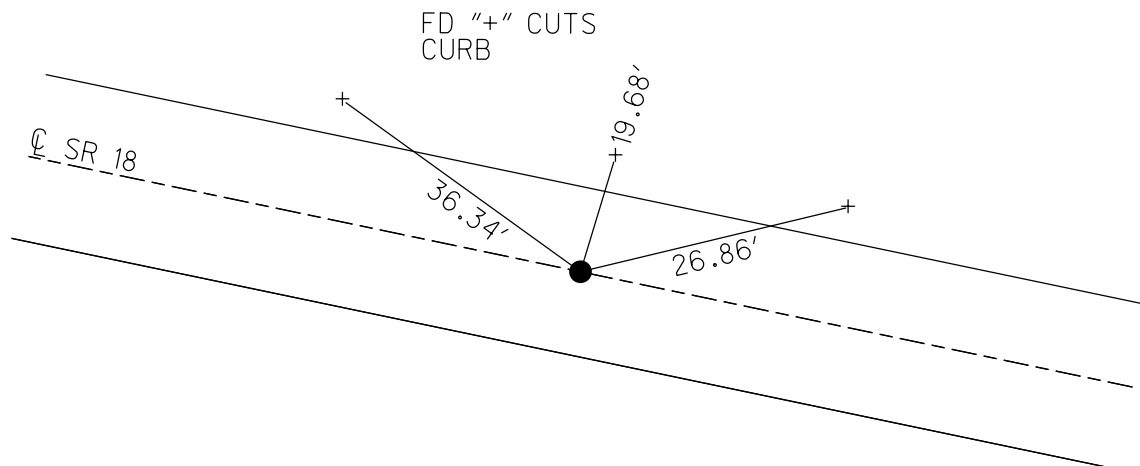

O.D.O.T. DISTRICT 2 SURVEY OFFICE

PERSONNEL

REFERENCE NO. 40

SHEET 20 OF 20

NOTES VAN DUSEN

H.C. ROUSOS

R.C. ADAM B.

DATE 6-4-01

WEATHER SUNNY

TEMP. +60°F

ROUTE 18

COUNTY SENECA

TOWNSHIP HOPWELL

SECTION 16

T2 NR 14 E


TYPE MONUMENT PK&WASHER

ON SURFACE - BELOW YES

LEFT - CL PAV'T. - RIGHT YES

10.5 TO N EDGE PAVEMENT


S.L.M. 517+69

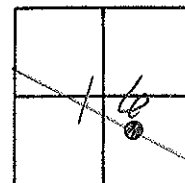

PREVIOUS MONUMENTS:
PK/SHINER
RR. SPIKE

PLAN STA. PC=505+48.59
RR. SPIKE

SET PK&WASHER
8-1-01
SAH

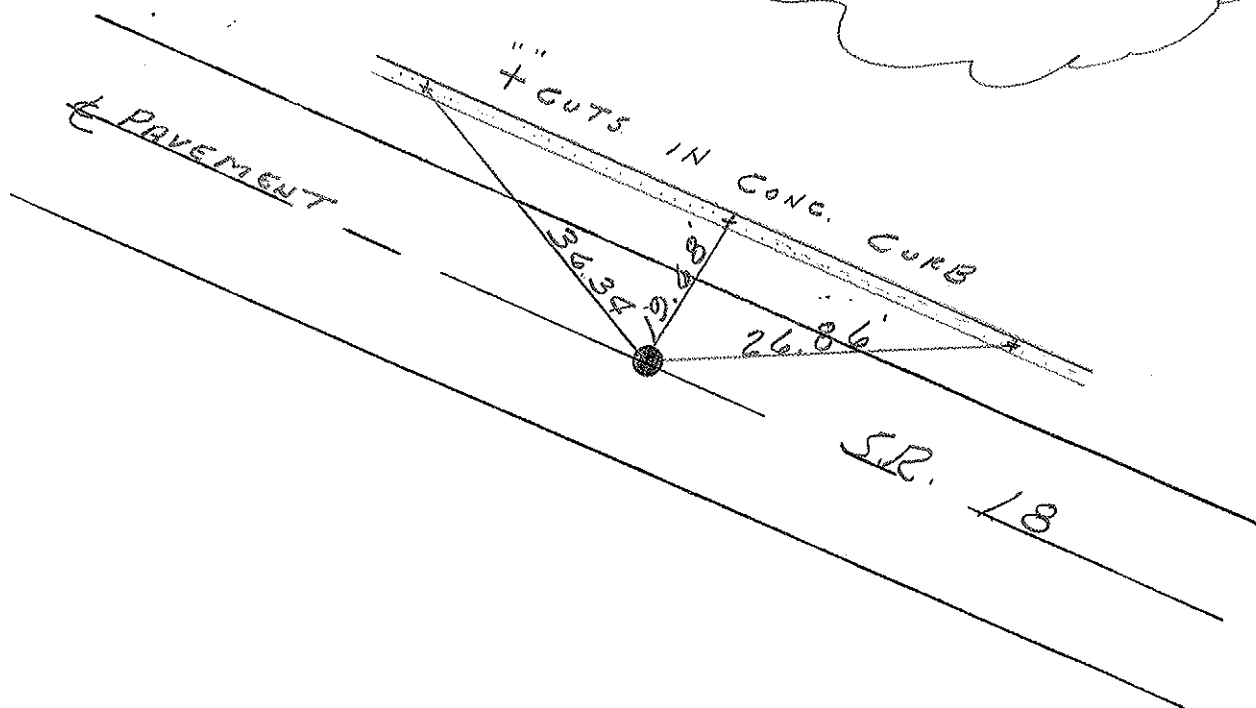

O.D.O.T. DISTRICT 2 SURVEY OFFICE

PERSONNEL

REFERENCE NO. 40

SHEET 20 OF 27

NOTES CHENEY

H.C. RIPPLE

R.C. BARBOUR

GEYMAN

DATE 11-5-1991

WEATHER PARTLY CLOUDY

TEMP. 30°

ROUTE 18

COUNTY SENECA

TOWNSHIP HOPEWELL

SECTION 16

T2 N R14 E


TYPE MONUMENT SET PK/WASHER

ON SURFACE - BELOW

LEFT - & PAV'T. - RIGHT

10.5 TO N. EDGE PAVEMENT

S.L.M. 517+53

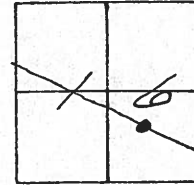


PREVIOUS MONUMENTS:

PK/SHINER

R.R. SPK.

PLAN STA PC = 505+48.59
RR SPIKE

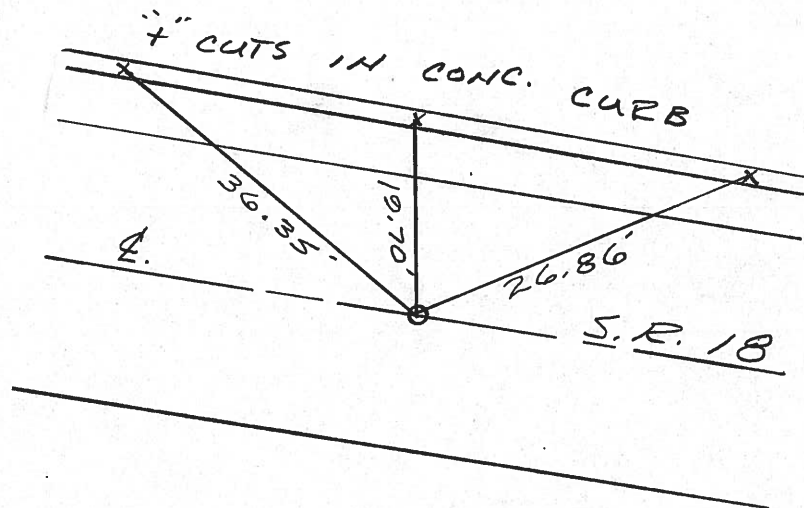

Q.D.O.T. DISTRICT 2 SURVEY OFFICE

Sht. of

County Seneca S.R. # 18

Township Hopewell

Section 16


T2N, R14E

Personnel Schneider
Mosser
Barbour
Cronin
Rippl Geyman

Date OK-9-12-80 G.W.S.
5-19-80

Weather cloudy

Temp. 3-8°

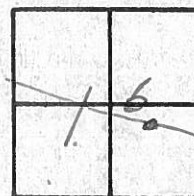

40



Q. S.R. #18


P.C.

505 + 48.59

R.R. SPK.

SET P.K. & SHI.

3'-X" on top curb

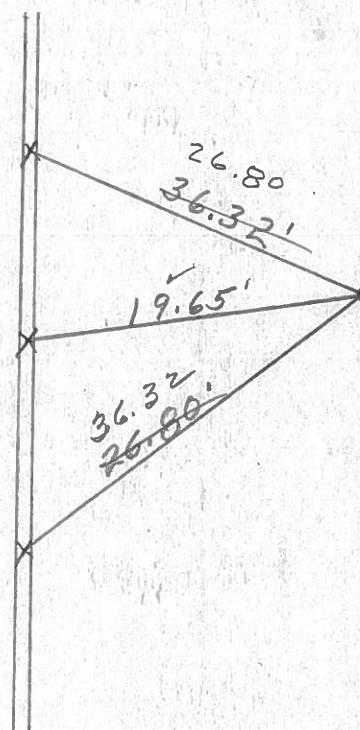


PERSONNEL	TITLE	PERSONNEL	TITLE	COUNTY	Seneca	DATE	10-21-68
Schneider		Potts		S. R.	18	WEATHER	Cloudy - Rain
Masser				SEC.	Bascom to Tiffin	TEMP.	45°
Barbour							
Redding							
DESCRIPTION				Ties for Control Points		JOB NO.	

LEFT CENTER LINE RIGHT

2 - (41) Fd. P.K. Nail


8132

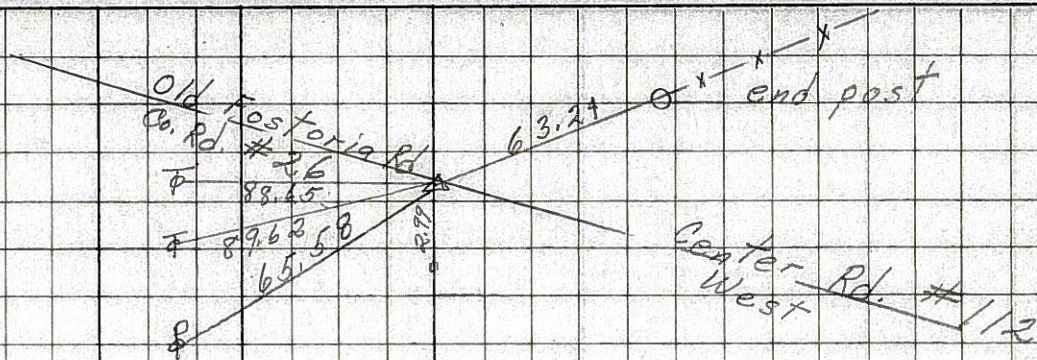

P.I. (40) 8122A

P.C. 505+48.59 R.R. spk.


8127

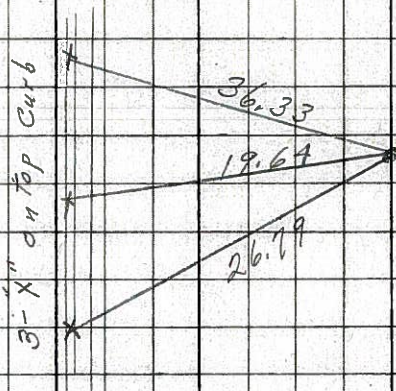

did not find off permit

(39) 488+57.14 Iron pin 487+96.00 R.R. spk.

3123

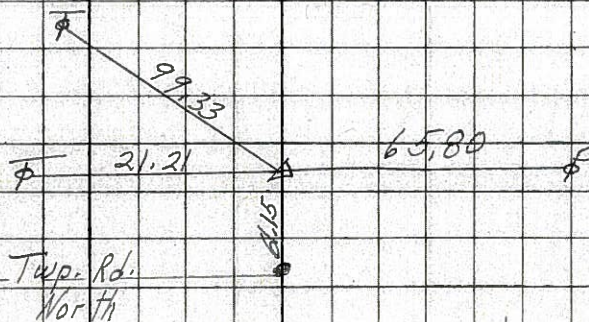

(38) P.I. 479+11.18 R.R. spk.

8127

