

O.D.O.T. DISTRICT 2 SURVEY OFFICE (USE ONLY)

PERSONNEL

REFERENCE NO. 40A

SHEET OF

NOTES RHOADES

DATE 4/10/24

ROUTE SR 18

H.C. NIESE

WEATHER CLOUDY

COUNTY SENECA

R.C. MILLER

TEMP. 55°

TOWNSHIP HOPEWELL

DWG BY BARRIERE

PID 92371

SECTION 15

T 2 N R 14 E

TYPE MONUMENT MAG NAIL/WASHER

ON SURFACE - BELOW ON

OFFSET $\oslash$ PAVEMENT 1' RT LT : RT

 TO EDGE PAVEMENT

STATION: 558+84

HORZ.DATUM: NAD83 (2011)


GEOID: 18

GRID: NORTHING: 531634.153


EASTING: 1763997.707

LDP: NORTHING:

EASTING:

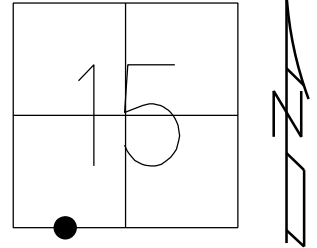

RECORD:
FD P.K./WASHER
11/5/91
FD P.K./WASHER
6/4/01, BVD
SET P.K./WASHER
8/1/01, SAH
FD P.K./WASHER
REFA40
4/23/19
8/16/19, JFO
FD P.K.SHANK
9/8/21, DSA
2/16/22, JFO
9/27/22, TDN
SET MAG/WASHER
9/11/24, TDN

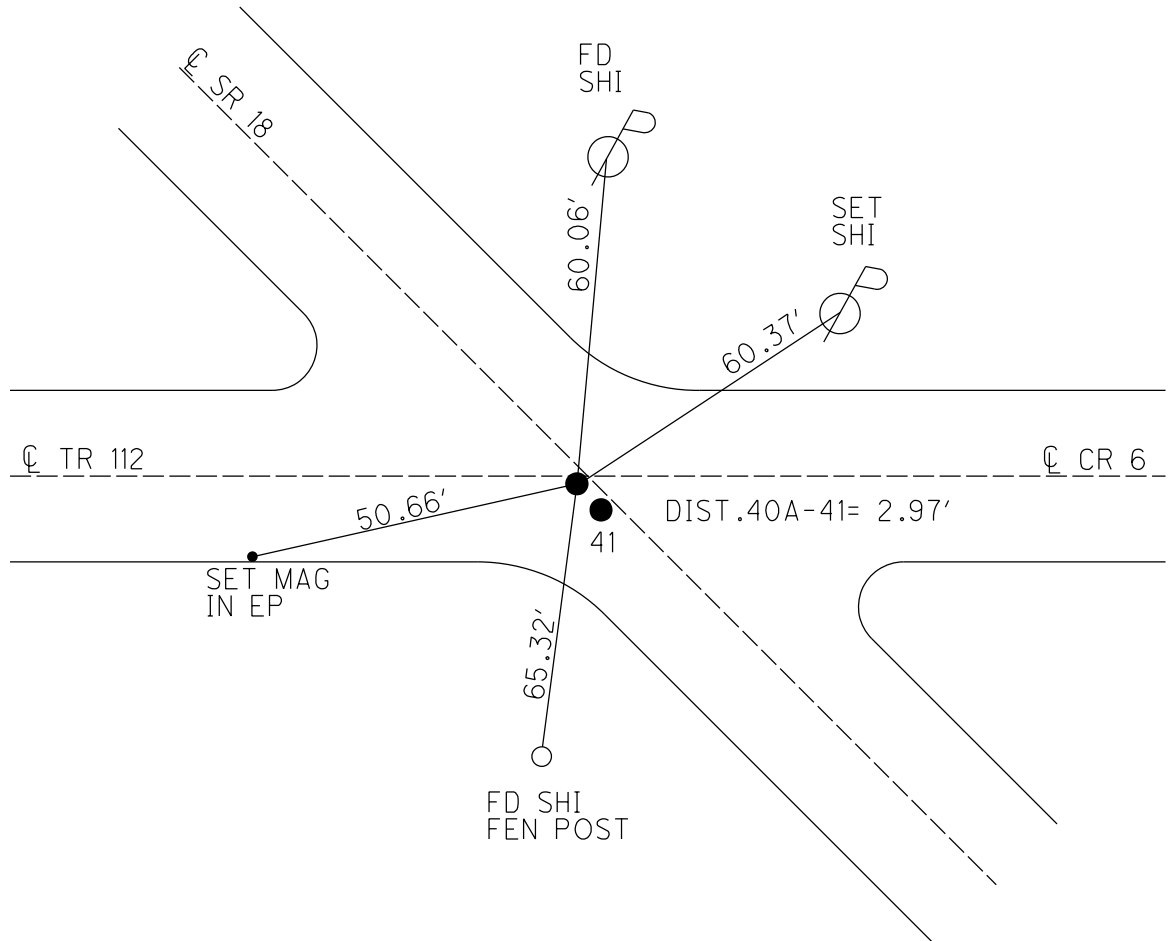

O.D.O.T. DISTRICT 2 SURVEY OFFICE (USE ONLY)

PERSONNEL

REFERENCE NO. 40 A

SHEET 43 OF 48

NOTES SAVAGE DATE 9/8/21
H.C. AUBLE WEATHER SUNNY
R.C. NIESE TEMP. 68°

ROUTE SR 18
COUNTY SENECA
TOWNSHIP HOPEWELL
SECTION 15
T 2 N R 14 E

DWG BY RHOADES PID PVTRAIN

TYPE MONUMENT P.K.SHANK


ON SURFACE - ~~BELOW~~ ON

OFFSET 11.0' TO LT EDGE PAVEMENT
11.0' TO LT EDGE PAVEMENT


STATION: 558+84

HORZ.DATUM: NAD83(2011) GEOID: 2012A

GRID: NORTHING: 531636.064 EASTING: 1763995.384

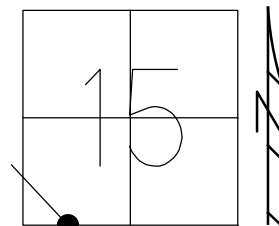

RECORD:
FD P.K./WASHER
11/5/91
FD P.K./WASHER
6/4/01, BVD
SET P.K./WASHER
8/1/01, SAH
FD P.K./WASHER
REFA40
4/23/19
8/16/19, JFO
FD P.K.SHANK
9/8/21, DSA
2/16/22, JFO

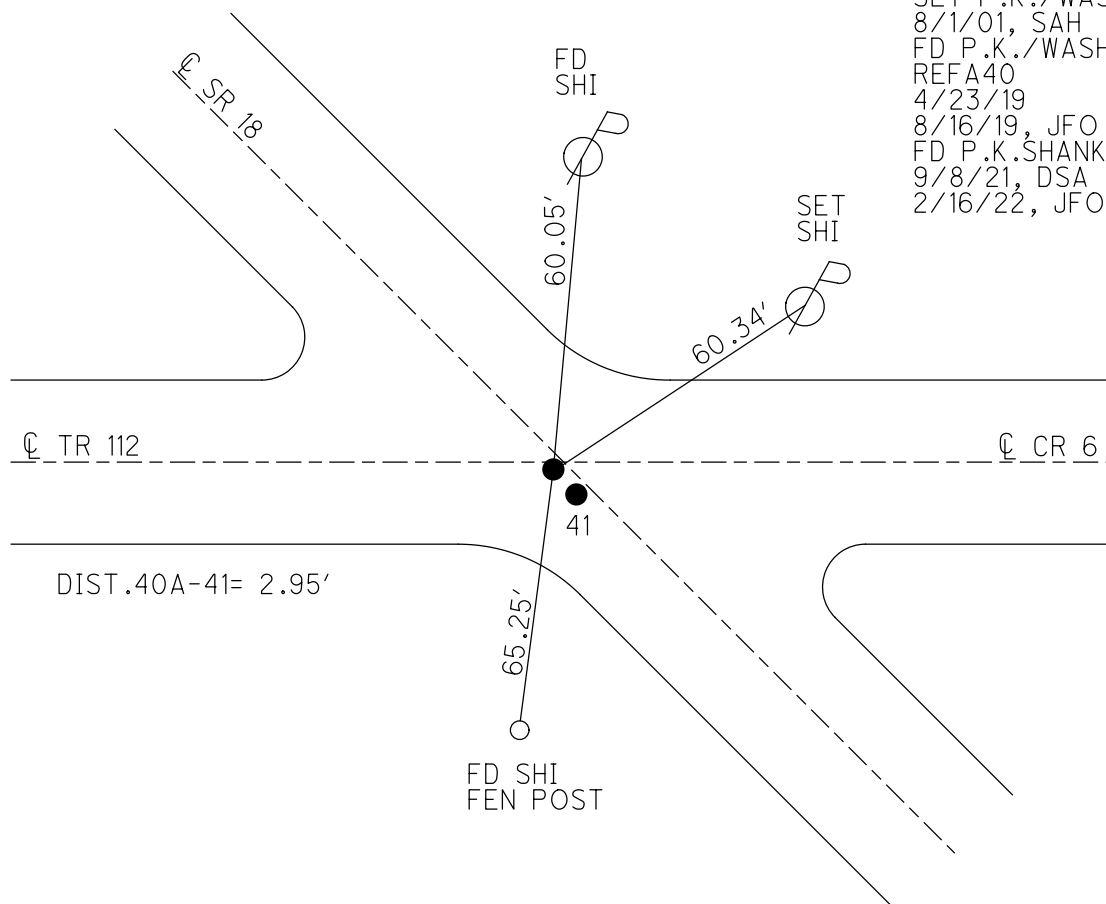

O.D.O.T. DISTRICT 2 SURVEY OFFICE (USE ONLY)

PERSONNEL

REFERENCE NO. 40 A

SHEET 43 OF 48

NOTES VAN DUSEN

DATE 6/4/01

ROUTE SR 18

H.C. ROUSOS

WEATHER SUNNY

COUNTY SENECA

R.C. BROWN

TEMP. 60°

TOWNSHIP HOPEWELL

SECTION 15

DWG BY NIESE

PID NO PID

T 2 N R 14 E

TYPE MONUMENT P.K./WASHER

ON SURFACE - ~~BELOW~~ ON

OFFSET CL PAVEMENT 1.0' LT : RT

11.0' TO LT EDGE PAVEMENT


STATION: 558+84

HORZ.DATUM: NAD83(2011)


GEOID: 2012A

GRID: NORTHING: 531636.064

EASTING: 1763995.384

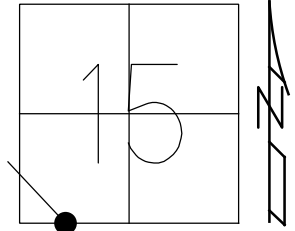

RECORD:
FD P.K./WASHER
11/5/91
FD P.K./WASHER
6/4/01, BVD
SET P.K./WASHER
8/1/01, SAH
FD P.K./WASHER
REFA40
4/23/19
8/16/19, JFO

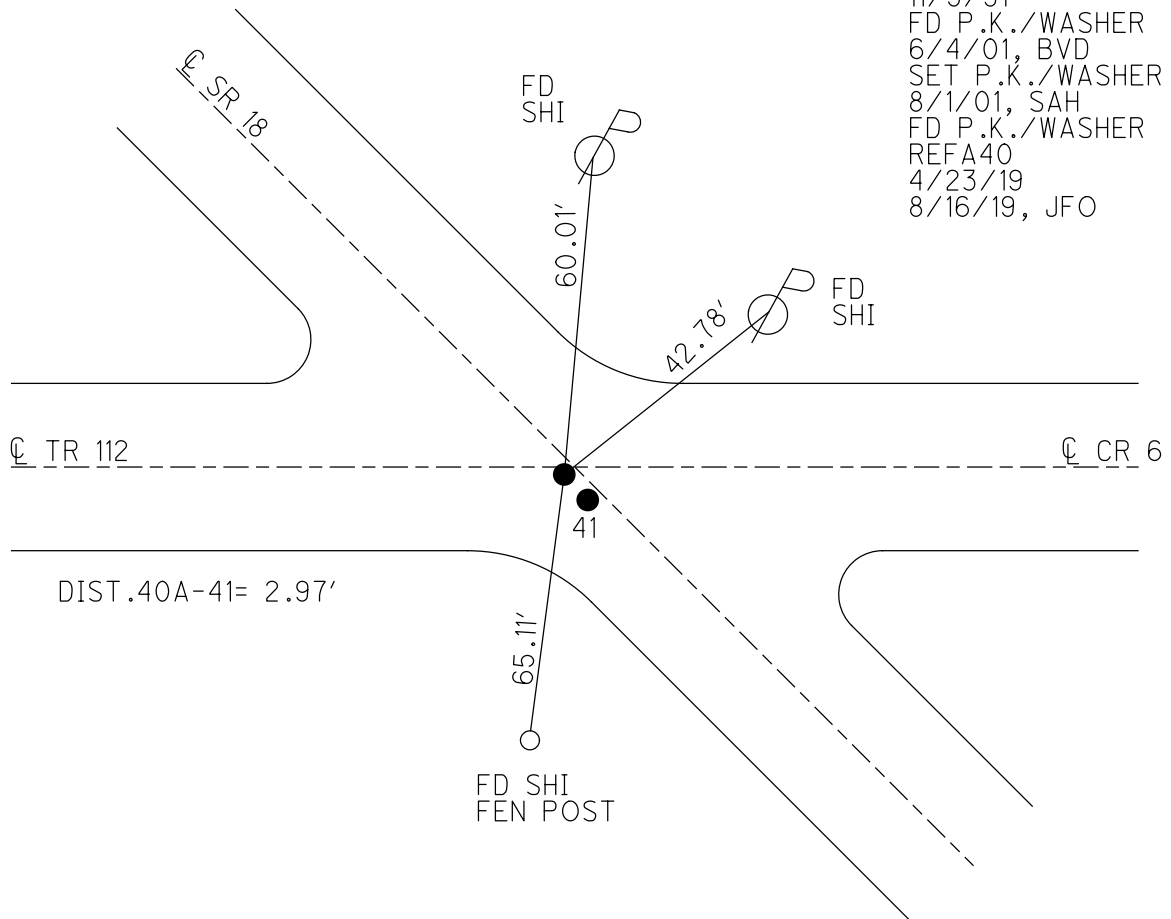

O.D.O.T. DISTRICT 2 SURVEY OFFICE

PERSONNEL

REFERENCE NO. 41

SHEET 21 OF 26

NOTES VanDusen

H.C. PAULSON

R.C. Brown

DATE 6-4-01

WEATHER Sunny

TEMP. 60°F

ROUTE 18

COUNTY Seneca

TOWNSHIP Hopewell

SECTION 15+22

T 2 N R 14 E

TYPE MONUMENT (A)(B) = PK/W

ON SURFACE - BELOW

LEFT - C PAV'T. - RIGHT 1' Both Points

11' TO N. EDGE PAVEMENT


S.L.M. (A) = 558+84 (B) = 558+87

15	
22	



Record
Proc. Mon. PK/W
11-6-91

Set PK/W
Both Pts
8-1-01
SAH

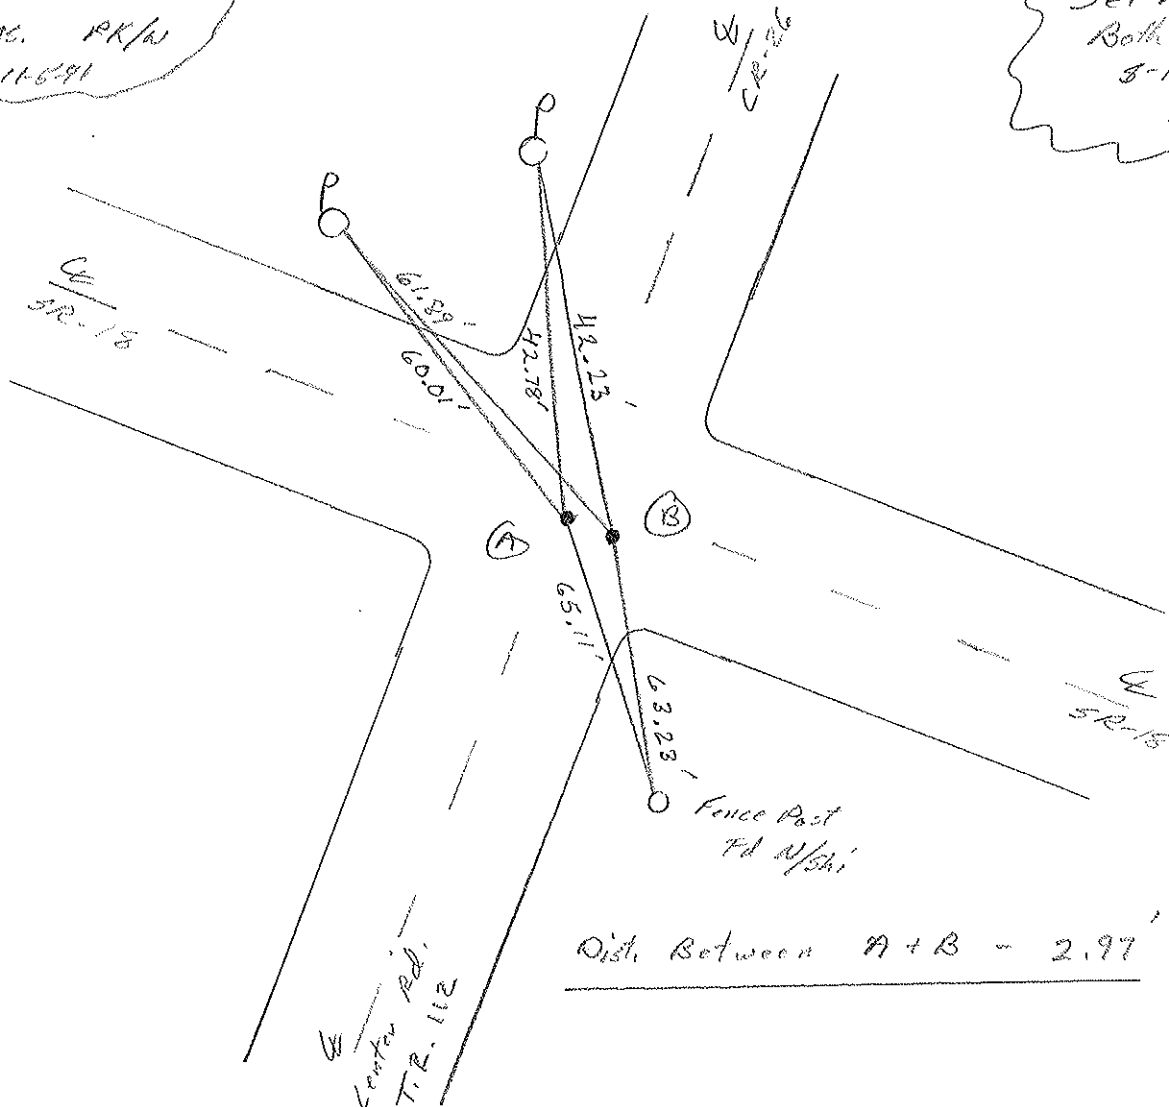

O.D.O.T. DISTRICT 2 SURVEY OFFICE

PERSONNEL

REFERENCE NO. 41

SHEET 24 OF 27

NOTES CHENEY

H.C. RIPPLE

R.C. BARBOUR

GEYMAN

DATE 11-5-1991

WEATHER PARTLY CLOUDY

TEMP. 30°

ROUTE 18

COUNTY SENECA

TOWNSHIP HOPEWELL

SECTION 15 & 22

T2N R14E


TYPE MONUMENT SET PK/WASHERS

ON SURFACE - BELOW


~~LEFT~~ & PAU'T. - RIGHT 1' BOTH POINTS

11' TO N. EDGE PAVEMENT BOTH POINTS

S.L.M. 558+71

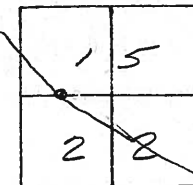

PREVIOUS MONUMENTS:
PKS/SHIERS

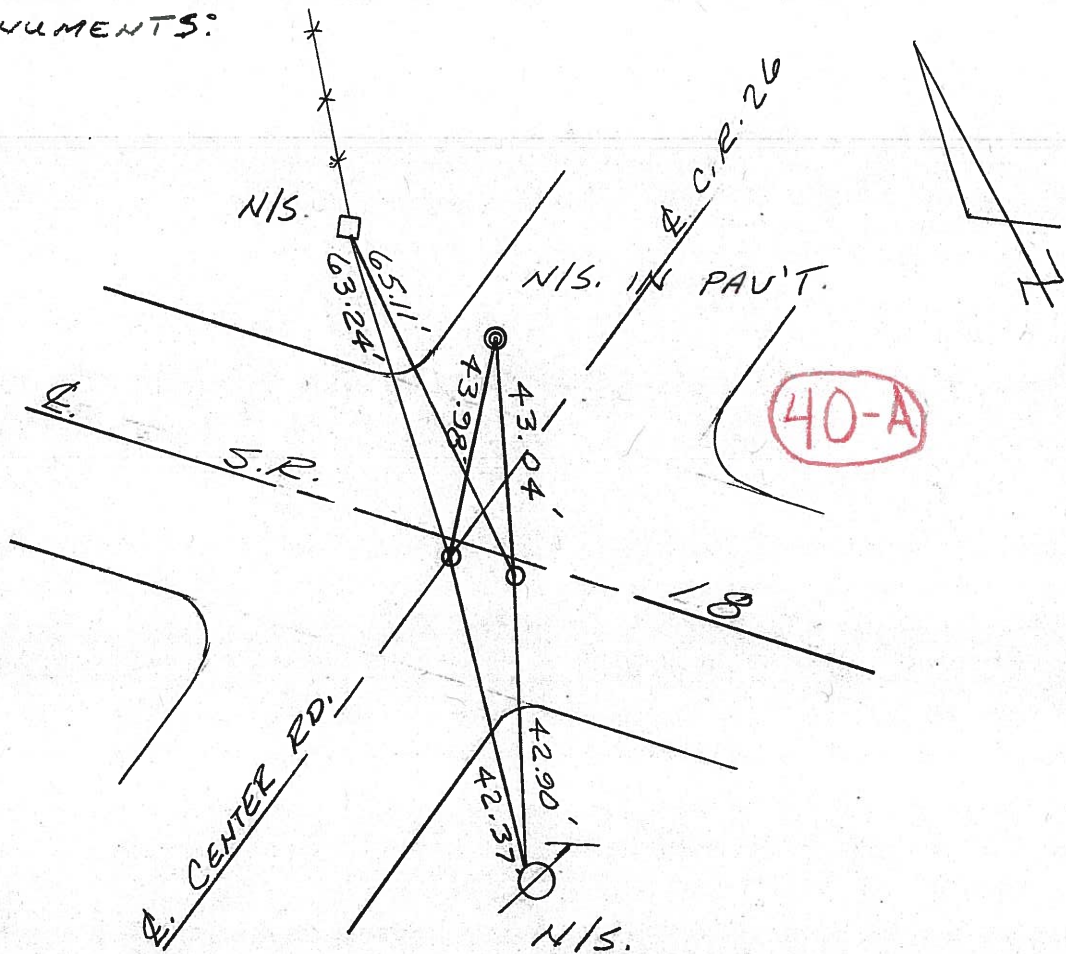

QD.O.T. DISTRICT 2 SURVEY OFFICE

Sht. of

County Seneca S.R. # 18

Township Hopewell

Section 15 & 22

T2N, R4E

Personnel Schneider

Mosser

Barbour

Cronin

Ripple Geyman

Date 5-19-80

Weather cloudy


Temp. 58°

1	5
2	2



~~41~~

Q S.R. #18

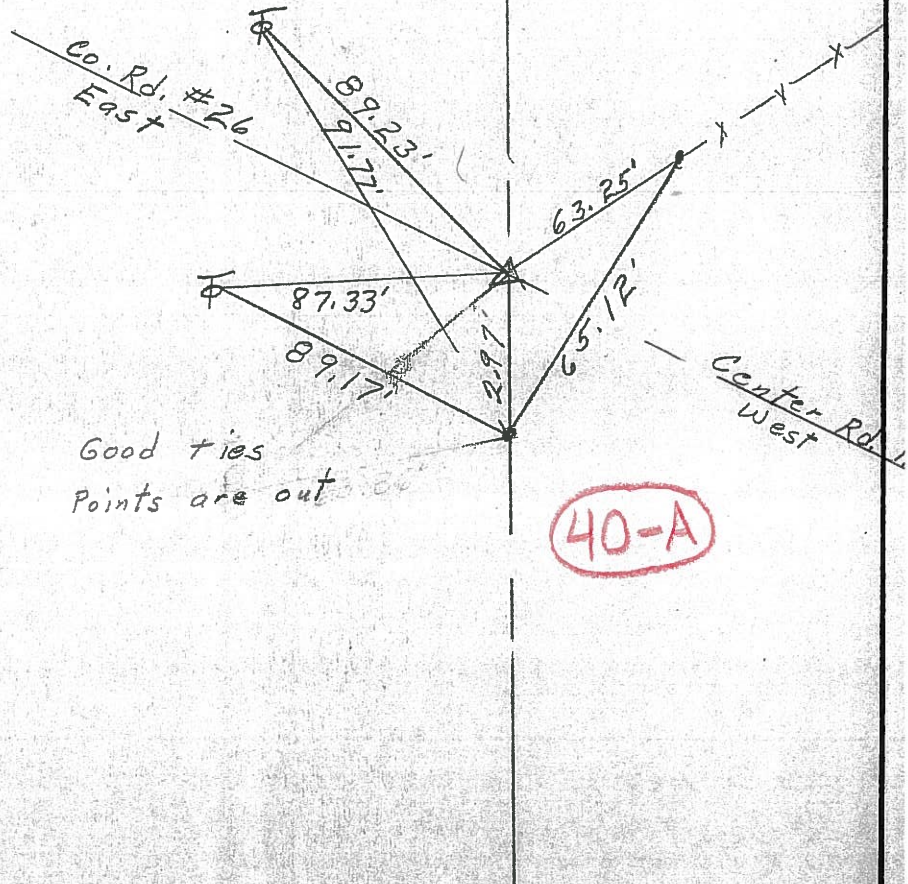

45.1 = 77.4

1942 Plan

SET P.K. NAILS & SHI.

40-A