
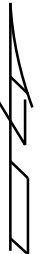



O.D.O.T. DISTRICT 2 SURVEY OFFICE (USE ONLY)

PERSONNEL		REFERENCE NO. <u>A41</u>	SHEET <u> </u> OF <u> </u>
NOTES	<u>RHOADES</u>	DATE <u>4/10/24</u>	ROUTE <u>SR 18</u>
H.C.	<u>NIESE</u>	WEATHER <u>CLOUDY</u>	COUNTY <u>SENECA</u>
R.C.	<u>MILLER</u>	TEMP. <u>55°</u>	TOWNSHIP <u>HOPEWELL</u>
			SECTION <u>22</u>
DWG BY <u>BARRIERE</u>		PID <u>92371</u>	T <u>2</u> N R <u>14</u> E
TYPE MONUMENT <u>MAG NAIL / WASHER</u>			
ON SURFACE - BELOW <u>ON</u>			
OFFSET $\odot$ PAVEMENT <u>4' RT</u> LT : RT			
<u> </u> TO <u> </u> EDGE PAVEMENT			
STATION: <u>589+95</u>			
HORZ. DATUM: <u>NAD83 (2011)</u>		GEOID: <u>18</u>	
GRID: NORTHING: <u>529503.915</u>		EASTING: <u>1766259.294</u>	
LDP: NORTHING: <u> </u>		EASTING: <u> </u>	

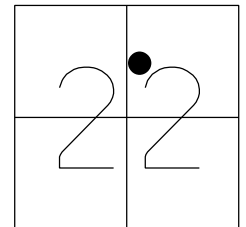

RECORD: P.I.
 STA: 482+88
 $\Delta = 1^{\circ}35'$ LT
 R= 11459.16'
 T= 158.34'
 L= 316.67'

FD P.K. SHANK
 FD P.K. / WASHER
 6/4/01, BVD
 SET P.K. / WASHER
 8/1/01, SAH
 FD P.K. / WASHER
 REFA41
 4/23/19
 8/16/19, JFO
 D.N.F.
 2/16/22, JFO
 SET MAG/WASHER
 REFA41
 7/25/22, DSA
 9/27/22, TDN
 SET MAG/WASHER
 9/11/24, TDN

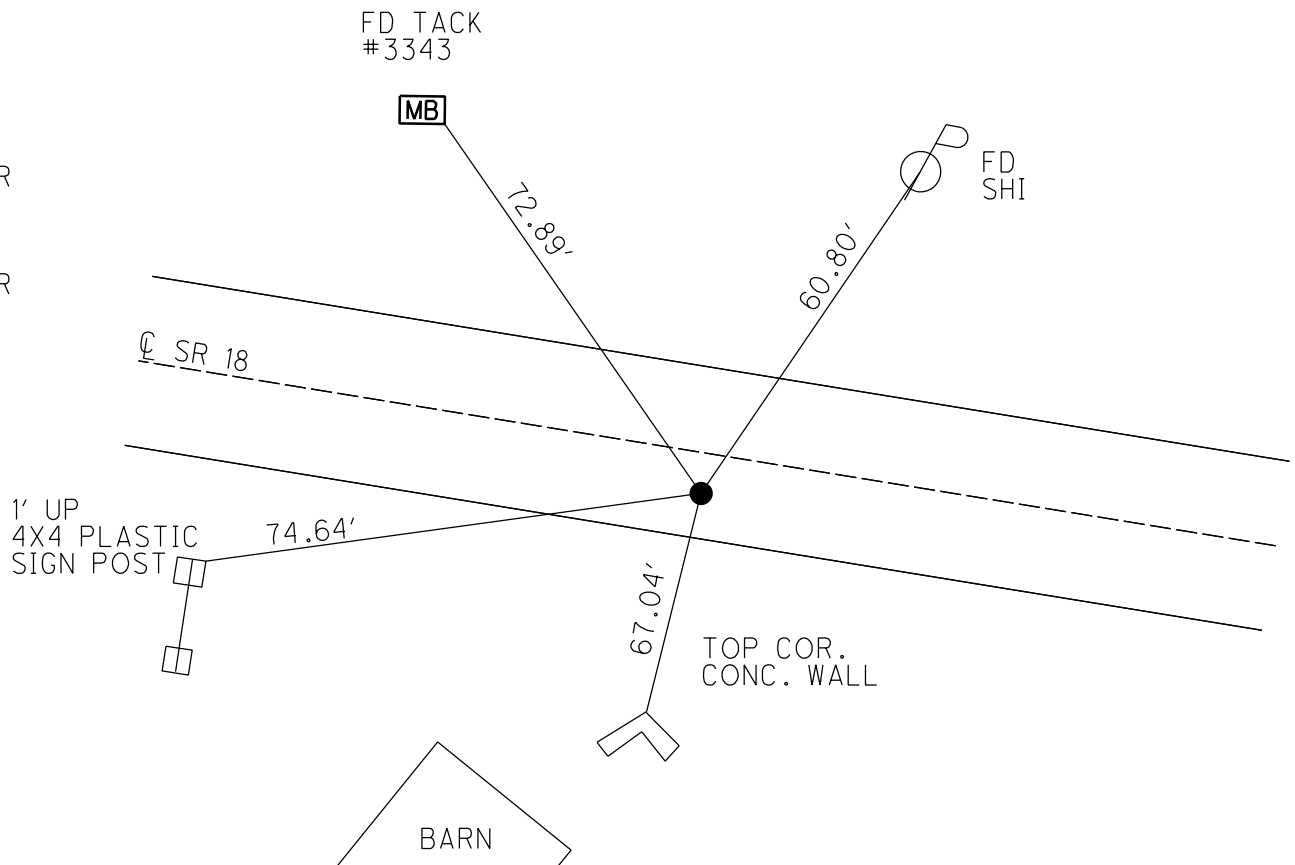

O.D.O.T. DISTRICT 2 SURVEY OFFICE (USE ONLY)

PERSONNEL

REFERENCE NO. 41 A

SHEET 45 OF 48

NOTES RHOADES

DATE 9/8/21

ROUTE SR 18

H.C. AUBLE

WEATHER SUNNY

COUNTY SENECA

R.C. NIESE

TEMP. 68°

TOWNSHIP HOPEWELL

DWG BY WHITAKER

PID PVTRN

SECTION 22

T 2 N R 14 E

TYPE MONUMENT P.K./WASHER

ON SURFACE - ~~BELOW~~ ON

OFFSET Q PAVEMENT 4.0' ~~LT~~ : RT

5.0' TO RT EDGE PAVEMENT


STATION: 589+95

HORZ.DATUM: NAD83(2011)

GEOID: 2012A

GRID: NORTHING: 529503.892


EASTING: 1766259.289

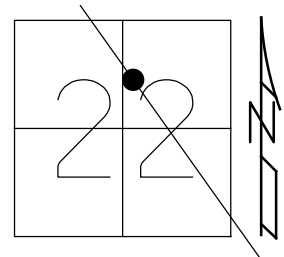

RECORD:

FD P.K.SHANK
FD P.K./WASHER
6/4/01, BVD
SET P.K./WASHER
8/1/01, SAH
FD P.K./WASHER
REFA41
4/23/19
8/16/19, JFO
D.N.F
2/16/22, JFO
SET MAG/WASHER
REFA41
7/25/22, DSA

FD TACK
#3343

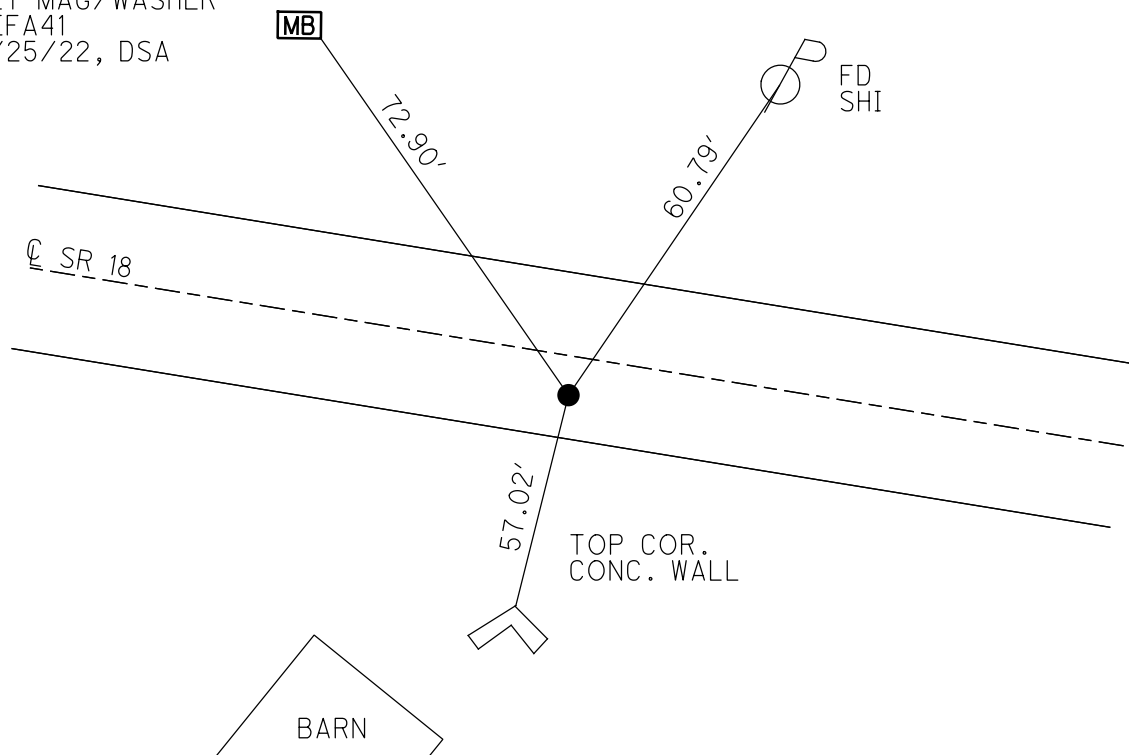

O.D.O.T. DISTRICT 2 SURVEY OFFICE (USE ONLY)

PERSONNEL

REFERENCE NO. 41 A

SHEET 45 OF 48

NOTES VAN DUSEN

DATE 6/4/01

ROUTE SR 18

H.C. ROUSOS

WEATHER SUNNY

COUNTY SENECA

R.C. BROWN

TEMP. 60°

TOWNSHIP HOPEWELL

SECTION 22

DWG BY NIESE

PID NO PID

T 2 N R 14 E

TYPE MONUMENT P.K./WASHER

ON SURFACE - ~~BELOW~~ ON

OFFSET CL PAVEMENT 4.0' ~~LT~~ : RT

5.0' TO RT EDGE PAVEMENT


STATION: 589+95

HORZ.DATUM: NAD83(2011)

GEOID: 2012A

GRID: NORTHING: 529503.892

EASTING: 1766259.289

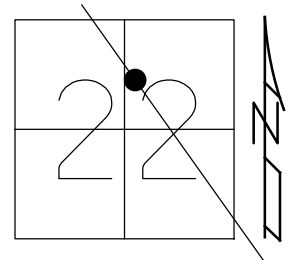

RECORD:

PREV. MOUMENT

P.K.SHANK

FD P.K./WASHER

6/4/01, BVD

SET P.K./WASHER


8/1/01, SAH

FD P.K./WASHER

REFA41

4/23/19

8/16/19, JFO

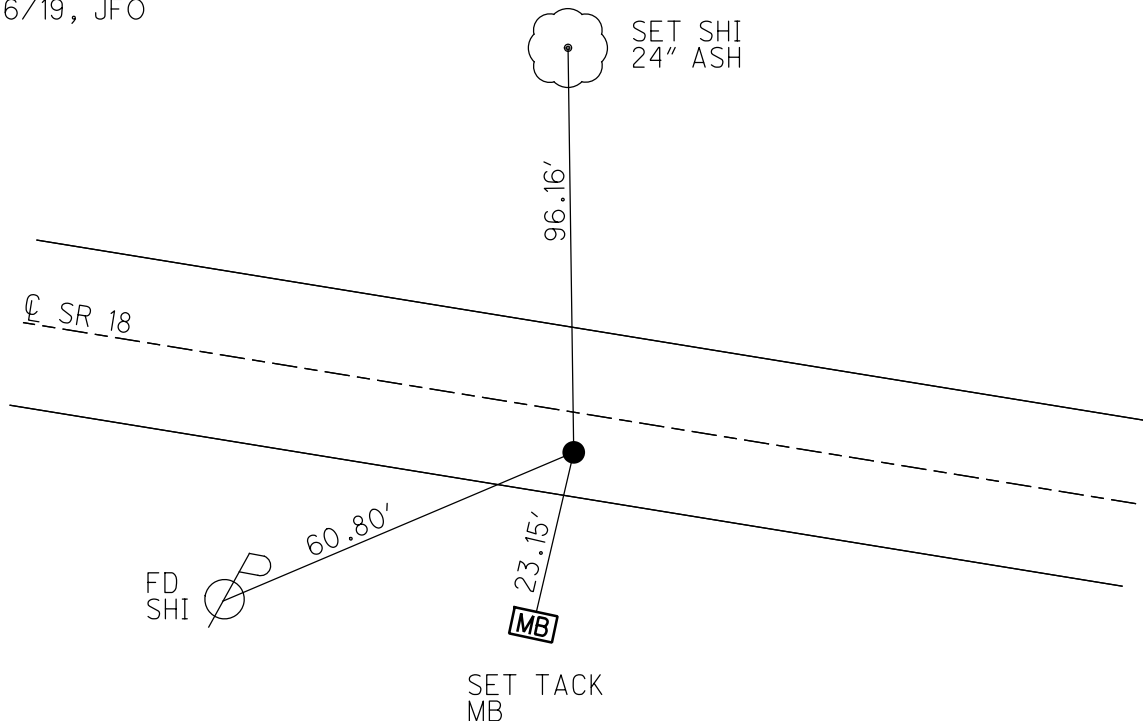

O.D.O.T. DISTRICT 2 SURVEY OFFICE

PERSONNEL

REFERENCE NO. 41-A

SHEET 22 OF 26

NOTES VAN DUSEN

H.C. ROUSOS

R.C. ADAM B.

DATE 6-4-01

WEATHER SUNNY

TEMP. +60° F

ROUTE 18

COUNTY SENECA

TOWNSHIP HOPEWELL

SECTION 22

T. 2 N R. 14 E


TYPE MONUMENT PK&WASHER

ON SURFACE - BELOW YES

LEFT - 6 PAV'T. - RIGHT 4

5 TO RT. EDGE PAVEMENT

S.L.M. 589+9.5

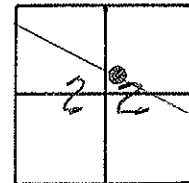

PREVIOUS MONUMENT
BROKEN PK

SET
SHI.
24" ASH

SET PK&WASHER
8-1-01
SAH

PAVEMENT

96.16'

60.80'

23.15'

SR. 18

FD.
SHI.

SET
TACK
IN MAIL BOX

O.D.O.T. DISTRICT 2 SURVEY OFFICE

PERSONNEL

REFERENCE NO. 41 A

SHEET 23 OF 27

NOTES CHENEY

H.C. RIPPLE

R.C. BARBOUR

DATE 10-8-1991

WEATHER SUNNY

TEMP. 60°

ROUTE 18

COUNTY SENECA

TOWNSHIP HOPWELL

SECTION 22

T2 N R 14 E


TYPE MONUMENT SET PK/WASHER

ON SURFACE - BELOW

~~LEFT~~ - 4' PAV'T. - RIGHT

TO EDGE PAVEMENT

S.L.M. 589+84

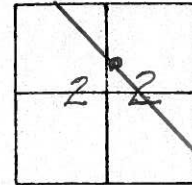

PREVIOUS MONUMENT:

BROKEN P.K.

