

O.D.O.T. DISTRICT 2 SURVEY OFFICE (USE ONLY)

PERSONNEL

REFERENCE NO. 41B

SHEET OF

NOTES RHOADES

DATE 4/10/24

ROUTE SR 18

H.C. NIESE

WEATHER CLOUDY

COUNTY SENECA

R.C. MILLER

TEMP. 55°

TOWNSHIP HOPEWELL

SECTION 22

DWG BY BARRIERE

PID 92371

T 2 N R 14 E

TYPE MONUMENT MAG NAIL/WASHER

ON SURFACE - BELOW ON

OFFSET $\odot$ PAVEMENT 3' RT LT : RT

 TO EDGE PAVEMENT

STATION: 591+50

HORIZ.DATUM: NAD83 (2011)


GEOID: 18

GRID: NORTHING: NO DATA

EASTING: NO DATA

LDP: NORTHING:


EASTING:

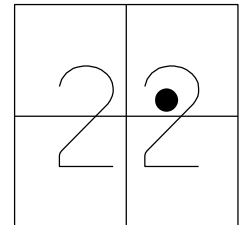

RECORD: P.C.
STA. 489+43.33
PER 1942 PLANS
 $\Delta = 0^\circ 58' 00''$ RT
L = 483.33'
T = 241.67'
D.N.F.
4/23/19, JFO
FD NAIL 1 1/2" DOWN
REF 41B
4/10/24, TDN
SET MAG/WASHER
9/11/24, TDN

****NOTE****

GET COORDINATES ON NEXT VISIT

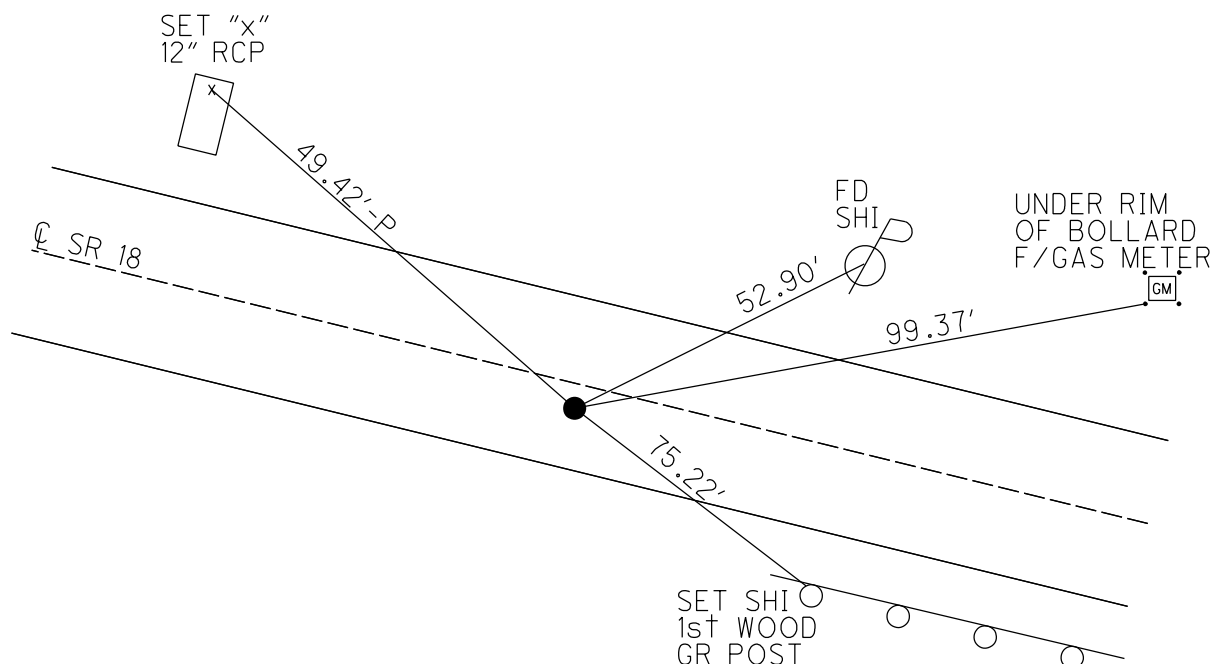

O.D.O.T. DISTRICT 2 SURVEY OFFICE (USE ONLY)

PERSONNEL

REFERENCE NO. 41 B

SHEET 46 OF 48

NOTES VAN DUSEN

DATE 6/4/01

ROUTE SR 18

H.C. ROUSOS

WEATHER SUNNY

COUNTY SENECA

R.C. BROWN

TEMP. 60°

TOWNSHIP HOPEWELL

SECTION 22

DWG BY NIESE

PID NO PID

T 2 N R 14 E

TYPE MONUMENT P.K./WASHER

ON SURFACE - ~~BELOW~~ ON

OFFSET Q PAVEMENT 3.0' ~~LT~~ : RT

8.3' TO RT EDGE PAVEMENT


STATION: 591+50

HORZ.DATUM: -


GEOID: -

GRID: NORTHING: -

EASTING: -

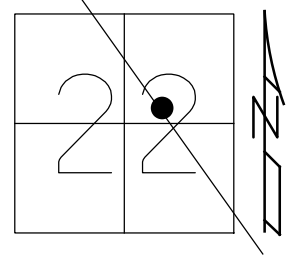

RECORD: P.C.
STA. 597+39.31
 $\Delta = 0^\circ 58' 00''$ RT
L = 483.33'
T = 241.67'
D.N.F.
4/23/19, JFO

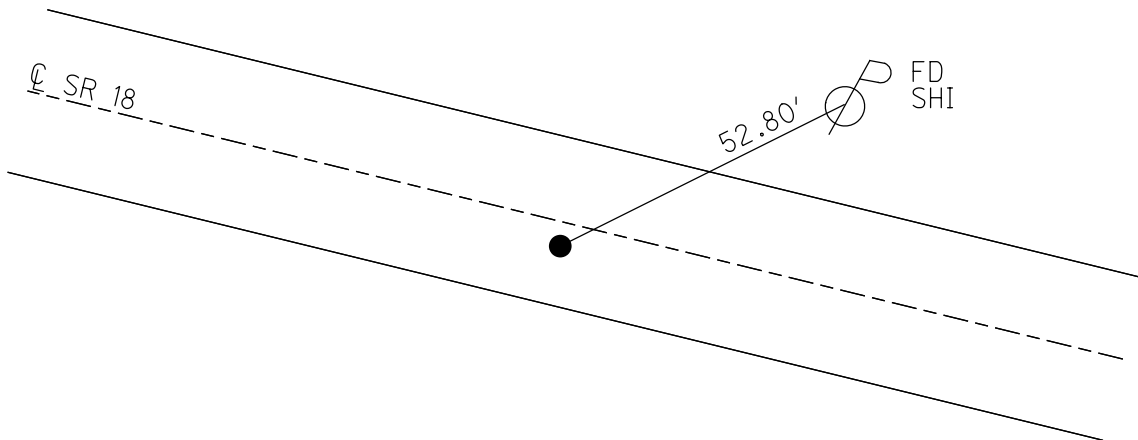

O.D.O.T. DISTRICT 2 SURVEY OFFICE

PERSONNEL

REFERENCE NO. 418

SHEET 23 OF 26

NOTES Vandusen

H.C. Rousos

R.C. Brown

DATE 6-4-01

WEATHER Sunny

TEMP. +60°F

ROUTE 18

COUNTY Seneca

TOWNSHIP Hopewell

SECTION 22

T 2 N R 14 E


TYPE MONUMENT PK/W

ON SURFACE - ~~BELONG~~ Surface

~~10' - 1~~ PAV'T. - RIGHT 3.0'

8.3' TO RT. EDGE PAVEMENT

S.L.M. 596+50

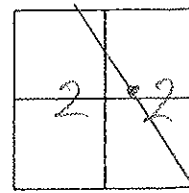

Record:


Plan Sta 5971.39.91

A = 0° - 58' RT

L = 483.33'

T = 241.67'

*PL
Set by Contractor*

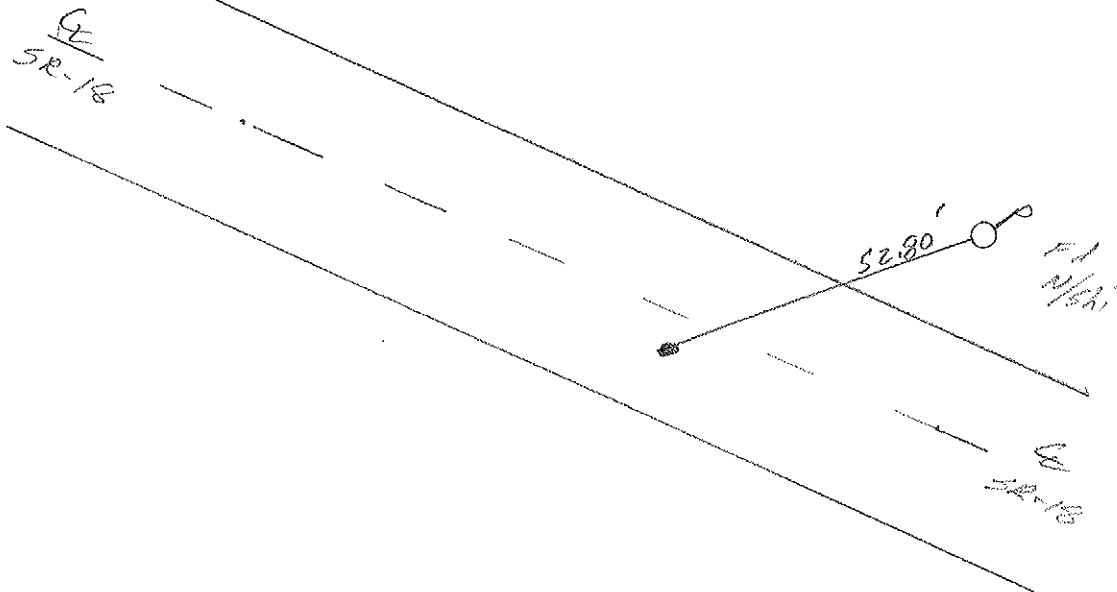

All temporary (HUBS) TIES
were DESTROYED by mowers
(Dig When Needed)

O.D.O.T. DISTRICT 2 SURVEY OFFICE

PERSONNEL

REFERENCE NO. 418

SHEET 24 OF 27

NOTES CHEHEY

H.C. RIPPLE

R.C. BARBOUR

DATE 10-8-1991

WEATHER SUNNY

TEMP. 60°

ROUTE 18

COUNTY SENECA

TOWNSHIP HOPWELL

SECTION 22

T. 2 N. R. 1 E


TYPE MONUMENT SET PK/WASHER

ON SURFACE - BELOW

LEFT - C. PAV'T. - RIGHT 3.0'

8.3' TO RT. EDGE PAVEMENT

S.L.M. 11.31

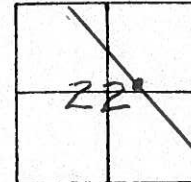

STA. 597+39.91 P.C. {SET BY CONTRACTOR}

$\Delta = 0^\circ 58'$ RT.

$L = 483.33'$

$T = 241.67'$

