

O.D.O.T. DISTRICT 2 SURVEY OFFICE (USE ONLY)

PERSONNEL

REFERENCE NO. C41

SHEET OF

NOTES RHOADES

DATE 4/10/24

ROUTE SR 18

H.C. NIESE

WEATHER CLOUDY

COUNTY SENECA

R.C. MILLER

TEMP. 55°

TOWNSHIP HOPEWELL

SECTION 22

DWG BY BARRIERE

PID 92371

T 2 N R 14 E

TYPE MONUMENT MAG NAIL/WASHER

ON SURFACE - BELOW ON

OFFSET $\mathcal{Q}$ PAVEMENT 3.2' RT LT : RT

 TO EDGE PAVEMENT

STATION: 589+92

HORZ.DATUM: NAD83 (2011)


GEOID: 18

GRID: NORTHING: 528907.505

EASTING: 1766929.871


LDP: NORTHING:

EASTING:

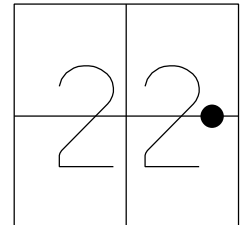

RECORD: P.I.
STA. 491+85.00
PER 1942 PLANS
 $\Delta = 0^\circ 58' 00''$ RT
D = $0^\circ 12'$
R = 28647.90'
T = 241.67'

FD P.K./WASHER
6/4/01, BVD
FD P.K.SHANK
REFC41
4/23/19
8/16/19
2/16/22, JFO
SET MAG/WASHER
REFC41
7/25/22, DSA
FD MAG/WASHER
REFC41
9/27/22, TDN
SET MAG/WASHER
9/11/24, TDN

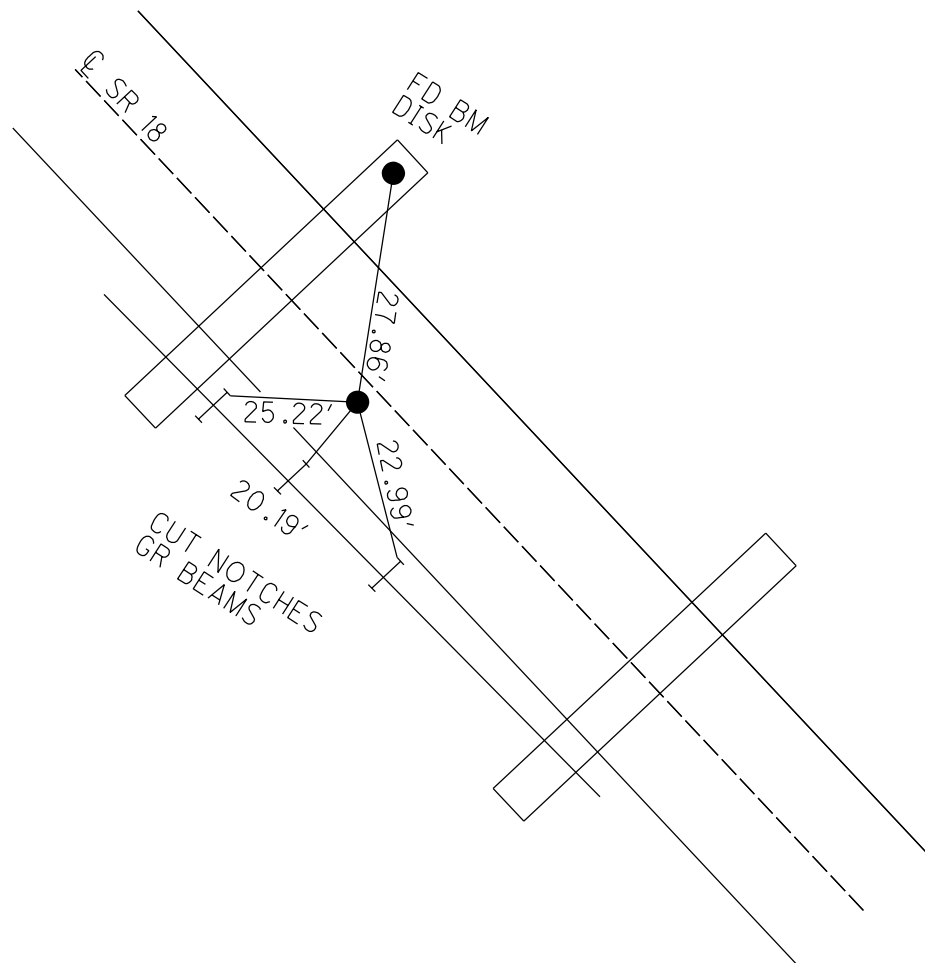

O.D.O.T. DISTRICT 2 SURVEY OFFICE (USE ONLY)

PERSONNEL

REFERENCE NO. 41 C

SHEET 47 OF 48

NOTES RHOADES

DATE 9/8/21

ROUTE SR 18

H.C. AUBLE

WEATHER SUNNY

COUNTY SENECA

R.C. NIESE

TEMP. 68°

TOWNSHIP HOPEWELL

SECTION 22

DWG BY WHITAKER

PID PVTRN

T 2 N R 14 E

TYPE MONUMENT P.K. SHANK

ON SURFACE - ~~BELOW~~ ON

OFFSET CL PAVEMENT 3.2' ~~LT~~ : RT

9.5' TO RT EDGE PAVEMENT


STATION: 599+92

HORZ.DATUM: NAD83(2011)

GEOID: 2012A

GRID: NORTHING: 528907.528

EASTING: 1766929.809

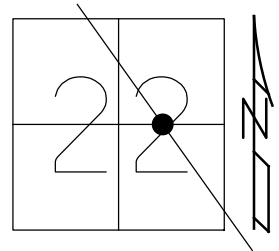

RECORD:

FD P.K./WASHER

6/4/01, BVD

FD P.K.SHANK

REFC41

4/23/19


8/16/19

2/16/22, JFO

SET MAG/WASHER

REFC41

7/25/22, DSA

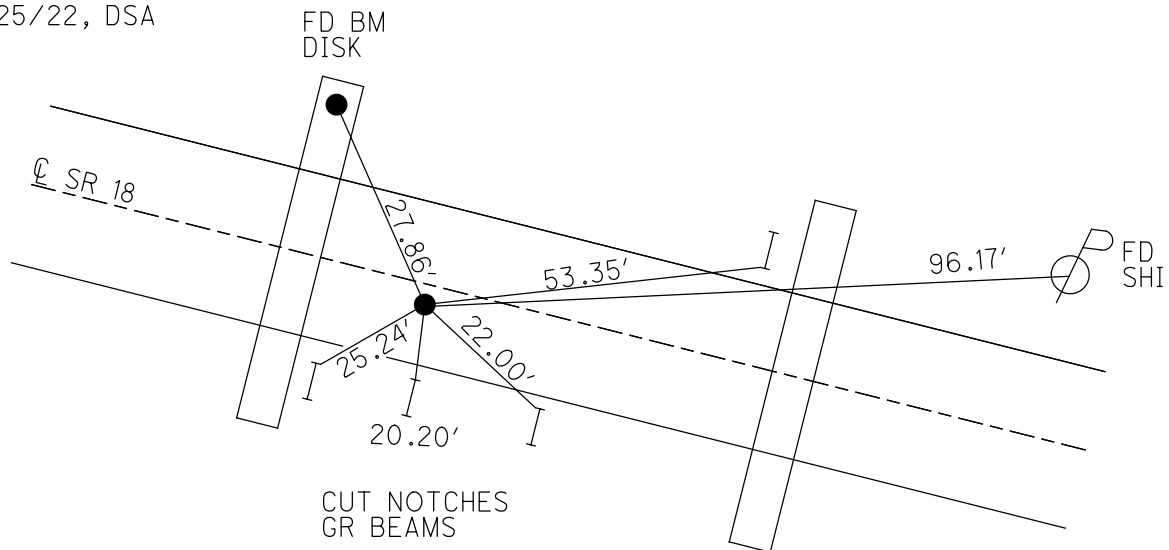

O.D.O.T. DISTRICT 2 SURVEY OFFICE (USE ONLY)

PERSONNEL

REFERENCE NO. 41 C

SHEET 47 OF 48

NOTES VAN DUSEN

DATE 6/4/01

ROUTE SR 18

H.C. ROUSOS

WEATHER SUNNY

COUNTY SENECA

R.C. BROWN

TEMP. 60°

TOWNSHIP HOPEWELL

SECTION 22

DWG BY NIESE

PID NO PID

T 2 N R 14 E

TYPE MONUMENT P.K./WASHER

ON SURFACE - ~~BELOW~~ ON

OFFSET CL PAVEMENT 3.2' ~~LT~~ : RT

9.5' TO RT EDGE PAVEMENT


STATION: 589+92

HORIZ.DATUM: NAD83(2011)

GEOID: 2012A

GRID: NORTHING: 528907.528

EASTING: 1766929.809

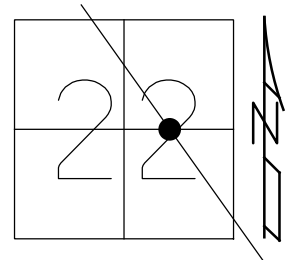

RECORD:

FD P.K./WASHER


6/4/01, BVD

FD P.K.SHANK

REFC41

4/23/19

8/16/19, JFO

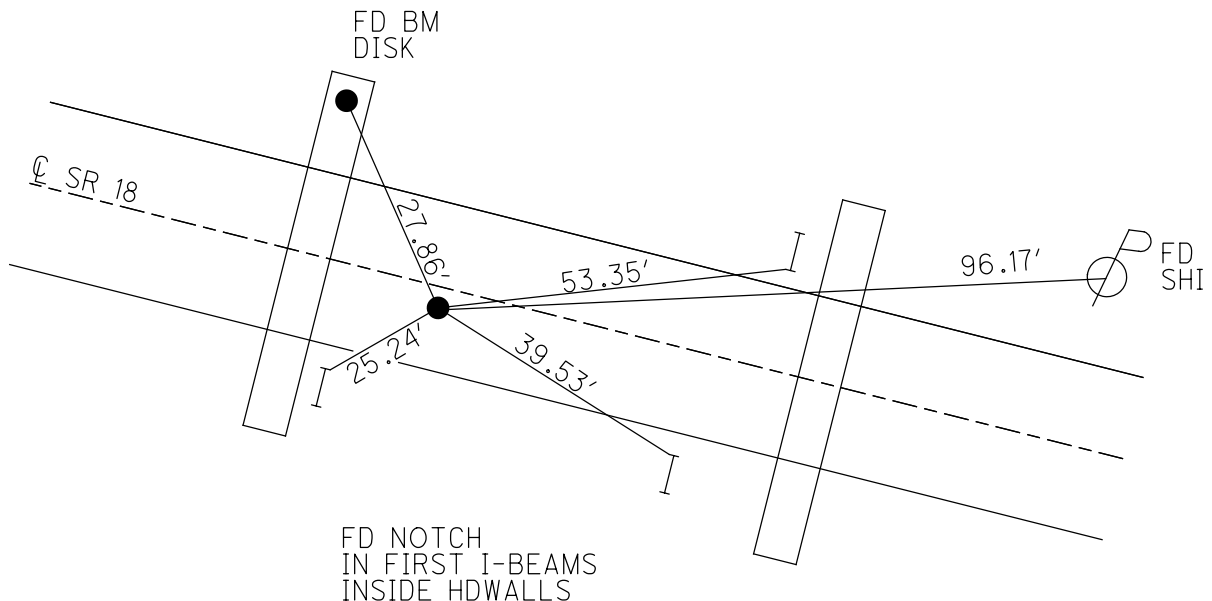

O.D.O.T. DISTRICT 2 SURVEY OFFICE

PERSONNEL

REFERENCE NO. 41C

SHEET 24 OF 26

NOTES Van Dusen

H.C. Rousos

R.C. Brown

DATE 6-4-01

WEATHER Sunny

TEMP. 60°F

ROUTE 18

COUNTY Seneca

TOWNSHIP Hopewell

SECTION 22

T2 N R 14 E



TYPE MONUMENT PK/W

ON SURFACE - ~~BELOW~~

~~LEFT~~ - PAV'T - RIGHT 3.2'

7.5' TO S. EDGE PAVEMENT

S.L.M. 598+92

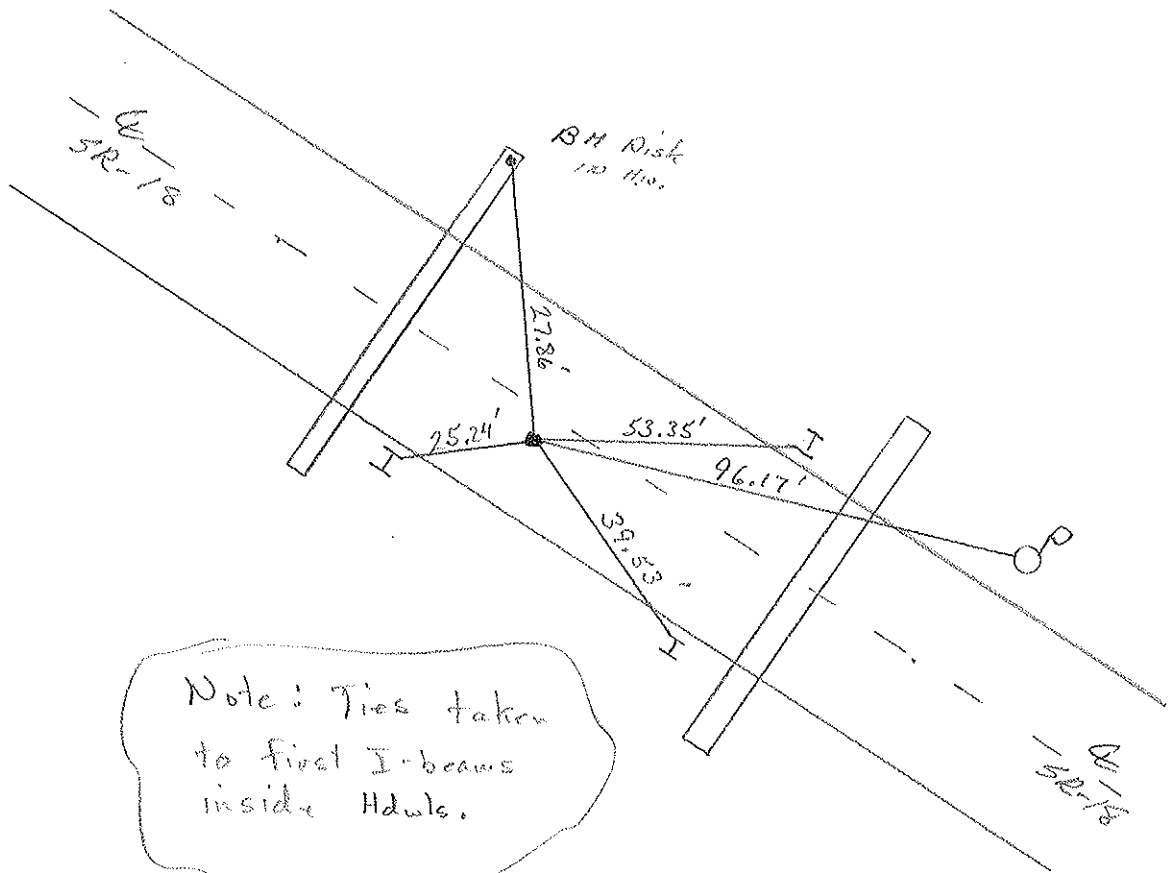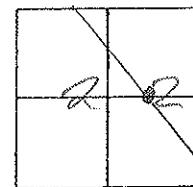

Note: Ties taken
to first I-beams
inside Hdws.

O.D.O.T. DISTRICT 2 SURVEY OFFICE

PERSONNEL

REFERENCE NO. 41. C

SHEET 25 OF 27

NOTES CHENEY

H.C. RIPPLE

DATE 10-9-1991

ROUTE 18

R.C. BARBOUR

WEATHER SUNNY

COUNTY SENECA

TEMP. 70°

TOWNSHIP HOPWELL

SECTION 22

T2 NR 14 E


TYPE MONUMENT RE-SET PK/WASHER

ON SURFACE - BELOW


LEFT - C PAV'T. - RIGHT 3.2'

9.5 TO 5.4 EDGE PAVEMENT

S.L.M. 11.36

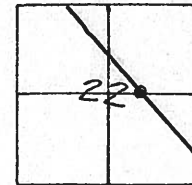

STA. 599+81.58

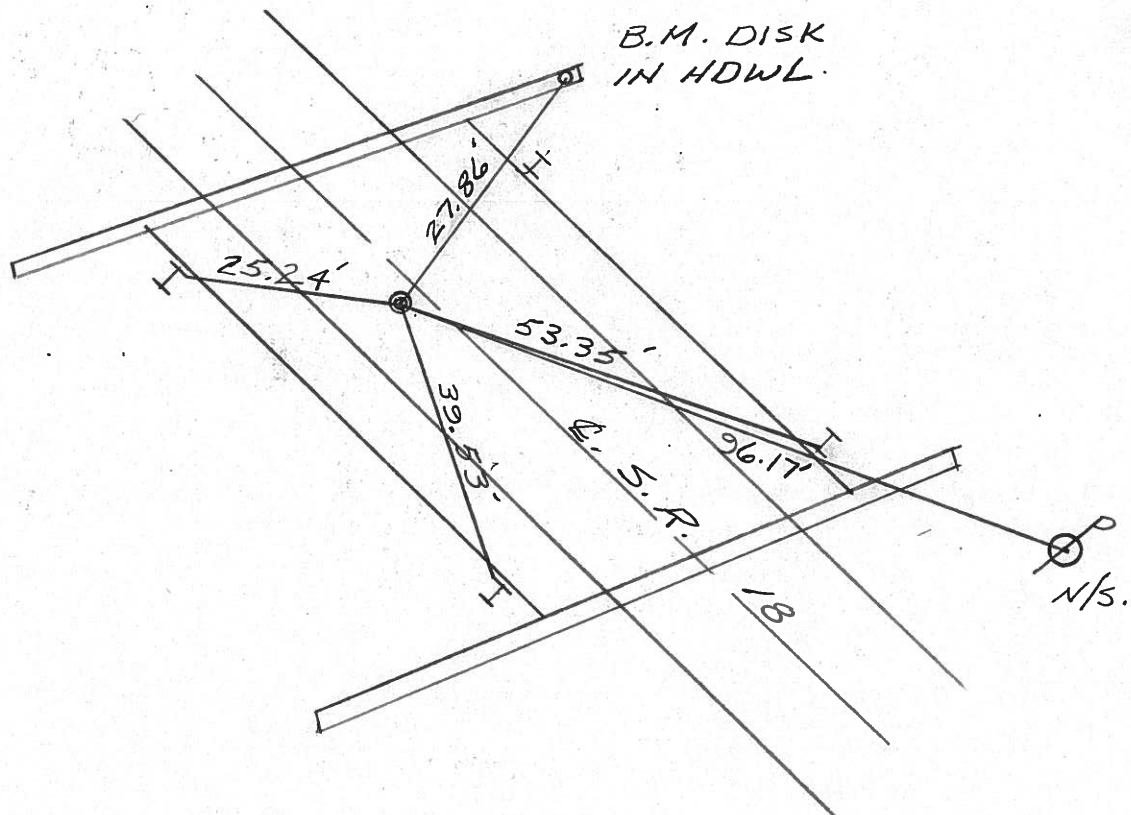

NOTE: TIES TAKEN TO 1ST
I-BEAM INSIDE HDWLS.