

O.D.O.T. DISTRICT 2 SURVEY OFFICE (USE ONLY)

PERSONNEL

REFERENCE NO. 42

SHEET _____ OF _____

NOTES RHOADES

DATE 4/10/24

ROUTE SR 18

H.C.	NIESE
------	-------

WEATHER CLOUDY

COUNTY SENECA

R.C. MILLER

TEMP. 55°

TOWNSHIP HOPEWELL

DWG BY BARRIERE

PID 92371

T_2_N R_14_E

TYPE MONUMENT MAG NAIL/WASHER

ON SURFACE - BELOW ON

OFFSET @ PAVEMENT 3.0' RT LT : RT

_____TO_____EDGE PAVEMENT

STATION: 603+06

HORZ.DATUM: NAD83 (2011)


GEOID: 18

GRID: NORTHING: 528626.997

EASTING: 1767234.823


LDP: NOTHING:

EASTING:

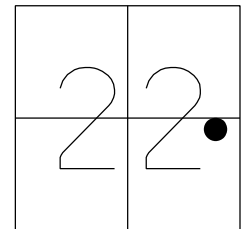

RECORD: P.I.
STA. 495+99.20
PER 1942 PLANS
 $\Delta = 0^{\circ} 26' 00''$ LT
 $R = 28647.90'$
 $T = 108.33'$

PREV MONUMENTS:
P.K./SHINER
P.K.NAIL
FD P.K./WASHER
6/4/01, BVD
SET P.K./WASHER
8/1/01, SAH
FD P.K./WASHER
REF42
4/22/19
8/18/19, JFO
FD P.K.NAIL
9/8/21, DSA
2/16/22, JFO
FD P.K. SHANK
REF42
9/27/22, TDN
SET MAG/WASHER
9/11/24, TDN

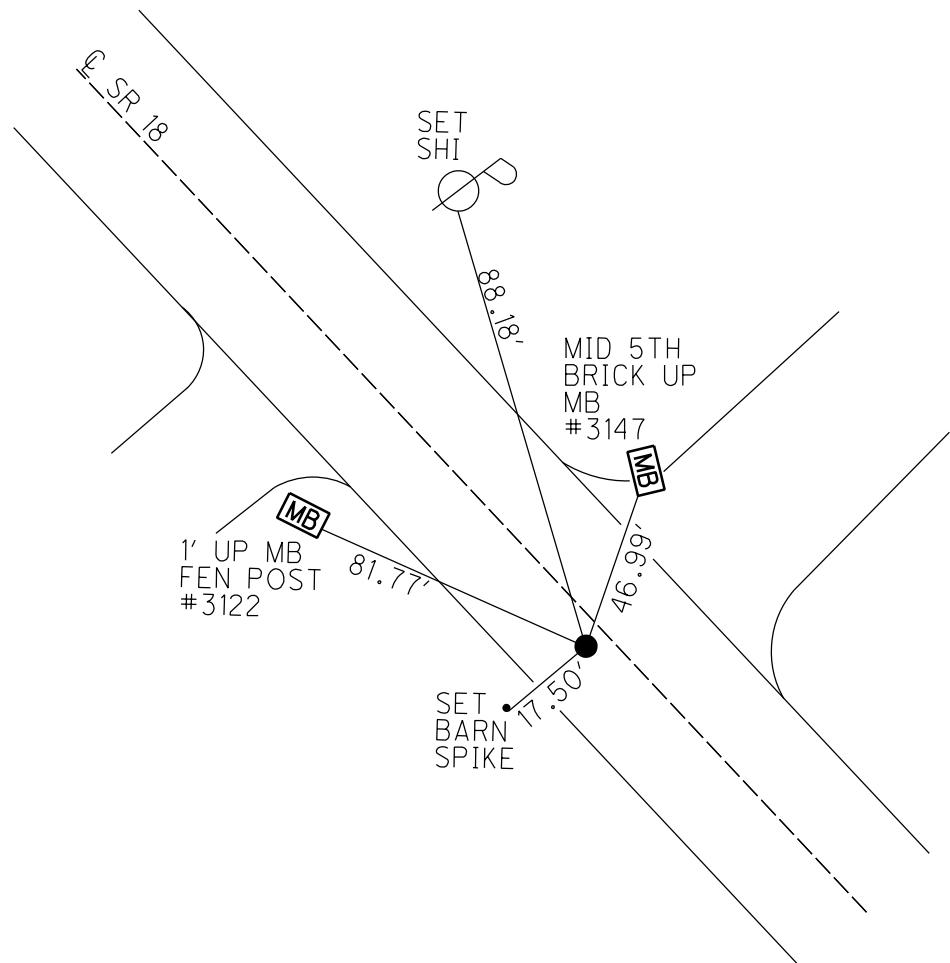

O.D.O.T. DISTRICT 2 SURVEY OFFICE (USE ONLY)

PERSONNEL

REFERENCE NO. 42

SHEET 48 OF 48

NOTES RHOADES

DATE 9/8/21

ROUTE SR 18

H.C. AUBLE

WEATHER SUNNY

COUNTY SENECA

R.C. NIESE

TEMP. 68°

TOWNSHIP HOPEWELL

SECTION 22

DWG BY RHOADES PID PVTRAIN

T 2 N R 14 E

TYPE MONUMENT P.K.NAIL

ON SURFACE - ~~BELOW~~ ON

OFFSET CL PAVEMENT 3.0' ~~LT~~ : RT
8.0' TO RT EDGE PAVEMENT


STATION: 603+06

HORIZ.DATUM: NAD83(2011)

GEOID: 2012A

GRID: NORTHING: 528627.034

EASTING: 1767234.773

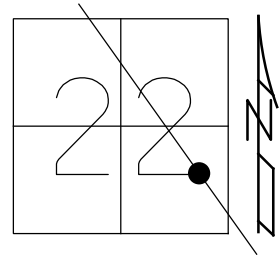

RECORD:

PREV MONUMENTS:

P.K./SHINER

P.K.NAIL

FD P.K./WASHER

6/4/01, BVD

SET P.K./WASHER

8/1/01, SAH

FD P.K./WASHER

REF42


4/22/19

8/18/19, JFO

FD P.K.NAIL

9/8/21, DSA

2/16/22, JFO

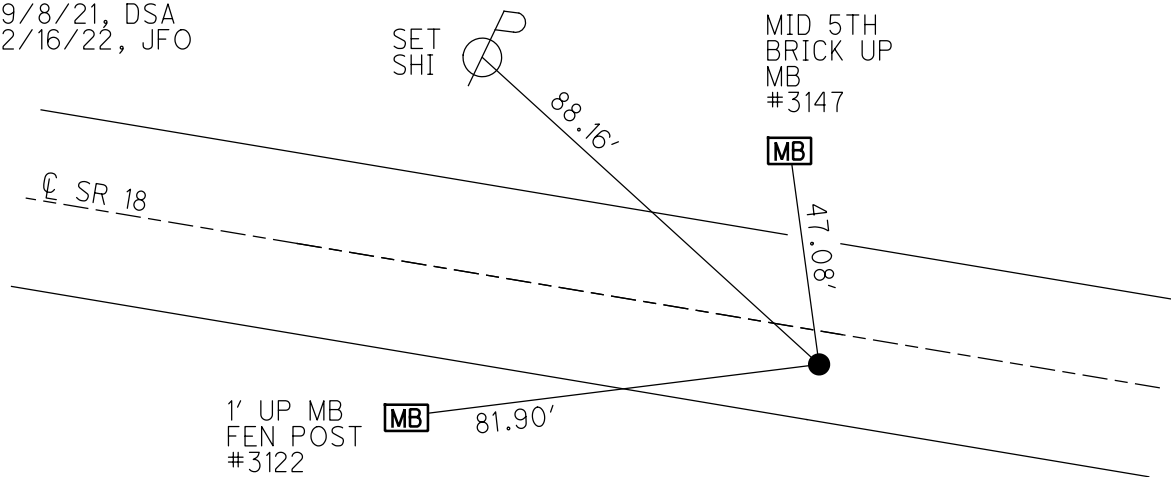

O.D.O.T. DISTRICT 2 SURVEY OFFICE (USE ONLY)

PERSONNEL

REFERENCE NO. 42

SHEET 48 OF 48

NOTES VAN DUSEN

DATE 6/4/01

ROUTE SR 18

H.C. ROUSOS

WEATHER SUNNY

COUNTY SENECA

R.C. BROWN

TEMP. 60°

TOWNSHIP HOPEWELL

SECTION 22

DWG BY NIESE PID NO PID

T 2 N R 14 E

TYPE MONUMENT P.K./WASHER

ON SURFACE - ~~BELOW~~ ON

OFFSET CL PAVEMENT 3.0' ~~LT~~ : RT

8.0' TO RT EDGE PAVEMENT


STATION: 603+06

HORIZ.DATUM: NAD83(2011)


GEOID: 2012A

GRID: NORTHING: 528627.034

EASTING: 1767234.773

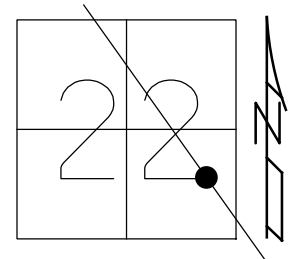

RECORD:
PREV MONUMENTS:
P.K./SHINER
P.K.NAIL
FD P.K./WASHER
6/4/01, BVD
SET P.K./WASHER
8/1/01, SAH
FD P.K./WASHER
REF42
4/22/19
8/18/19, JFO

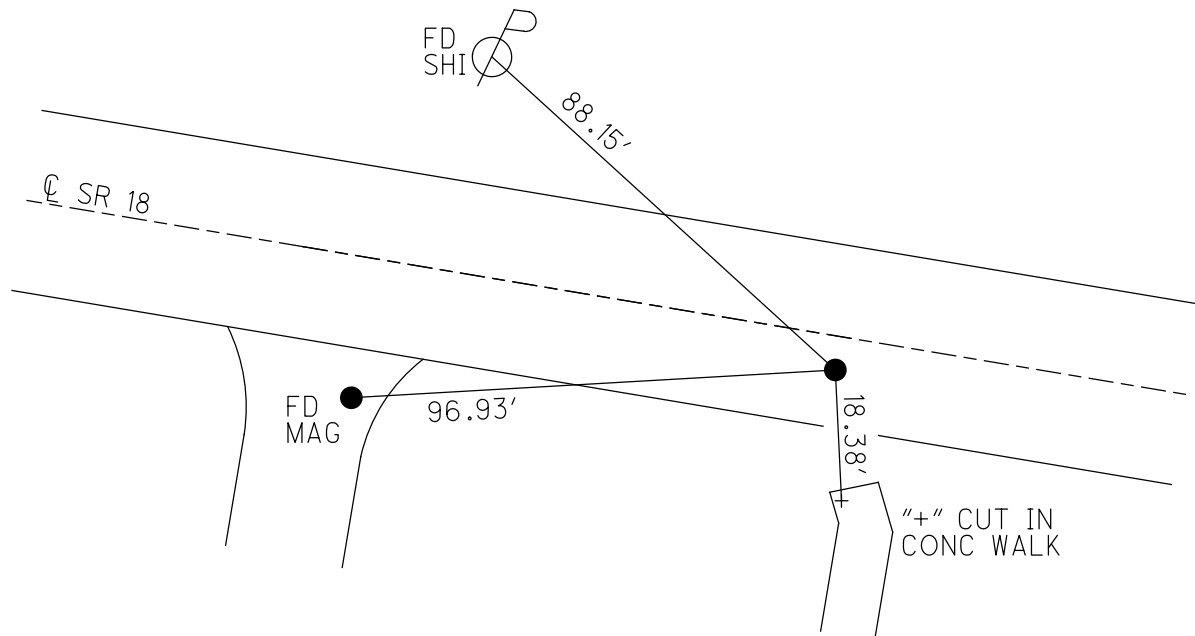

O.D.O.T. DISTRICT 2 SURVEY OFFICE

PERSONNEL

REFERENCE NO. 42

SHEET 25 OF 26

NOTES VAN DUSEN

H.C. Rouss

R.C. Adams E.

DATE 6-4-01

WEATHER SUNNY

TEMP. 76.00 F

ROUTE 18

COUNTY SENECA

TOWNSHIP HOPEWELL

SECTION 22

T2 NR 14 E


TYPE MONUMENT PKF WASHER

ON SURFACE - ~~BELOW~~ YES

LEFT - & PAN'T. - RIGHT 3'

8' TO RT EDGE PAVEMENT

S.I. M. 603 + 06

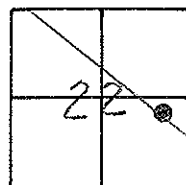


PREVIOUS MONUMENTS.

PK SHINER

P.K. REC:

SET PRESS WASHER
8-1-01
JAH

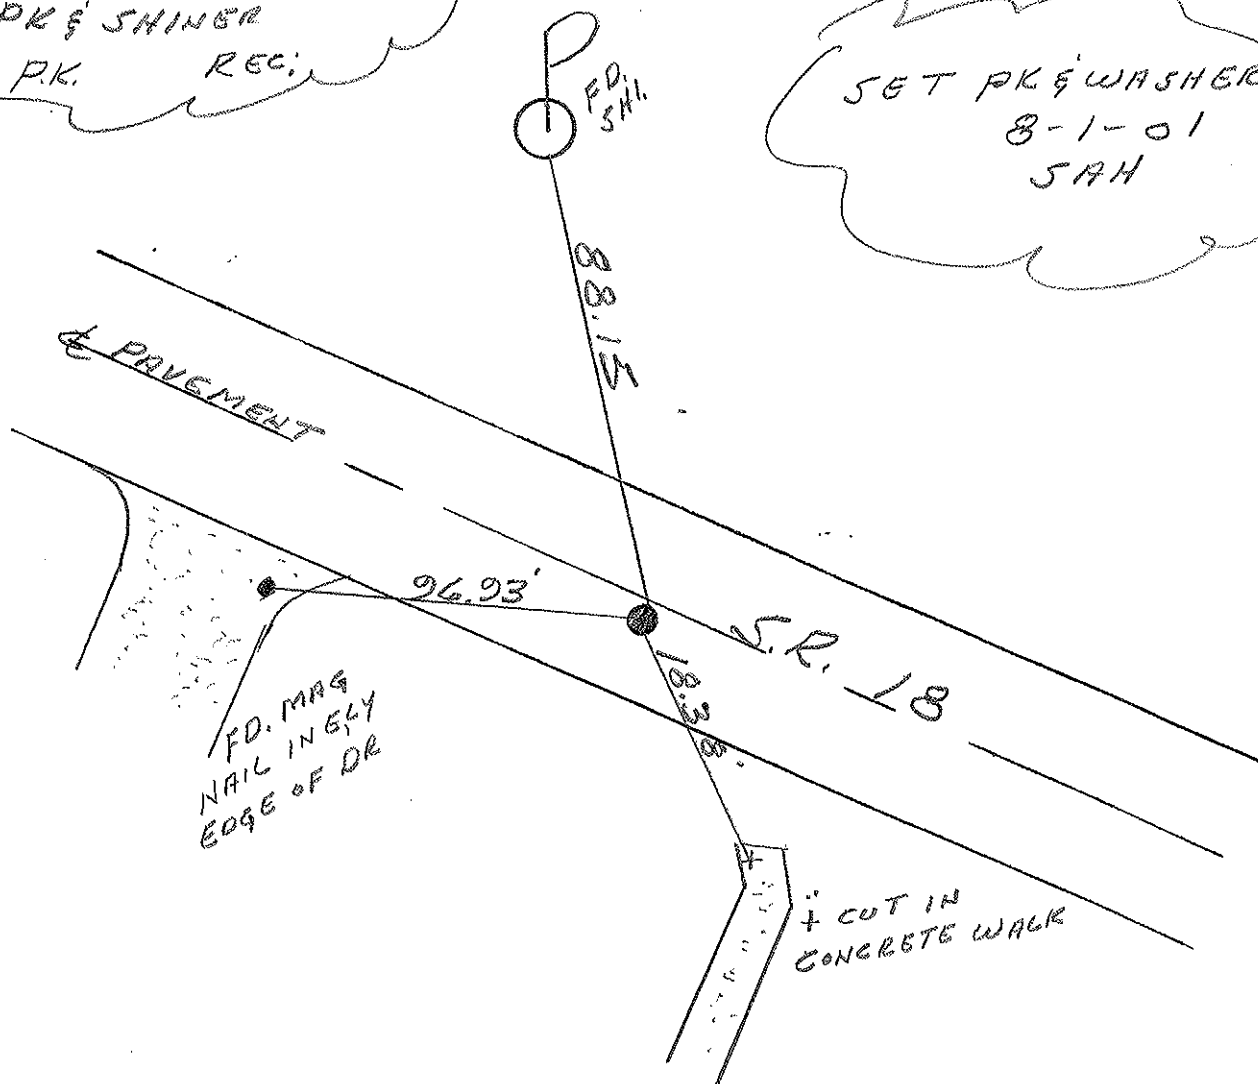

O.D.O.T. DISTRICT 2 SURVEY OFFICE

PERSONNEL

REFERENCE NO. 42

SHEET 22 OF 27

NOTES CHENEY

H.C. RIPPLE

R.C. BAIRBOUR

DATE 10-8-1991

WEATHER SUNNY

TEMP. 60°

ROUTE 18

COUNTY SENECA

TOWNSHIP HOPEWELL

SECTION 22

T2 N R 14 E


TYPE MONUMENT SET PK/WASHER

ON SURFACE - ~~BELOW~~ _____

~~FEET~~ c PAV'T. - RIGHT 3'

8' TO RT. EDGE PAVEMENT

S.L.M. 602+97

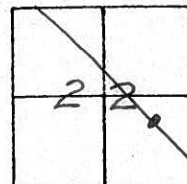

PREVIOUS MONUMENTS:

PK/SHINER

РК.

N/S.

88.13

87.89'

N/S. IN BLACKTOP
DRIVE (E'LY. EDGE)

4/5

99

90

-X" CUT IN
CONCRETE
WALK

QD.O.T. DISTRICT 2 SURVEY OFFICE

Sht. ____ of ____

County Seneca S.R. # 18

Township Hopewell

Section 22

T2N, R14E

Personnel Schneider

Mosser

Barbour


Cronin

Rippl Geyman

Date OK. 9-12-80 - G.W.S.
5-19-80

Weather cloudy

Temp. 58°

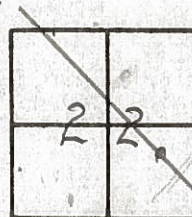


42



P.K. Nail

2' Rt. of $\frac{1}{4}$

SET P.K. NAIL $\frac{1}{4}$ SH.

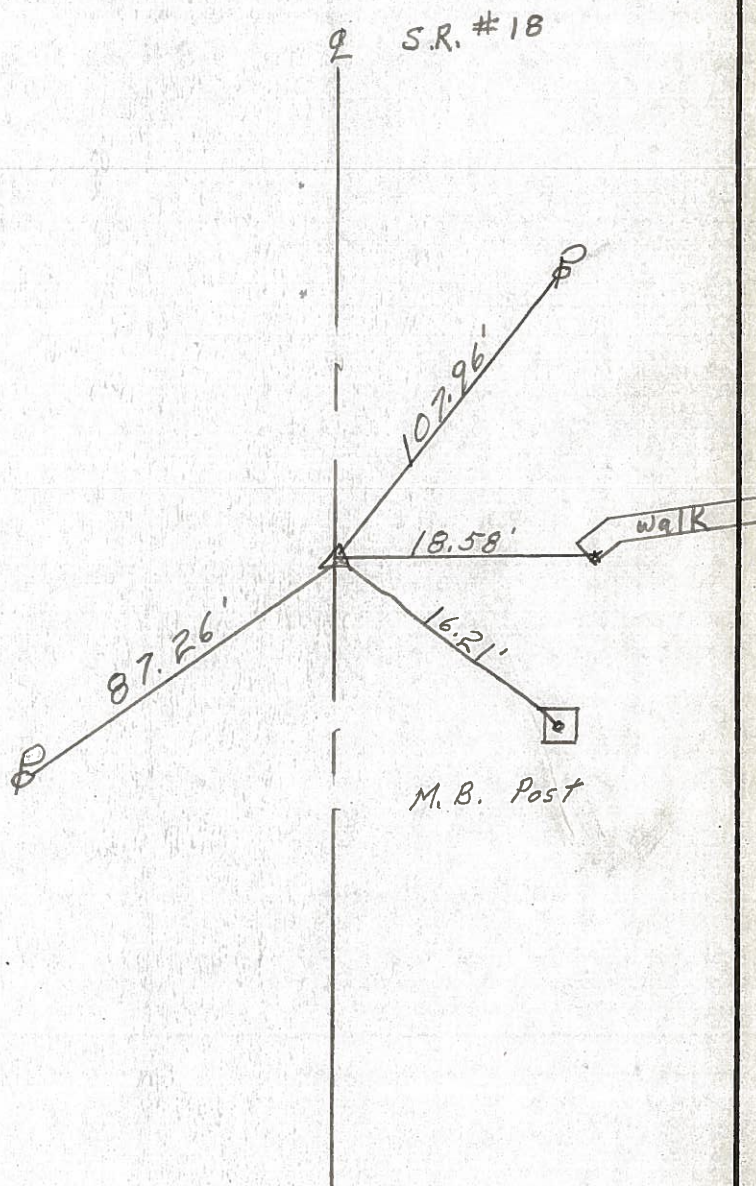

PERSONNEL	TITLE	PERSONNEL	TITLE	COUNTY	DATE	WEATHER	TEMP.
Schneider				Seneca	10-29-68	Fair - Cold	35°
Barbour				S. R. 18			
Redding				SEC. Bascon to Tiffin			
Potts							

DESCRIPTION Ties for Control Points LEFT CENTER LINE RIGHT JOB NO.

