

O.D.O.T. DISTRICT 2 SURVEY OFFICE (USE ONLY)

PERSONNEL

REFERENCE NO. 42A

SHEET OF

NOTES RHOADES
H.C. NIESE
R.C. MILLER

DATE 4/10/24
WEATHER CLOUDY
TEMP. 55°

ROUTE SR 18
COUNTY SENECA
TOWNSHIP HOPEWELL
SECTION 23

DWG BY BARRIERE PID 92371

T 2 N R 14 E

TYPE MONUMENT MAG NAIL/WASHER

ON SURFACE - BELOW ON

OFFSET $\mathcal{Q}$ PAVEMENT ON LT : RT

 TO EDGE PAVEMENT

STATION: 631+52

HORIZ.DATUM: NAD83 (2011)


GEOID: 18

GRID: NORTHING: 526723.269

EASTING: 1769350.959

LDP: NORTHING:

EASTING:

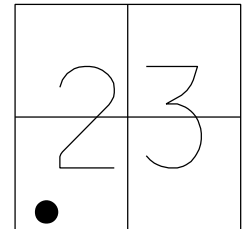


RECORD:
STA 631+57.65
SEN-224-10.64-1998
PID 11690

P.K./WASHER
FD P.K./WASHER
6/4/01, TR
SET P.K./WASHER
8/1/01, SAHFD MAG NAIL
*BELIEVE TO BE REF42A
BASED OFF FIELD NOTES
FROM LOEHRKE ON 3/2/99
AND REF TIE FROM 11/5/91.
SV2 (42A)
4/10/24, TDN
SET MAG/WASHER
9/11/24, TDN

RECORD:
FND MAG NAILS
ORIGIN UNKNOWN
SV1 (42AA)
SV3 (42AB)
4/10/24, TDN
SET MAG/WASHER
9/11/24, TDN

SET
SHI  42AA- 61.33'
42A - 63.61'
42AB- 81.90'

42AA-42A: 2.83'
42AA-42AB: 24.33'
42A-42AB: 21.49'

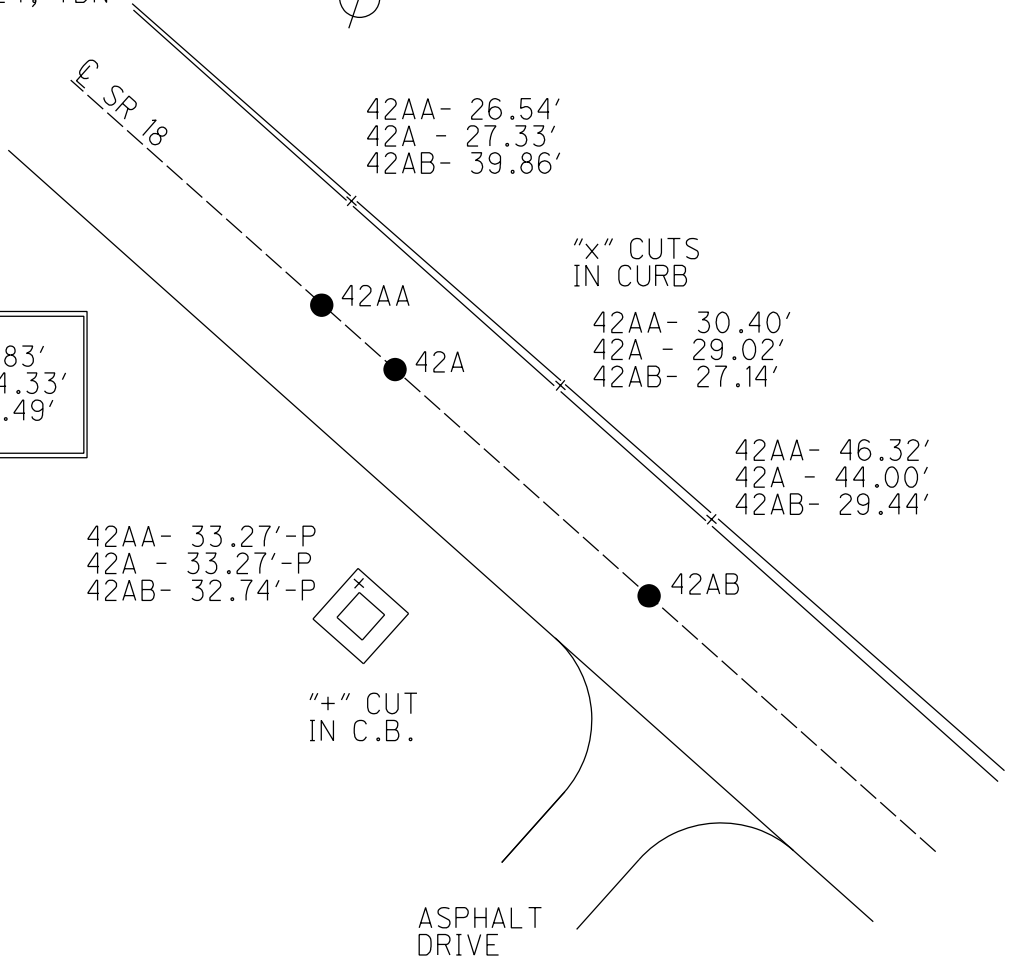

O.D.O.T. DISTRICT 2 SURVEY OFFICE (USE ONLY)

PERSONNEL

REFERENCE NO. 42 A

SHEET 1 OF 18

NOTES VAN DUSEN

DATE 6/4/01

ROUTE SR 18

H.C. ROUSOS

WEATHER SUNNY

COUNTY SENECA

R.C. BROWN

TEMP. 60°

TOWNSHIP HOPEWELLDWG BY NIESE

PID

T_2_N R_14_E

TYPE MONUMENT P.K./WASHER

ON SURFACE - ~~BELOW~~ _____ ON

OFFSET C PAVEMENT ON LT : RT

11.5' TO LT EDGE PAVEMENT


STATION: 631+52

HORZ.DATUM:

GEOID:

GRID: NORTHING:

EASTING:

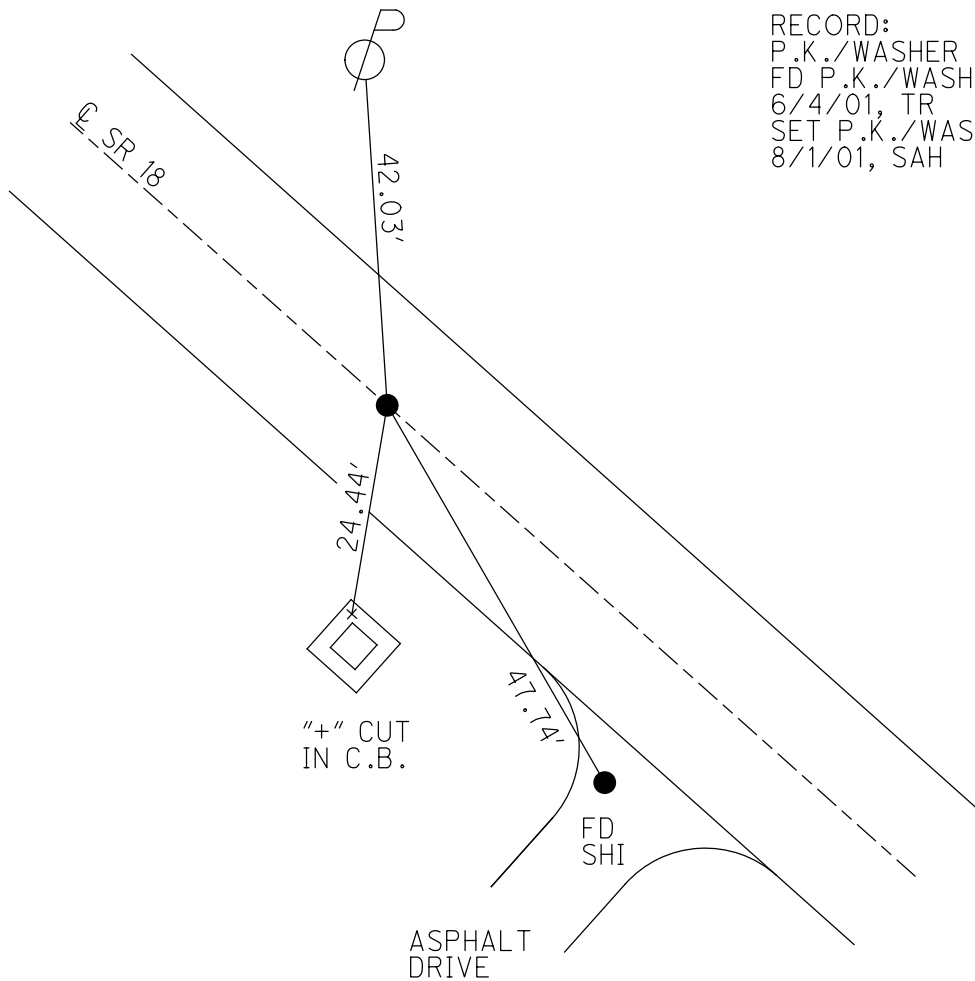

RECORD:
P.K./WASHER
FD P.K./WASHER
6/4/01, TR
SET P.K./WASHER
8/1/01, SAH

O.D.O.T. DISTRICT 2 SURVEY OFFICE

PERSONNEL

REFERENCE NO. 42A

SHEET 26 OF 26

NOTES Van Dusen

H.C. Russos

R.C. Brown

DATE 6-4-01

WEATHER Sunny

TEMP. 60°F

ROUTE 18

COUNTY Sheridan

TOWNSHIP Hopewell

SECTION 23

T 2 N R 14 E


TYPE MONUMENT PK/W

ON SURFACE - ~~BELOW~~ Surface

LEFT - ~~C~~ PAW'T - RIGHT 4' Pav't


145' TO N EDGE PAVEMENT

S.L.M. 631 + 52

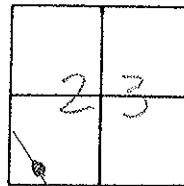

Record;
Prev. Mon. - PK/W

Set PK/W
8-1-01
SAH

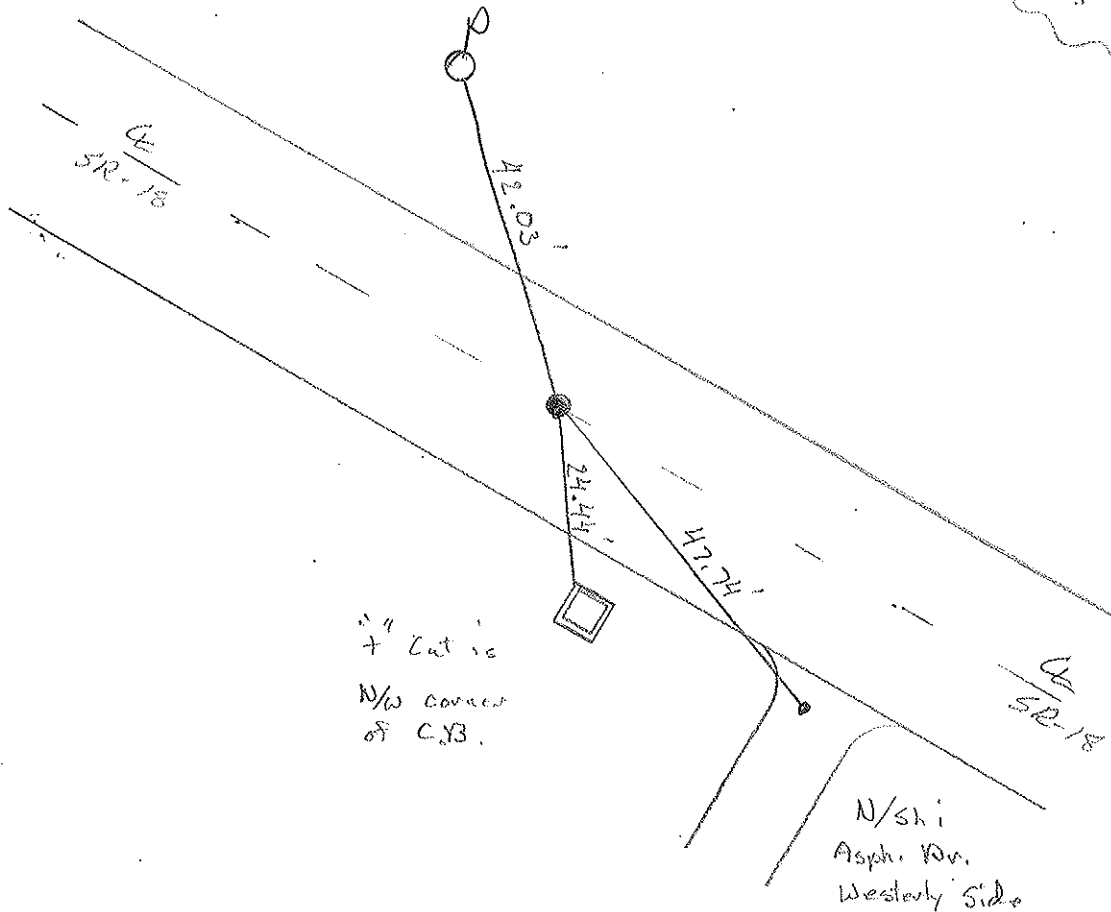

O.D.O.T. DISTRICT 2 SURVEY OFFICE

PERSONNEL

REFERENCE NO. 45

SHEET 26 OF 27

NOTES CHENEY

H.C. RIPPLE

R.C. BARBOUR

GEYMAN

DATE 11-5-1991

WEATHER PARTLY CLOUDY

TEMP. 30°

ROUTE 18

COUNTY SENECA

TOWNSHIP HOPEWELL

SECTION 23

T2N R14E

TYPE MONUMENT SET PK/WASHER


ON SURFACE - BELOW

~~LEFT~~ - & PAV'T. - ~~RIGHT~~

11.5' TO N. EDGE PAVEMENT


S.L.M. 631+43

42-A

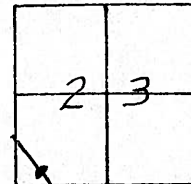


PREVIOUS MONUMENT:

PK. NAIL

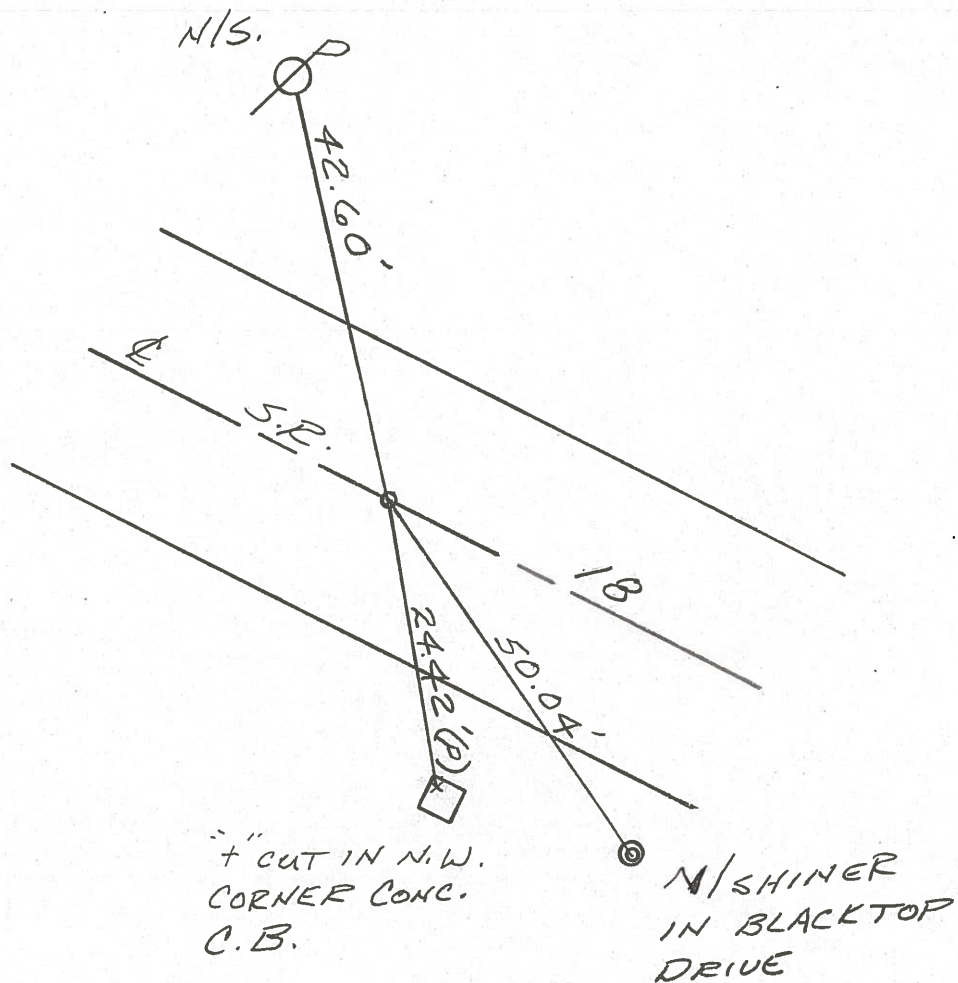

PERSONNEL	TITLE	PERSONNEL	TITLE	COUNTY	DATE
Schneider				Seneca	10-29-68
Barbour				S. R. 18	WEATHER Fair - Cold
Redding				SEC. Boscon to Tiffin	TEMP. 35°
Potts					

DESCRIPTION Ties for Control Points JOB NO. _____

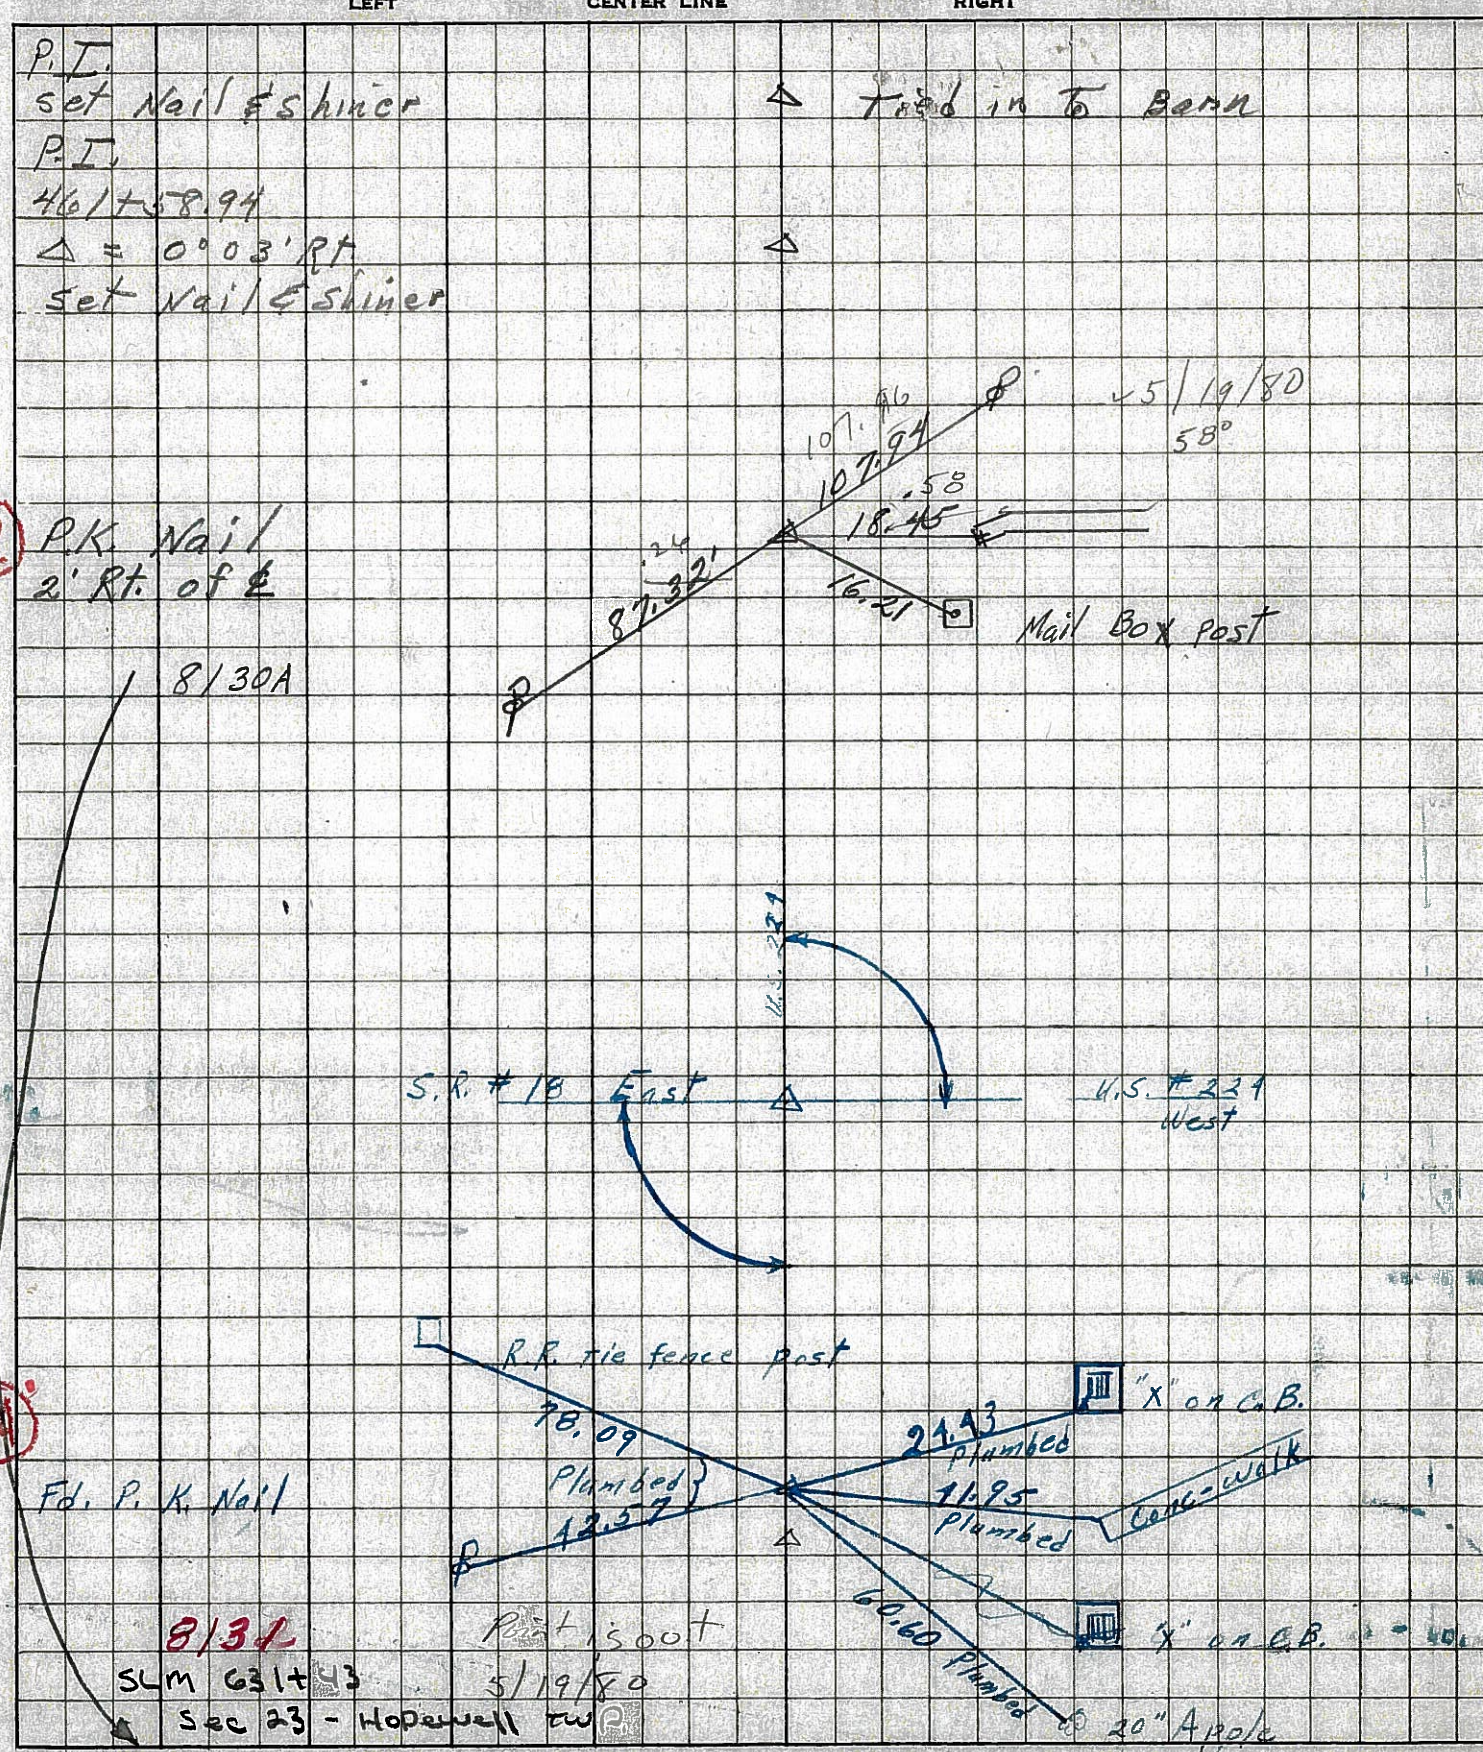

PERSONNEL	TITLE	PERSONNEL	TITLE	COUNTY	DATE	WEATHER	TEMP.
Schneider				Seneca	10-29-68	Fair-cold	35°
Barbour				S. R. 18			
Redding				SEC. Boscon to Tiffin			
Potts							

DESCRIPTION Ties for Control Points JOB NO. _____

