

O.D.O.T. DISTRICT 2 SURVEY OFFICE (USE ONLY)

PERSONNEL

REFERENCE NO. 1

SHEET 1 OF 27

NOTES SCHNEIDER

DATE 7/29/69

ROUTE SR 101

H.C. BARBOUR

WEATHER CLOUDY/RAIN

COUNTY SENECA

R.C. REDDING

TEMP. 70°

TOWNSHIP CLINTON

DWG BY MILLER

PID 102817

SECTION 20

T 2 N R 15 E

TYPE MONUMENT R.R.SPIKE

~~ON SURFACE~~ - BELOW 4"

OFFSET $\varnothing$ PAVEMENT ON ~~LT:RT~~

16.28' TO LT EDGE PAVEMENT



STATION: 81+30.5

HORZ.DATUM: _____

GEOID: _____

GRID: NORTHING: _____

EASTING: _____

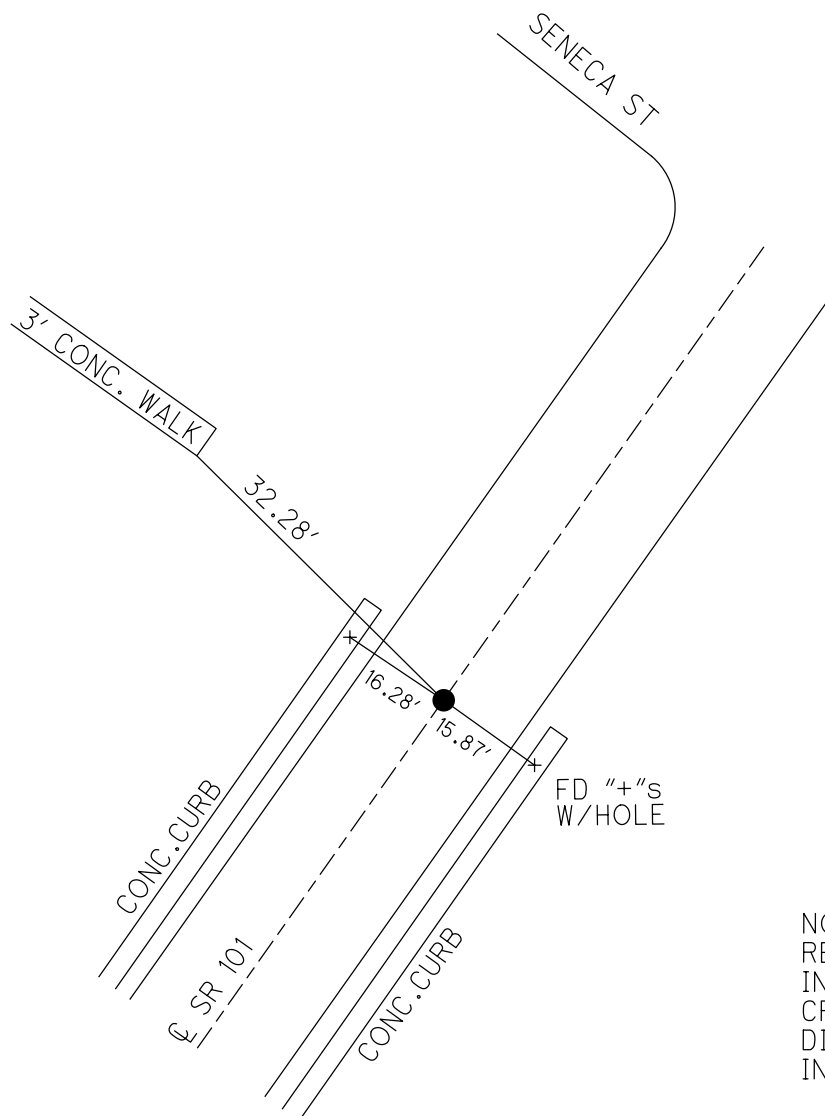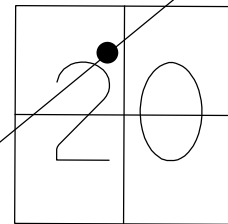

RECORD: P.I.
FD R.R.SPIKE IN
BRICK PAVM'T
 $\Delta = 0^{\circ} 00'$
STA. 43+90.3
7/29/69
DNF
10-11-16, JFO

NOTE:
RECORD WITNESS HOLES
IN SIDE OF CURBS, AND
CROSSES ON TOP.
DISTANCES ARE FROM HOLES
IN CURBS, 1936 PLANS.

O.D.O.T. DISTRICT 2 SURVEY OFFICE (USE ONLY)

PERSONNEL

REFERENCE NO. 2

SHEET 2 OF 27

NOTES HOMAN

DATE 6/23/08

ROUTE SR 101

H.C. ROUSOS

WEATHER SUNNY

COUNTY SENECA

R.C. HOMAN

TEMP. 65°

TOWNSHIP CLINTON

SECTION 20

DWG BY MILLER

PID 102817

T 2 N R 15 E

TYPE MONUMENT MAG/WASHER

~~ON SURFACE~~ - BELOW 2"

OFFSET Q PAVEMENT 2.3' LT : ~~RT~~

7.3' TO LT EDGE PAVEMENT


STATION: 85+53

HORZ.DATUM: NAD83 2011

GEOID: 2012A NAVD88


GRID: NORTHING: 531178.113

EASTING: 1786738.205

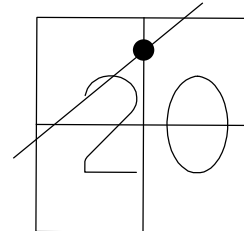

RECORD:
1925 PLAN STA. 0+00
FD IRON BAR
4" DOWN
2/17/83, CL
2" DOWN
6/23/08, DCH
SET MAG/WASHER
9-30-08, DCH
FD MAG/WASHER
REF2
10-11-16, JFO

DIST. 2-2A= 16.52'

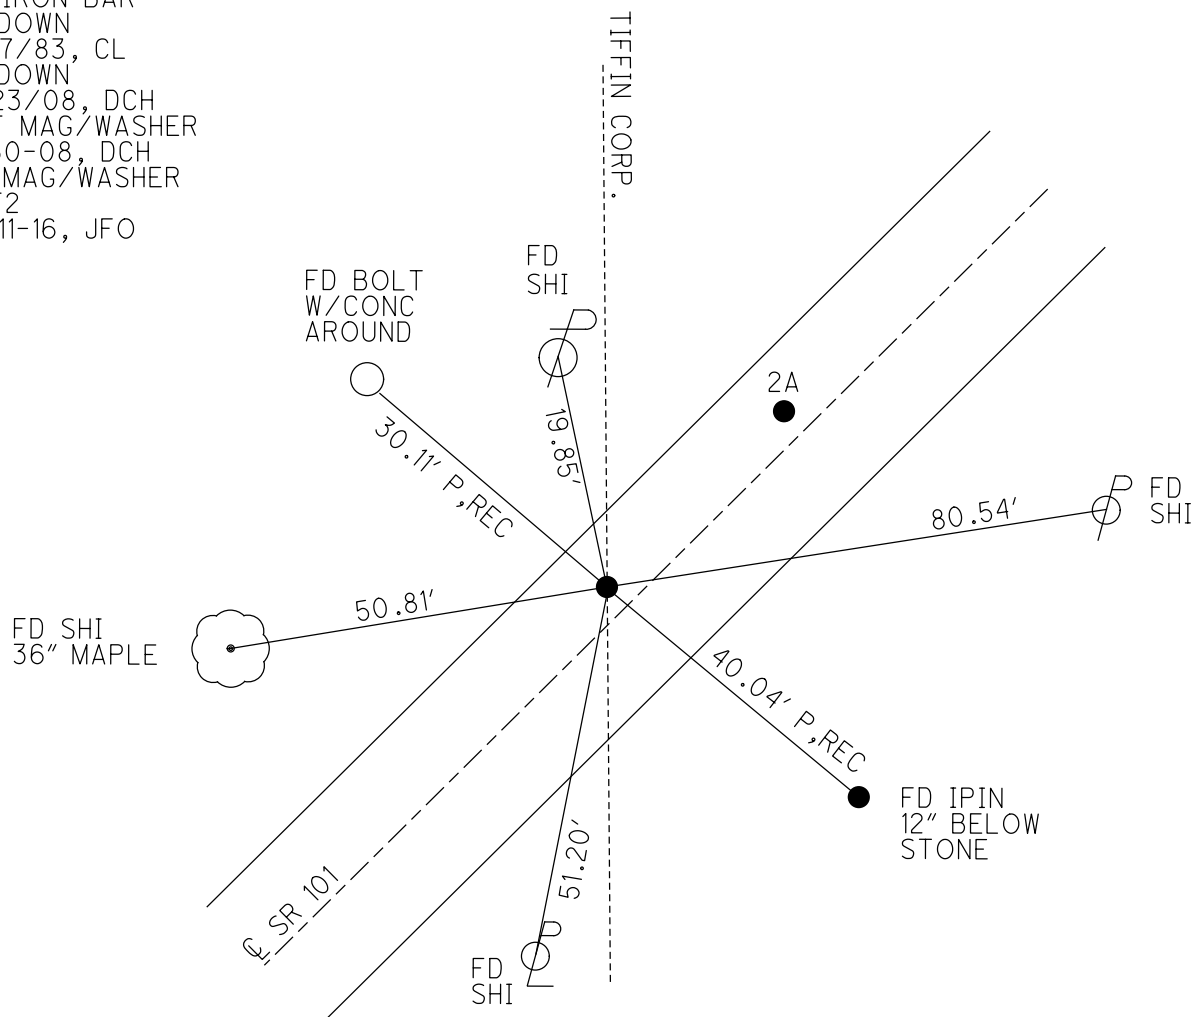

O.D.O.T. DISTRICT 2 SURVEY OFFICE (USE ONLY)

PERSONNEL

REFERENCE NO. 2 A

SHEET 3 OF 27

NOTES RHOADES

DATE 3/15/18

ROUTE SR 101

H.C. O'DONNELL

WEATHER SUNNY

COUNTY SENECA

R.C. SEAMAN

TEMP. 32°

TOWNSHIP CLINTON

SECTION 20

DWG BY MILLER

PID 102817

T 2 N R 15 E

TYPE MONUMENT MAG/WASHER

ON SURFACE - ~~BELOW~~ ON

OFFSET CL PAVEMENT 2.3' LT : ~~RT~~

7.3' TO LT EDGE PAVEMENT


STATION: 85+69.53

HORIZ.DATUM: NAD83 2011

GEOID: 2012A NAVD88


GRID: NORTHING: 531189.526

EASTING: 1786750.311

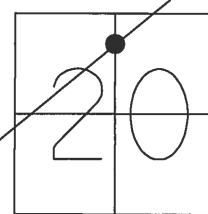

RECORD:
FD R.R.SPIKE
3" DOWN
6/23/08, DCH
SET MAG/WASHER
9-30-08, DCH
FD MAG/WASHER
REFA2
10-11-16, JFO
SET MAG/WASHER
10-10-18, JFO

DIST. 2-2A= 16.52'

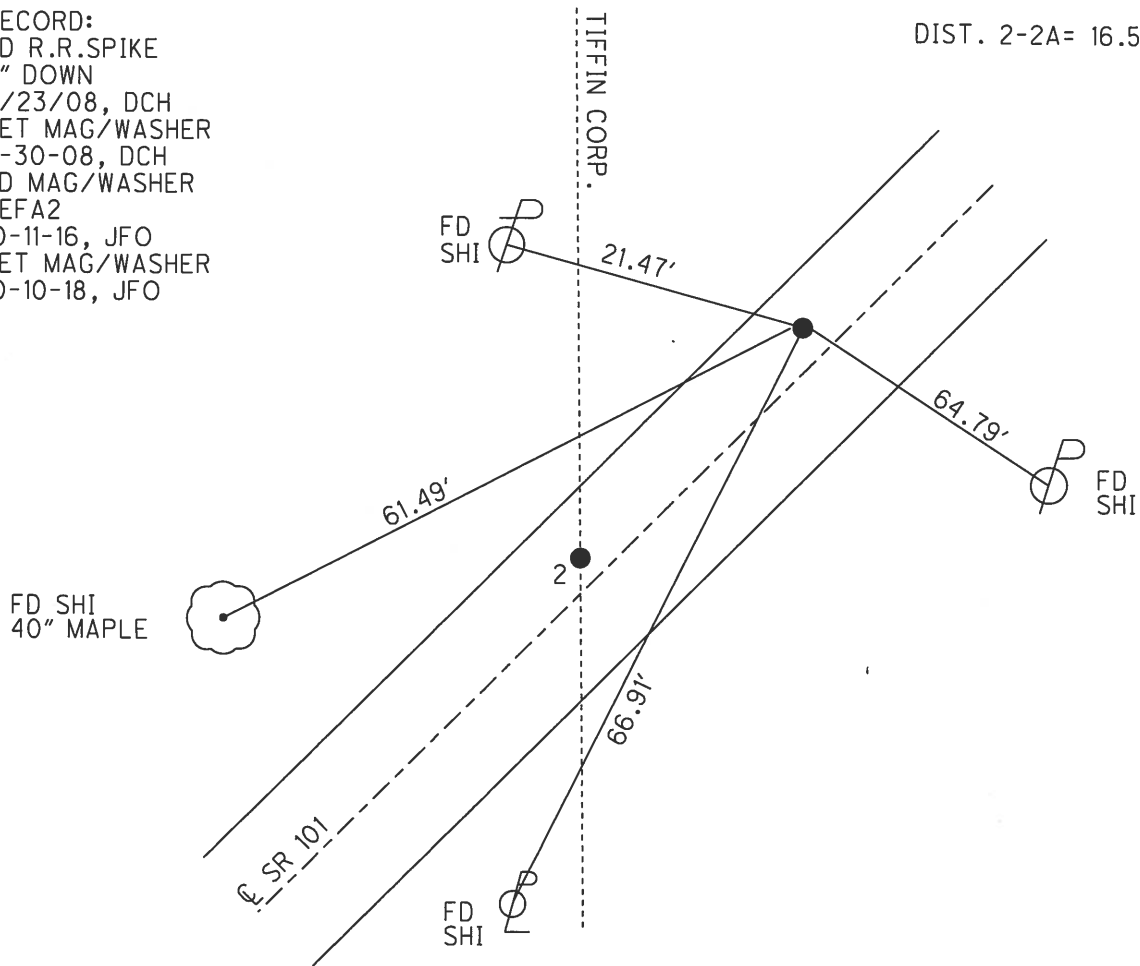

O.D.O.T. DISTRICT 2 SURVEY OFFICE (USE ONLY)

PERSONNEL

REFERENCE NO. 3

SHEET 4 OF 27

NOTES RHOADES

DATE 3/15/18

ROUTE SR 101

H.C. O'DONNELL

WEATHER SUNNY

COUNTY SENECA

R.C. SEAMAN

TEMP. 32°

TOWNSHIP CLINTON

DWG BY MILLER

PID 102817

SECTION 20

T 2 N R 15 E

TYPE MONUMENT HOLE IN CONC APPROACH SLAB

ON SURFACE - ~~BELOW~~ ON

OFFSET CL PAVEMENT ON ~~LT~~ : ~~RT~~

10.2' TO RT EDGE PAVEMENT


STATION: 89+22.4

HORZ.DATUM: NAD83 2011


GEOID: 2012A NAVD88

GRID: NORTHING: 531424.567

EASTING: 1787013.443

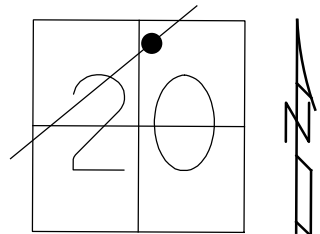

RECORD :
1925 PLAN
STA. 3+53.6
FD IPIN ON CL R/W
14" BELOW
7-29-69
SET MAG/WASHER
9-30-08, DCH
FD HOLE IN CONC
REF3
10-11-16, JFO
SET DRILLHOLE
IN CONC
10-10-18, JFO

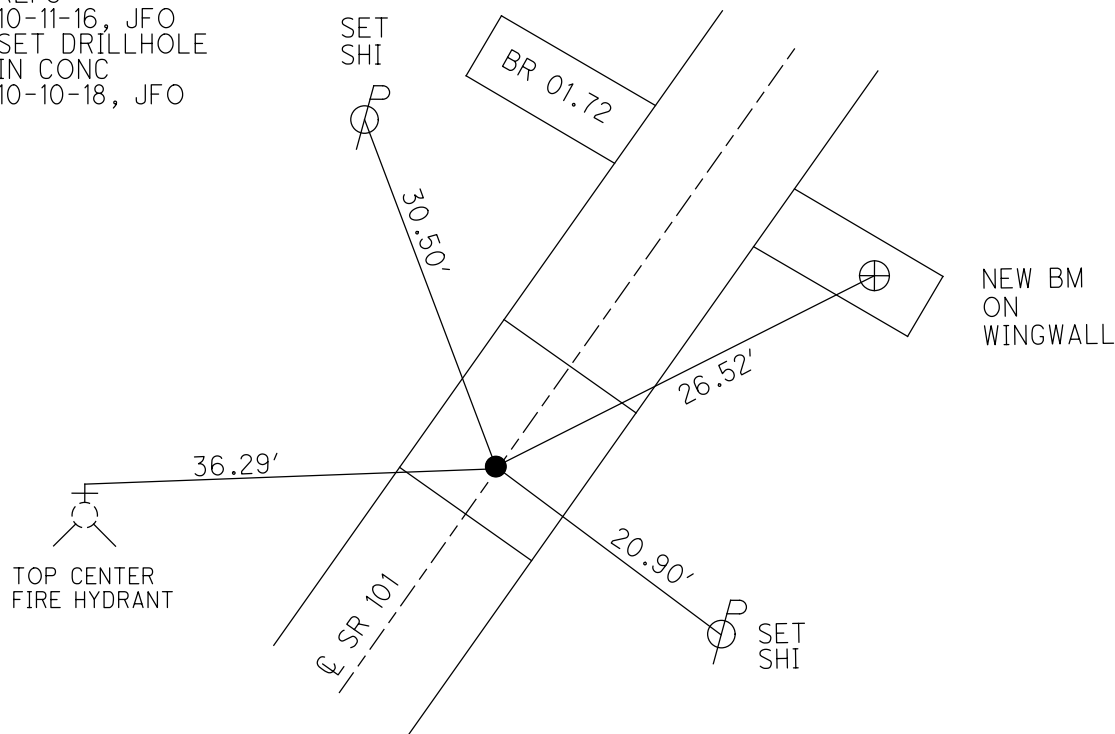

O.D.O.T. DISTRICT 2 SURVEY OFFICE (USE ONLY)

PERSONNEL

REFERENCE NO. 4

SHEET 5 OF 27

NOTES RHOADES

DATE 3/15/18

ROUTE SR 101

H.C. O'DONNELL

WEATHER SUNNY

COUNTY SENECA

R.C. SEAMAN

TEMP. 32°

TOWNSHIP CLINTON

SECTION 20

DWG BY JAMES

PID 102817

T 2 N R 20 E

TYPE MONUMENT MAG/WASHER

ON SURFACE - ~~BELOW~~ ON

OFFSET 1.5' LT : ~~RT~~

10.2' TO RT EDGE PAVEMENT


STATION: 95+18.3

HORZ.DATUM: NAD83 2011


GEOID: 2012A NAVD88

GRID: NORTHING: 531855.530

EASTING: 1787494.627

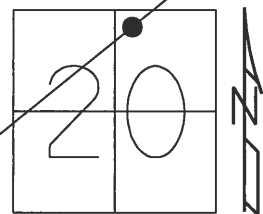

RECORD:
1925 PLAN
STA. 10+00
FD IPIN
2" DOWN
3-4-70
FD P.K./WASHER
6/23/08, DCH
FD MAG/WASHER
REF 4
10-11-16, JFO
SET MAG/WASHER
10-10-18, JFO

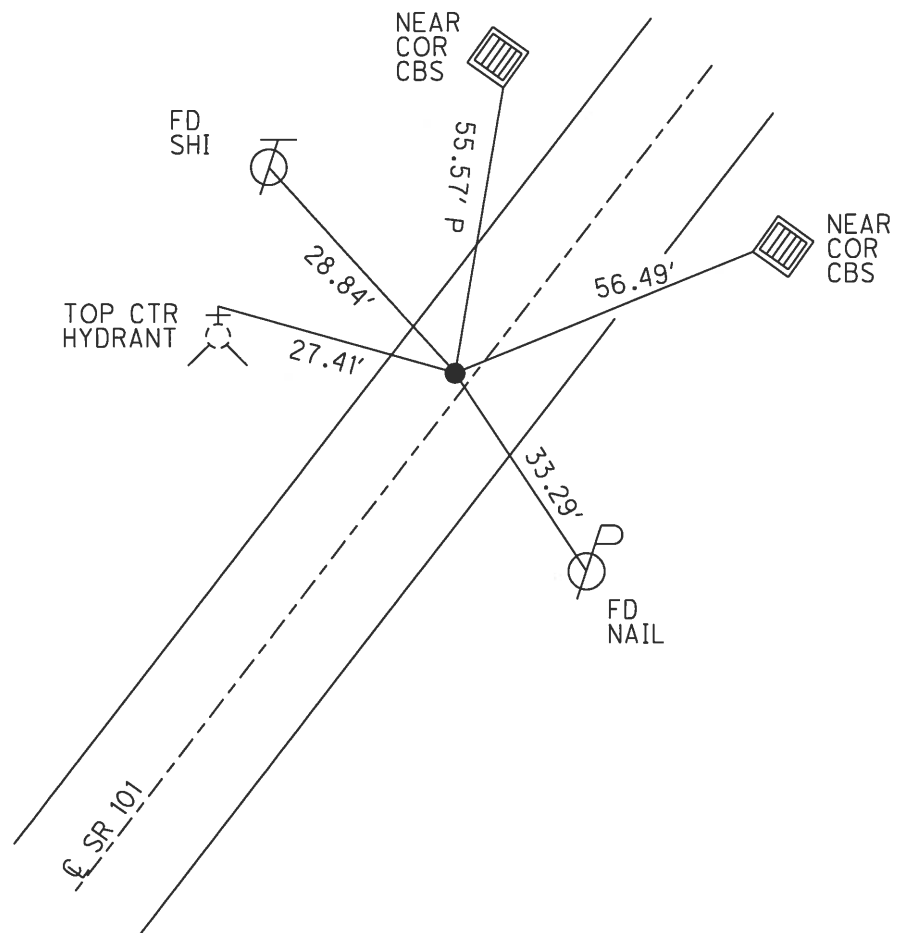

O.D.O.T. DISTRICT 2 SURVEY OFFICE (USE ONLY)

PERSONNEL

REFERENCE NO. 5

SHEET 6 OF 27

NOTES RHOADES

DATE 3/15/18

ROUTE SR 101

H.C. O'DONNELL

WEATHER SUNNY

COUNTY SENECA

R.C. SEAMAN

TEMP. 32°

TOWNSHIP CLINTON

SECTION 20

DWG BY MILLER

PID 102817

T 2 N R 15 E

TYPE MONUMENT MAG/WASHER

ON SURFACE - ~~BELOW~~ ON

OFFSET Q PAVEMENT 0.5' LT : ~~RT~~

10.3' TO RT EDGE PAVEMENT


STATION: 101+68.46

HORIZ.DATUM: NAD83 2011

GEOID: 2012A NAVD88

GRID: NORTHING: 532256.078

EASTING: 1787941.538

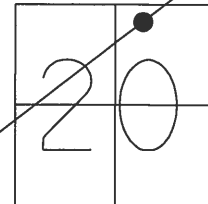

RECORD:

STA. 16+00

IPIN ON Q R/W

3" BELOW

3-4-70

FD P.K.SHANK

6/23/08, DCH

SET MAG/WASHER

10-1-08, DCH


FD MAG/WASHER

REF5

10-11-16, JFO

SET MAG/WASHER

10-10-18, JFO

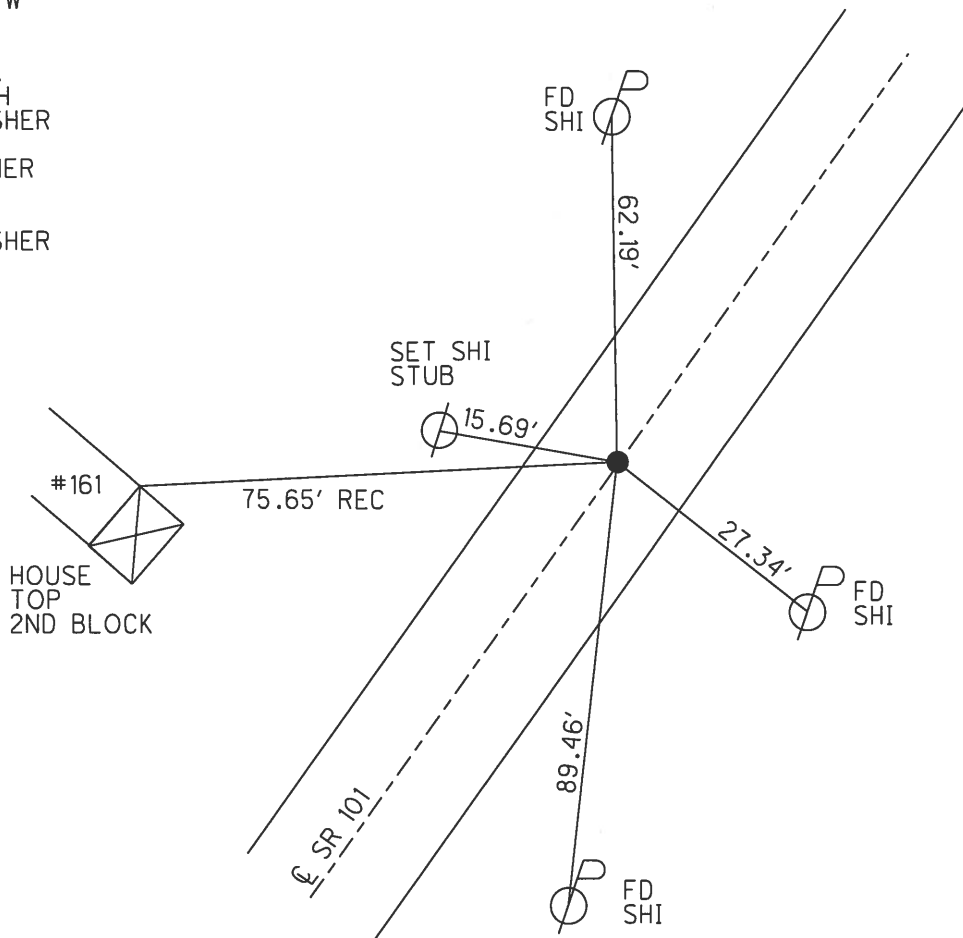

O.D.O.T. DISTRICT 2 SURVEY OFFICE (USE ONLY)

PERSONNEL

REFERENCE NO. 6

SHEET 7 OF 27

NOTES RHOADES

DATE 3/15/18

ROUTE SR 101

H.C. O'DONNELL

WEATHER SUNNY

COUNTY SENECA

R.C. SEAMAN

TEMP. 32°

TOWNSHIP CLINTON

DWG BY MILLER PID 102817

SECTION 20

T 2 N R 15 E

TYPE MONUMENT MAG/WASHER

ON SURFACE - ~~BELOW~~ ON

OFFSET 0.5' LT : ~~RT~~

10.8 TO RT EDGE PAVEMENT


STATION: 111+68

HORZ.DATUM: NAD83 2011

GEOID: 2012A NAVD88

GRID: NORTHING: 532928.851

EASTING: 1788680.794

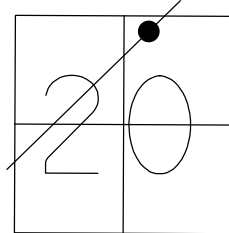

RECORD:

SLM. 26+00

FD IPIN ON $\angle$ R/W

2" BELOW

3-4-70

FD P.K./WASHER

6/23/08, DCH

SET P.K./WASHER

9-30-92

SET MAG/WASHER

9-30-08, DCH

FD P.K.SHANK/WASHER

REF6

10-11-16, JFO


MONBOX INSTALL

FD MONBOX

W/1" IPIN

NEWREF6

11-2-18, JFO

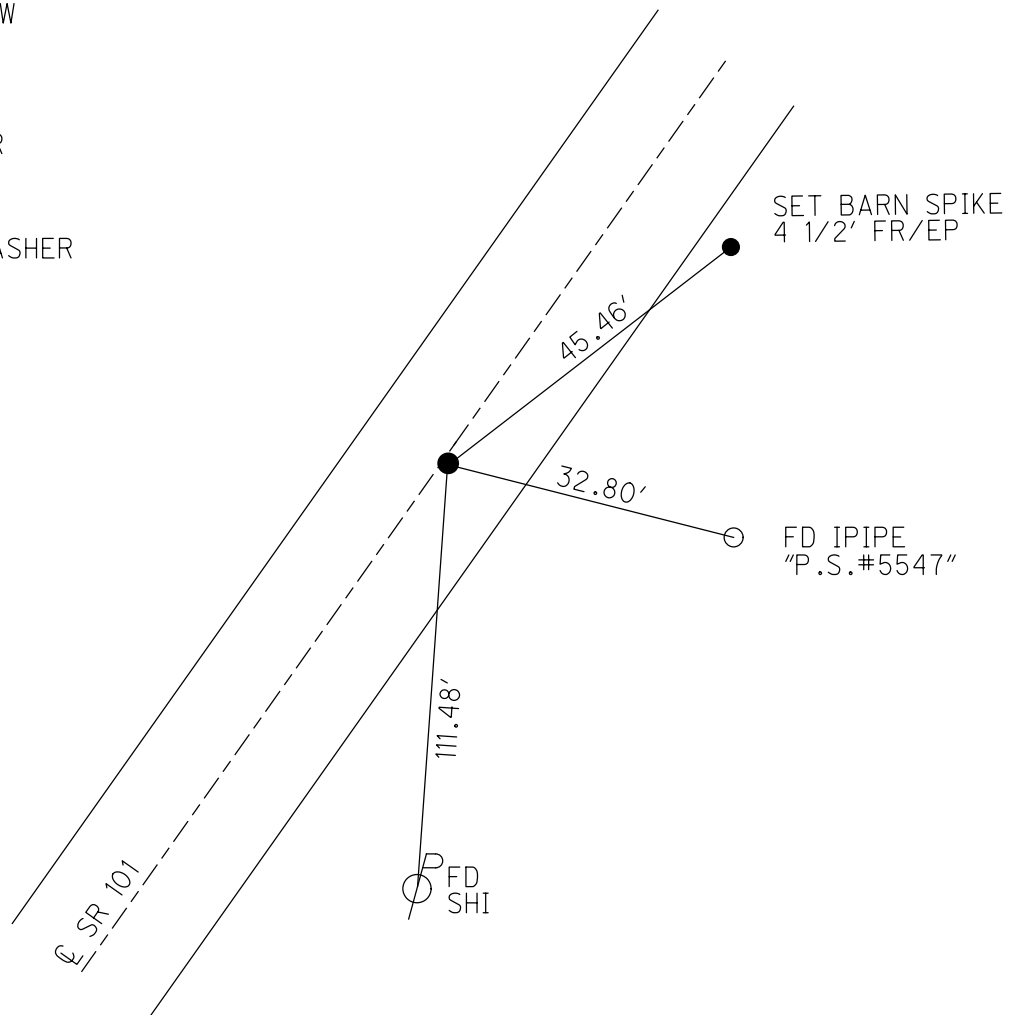

O.D.O.T. DISTRICT 2 SURVEY OFFICE (USE ONLY)

PERSONNEL

REFERENCE NO. 7

SHEET 8 OF 27

NOTES RHOADES

DATE 3/15/18

ROUTE SR 101

H.C. O'DONNELL

WEATHER SUNNY

COUNTY SENECA

R.C. SEAMAN

TEMP. 32°

TOWNSHIP CLINTON

SECTION 17

DWG BY MILLER

PID 102817

T 2 N R 15 E

TYPE MONUMENT MAG/WASHER

ON SURFACE - ~~BELOW~~ ON

OFFSET Q PAVEMENT 1.5' ~~LT~~ : RT

8.1' TO RT EDGE PAVEMENT


STATION: 121+68.05

HORIZ.DATUM: NAD83 2011


GEOID: 2012A NAVD88

GRID: NORTHING: 533599.839

EASTING: 1789422.350

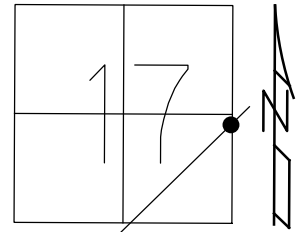

RECORD: P.I.
SR 101 (S.H.#271)
SEC. I-K-O-J
 $\Delta = 0^\circ 49' \text{ LT}$
STA 36+01.06
IPIN ON Q R/W
2" BELOW
3-04-70
SET P.K./WASHER
9-30-92
FD P.K./WASHER
6/23/08, DCH
SET MAG/WASHER
9-30-08, DCH
FD MAG/WASHER
REF7
10-11-16, JFO
MONBOX INSTALL
FD MONBOX
W/1" IPIN
NEWREF7
11-2-18, JFO

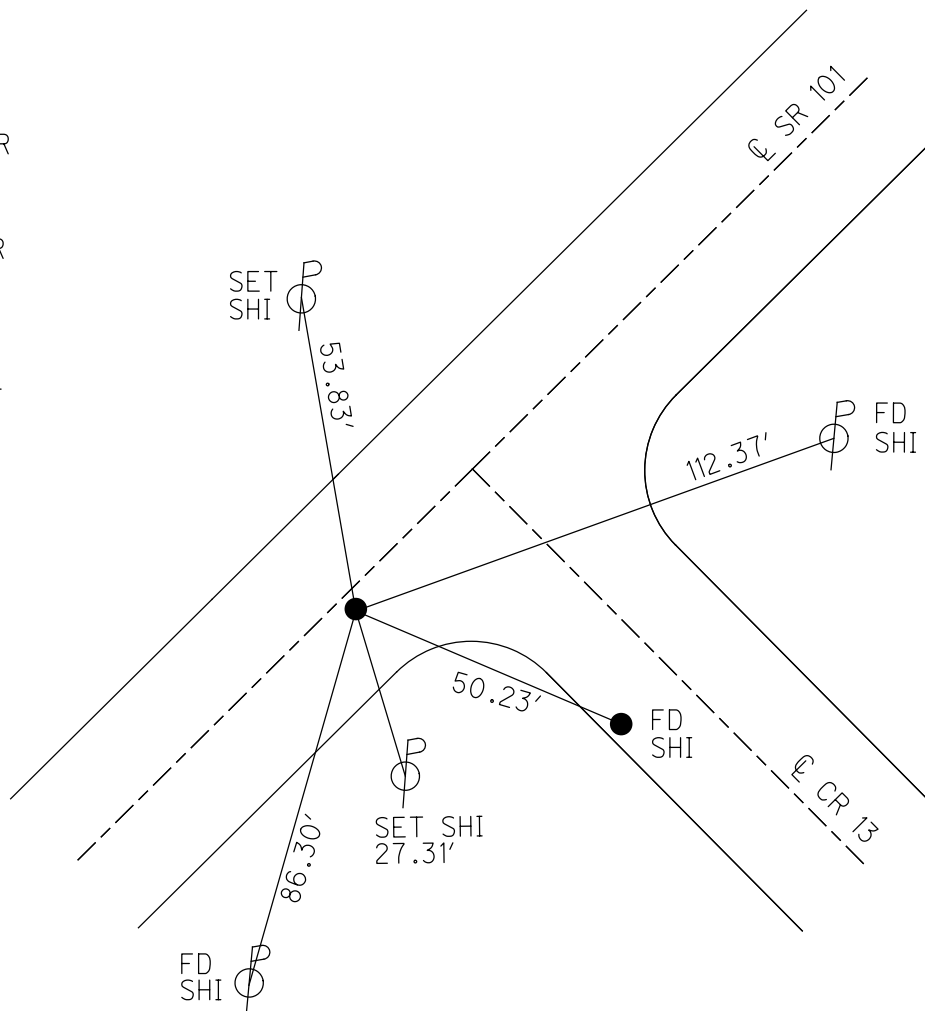

O.D.O.T. DISTRICT 2 SURVEY OFFICE (USE ONLY)

PERSONNEL

REFERENCE NO. 8

SHEET 9 OF 27

NOTES RHOADES

DATE 3/15/18

ROUTE SR 101

H.C. O'DONNELL

WEATHER SUNNY

COUNTY SENECA

R.C. SEAMAN

TEMP. 32°

TOWNSHIP CLINTON

DWG BY MILLER

PID 102817

SECTION 16

T 2 N R 15 E

TYPE MONUMENT MAG/WASHER

ON SURFACE - ~~BELOW~~ ON

OFFSET CL PAVEMENT 0.5' LT : ~~RT~~

10.9 TO RT EDGE PAVEMENT


STATION: 132+54.26

HORZ.DATUM: NAD83 2011


GEOID: 20/2A NAVD88

GRID: NORTHING: 534341.426

EASTING: 1790215.964

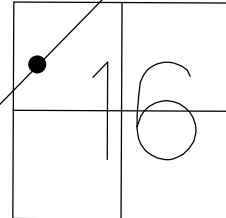

RECORD: P.I.
Δ = 0° 32' LT
STA. 46+88.42
FD HARROW TOOTH
3" BELOW
3-11-70
SET P.K./WASHER
9-30-92
FD P.K./WASHER
6/23/08, DCH
SET MAG/WASHER
10-1-08, DCH
FD MAG/WASHER
REF8
10-11-16, JFO
SET MAG/WASHER
10-10-18, JFO

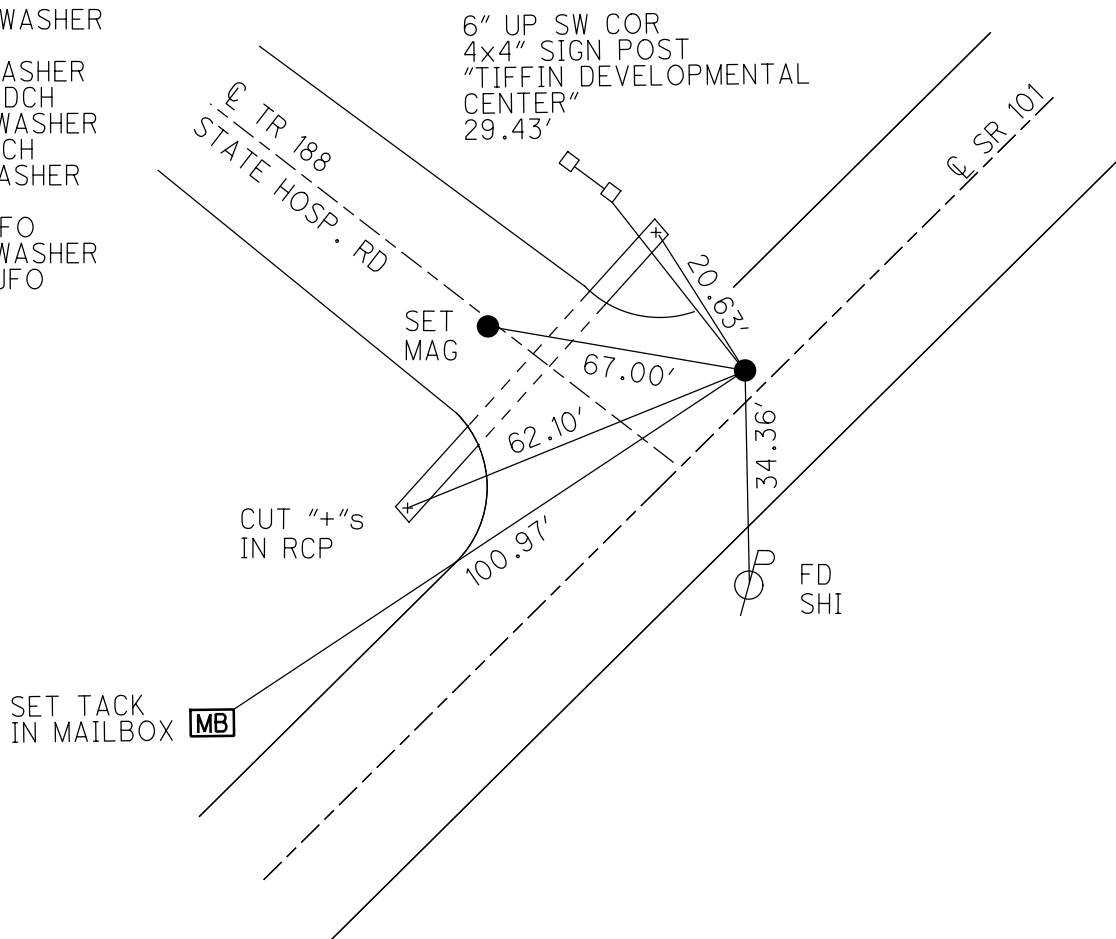

O.D.O.T. DISTRICT 2 SURVEY OFFICE (USE ONLY)

PERSONNEL

REFERENCE NO. 9

SHEET 10 OF 27

NOTES CHENEY

DATE 7/20/92

ROUTE SR 101

H.C. RIPPLE

WEATHER SUNNY

COUNTY SENECA

R.C. BARBOUR

TEMP. 60°

TOWNSHIP CLINTON

GEYMAN

SECTION 16

DWG BY MILLER

PID 102817

T 2 N R 15 E

TYPE MONUMENT IPIN

~~ON SURFACE~~ - BELOW 4"


OFFSET CL PAVEMENT 2.5' ~~LT~~ : RT

7.5' TO RT EDGE PAVEMENT


STATION: 139+78.42

HORIZ.DATUM: _____ GEOID: _____

GRID: NORTHING: _____ EASTING: _____

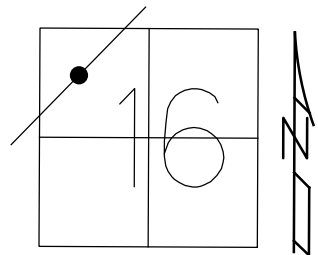

RECORD:
STA. 54+00
FD IPIN ON CL R/W
3" BELOW
3-4-70
FD IPIN
4" DOWN
7/20/92, RIPPLE
SET P.K./WASHER
9-30-92, RIPPLE
DNF
6-23-08, DCH
DNF
10-11-16, JFO

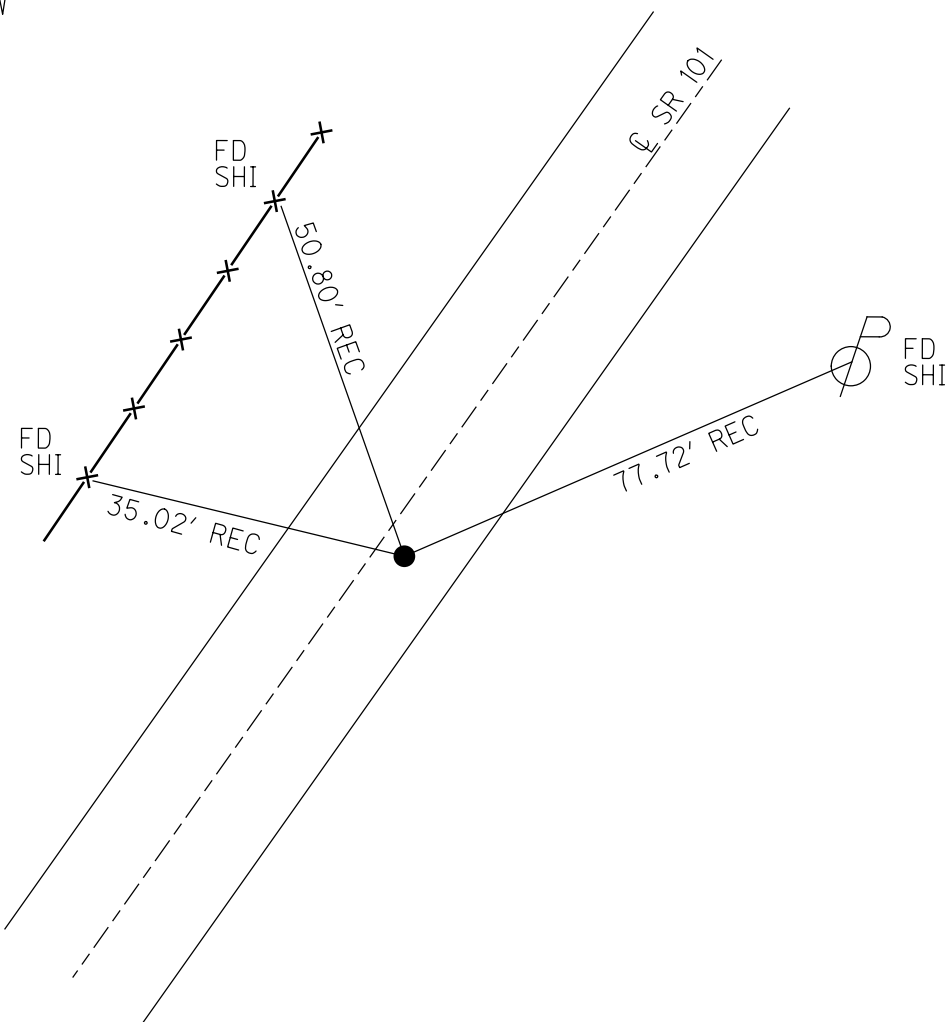

O.D.O.T. DISTRICT 2 SURVEY OFFICE (USE ONLY)

PERSONNEL

REFERENCE NO. 10

SHEET 11 OF 27

NOTES SEAMAN

DATE 3/22/18

ROUTE SR 101

H.C. O'DONNELL

WEATHER SUNNY

COUNTY SENECA

R.C. SEAMAN

TEMP. 32°

TOWNSHIP CLINTON

SECTION 16

DWG BY MILLER

PID 102817

T 2 N R 15 E

TYPE MONUMENT MAG/WASHER

ON SURFACE - ~~BELOW~~ ON

OFFSET 11.1' TO RT EDGE PAVEMENT


STATION: 143+28.42

HORZ.DATUM: NAD83 2011

GEOID: 2012A NAVD88


GRID: NORTHING: 535086.656

EASTING: 1790989.371

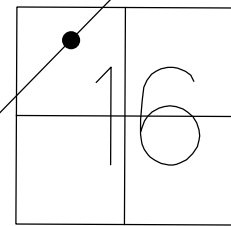

RECORD:

STA. 57+50
FD IPIN ON $\angle$ R/W
2" BELOW
3-4-70
SET P.K./WASHER
9-30-92
FD P.K./WASHER
6/24/08, DCH
SET MAG/WASHER
9-30-08, DCH
FD MAG/WASHER
REF10
10-11-16, JFO
SET MAG/WASHER
10-10-18, JFO

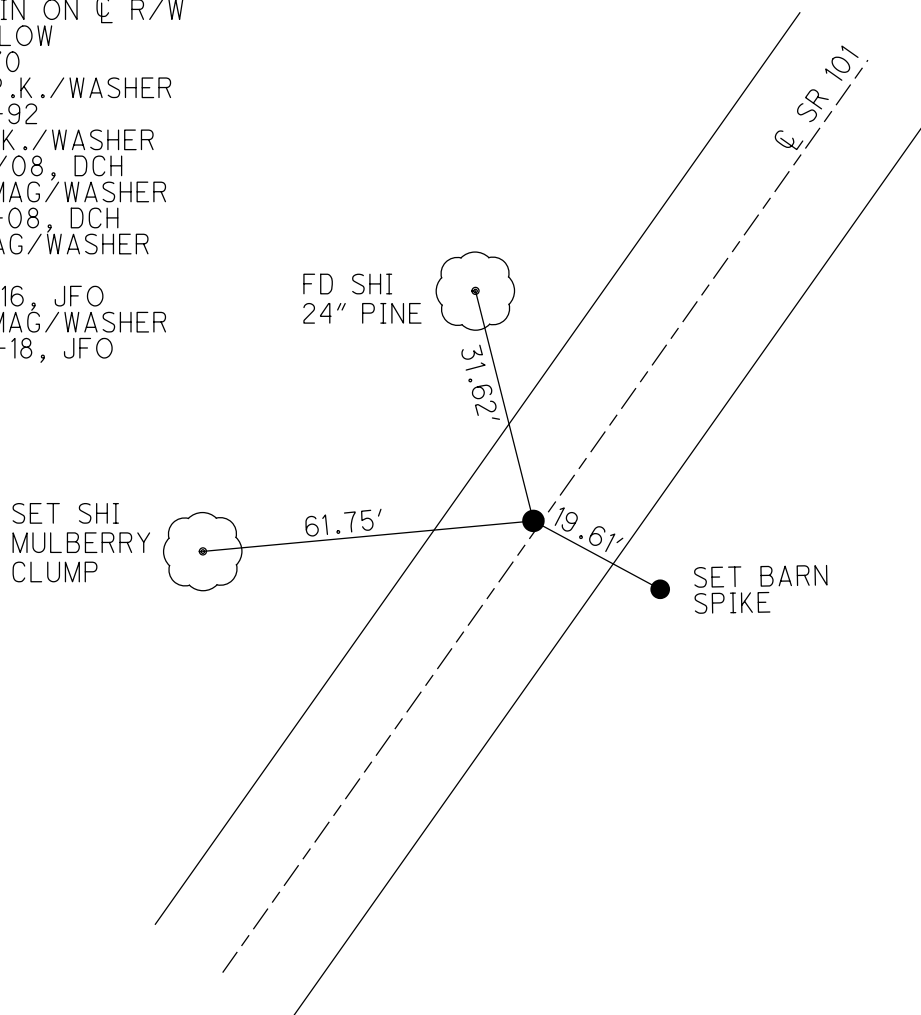

O.D.O.T. DISTRICT 2 SURVEY OFFICE (USE ONLY)

PERSONNEL

REFERENCE NO. 11

SHEET 12 OF 27

NOTES SEAMAN

DATE 3/22/18

ROUTE SR 101

H.C. O'DONNELL

WEATHER SUNNY

COUNTY SENECA

R.C. SEAMAN

TEMP. 34°

TOWNSHIP CLINTON

SECTION 16

DWG BY MILLER

PID 102817

T 2 N R 15 E

TYPE MONUMENT MAG/WASHER

ON SURFACE - ~~BELOW~~ ON

OFFSET 6.6' Q PAVEMENT 3.5' LT : ~~RT~~

6.6' TO LT EDGE PAVEMENT


STATION: 152+67.03

HORZ.DATUM: NAD83 2011


GEOID: 2012A NAVD88

GRID: NORTHING: 535724.470

EASTING: 1791677.976

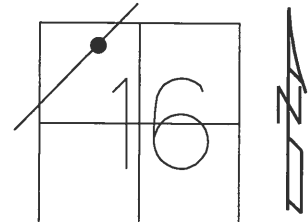


RECORD: P.T.
STA. 67+27.31 SR 101
FD R.R. SPIKE
2" BELOW
3-11-70
SET P.K./WASHER
9-30-92
FD SM.R.R.SPIKE
1.5" DOWN
6/24/08, DCH
SET MAG/WASHER
9-30-08, DCH
FD MAG SHANK
REF11
10-11-18, JFO
SET MAG/WASHER
10-10-18, JFO

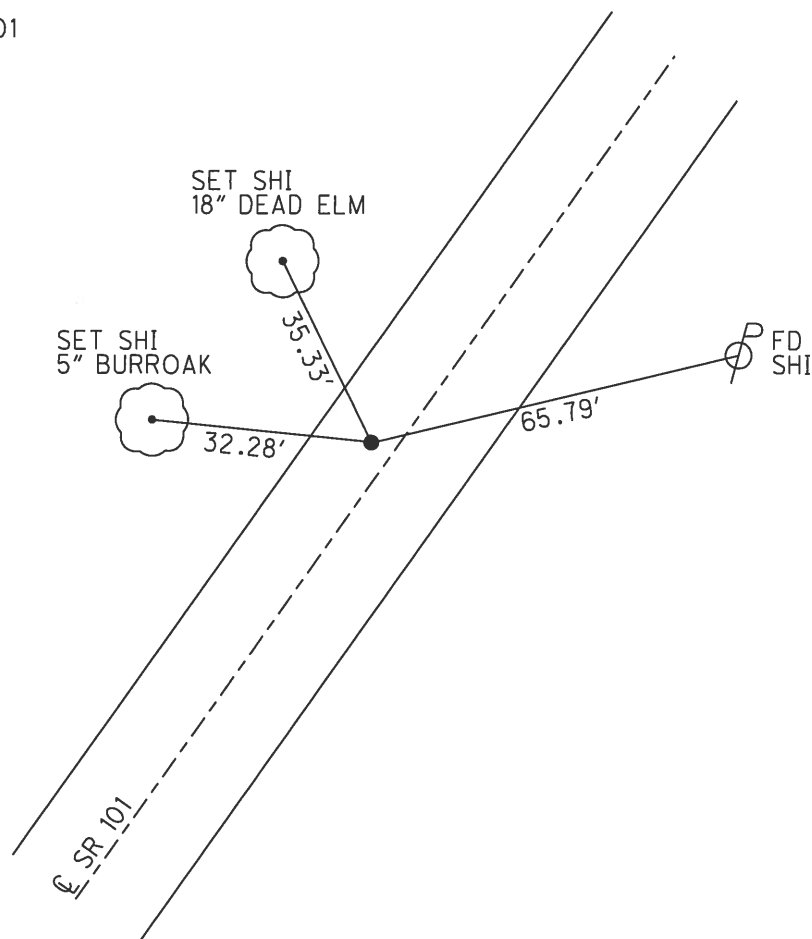


O.D.O.T. DISTRICT 2 SURVEY OFFICE (USE ONLY)

PERSONNEL	REFERENCE NO. <u>12</u>	SHEET <u>13</u> OF <u>27</u>
NOTES SEAMAN	DATE <u>3/22/18</u>	ROUTE <u>SR 101</u>
H.C. <u>O'DONNELL</u>	WEATHER <u>SUNNY</u>	COUNTY <u>SENECA</u>
R.C. <u>SEAMAN</u>	TEMP. <u>35°</u>	TOWNSHIP <u>CLINTON</u>
		SECTION <u>16</u>
DWG BY <u>MILLER</u>	PID <u>102817</u>	T <u>2</u> N R <u>15</u> E
TYPE MONUMENT <u>MAG/WASHER</u>		
ON SURFACE - BELOW <u>ON</u>		
OFFSET <u>Q</u> PAVEMENT <u>2'</u> LT : RT		
<u>7.9'</u> TO RT EDGE PAVEMENT		
STATION: <u>158+74.84</u>		
HORZ. DATUM: <u>NAD83 2011</u>		GEOID: <u>2012A NAVD88</u>
GRID: NORTHING: <u>536119.023</u>		EASTING: <u>1792140.317</u>

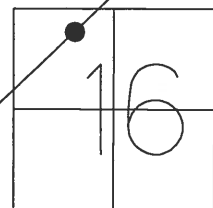

RECORD: P.I.
 STA. 73+11.20
 FD IPIN
 2" BELOW
 $\Delta = 0^\circ 37' \text{ LT}$
 3-11-70
 SET P.K./WASHER
 9-30-92
 SET MAG/WASHER
 6-24-08, DCH
 FD MAG/WASHER
 REF12
 10-11-16, JFO
 SET MAG/WASHER
 10-10-18, JFO

DIST. 12-13= 91.50'

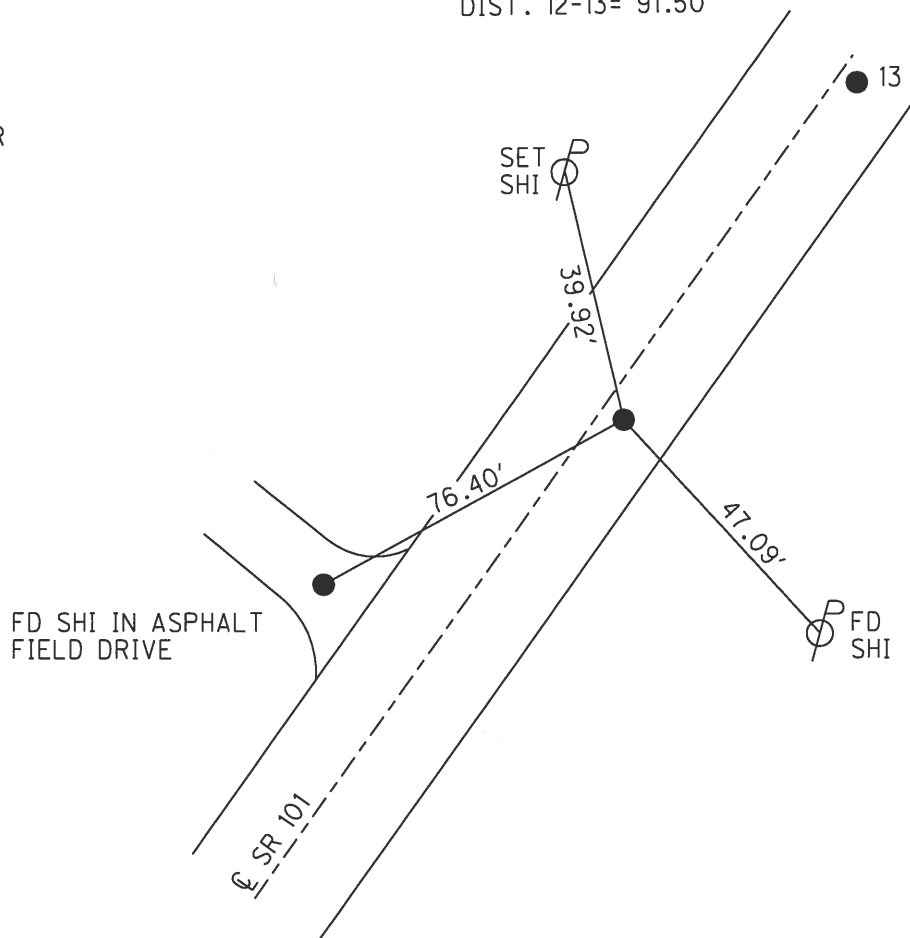

O.D.O.T. DISTRICT 2 SURVEY OFFICE (USE ONLY)

PERSONNEL

REFERENCE NO. 13

SHEET 14 OF 27

NOTES SEAMAN

DATE 3/22/18

ROUTE SR 101

H.C. O'DONNELL

WEATHER SUNNY

COUNTY SENECA

R.C. SEAMAN

TEMP. 35°

TOWNSHIP CLINTON

SECTION 16

DWG BY MILLER PID 102817

T 2 N R 15 E

TYPE MONUMENT MAG/WASHER

ON SURFACE - ~~BELOW~~ ON

OFFSET Q PAVEMENT 2' ~~LT~~ : RT

9.2' TO RT EDGE PAVEMENT


STATION: 159+66.3

HORZ.DATUM: NAD83 2011


GEOID: 2012A NAVD88

GRID: NORTHING: 536179.347

EASTING: 1792209.059

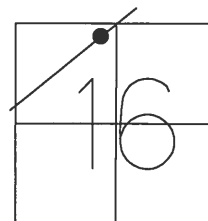

RECORD:
R.R. SPIKE
SET P.K./WASHER
9-30-92
FD P.K.NAIL
6/24/08, DCH
SET MAG/WASHER
10-1-08, DCH
FD MAG/WASHER
10-11-16, JFO
SET MAG/WASHER
10-10-18, JFO

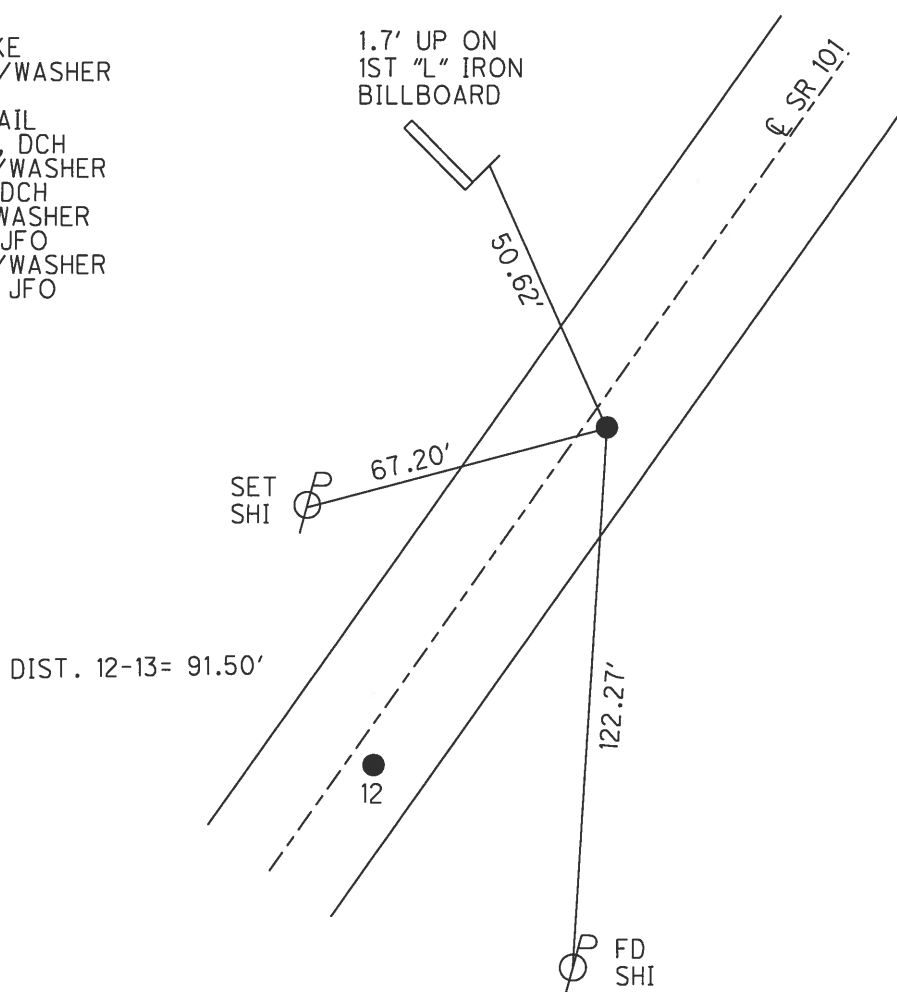

O.D.O.T. DISTRICT 2 SURVEY OFFICE (USE ONLY)

PERSONNEL

REFERENCE NO. 14

SHEET 15 OF 27

NOTES SEAMAN

DATE 3/22/18

ROUTE SR 101

H.C. O'DONNELL

WEATHER SUNNY

COUNTY SENECA

R.C. SEAMAN

TEMP. 40°

TOWNSHIP CLINTON

SECTION 16

DWG BY MILLER

PID 102817

T 2 N R 15 E

TYPE MONUMENT MAG/WASHER

ON SURFACE - ~~BELOW~~ ON

OFFSET Q PAVEMENT 1.5' LT : ~~RT~~

8.6' TO LT EDGE PAVEMENT


STATION: 171+58.75

HORZ. DATUM: NAD83 2011


GEOID: 2012A NAVD88

GRID: NORTHING: 536970.433

EASTING: 1793101.321

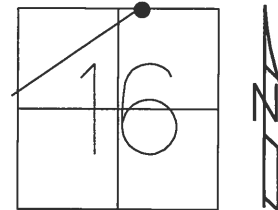

RECORD: P.I.
 $\Delta = 0^\circ 38' \text{ RT}$
 STA 85+96
 3-11-70
 SET P.K./WASHER
 9-30-92
 FD MINE SPIKE
 2" DOWN
 6/24/08, DCH
 SET MAG/WASHER
 10-1-08, DCH
 FD MAG/WASHER
 REF14
 10-11-16, JFO
 SET MAG/WASHER
 10-9-18, JFO

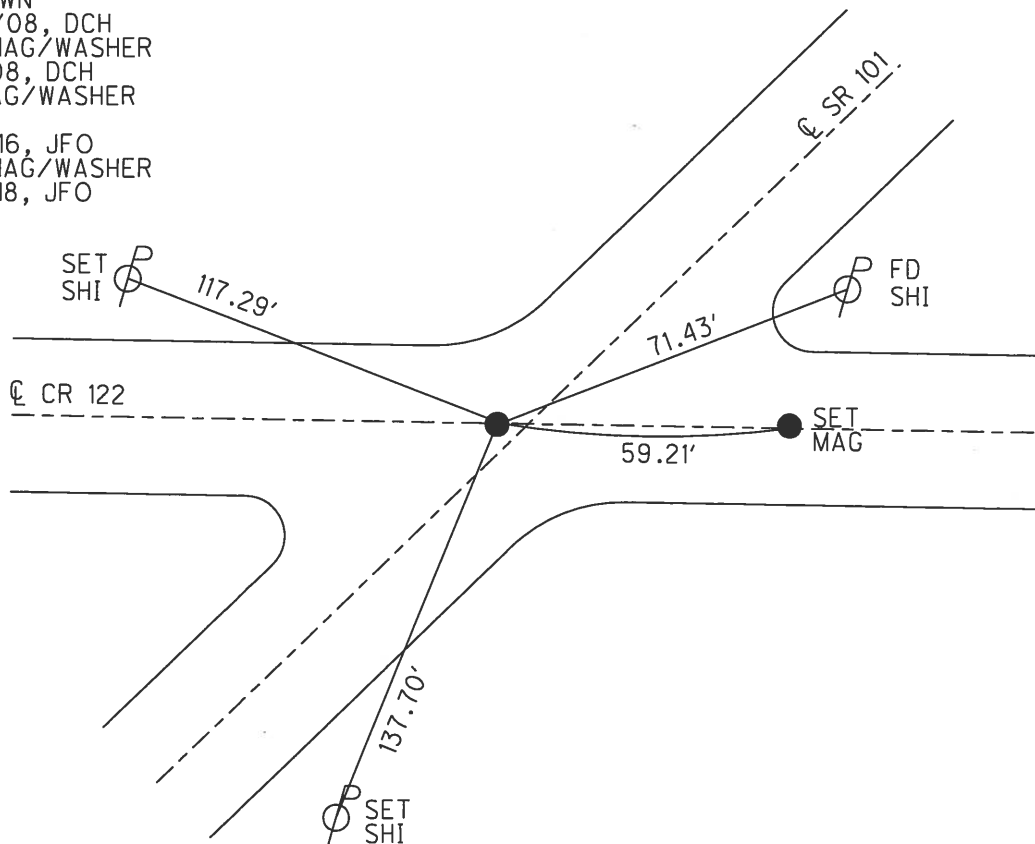

O.D.O.T. DISTRICT 2 SURVEY OFFICE (USE ONLY)

PERSONNEL

REFERENCE NO. 15

SHEET 16 OF 27

NOTES SEAMAN

DATE 3/22/18

ROUTE SR 101

H.C. O'DONNELL

WEATHER SUNNY

COUNTY SENECA

R.C. SEAMAN

TEMP. 40°

TOWNSHIP CLINTON

SECTION 9

DWG BY MILLER

PID 102817

T 2 N R 15 E

TYPE MONUMENT MAG/WASHER

~~ON SURFACE~~ - BELOW 3"

OFFSET Q PAVEMENT 0.7' ~~LT~~ : RT

10.1' TO RT EDGE PAVEMENT


STATION: 189+61.91

HORZ.DATUM: NAD83 2011

GEOID: 2012A NAVD88

GRID: NORTHING: 538150.587

EASTING: 1794464.646

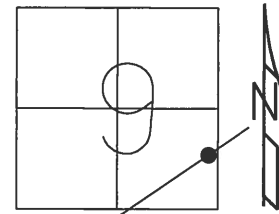

RECORD:

STA. 104+00

FD IPIN

2" BELOW

3-11-70

SET P.K./WASHER

9-30-92

FD P.K./WASHER

3" DOWN

6/24/08, DCH

SET MAG/WASHER


10-14-08, DCH

FD MAG/WASHER

10-11-16, JFO

SET MAG/WASHER

10-9-18, JFO

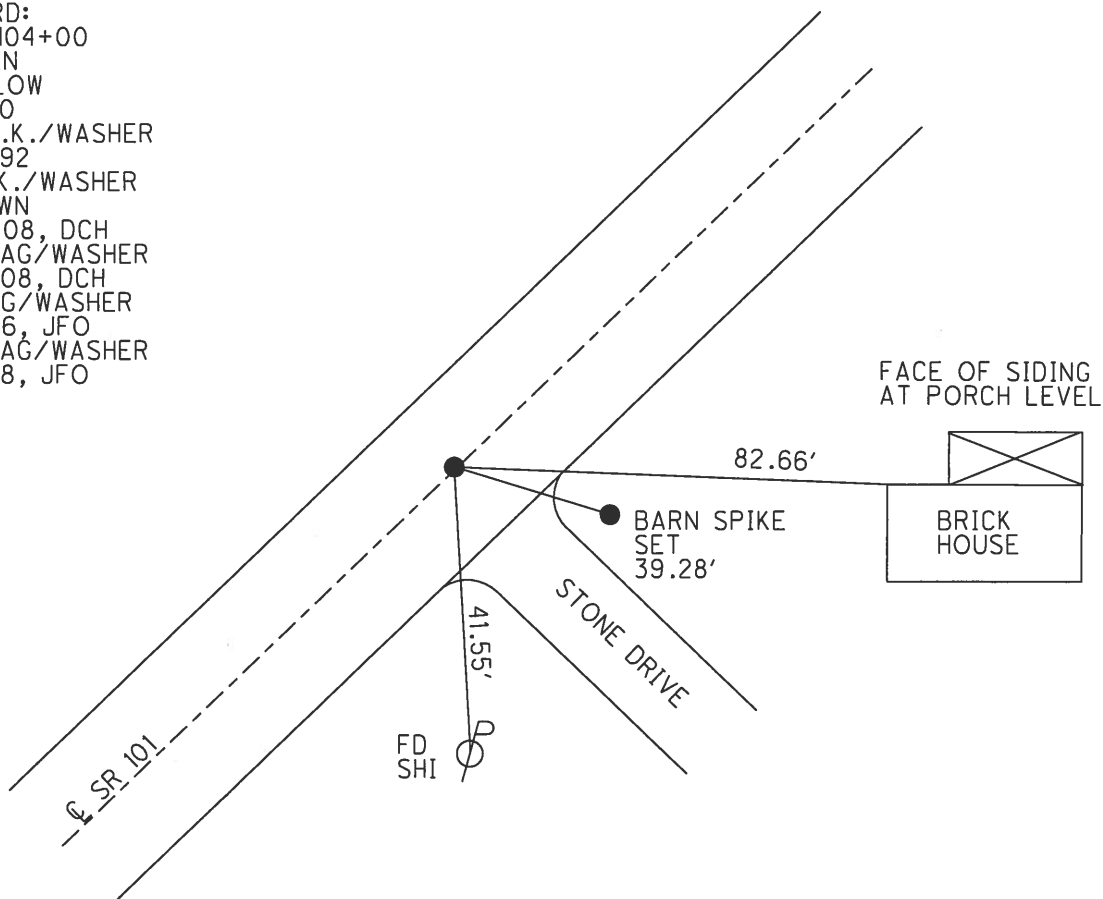

O.D.O.T. DISTRICT 2 SURVEY OFFICE (USE ONLY)

PERSONNEL

REFERENCE NO. 16

SHEET 17 OF 27

NOTES RHOADES

DATE 3/23/18

ROUTE SR 101

H.C. O'DONNELL

WEATHER SUNNY

COUNTY SENECA

R.C. SEAMAN

TEMP. 30°

TOWNSHIP CLINTON

DWG BY MILLER

PID 102817

SECTION 10

T 2 N R 15 E

TYPE MONUMENT MAG/WASHER

ON SURFACE - ~~BELOW~~ ON

OFFSET Q PAVEMENT 1' LT : ~~RT~~

9' TO LT EDGE PAVEMENT



STATION: 198+65.02

HORIZ.DATUM: NAD83 2011

GEOID: 2012A NAVD88

GRID: NORTHING: 538746.313

EASTING: 1795143.397

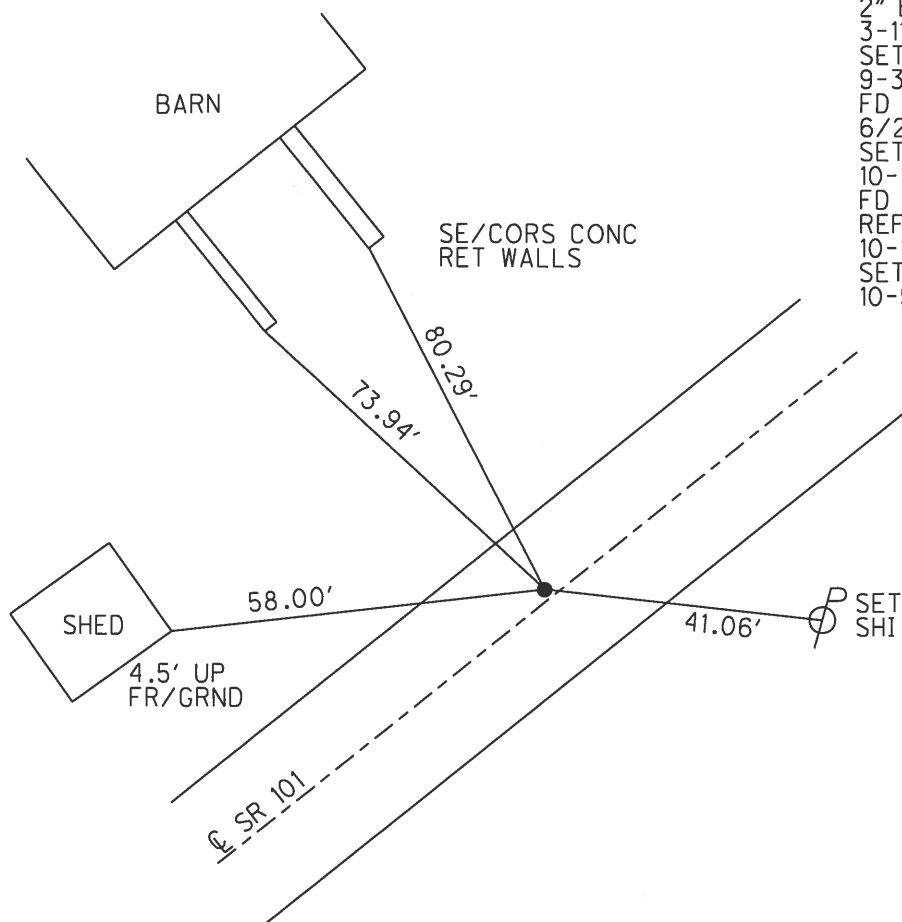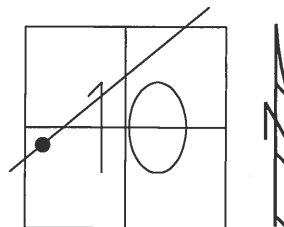

RECORD:
STA. 113+00
IPIN
2" BELOW
3-11-70
SET P.K./WASHER
9-30-92
FD P.K./WASHER
6/24/08, DCH
SET MAG/WASHER
10-14-08, DCH
FD MAG/WASHER
REF16
10-11-16, JFO
SET MAG/WASHER
10-9-18, JFO

O.D.O.T. DISTRICT 2 SURVEY OFFICE (USE ONLY)

PERSONNEL

REFERENCE NO. 17

SHEET 18 OF 27

NOTES RHOADES

DATE 3/23/18

ROUTE SR 101

H.C. O'DONNELL

WEATHER SUNNY

COUNTY SENECA

R.C. SEAMAN

TEMP. 30°

TOWNSHIP CLINTON

SECTION 10

DWG BY MILLER

PID 102817

T 2 N R 15 E

TYPE MONUMENT MAG/WASHER

ON SURFACE - ~~BELOW~~ ON

OFFSET Q PAVEMENT 5' LT : ~~RT~~

5.1' TO LT EDGE PAVEMENT


STATION: 206+12.65

HORIZ.DATUM: NAD83 2011

GEOID: 2012A NAVD88

GRID: NORTHING: 539235.396

EASTING: 1795708.864

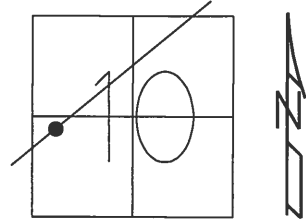

RECORD:

STA. 120+39

R.R. SPIKE ON Q R/W

2" BELOW

3-11-70

SET P.K./WASHER

9-30-92

FD P.K.NAIL

6/24/08, DCH

SET MAG/WASHER

10-14-08, DCH


FD MAG/WASHER

REF17

10-11-16, JFO

SET MAG/WASHER

10-9-18, JFO

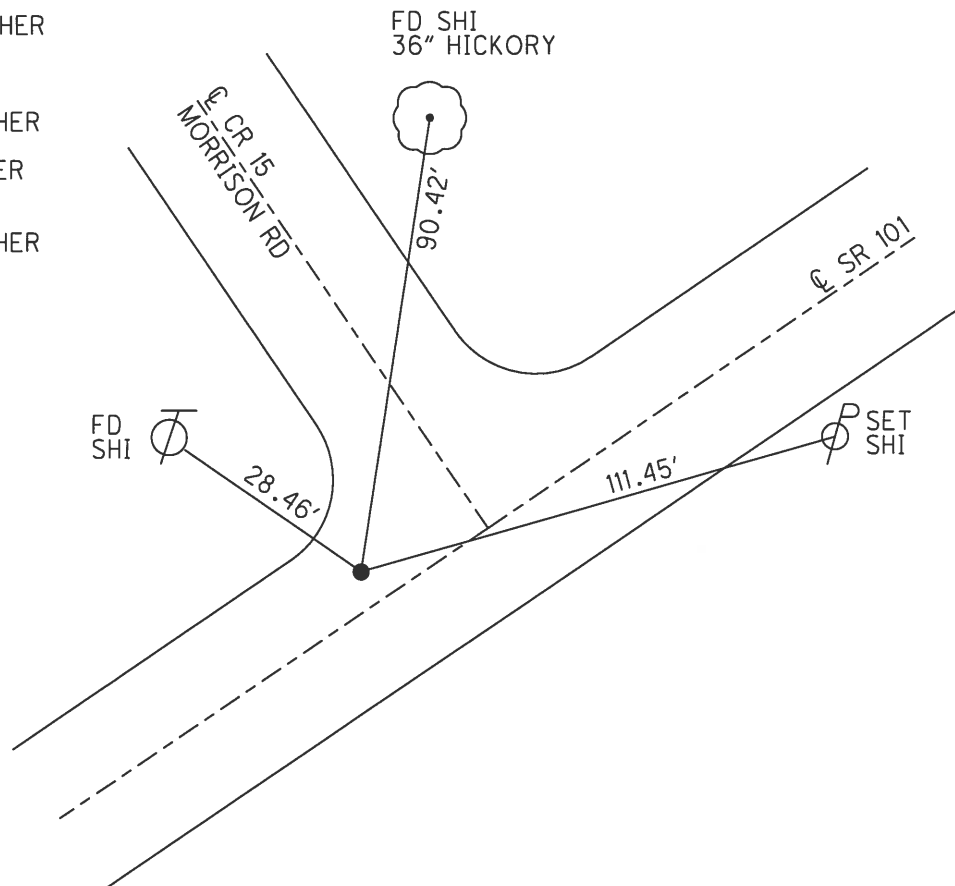

O.D.O.T. DISTRICT 2 SURVEY OFFICE (USE ONLY)

PERSONNEL

REFERENCE NO. 18

SHEET 19 OF 27

NOTES RHOADES

DATE 3/23/18

ROUTE SR 101

H.C. O'DONNELL

WEATHER SUNNY

COUNTY SENECA

R.C. RHOADES

TEMP. 30°

TOWNSHIP CLINTON

DWG BY MILLER

PID 102817

SECTION 10

T 2 N R 15 E

TYPE MONUMENT 1" IPIN

~~ON SURFACE~~ - BELOW 6"

OFFSET 6.5' TO RT EDGE PAVEMENT


STATION: 213+14.40

HORZ. DATUM: NAD83 2011

GEOID: 2012A NAVD88

GRID: NORTHING: 539584.263

EASTING: 1796318.298

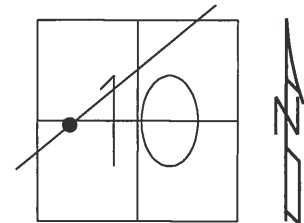

RECORD: P.I.
STA. 127+53
1" IPIN ON CL R/W
3-11-70
FD 1" IPIN
6" DOWN
6/24/08, DCH
4" DOWN
REF18
10-11-16, JFO

SET SHI
18" CEDAR

FD
SHI 43.36'

95.93' P

42.95' P

MB

SET TACK
MB POST
1 1/2' UP

CL SR 101

O.D.O.T. DISTRICT 2 SURVEY OFFICE (USE ONLY)

PERSONNEL

REFERENCE NO. 19

SHEET 20 OF 27

NOTES RHOADES

DATE 3/23/18

ROUTE SR 101

H.C. O'DONNELL

WEATHER SUNNY

COUNTY SENECA

R.C. SEAMAN

TEMP. 30°

TOWNSHIP CLINTON

SECTION 10

DWG BY MILLER

PID 102817

T 2 N R 15 E

TYPE MONUMENT MAG/WASHER

ON SURFACE - ~~BELOW~~ ON

OFFSET CL PAVEMENT 3.5' ~~LT~~ : RT

7' TO RT EDGE PAVEMENT


STATION: 229+99.49

HORZ. DATUM: NAD83 2011


GEOID: 2012A NAVD88

GRID: NORTHING: 540820.684

EASTING: 1797467.177

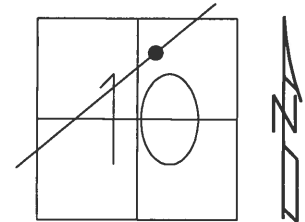

RECORD: 3-12-69
STA. 144+34
R.R. SPIKE ON CL R/W
3-12-69
FD R.R. SPIKE
3" BELOW
7-20-92
SET P.K./WASHER
10-1-92
FD P.K. NAIL
6/24/08, DCH
SET MAG/WASHER
10-14-08, DCH
FD MAG/WASHER
REF19
10-11-16, JFO
SET MAG/WASHER
10-9-18, JFO

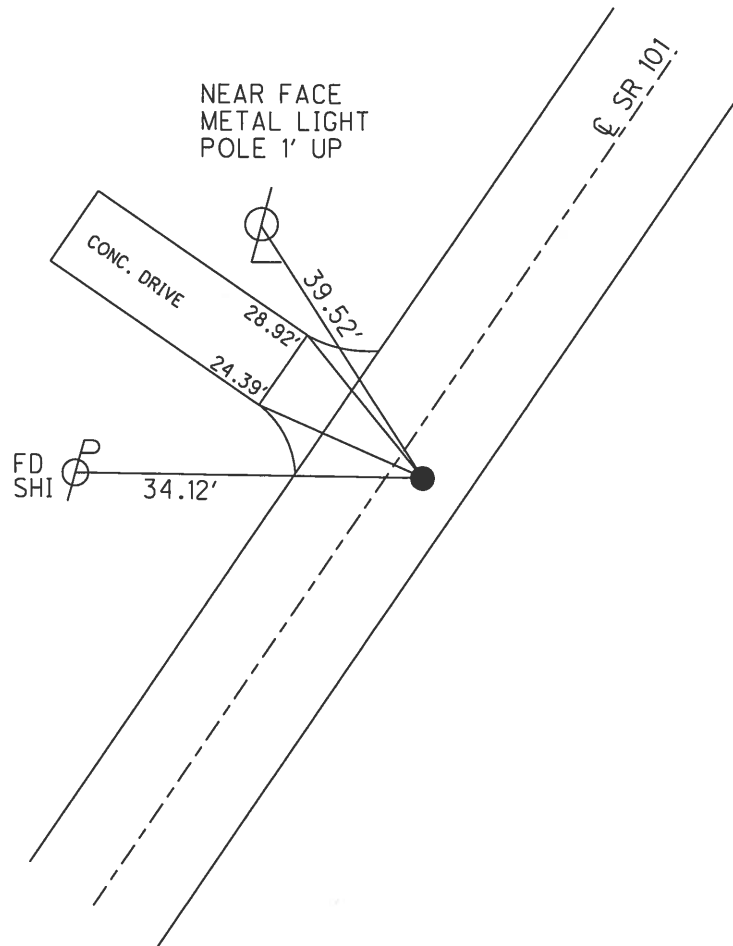

O.D.O.T. DISTRICT 2 SURVEY OFFICE (USE ONLY)

PERSONNEL

REFERENCE NO. 20

SHEET 21 OF 27

NOTES RHOADES

DATE 3/23/18

ROUTE SR 101

H.C. O'DONNELL

WEATHER SUNNY

COUNTY SENECA

R.C. SEAMAN

TEMP. 30°

TOWNSHIP CLINTON

SECTION 10

DWG BY MILLER

PID 102817

T 2 N R 15 E

TYPE MONUMENT MAG/WASHER

ON SURFACE - ~~BELOW~~ ON

OFFSET Q PAVEMENT 2' ~~LT~~ : RT

8' TO RT EDGE PAVEMENT


STATION: 241+64.28

HORIZ.DATUM: NAD83 2011


GEOID: 2012A NAVD88

GRID: NORTHING: 541720.900

EASTING: 1798206.340

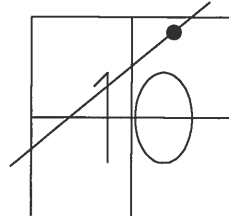

RECORD :
STA.155+98 = 0+00
SEC.I SEC.K
IPIN ON Q R/W
8" BELOW
3-12-69
SET P.K./WASHER
10-1-92
FD P.K./WASHER
6/24/08, DCH
SET MAG/WASHER
10-14-08, DCH
FD MAG/WASHER
REF20
10-11-16, JFO
SET MAG/WASHER
10-9-18, JFO

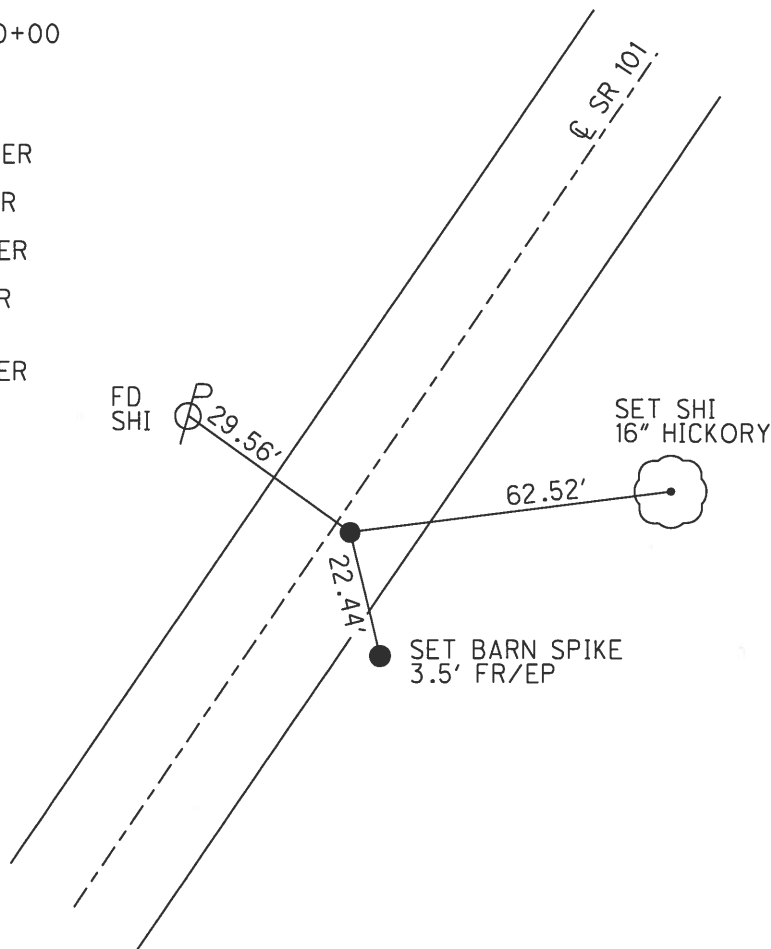

O.D.O.T. DISTRICT 2 SURVEY OFFICE (USE ONLY)

PERSONNEL

REFERENCE NO. 21

SHEET 22 OF 27

NOTES RHODES

DATE 3/23/18

ROUTE SR 101

H.C. O'DONNELL

WEATHER SUNNY

COUNTY SENECA

R.C. SEAMAN

TEMP. 33°

TOWNSHIP CLINTON

SECTION 10

DWG BY MILLER

PID 102817

T 2 N R 15 E

TYPE MONUMENT 5/8" IPIN

ON SURFACE - ~~BELOW~~ 5"

OFFSET CL PAVEMENT ON ~~LT~~ : ~~RT~~

10' TO RT EDGE PAVEMENT


STATION: 249+03.22

HORIZ.DATUM: NAD83 2011

GEOID: 2012A NAVD88

GRID: NORTHING: 542304.144

EASTING: 1798660.054

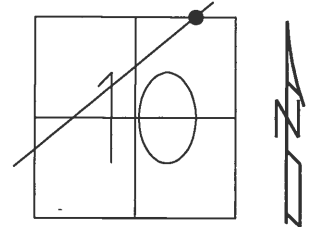

RECORD:

STA. 7+77

IPIN ON CL R/W

2" BELOW

11-22-65

SET P.K./WASHER

10-1-92

FD 5/8" IPIN

4" DOWN

SET MAG/WASHER

10-14-08, DCH

FD 5/8" IPIN


5" DOWN BENT SW

REF21

10-11-16, JFO

SET MAG/WASHER

10-9-18, JFO

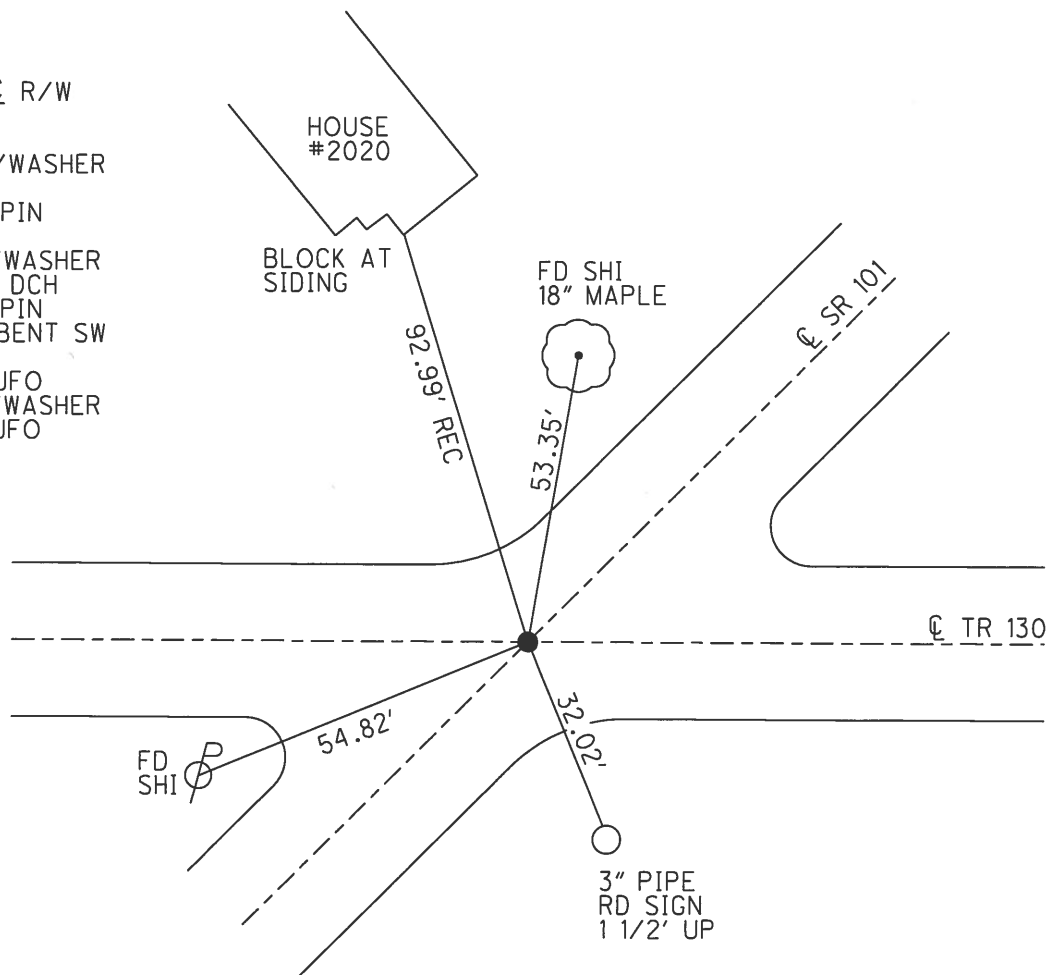

O.D.O.T. DISTRICT 2 SURVEY OFFICE (USE ONLY)

PERSONNEL

REFERENCE NO. 22

SHEET 23 OF 27

NOTES RHOADES

DATE 3/23/18

ROUTE SR 101

H.C. O'DONNELL

WEATHER SUNNY

COUNTY SENECA

R.C. SEAMAN

TEMP. 33°

TOWNSHIP CLINTON

SECTION 3

DWG BY MILLER

PID 102817

T 2 N R 15 E

TYPE MONUMENT MAG/WASHER

ON SURFACE - ~~BELOW~~ ON

OFFSET Q PAVEMENT 2' LT : ~~RT~~

8' TO LT EDGE PAVEMENT


STATION: 266+04.38

HORZ. DATUM: NAD83 2011

GEOID: 2012A NAVD88

GRID: NORTHING: 543626.968

EASTING: 1799729.674

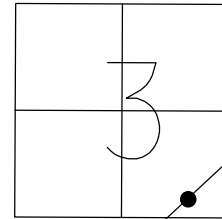

RECORD:

STA. 24+47

R.R. SPIKE ON Q R/W

ON SURFACE

11-22-65

FD P.K. NAIL

7/21/92, CHENEY

SET P.K./WASHER

10-1-92

FD MAG/WASHER

REF22

10-12-16, JFO

SET MAG/WASHER

10-9-18, JFO

FD SHI
20" GINKGO FAN




50.50'

24.32'

26.03'

SET SHI'S
TOP GR
POSTS

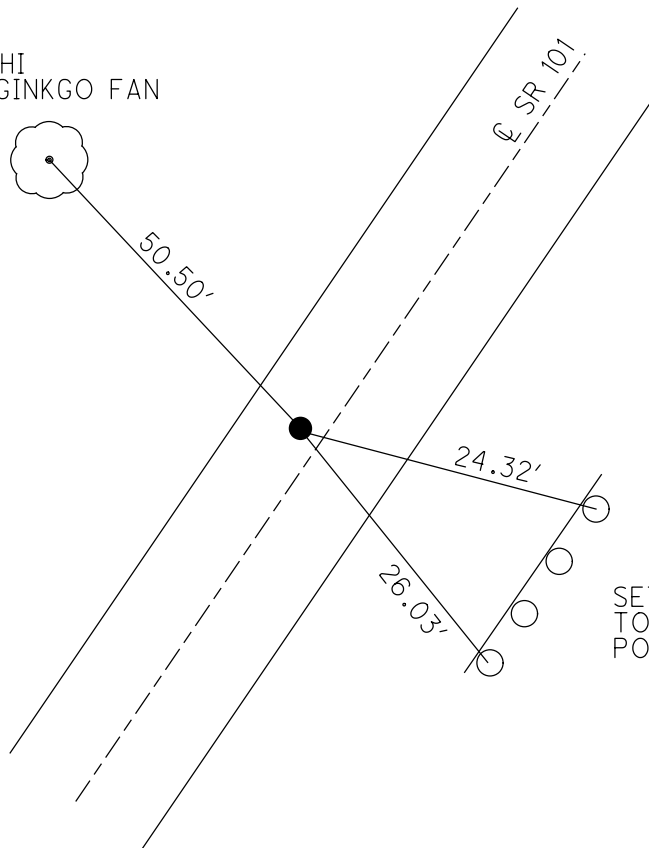

O.D.O.T. DISTRICT 2 SURVEY OFFICE (USE ONLY)

PERSONNEL

REFERENCE NO. 23

SHEET 24 OF 27

NOTES RHOADES

DATE 3/23/18

ROUTE SR 101

H.C. O'DONNELL

WEATHER SUNNY

COUNTY SENECA

R.C. SEAMAN

TEMP. 33°

TOWNSHIP CLINTON

SECTION 3

DWG BY MILLER

PID 102817

T 2 N R 15 E

TYPE MONUMENT MAG/WASHER

ON SURFACE - ~~BELOW~~ ON

OFFSET Q PAVEMENT 5.5' ~~LT~~ : RT

5.5' TO RT EDGE PAVEMENT


STATION: 274+67.2

HORZ.DATUM: NAD83 2011

GEOID: 2012A NAVD88

GRID: NORTHING: 544277.514

EASTING: 1800296.451

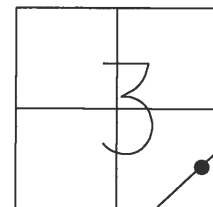

RECORD:

$\Delta = 1^{\circ} 07' \text{ RT}$

R.R. SPIKE ON Q R/W

ON SURFACE

11-22-65

FD P.K.NAIL

7/21/92, CHENEY

SET P.K./WASHER

10-1-92

FD MAG/WASHER

REF23

10-12-16, JFO

SET MAG/WASHER

10-9-18, JFO

FD SHI
30" PINE

46.25' REC

67.96'


SET SHI
18" TREE

38.83'

FD SHI
8" TWIN

52.70'

SET SHI
14" ASH

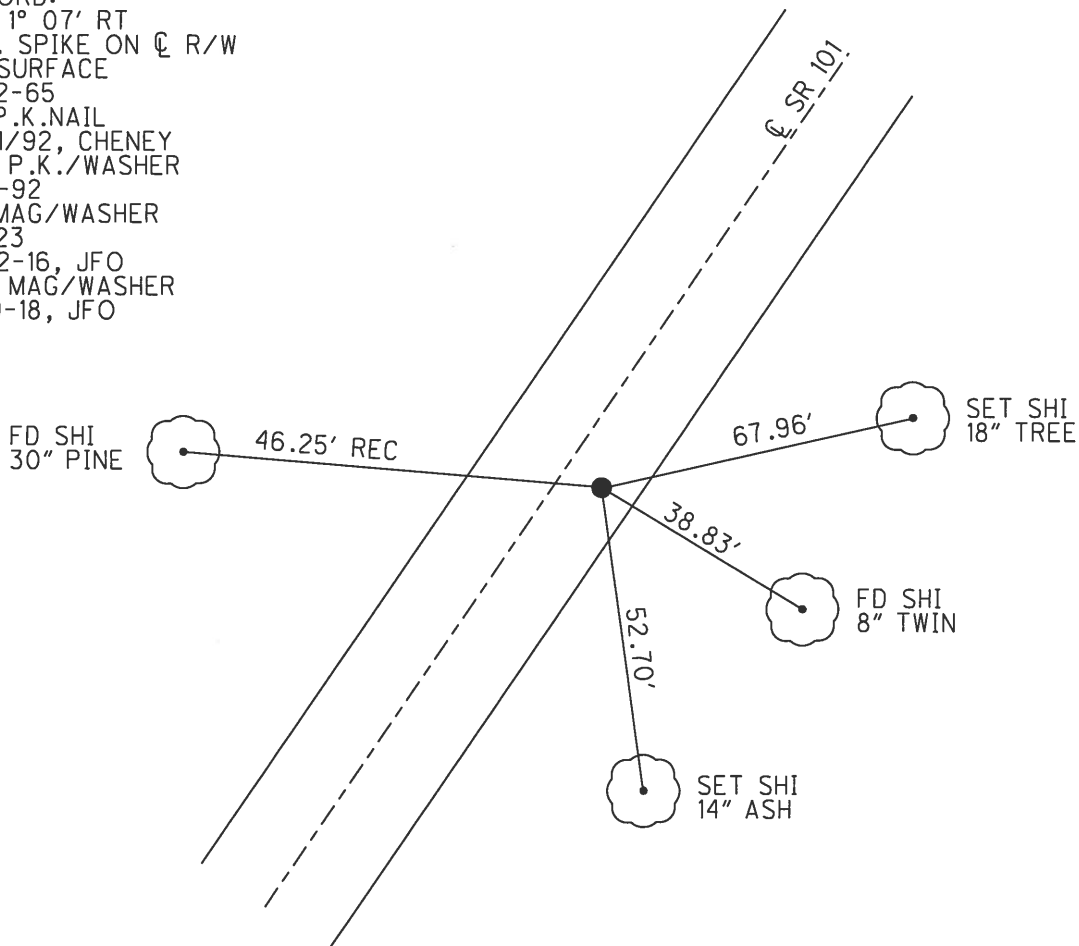

O.D.O.T. DISTRICT 2 SURVEY OFFICE (USE ONLY)

PERSONNEL

REFERENCE NO. 24

SHEET 25 OF 27

NOTES RHOADES
H.C. O'DONNELL
R.C. SEAMAN

DATE 3/23/18
WEATHER SUNNY
TEMP. 33°

ROUTE SR 101
COUNTY SENECA
TOWNSHIP CLINTON
SECTION 2
T 2 N R 15 E

DWG BY MILLER PID 102817

TYPE MONUMENT MAG/WASHER

ON SURFACE - ~~BELOW~~ ON

OFFSET 6.5' LT : ~~RT~~

3.5' TO LT EDGE PAVEMENT


STATION: 279+58

HORZ. DATUM: NAD83 2011


GEOID: 2012A NAVD88

GRID: NORTHING: 544647.834

EASTING: 1800618.555

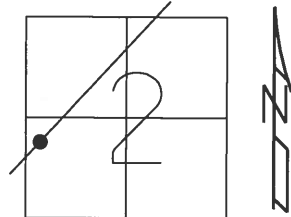

RECORD: P.I.
STA. 37+92.7
 $\Delta = 2^\circ 24' RT$
R.R. SPK. ON $\mathcal{C}$ R/W
ON SURFACE
11-22-65
FD R.R. SPIKE
7/21/92, CHENEY
SET P.K./WASHER
10-1-92
FD MAG/WASHER
REF24
10-12-16, JFO
SET MAG/WASHER
10-9-18, JFO

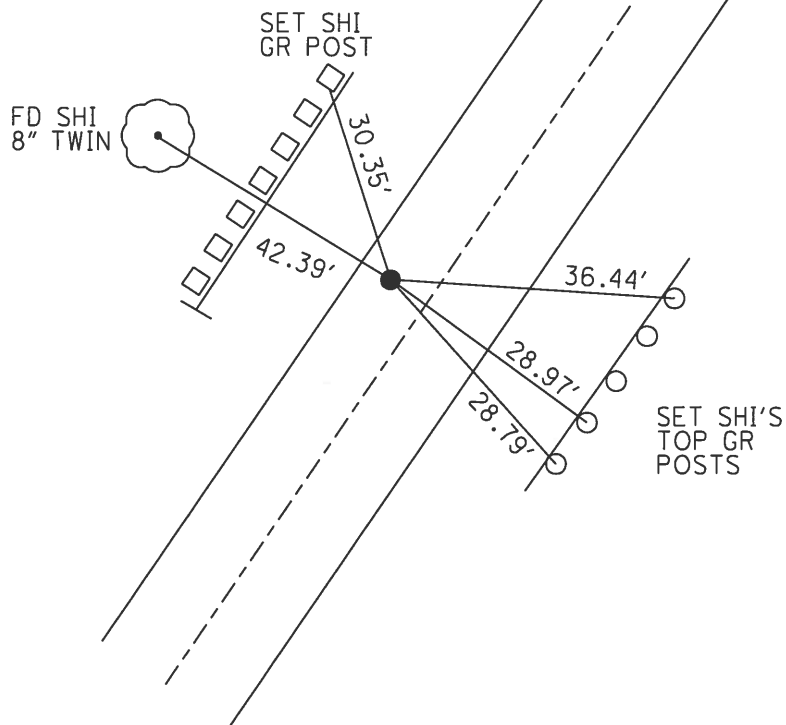

O.D.O.T. DISTRICT 2 SURVEY OFFICE (USE ONLY)

PERSONNEL

REFERENCE NO. 25

SHEET 26 OF 27

NOTES RHOADES

DATE 3/23/18

ROUTE SR 101

H.C. O'DONNELL

WEATHER SUNNY

COUNTY SENECA

R.C. SEAMAN

TEMP. 33°

TOWNSHIP CLINTON

SECTION 2

DWG BY MILLER

PID 102817

T 2 N R 15 E

TYPE MONUMENT P.K.NAIL

ON SURFACE - ~~BELOW~~ ON

OFFSET Q PAVEMENT 1' LT : ~~RT~~

10' TO RT EDGE PAVEMENT


STATION: 283+95.10

HORIZ.DATUM: NAD83 2011

GEOID: 2012A NAVD88

GRID: NORTHING: 544959.366

EASTING: 1800925.156

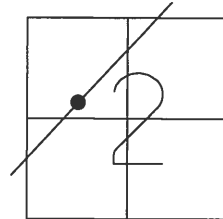

RECORD:

FD. R.R. SPIKE

11-23-65

FD P.K.NAIL

7/21/92, CHENEY

SET P.K./WASHER

10-1-92

FD MAG/WASHER


REF25

10-12-16, JFO

SET MAG/WASHER

10-9-18, JFO

FD SHI'S
TOP GR
POSTS

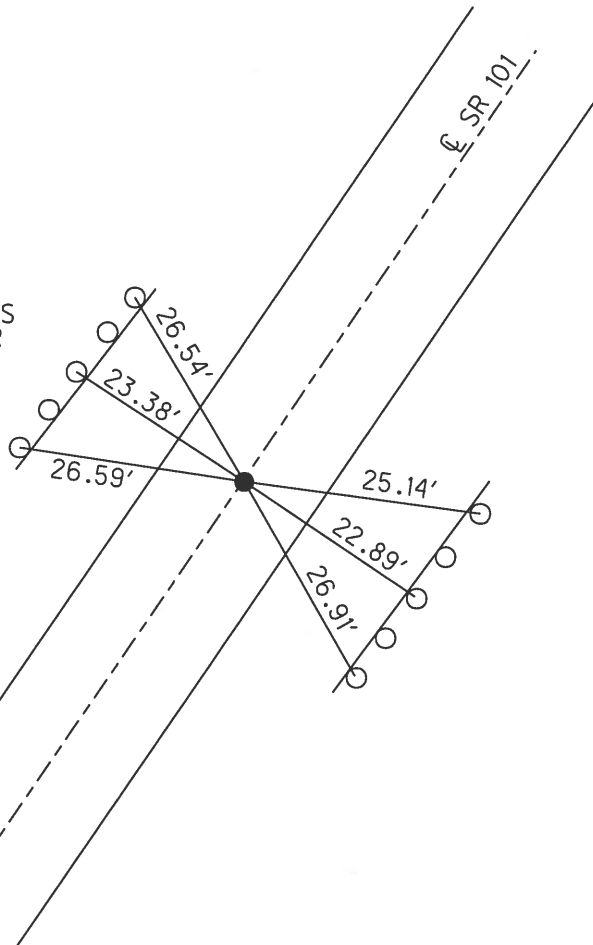


O.D.O.T. DISTRICT 2 SURVEY OFFICE (USE ONLY)


PERSONNEL	REFERENCE NO. <u>26</u>	SHEET <u>27</u> OF <u>27</u>
NOTES <u>MILLER</u>	DATE <u>8/7/24</u>	ROUTE <u>SR 101</u>
H.C. <u>MILLER</u>	WEATHER <u>SUNNY</u>	COUNTY <u>SENECA</u>
R.C. <u>BARRIERE</u>	TEMP. <u>66</u>	TOWNSHIP <u>CLINTON</u>
		SECTION <u>2</u>
DWG BY <u>BLUBAUGH</u>	PID <u>114849</u>	T <u>2</u> N R <u>15</u> E

TYPE MONUMENT MAG/WASHER
 ON SURFACE - ~~BELOW~~ ON
 OFFSET CL PAVEMENT 2' LT : RT
8' TO RT EDGE PAVEMENT
 STATION: 291+23.53

HORZ.DATUM: <u>NAD83 2011</u>	GEOID: <u>2012A NAVD88</u>
GRID: NORTHING: <u>545478.800</u>	EASTING: <u>1801435.843</u>
LDP: NORTHING: <u>314352.220</u>	EASTING: <u>175947.561</u>

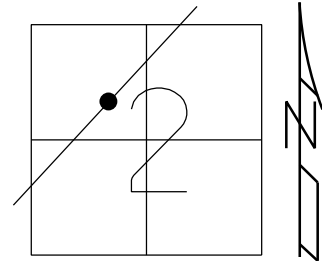

RECORD: P.C.
 STA. 49+35.6
 R.R.SPIKE ON CL R/W
 11-23-95
 FD P.K.NAIL
 7/21/92, CHENEY
 SET P.K./WASHER
 10-1-92
 FD MAG/WASHER
 REF 26
 6-14-16, JFO
 SET MAG/WASHER
 10-9-18, JFO
 FD MAG/WASH
 REF 26
 12/20/23, DSA
 8/9/24, JAM

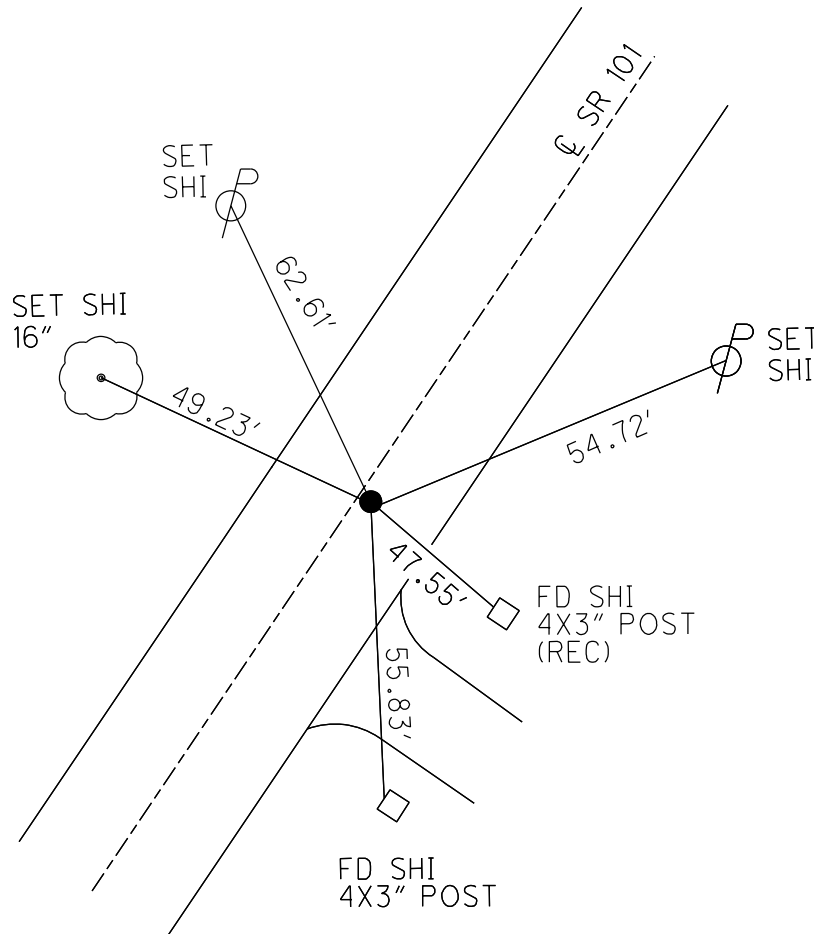


O.D.O.T. DISTRICT 2 SURVEY OFFICE (USE ONLY)


PERSONNEL	REFERENCE NO. <u>27</u>	SHEET <u>1</u> OF <u>46</u>
NOTES <u>MILLER</u>	DATE <u>8/9/24</u>	ROUTE <u>SR 101</u>
H.C. <u>MILLER</u>	WEATHER <u>SUNNY</u>	COUNTY <u>SENECA</u>
R.C. <u>BARRIERE</u>	TEMP. <u>65</u>	TOWNSHIP <u>PLEASENT</u>
<u>BLUBAUGH</u>		SECTION <u>35</u>
DWG BY <u>BLUBAUGH</u>	PID <u>114849</u>	T <u>3</u> N R <u>15</u> E

TYPE MONUMENT MAG/WASHER
 ON SURFACE - ~~BELOW~~ 0.5"
 OFFSET $\oslash$ PAVEMENT ON LT : RT
-- TO -- EDGE PAVEMENT
 STATION: 318+73.57

HORZ.DATUM: <u>NAD83 2011</u>	GEOID: <u>NAVD88-2012A</u>
GRID: NORTHING: <u>547506.005</u>	EASTING: <u>1803294.084</u>
LDP: NORTHING: <u>316393.358</u>	EASTING: <u>177790.774</u>

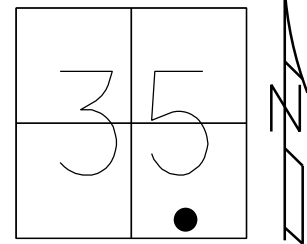

RECORD: P.O.T.
 SLM. 77+00
 SET P.K./ WASHER
 8-27-90
 FD P.K./WASHER
 2-4-05, SAH
 SET P.K./WASHER
 6/30/09, DCH
 SET MAG/WASHER
 NEWREF27
 10-05-09, DCH
 FD MAG/WASHER
 REF27
 6-14-16, JFO
 10-12-16, JFO
 9-18-17, JFO
 FD MAG/WASH
 REF27
 12/20/23, DSA
 FD TONE, DID NOT
 UNCOVER, PAINTED
 8/9/24, JAM

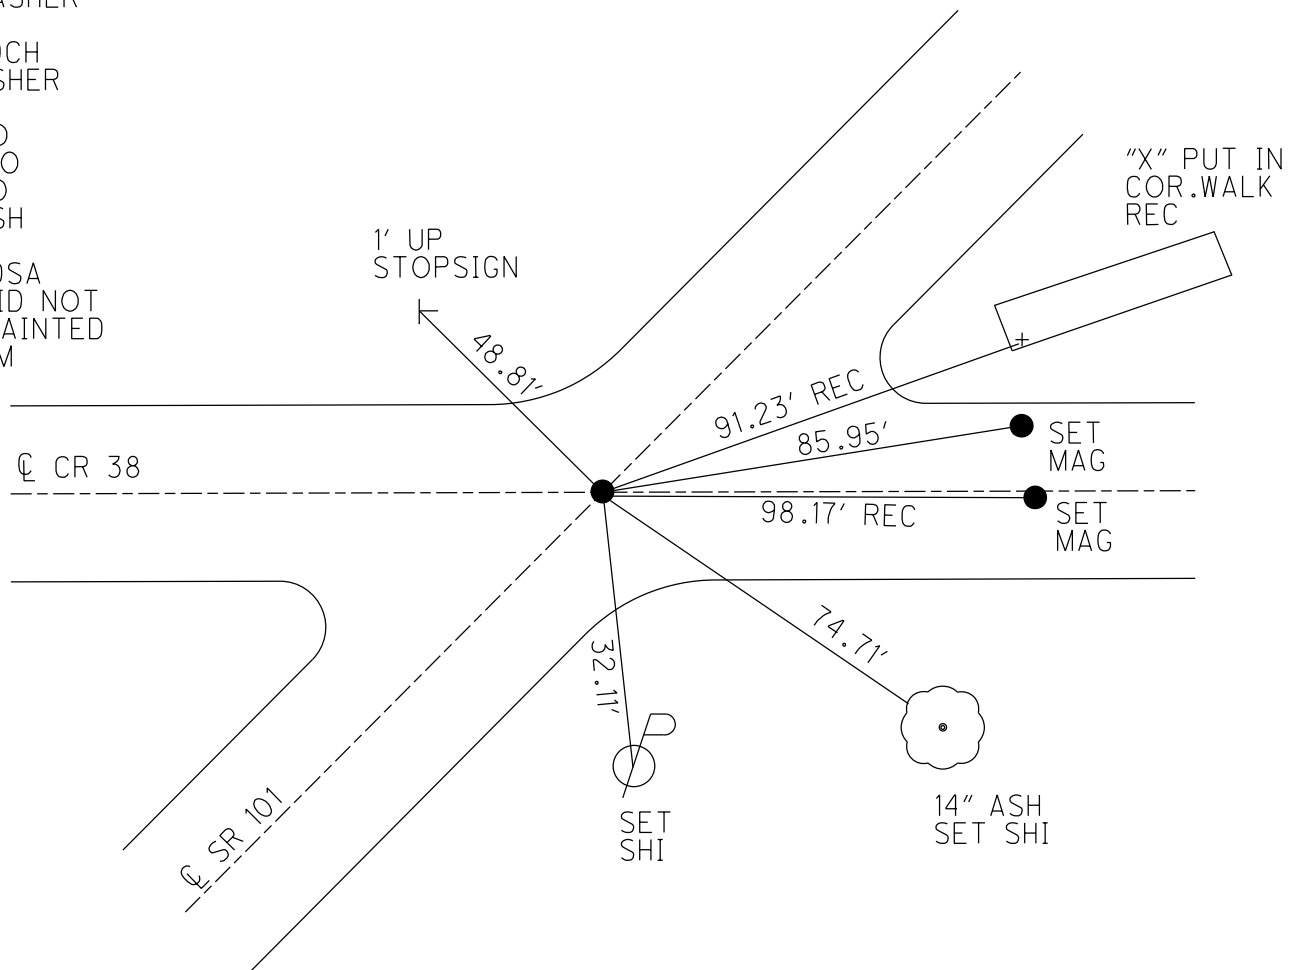


O.D.O.T. DISTRICT 2 SURVEY OFFICE (USE ONLY)


PERSONNEL NOTES <u>MILLER</u> H.C. <u>MILLER</u> R.C. <u>BARRIERE</u> <u>BLUBAUGH</u> DWG BY <u>BLUBAUGH</u>	REFERENCE NO. <u>28</u> DATE <u>8/9/24</u> WEATHER <u>CLEAR</u> TEMP. <u>65</u> PID <u>114849</u>	SHEET <u>2</u> OF <u>46</u> ROUTE <u>SR 101</u> COUNTY <u>SENECA</u> TOWNSHIP <u>PLEASENT</u> SECTION <u>35</u> T <u>3</u> N R <u>15</u> E
--	--	---

TYPE MONUMENT MAG/WASHER
 ON SURFACE - ~~BELOW~~ 0.5"
 OFFSET 1' LT : RT
 -- TO -- EDGE PAVEMENT
 STATION: 342+58.44

HORZ.DATUM: <u>NAD83 2011</u> GRID: NORTHING: <u>549263.893</u> LDP: NORTHING: <u>318163.388</u>	GEOID: <u>NAVD88-2018</u> EASTING: <u>1804905.756</u> EASTING: <u>179389.425</u>
--	--

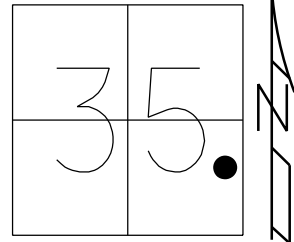

RECORD:
 STA.101+00
 FD. R.R. SPIKE
 SET P.K./WASHER
 8-27-90
 FD P.K./WASHER
 2-4-05, SAH
 SET P.K./WASHER
 6/30/09, DCH
 SET MAG/WASHER
 NEWREF28
 10-05-09, DCH
 FD MAG/WASHER
 REF28
 6-14-16, JFO
 FD MAG/WASHER
 REF28
 10-12-16, JFO
 9-18-17, JFO
 FD MAG/WASH
 REF28
 12/20/23, DSA
 FD TONE, DID NOT
 UNCOVER, PAINTED
 8/9/24, JAM

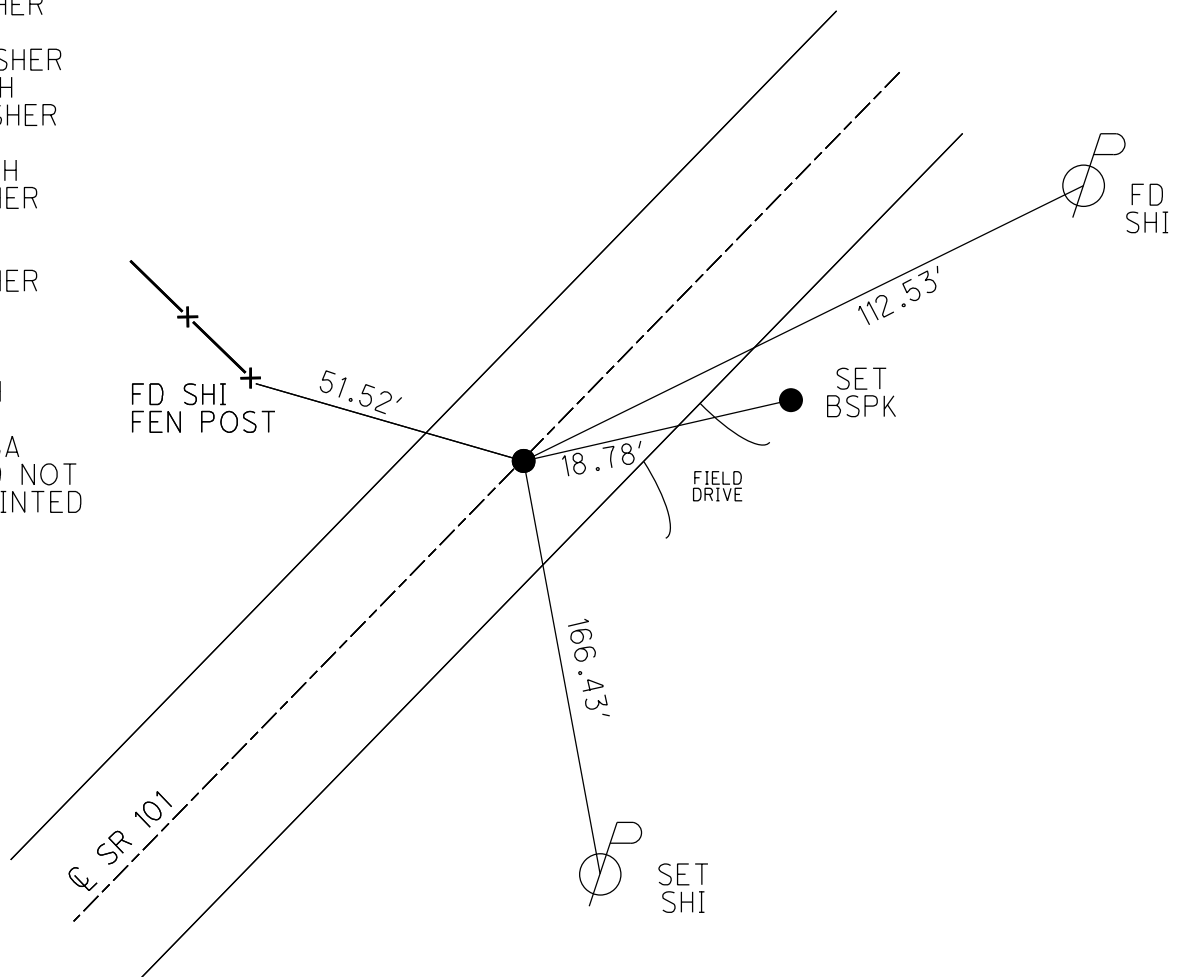

O.D.O.T. DISTRICT 2 SURVEY OFFICE (USE ONLY)

PERSONNEL

REFERENCE NO. 29

SHEET 3 OF 46

NOTES MILLER

DATE 8/9/24

ROUTE SR 101

H.C. MILLER

WEATHER SUNNY

COUNTY SENECA

R.C. BARRIERE

TEMP. 66

TOWNSHIP PLEASENT

BLUBAUGH

SECTION 36

DWG BY BLUBAUGH

PID 114849

T 3 N R 15 E

TYPE MONUMENT P.K.NAIL

ON SURFACE - ~~BELOW~~ ON

OFFSET Q PAVEMENT ON LT : RT

-- TO -- EDGE PAVEMENT

STATION: 356+20

HORIZ.DATUM: NAD83 2011


GEOID: NAVD88-2018

GRID: NORTHING: 550274.188

EASTING: 180531.862


LDP: NORTHING: 319173.846

EASTING: 180302.508

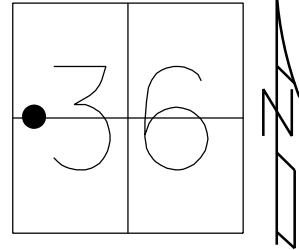

RECORD:
STA.115+72
FD. P.K./WASHER
ATOP R.R. SPIKE
SET P.K./WASHER
8/27/90
FD P.K./WASHER
2/4/05, SAH
FD P.K.NAIL
REF29
7/14/09, DCH
SET MAG/WASHER
NEWREF29
10-08-09, DCH
FD MAG/WASHER
REF29
6/14/16, JFO
9/18/17, JFO
FD MAGNAIL
REF29
12/20/23, DSA
FD TONE, DID NOT UNCOVER,PAINTED
8/9/24, JAM

DIST.
29-29A = 8.79'
29-29B = 106.47'
29A-29B = 97.69'

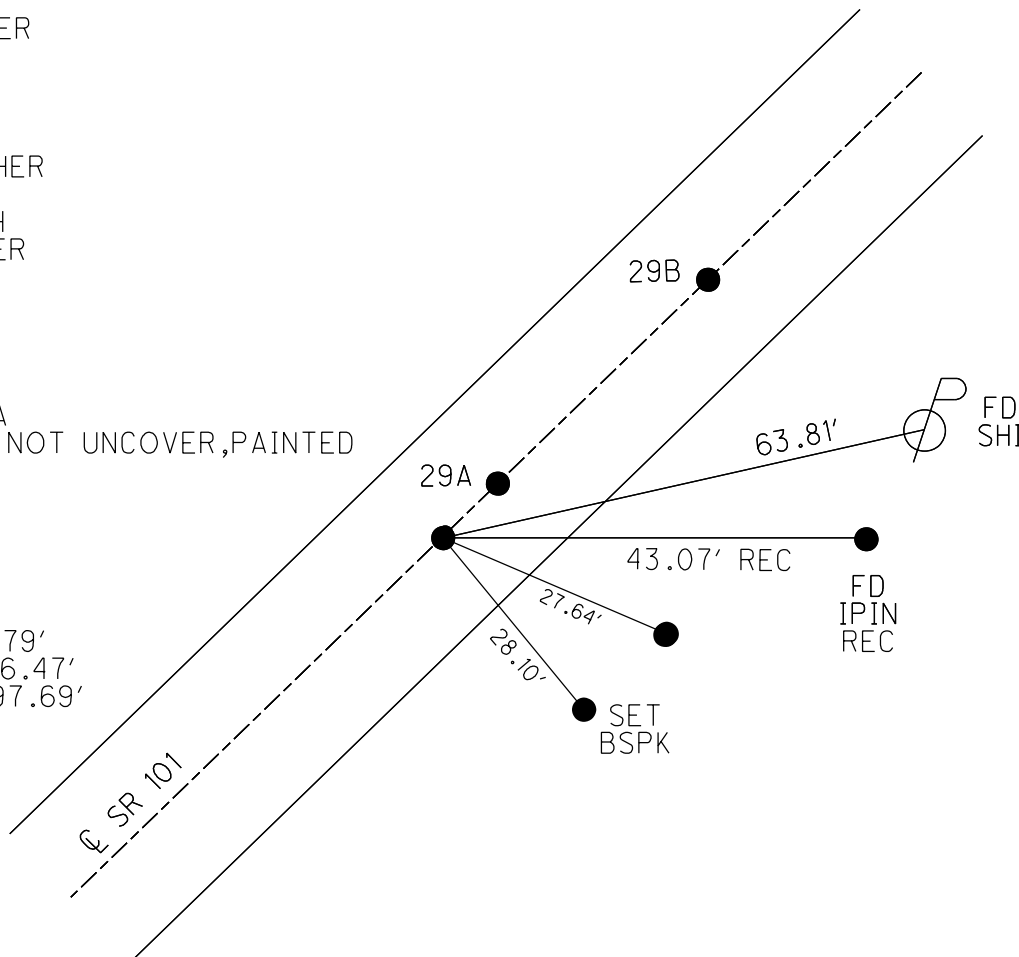

O.D.O.T. DISTRICT 2 SURVEY OFFICE (USE ONLY)

PERSONNEL

REFERENCE NO. 29 A

SHEET 4 OF 46

NOTES MILLER
H.C. MILLER
R.C. BARRIERE
BLUBAUGH

DATE 8/9/24
WEATHER SUNNY
TEMP. 66

ROUTE SR 101
COUNTY SENECA
TOWNSHIP PLEASENT
SECTION 36
T 3 N R 15 E

DWG BY BLUBAUGH PID 114849

TYPE MONUMENT MAG/WASHER

ON SURFACE - ~~BELOW~~ ON

OFFSET $\mathcal{C}$ PAVEMENT ON LT : RT

-- TO -- EDGE PAVEMENT

STATION: 356+29

HORIZ.DATUM: NAD83 2011


GEOID: NAVD88-2018

GRID: NORTHING: 550274.265

EASTING: 1805831.787

LDP: NORTHING: 319180.655


EASTING: 180308.064

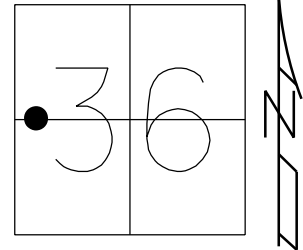


RECORD:

D.N.F.
2/4/05, SAH
FD P.K./WASHER
REFB29
7/14/09, DCH
SET MAG/WASHER
NEWREFB29
10/8/09, DCH
D.N.F.
6/14/16, JFO
FD MAG/W
REF29A
12/20/23, DSA
FD TONE. DID NOT UNCOVER, PAINTED
8/9/24, JAM

DIST.
29-29A = 8.79'
29-29B = 106.47'
29A-29B = 97.69'

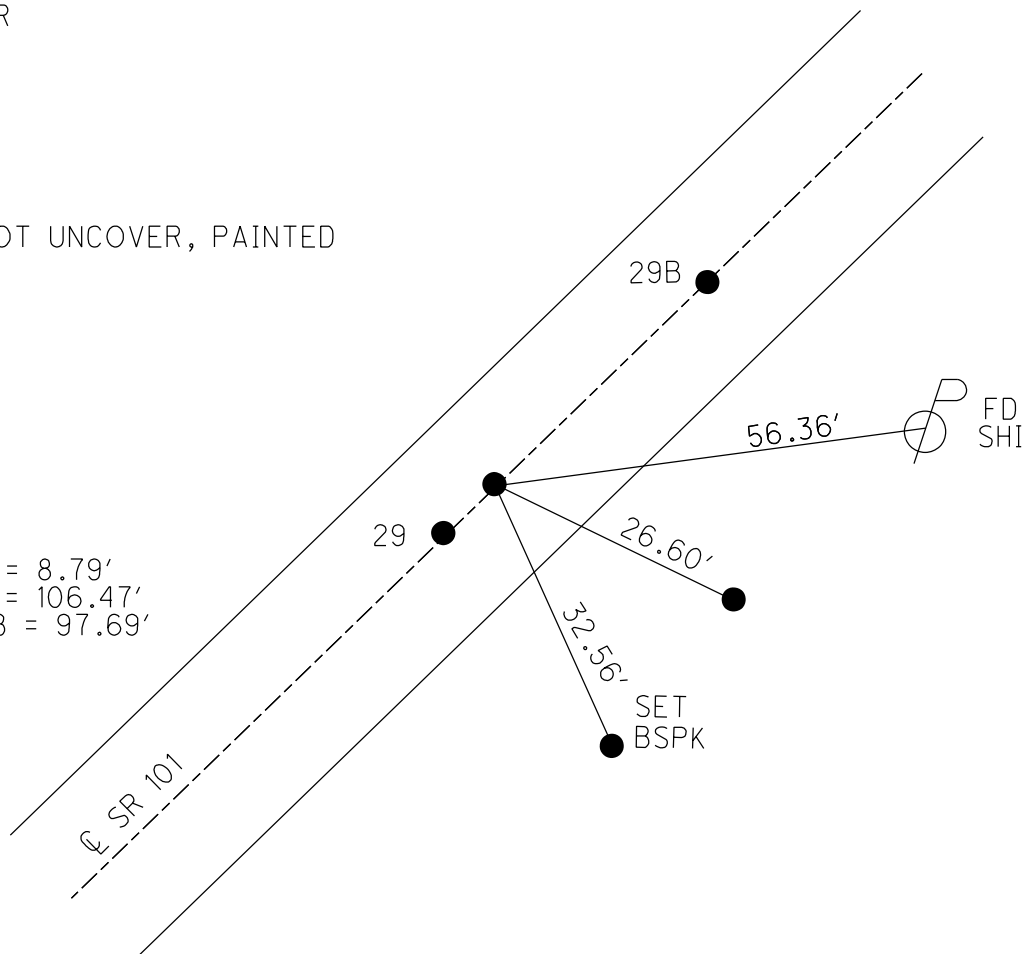


O.D.O.T. DISTRICT 2 SURVEY OFFICE (USE ONLY)

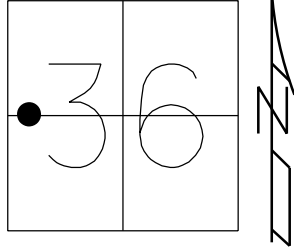PERSONNEL NOTES <u>MILLER</u> H.C. <u>MILLER</u> R.C. <u>BARRIERE</u> <u>BLUBAUGH</u> DWG BY <u>BLUBAUGH</u>	REFERENCE NO. <u>29 B</u> DATE <u>8/9/24</u> WEATHER <u>SUNNY</u> TEMP. <u>66</u> PID <u>114849</u>	SHEET <u>5</u> OF <u>46</u> ROUTE <u>SR 101</u> COUNTY <u>SENECA</u> TOWNSHIP <u>PLEASENT</u> SECTION <u>36</u> T <u>3</u> N R <u>15</u> E
TYPE MONUMENT <u>MAG/WASHER</u> ON SURFACE - BELOW <u>2.0"</u> OFFSET $\oslash$ PAVEMENT <u>ON</u> LT : RT <u>--</u> TO <u>--</u> EDGE PAVEMENT STATION: <u>357+26</u>		
HORIZ.DATUM: <u>NAD83 2011</u> GRID: NORTHING: <u>550346.303</u> LDP: NORTHING: <u>319253.268</u>		GEOID: <u>NAVD88-2018</u> EASTING: <u>1805897.713</u> EASTING: <u>180373.417</u>

RECORD:
 FD MAG NAIL
 REFA29
 7/14/09, DCH
 SET MAG/WASHER
 NEWREFA29
 10-08-09, DCH
 FD MAG/WASHER
 REFA29
 6/14/16
 9/18/17, JFO
 FD MAG/W
 REF29B
 12/20/23, DSA
 FD TONE.DID NOT UNCOVER, PAINTED
 8/9/24, JAM

DIST.
 29-29A = 8.79'
 29-29B = 106.47'
 29A-29B = 97.69'

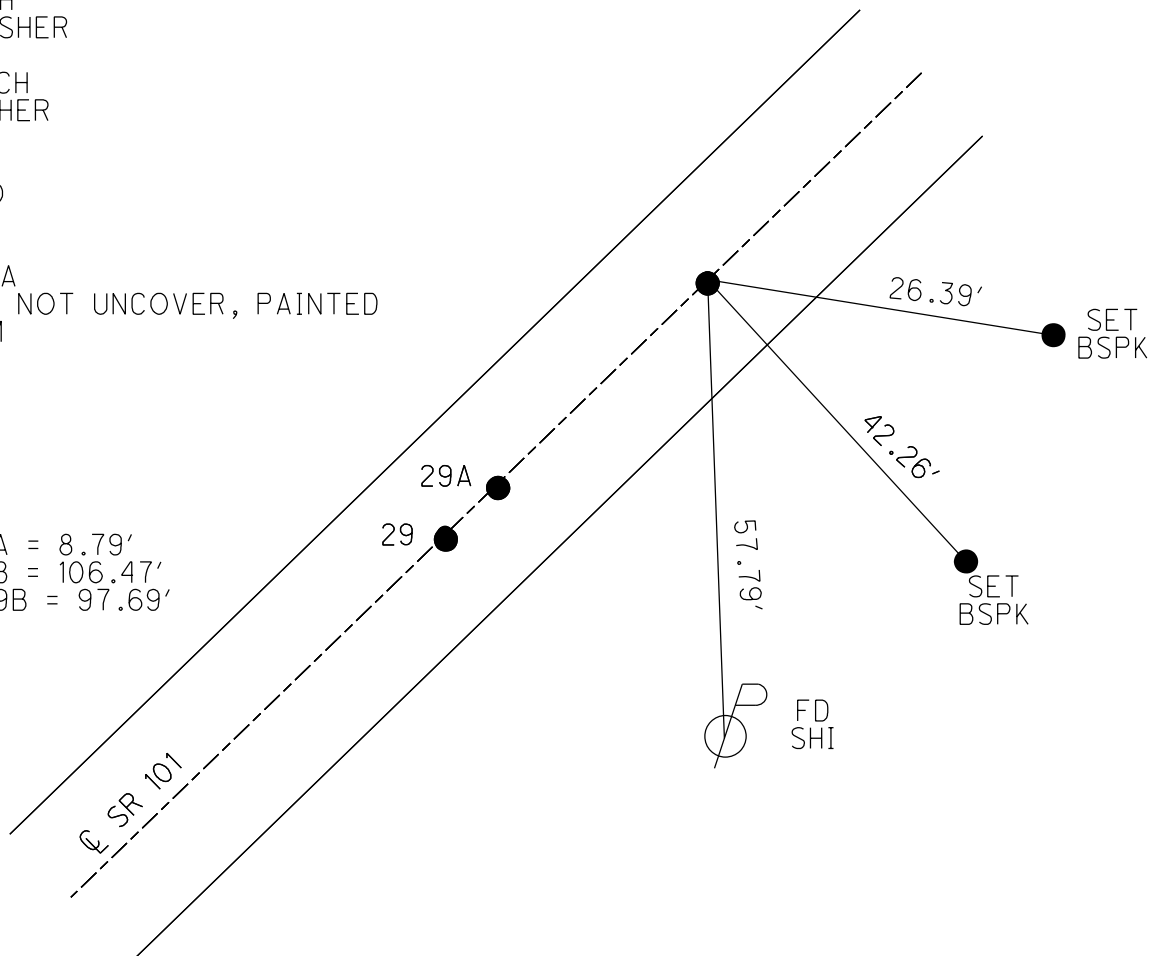

O.D.O.T. DISTRICT 2 SURVEY OFFICE (USE ONLY)

PERSONNEL

REFERENCE NO. 30

SHEET 6 OF 46

NOTES RIPPLE

DATE 8-27-90

ROUTE SR 101

H.C. BARBOUR

WEATHER SUNNY

COUNTY SENECA

R.C. -----

TEMP. 73°F

TOWNSHIP PLEASENT

DWG BY MAHLER

PID 100787

SECTION 36

T 3 N R 15 E

TYPE MONUMENT R.R.SPIKE

ON SURFACE - BELOW -----

OFFSET Q PAVEMENT ----- LT : RT

-- TO -- EDGE PAVEMENT

STATION: 376+73±

HORZ.DATUM: -----


GEOID: -----

GRID: NORTHING: -----


EASTING: -----

LDP: NORTHING: -----

EASTING: -----

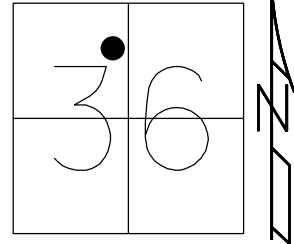

RECORD:
STA. 135+00
R.R.SPIKE
ON R/W
D.N.F.
8/27/90, BARBOUR
2/4/05, SAH
7/14/09, DCH
6/14/16, JFO
8/9/24, JAM

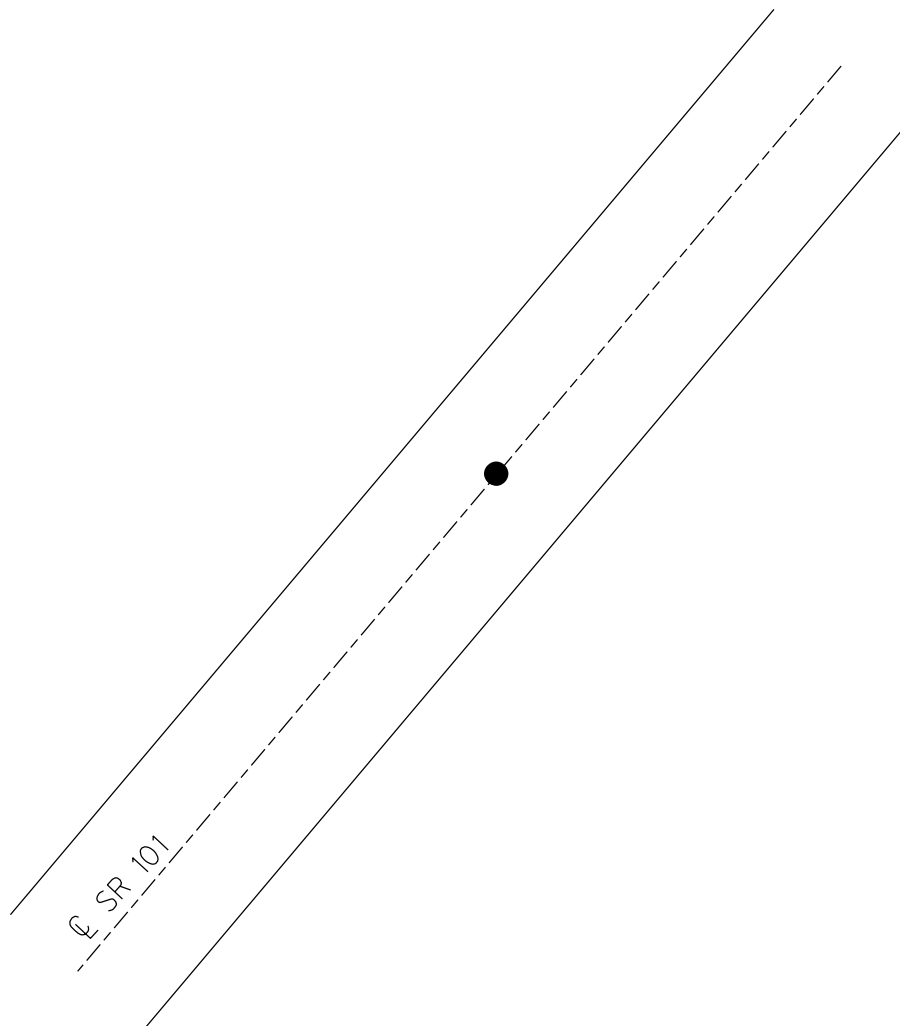

O.D.O.T. DISTRICT 2 SURVEY OFFICE (USE ONLY)

PERSONNEL

REFERENCE NO. 31

SHEET 7 OF 46

NOTES MILLER

DATE 8/9/24

ROUTE SR 101

H.C. MILLER

WEATHER CLEAR

COUNTY SENECA

R.C. BARRIERE

TEMP. 66°F

TOWNSHIP PLEASENT

BLUBAUGH

SECTION 36

DWG BY BLUBAUGH

PID 114849

T 3 N R 15 E

TYPE MONUMENT MAG/WASHER

~~ON SURFACE~~ - BELOW ON

OFFSET Q PAVEMENT ON LT : RT

-- TO -- EDGE PAVEMENT

STATION: 387+18

HORZ.DATUM: NAD83 2011


GEOID: NAVD88-2018

GRID: NORTHING: 552550.967

EASTING: 1807899.699

LDP: NORTHING: 321473.026

EASTING: 182359.101

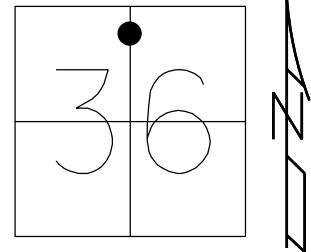

RECORD:
1924 PLAN
STA. 389+04.61
 $\Delta = 0^{\circ} 33' \text{ RT}$
FD R.R SPIKE
6/26/79, BARBOUR
SET P.K./WASHER
8/27/90, BARBOUR
FD P.K.NAIL
REF31
7/14/09, DCH
SET MAG/WASHER
NEWREF31
10-08-09, DCH
FD P.K./WASHER
4 1/2" DOWN
REF31
6/14/16
9/18/17, JFO
FD MAGNAIL
4.5" DOWN
REF31
12/20/23, DSA
SET MAG/WASHER
8/9/24, JAM

RES.
#3924

CONC.WALK

PULLED
TO CORNER
OF FIRST SEAM

65.17'

ASPHALT
DRIVE

SR 101

52.20'

SET SHI
14" WALNUT

36.99'

FD SHI
18" WALNUT

45.46'


FD SHI
18" PINE

O.D.O.T. DISTRICT 2 SURVEY OFFICE (USE ONLY)


PERSONNEL	REFERENCE NO. <u>32</u>	SHEET <u>8</u> OF <u>46</u>
NOTES <u>MILLER</u>	DATE <u>8/9/24</u>	ROUTE <u>SR 101</u>
H.C. <u>MILLER</u>	WEATHER <u>SUNNY</u>	COUNTY <u>SENECA</u>
R.C. <u>BARRIERE</u>	TEMP. <u>66°F</u>	TOWNSHIP <u>PLEASENT</u>
		SECTION <u>25</u>
DWG BY <u>BLUBAUGH</u>	PID <u>114849</u>	T <u>3</u> N R <u>15</u> E

TYPE MONUMENT MAG/WASHER
 ON SURFACE - ~~BELOW~~ 0.5"
 OFFSET Q PAVEMENT 2.3' LT : RT
-- TO -- EDGE PAVEMENT
 STATION: 402+46

HORZ.DATUM: <u>NAD83 2011</u>	GEOID: <u>NAVD88-2018</u>
GRID: NORTHING: <u>553679.363</u>	EASTING: <u>1808942.359</u>
LDP: NORTHING: <u>322609.276</u>	EASTING: <u>183393.423</u>

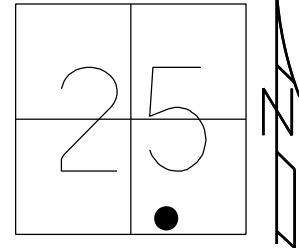

RECORD: P.I.
 $\Delta = 7^{\circ} 04' 30''$ RT
 STA. 404+41.26
 STA. 160+82
 FD BOAT SPIKE/SHI
 SET P.K./WASHER
 8/27/90
 FD P.K./WASHER
 REF32
 7/14/09, DCH
 SET MAG/WASHER
 NEWREF32
 11/4/09, DCH
 FD MAG/WASHER
 REF32
 6/14/16, JFO
 UNCOVERED
 9/18/17, JFO
 FD MAG/W
 REF32
 12/20/23, DSA
 FD TONE. DID NOT UNCOVER, PAINTED
 8/9/24, JAM

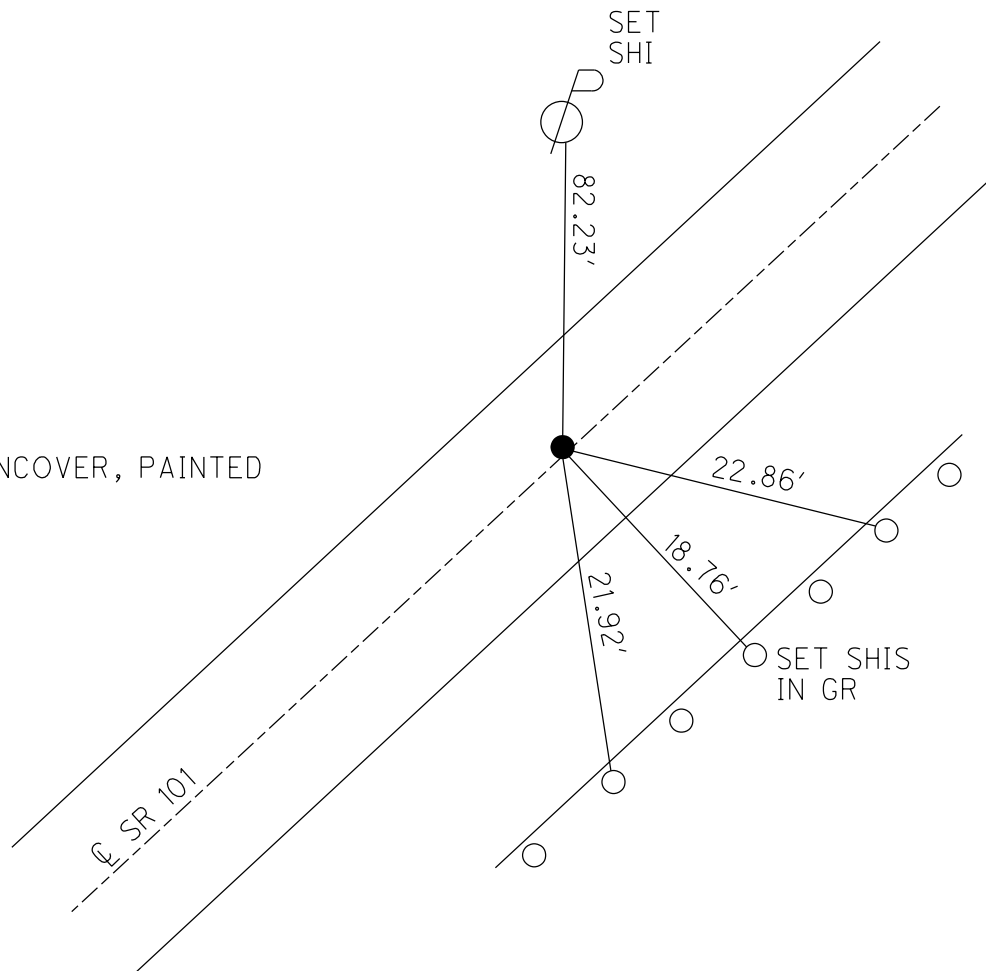

O.D.O.T. DISTRICT 2 SURVEY OFFICE (USE ONLY)

PERSONNEL

REFERENCE NO. 33

SHEET 9 OF 46

NOTES RIPPLE

DATE 8/27/90

ROUTE SR 101

H.C. BARBOUR

WEATHER SUNNY

COUNTY SENECA

R.C. GEYMAN

TEMP. 82°

TOWNSHIP PLEASENT

DWG BY MAHLER

PID 100787

SECTION 25

T 3 N R 15 E

TYPE MONUMENT P.K./WASHER

ON SURFACE - ~~BELOW~~ ON

OFFSET Q PAVEMENT ON LT : RT

-- TO -- EDGE PAVEMENT

STATION: 408+10±

HORZ.DATUM: -


GEOID: -

GRID: NORTHING: -

EASTING: -

LDP: NORTHING: -

EASTING: -

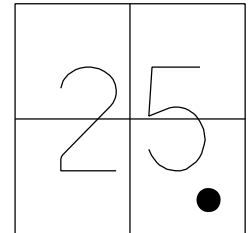


RECORD: P.O.T.
STA. 410+04.86
FD P.K./WASHER
ATOP P.K.NAIL
8/27/90, BARBOUR
D.N.F.
7/14/09, DCH
6/14/16, JFO
8/7/24, JAM

SET SHI
12" BOXELDER

SET SHI
14" CEDAR

SET SHI
4" ELM

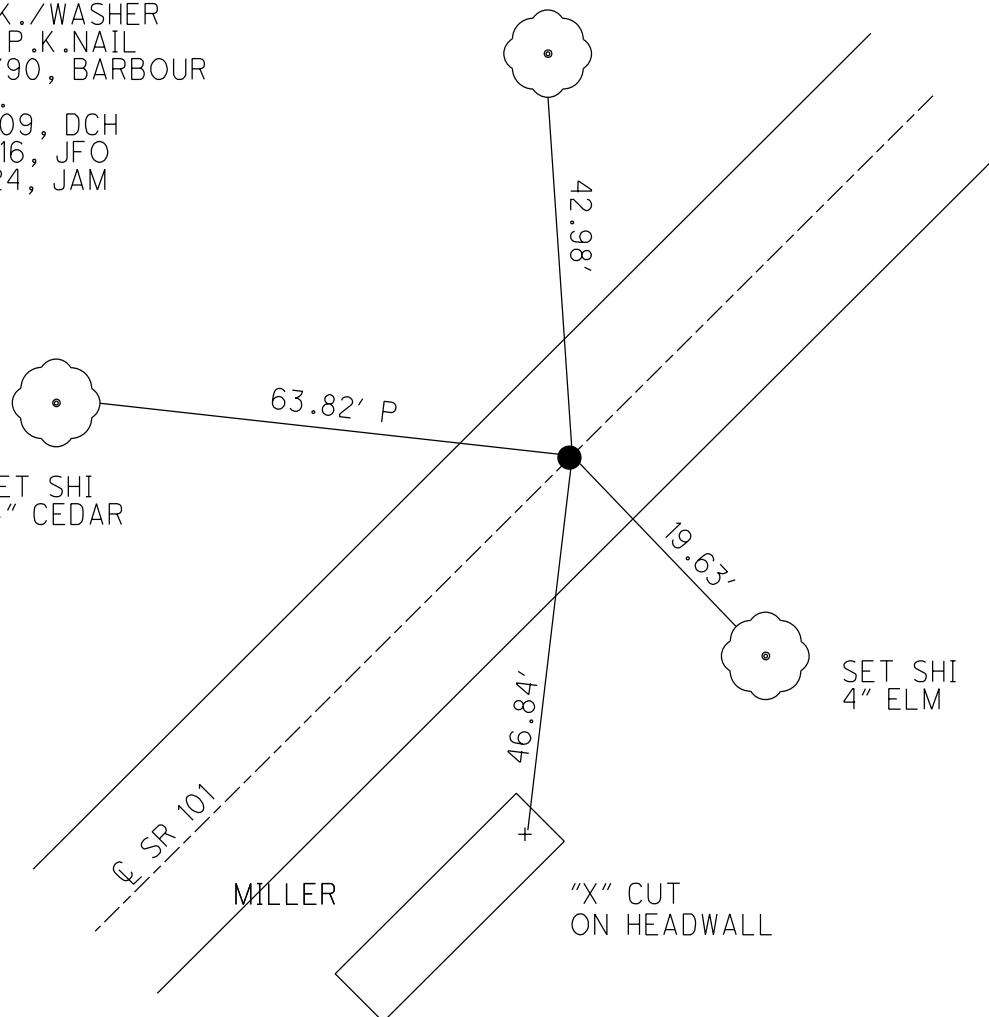

O.D.O.T. DISTRICT 2 SURVEY OFFICE (USE ONLY)

PERSONNEL

REFERENCE NO. 34

SHEET 10 OF 46

NOTES RIPPLE
H.C. BARBOUR
R.C. GEYMAN

DATE 8-27-90
WEATHER SUNNY
TEMP. 82°F

ROUTE SR 101
COUNTY SENECA
TOWNSHIP PLEASENT
SECTION 25

DWG BY MAHLER PID 100787

T 3 N R 15 E

TYPE MONUMENT MINE SPIKE

ON SURFACE - BELOW -

OFFSET Q PAVEMENT 5.7' ~~LT~~ : RT

-- TO -- EDGE PAVEMENT

STATION: 412+09±

HORZ.DATUM: -


GEOID: -

GRID: NORTHING: -


EASTING: -

LDP: NORTHING: -

EASTING: -

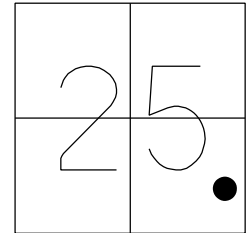

RECORD: P.I.
STA. 414+04.19
FD MINE SPIKE
8/27/90, BARBOUR
D.N.F.
7/14/09, DCH
6/14/16, JFO
8/7/24, JAM

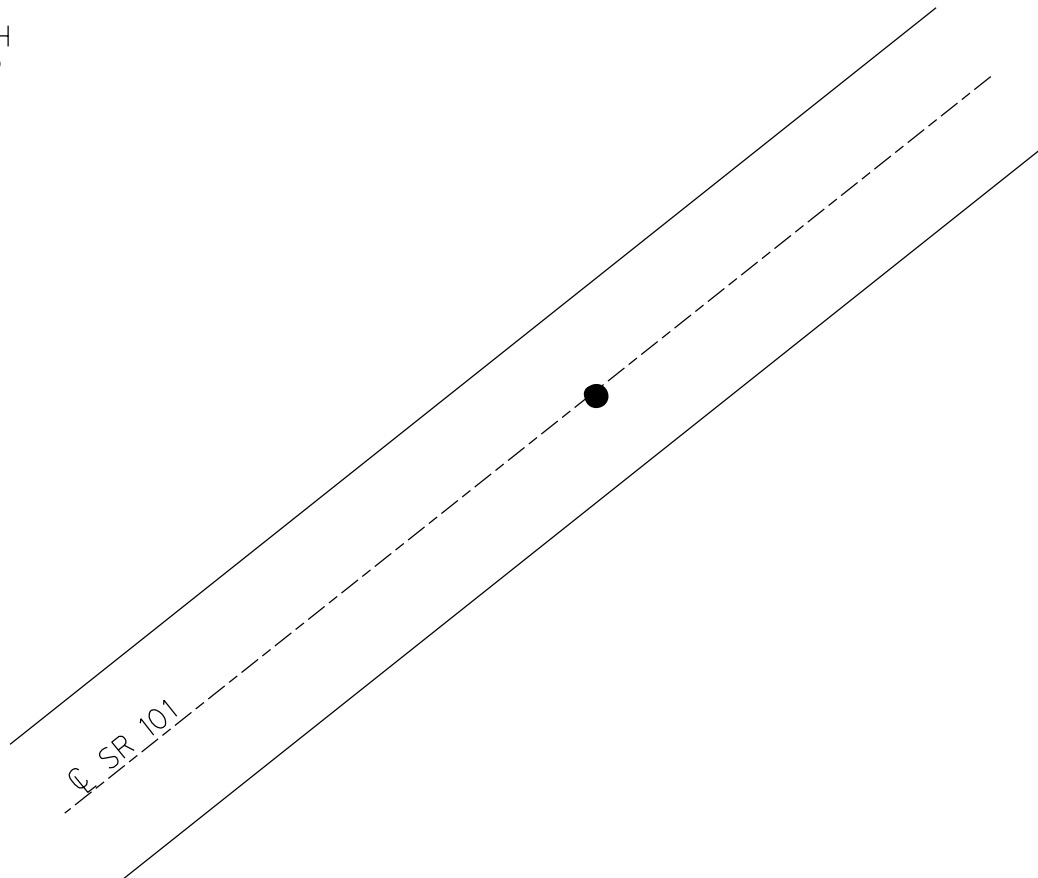

O.D.O.T. DISTRICT 2 SURVEY OFFICE (USE ONLY)

PERSONNEL

REFERENCE NO. 35

SHEET 11 OF 46

NOTES MILLER

DATE 8/7/24

ROUTE SR 101

H.C. MILLER

WEATHER WINDY/CLOUDY

COUNTY SENECA

R.C. BARRIERE

TEMP. 70°F

TOWNSHIP PLEASANT

BLUBAUGH, ASTON, PRESTON-COLVIN

SECTION 25

DWG BY BLUBAUGH PID 114849

T 3 N R 15 E

TYPE MONUMENT MONBOX

ON SURFACE - ~~BELOW~~ 0.5"

OFFSET Q PAVEMENT 1' ~~LT~~ : RT

-- TO -- EDGE PAVEMENT

STATION: 425+00

HORZ.DATUM: NAD83 (2011)


GEOID: NAVD88-2018

GRID: NORTHING: 555287.618


EASTING: 1810504.685

LDP: NORTHING: 324229.237

EASTING: 184943.911

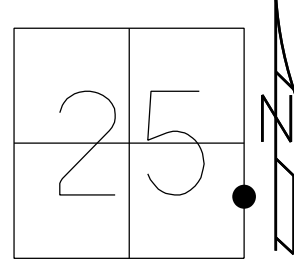

RECORD: P.I.
STA. 426+91.80
 $\Delta = 0^\circ 29' \text{ LT}$
8/27/90, BARBOUR
FD MONBOX
2/4/05, SAH
7/14/09, DCH
FD MONBOX
REF35
6/14/16
9/18/17, JFO
FD MONBOX
(COULD NOT OPEN)
SHOT MID LID
REF35
12/20/23, JAM
FD MONBOX COVERED.
PAINTED LOCATION
8/7/24, JAM

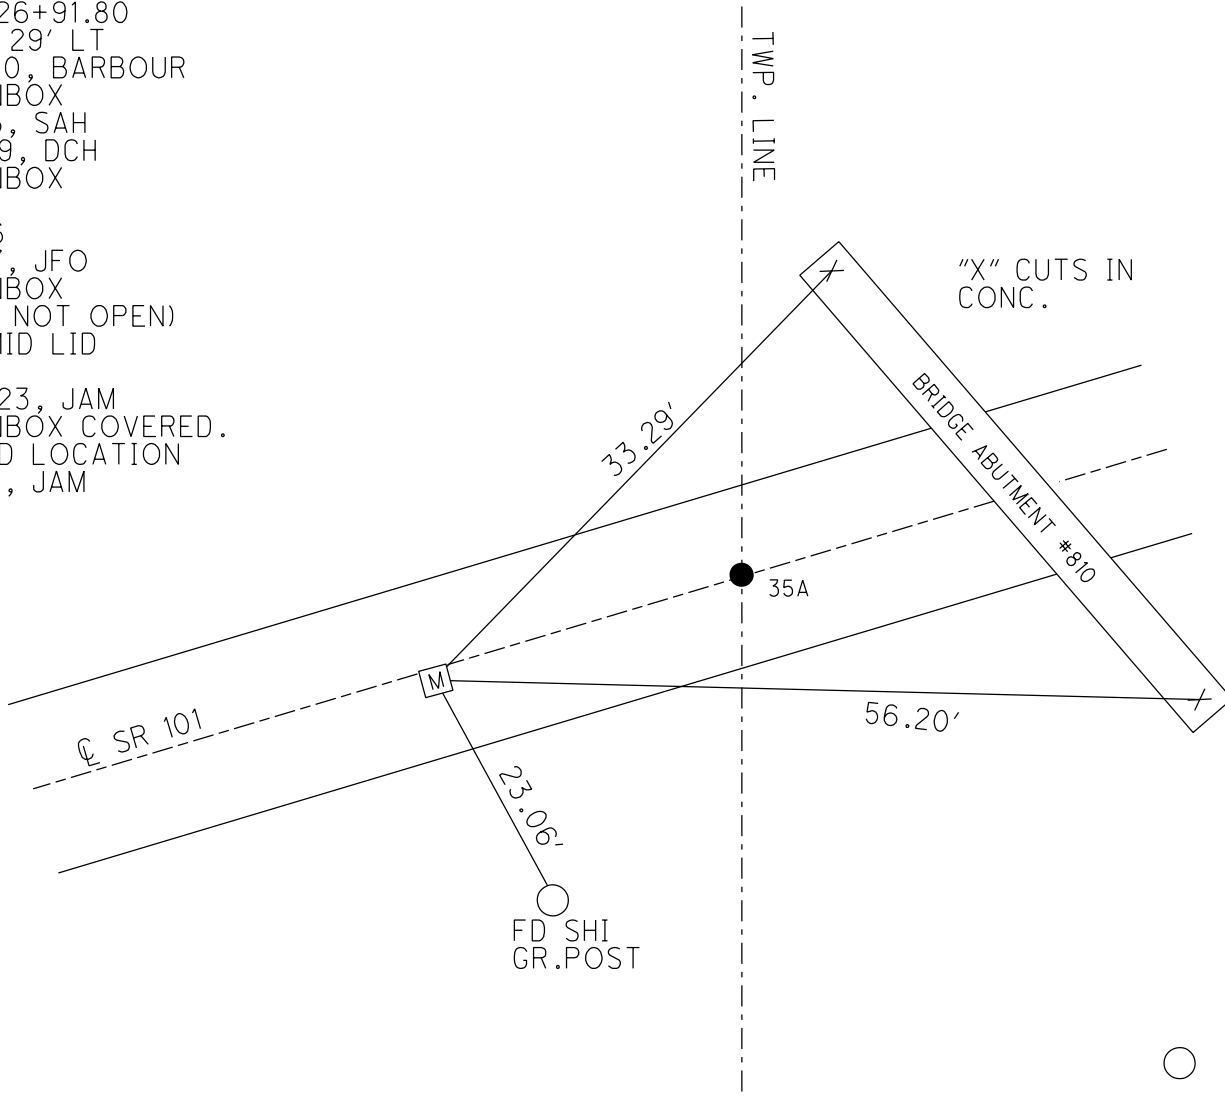

O.D.O.T. DISTRICT 2 SURVEY OFFICE (USE ONLY)

PERSONNEL

REFERENCE NO. 35 A

SHEET 12 OF 46

NOTES RIPPLE
H.C. BARBOUR
R.C. GEYMAN

DATE 8-27-90
WEATHER SUNNY
TEMP. 92°F

ROUTE SR 101
COUNTY SENECA
TOWNSHIP ADAMS
SECTION 30
T 3 N R 16 E

DWG BY MAHLER PID 100787

TYPE MONUMENT P.K. NAIL

ON SURFACE - ~~BELOW~~ ON

OFFSET $\varnothing$ PAVEMENT ON ~~LT~~ : RT


-- TO -- EDGE PAVEMENT

STATION: 425+06


HORIZ.DATUM: - GEOID: -

GRID: NORTHING: - EASTING: -

LDP: NORTHING: - EASTING: -

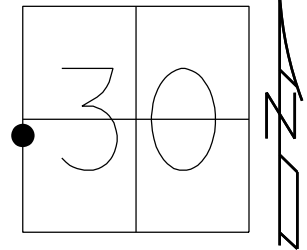

RECORD: P.O.T.
STA. 426+97.81
FD P.K./WASHER
8/27/90, BARBOUR
D.N.F.
2/4/05, SAH
7/14/09, DCH
6/14/16, JFO
8/7/24, JAM

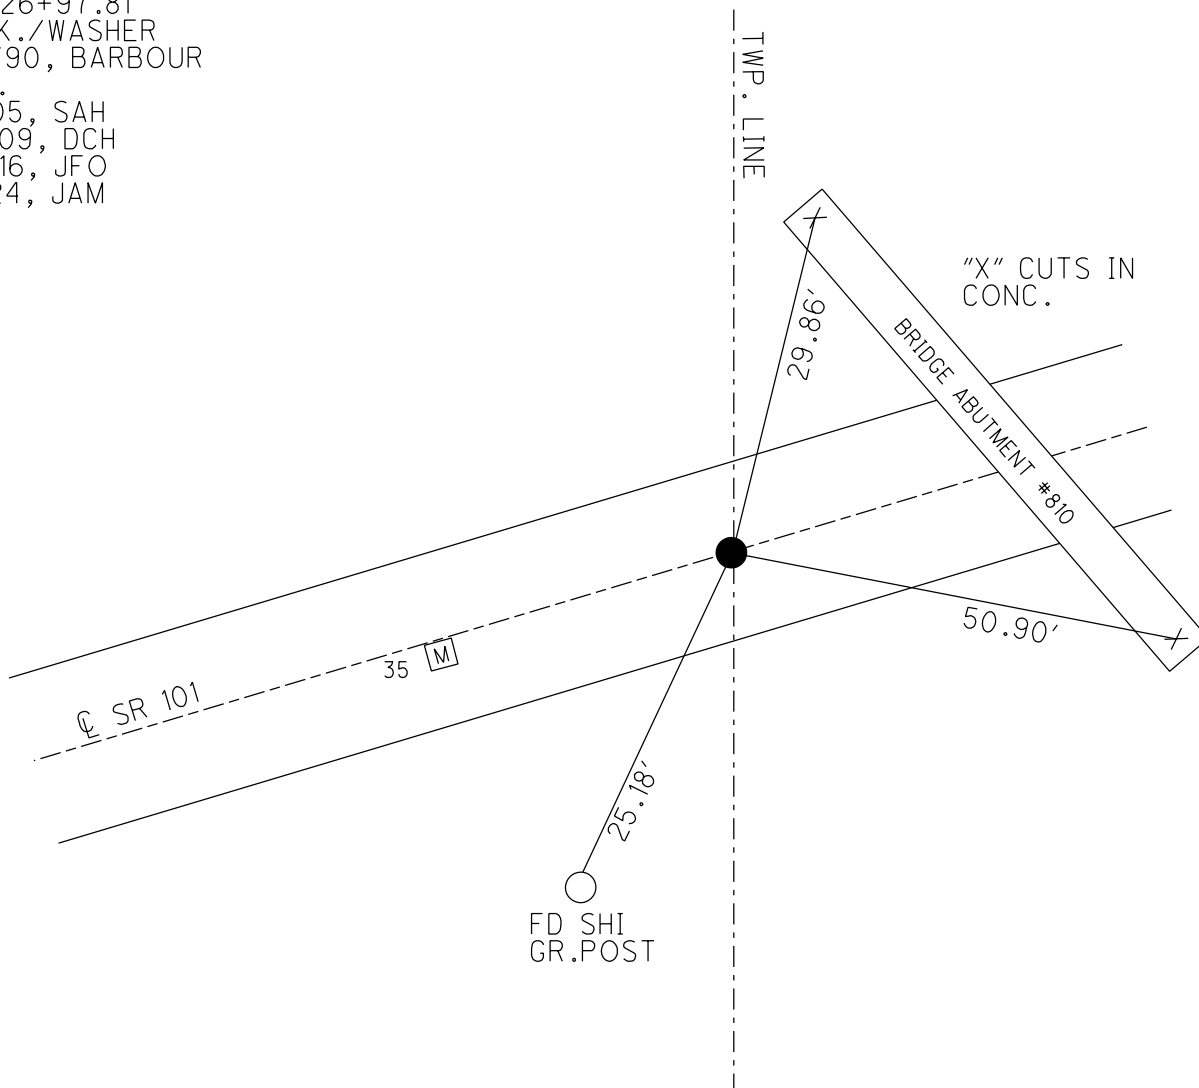

O.D.O.T. DISTRICT 2 SURVEY OFFICE (USE ONLY)

PERSONNEL

REFERENCE NO. 36

SHEET 13 OF 46

NOTES MILLER

DATE 8/7/24

ROUTE SR 101

H.C. MILLER

WEATHER WINDY/CLOUDY

COUNTY SENECA

R.C. BARRIERE

TEMP. 70°F

TOWNSHIP PLEASENT

BLUBAUGH, ASTON, PRESTON-COLVIN

SECTION 25

DWG BY BLUBAUGH

PID 114849

T 3 N R 15 E

TYPE MONUMENT MAG/WASHER

ON SURFACE - ~~BELOW~~ 0.5"

OFFSET $\mathcal{C}$ PAVEMENT ON LT : RT

-- TO -- EDGE PAVEMENT

STATION: 438+11

HORIZ.DATUM: NAD83 (2011)


GEOID: NAVD88-2018

GRID: NORTHING: 556296.638


EASTING: 1811336.255

LDP: NORTHING: 325244.535

EASTING: 185767.942

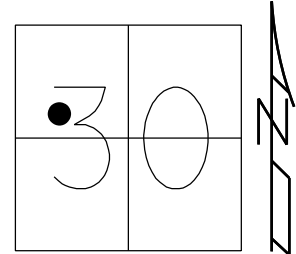

RECORD: P.O.T.
STA. 440+00
FD P.K.NAIL
SET P.K./WASHER
8/27/90, BARBOUR
FD P.K./WASHER
REF36
7/14/09, DCH
SET MAG/WASHER
NEWREF36
11/4/09, DCH
FD MAG/WASHER
REF36
6/14/16
9/18/17, JFO
FD MAG/WASHER
REF36
12/14/23, JAM
FD TONE. DID NOT
UNCOVER, PAINTED
8/7/24, JAM

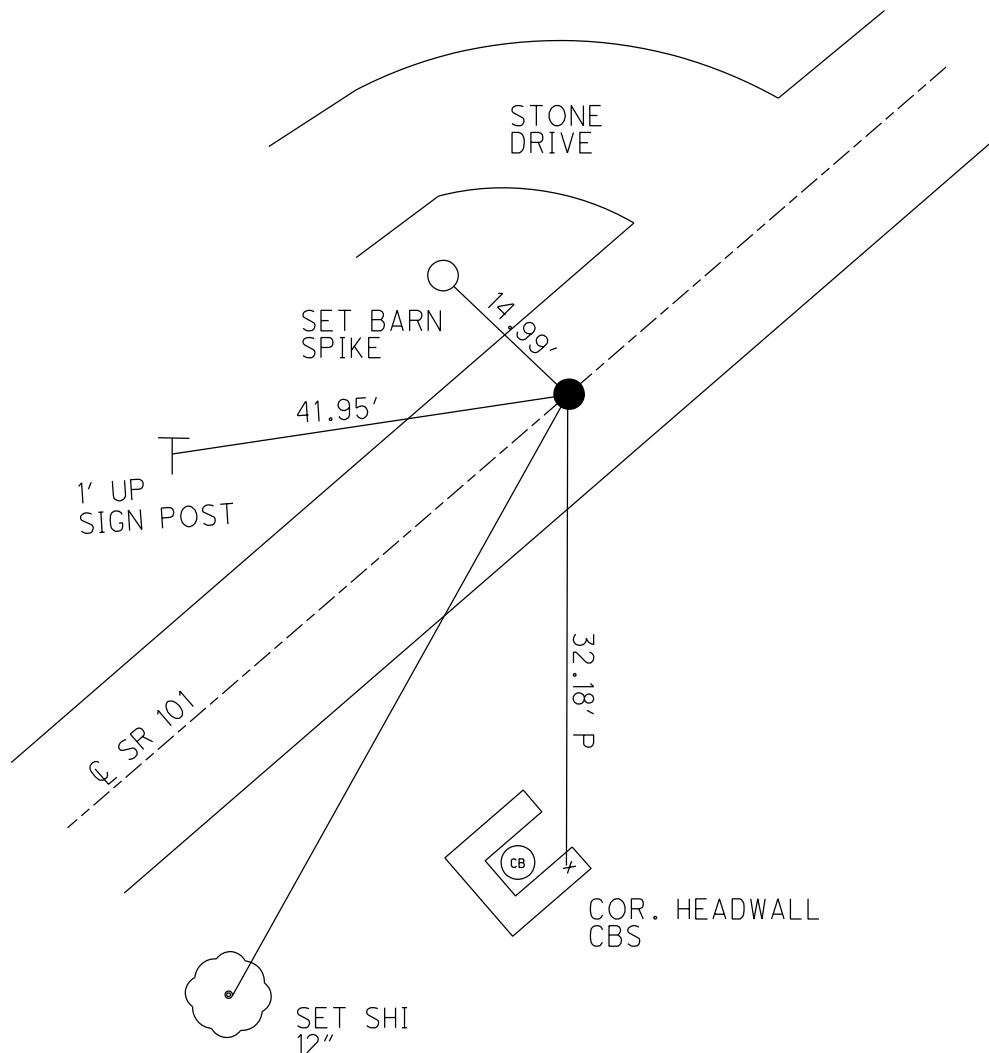

O.D.O.T. DISTRICT 2 SURVEY OFFICE (USE ONLY)

PERSONNEL

REFERENCE NO. 37

SHEET 14 OF 46

NOTES MILLER DATE 8/7/24

H.C. MILLER WEATHER SUNNY

R.C. BARRIERE TEMP. 75°F

BLUBAUGH, ASTON, PRESTON-COLVIN

DWG BY BLUBAUGH PID 114849

ROUTE SR 101

COUNTY SENECA

TOWNSHIP ADAMS

SECTION 30

T 3 N R 16 E

TYPE MONUMENT MAG/WASHER

ON SURFACE - ~~BELOW~~ 0.5"

OFFSET $\mathcal{C}$ PAVEMENT ON LT : RT

 TO EDGE PAVEMENT

STATION: 445+55

HORZ.DATUM: NAD82 (2011)


GEOID: NAVD88-2018

GRID: NORTHING: 556869.989


EASTING: 1811808.728

LDP: NORTHING: 325821.447

EASTING: 186236.180

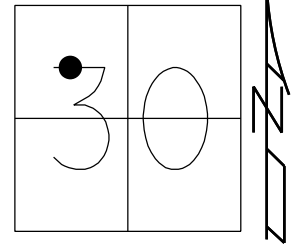

RECORD: P.I.
STA. 447+43.01
 $\Delta = 1^{\circ} 31' 30''$
FD 1/2" IPIN
SET P.K./WASHER
8/27/90, BARBOUR
FD P.K./WASHER
2/4/05, SAH
FD P.K./WASHER
REF37
7/14/09, DCH
SET MAG/WASHER
NEWREF37
10/8/09, DCH
FD MAG/WASHER
REF37
6/14/16
9/18/17, JFO
FD MAG/WASHER
REF37
12/14/23, JAM
FD TONE. DID
NOT UNCOVER.
PAINTED
8/7/24, JAM

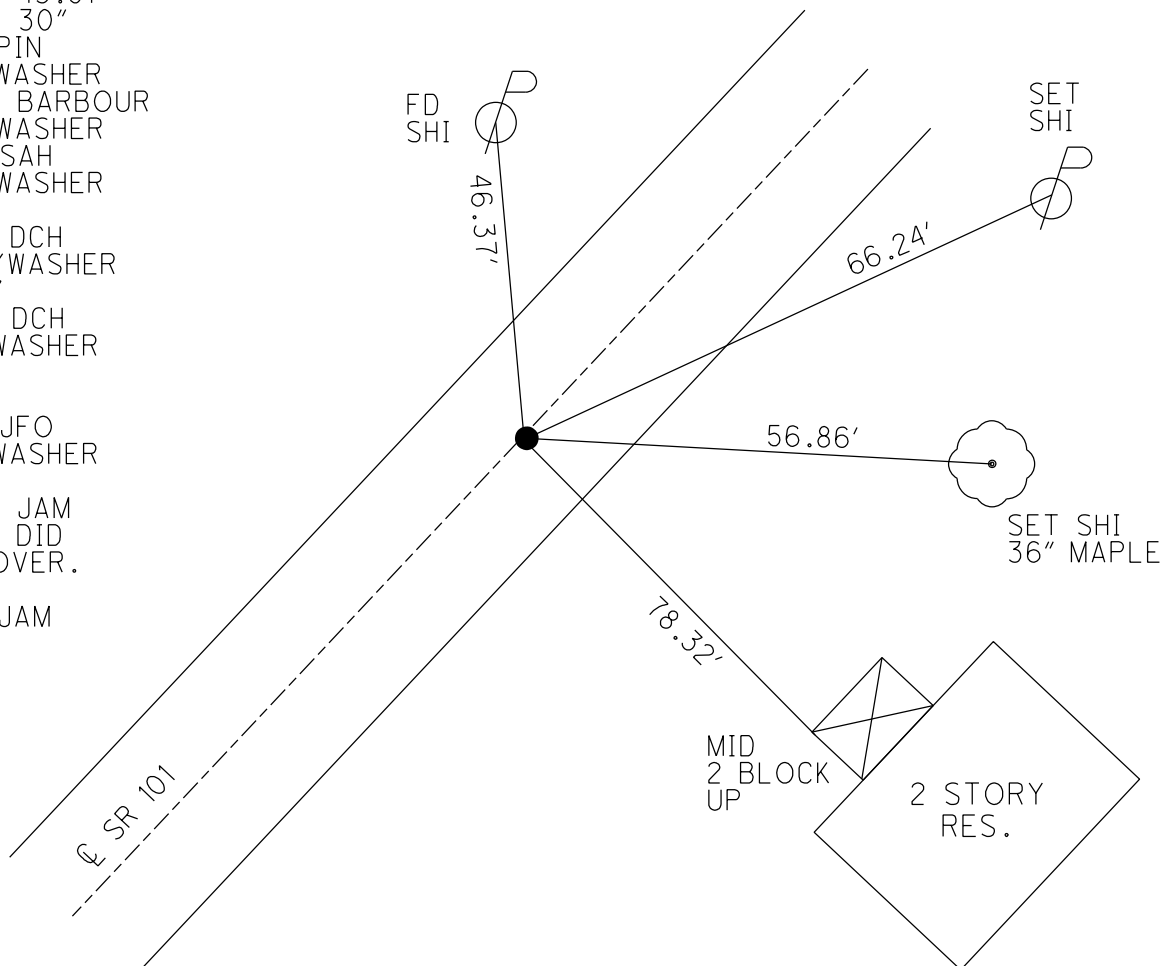

O.D.O.T. DISTRICT 2 SURVEY OFFICE (USE ONLY)

PERSONNEL

REFERENCE NO. 37 A

SHEET 15 OF 46

NOTES MILLER

DATE 8/7/24

ROUTE SR 101

H.C. MILLER

WEATHER CLOUDY/WINDY

COUNTY SENECA

R.C. BARRIERE

TEMP. 75°F

TOWNSHIP ADAMS

BLUBAUGH, ASTON, PRESTON-COLVIN

SECTION 19

DWG BY BLUBAUGH

PID 114849

T 3 N R 16 E

TYPE MONUMENT MAG/WASHER

ON SURFACE - ~~BELOW~~ 0.5"

OFFSET $\mathcal{C}$ PAVEMENT 0.8' LT : ~~RT~~

-- TO -- EDGE PAVEMENT

STATION: 467+46

HORZ.DATUM: NAD82 (2011)


GEOID: NAVD88-2018

GRID: NORTHING: 558520.901


EASTING: 1813244.488

LDP: NORTHING: 327483.187

EASTING: 187659.745

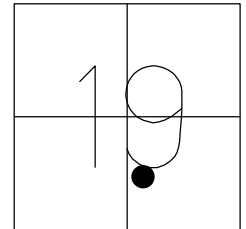

RECORD:
FD P.K.NAIL
REFA38
7/21/09, DCH
SET MAG/WASHER
NEWREFA38
10/8/09, DCH
FD MAG/WASHER
REFA37
6/14/16
9/18/17, JFO
FD MAG/WASHER
REF37A
12/14/23, JAM
FD TONE. DID NOT
UNCOVER. PAINTED
8/7/24, JAM

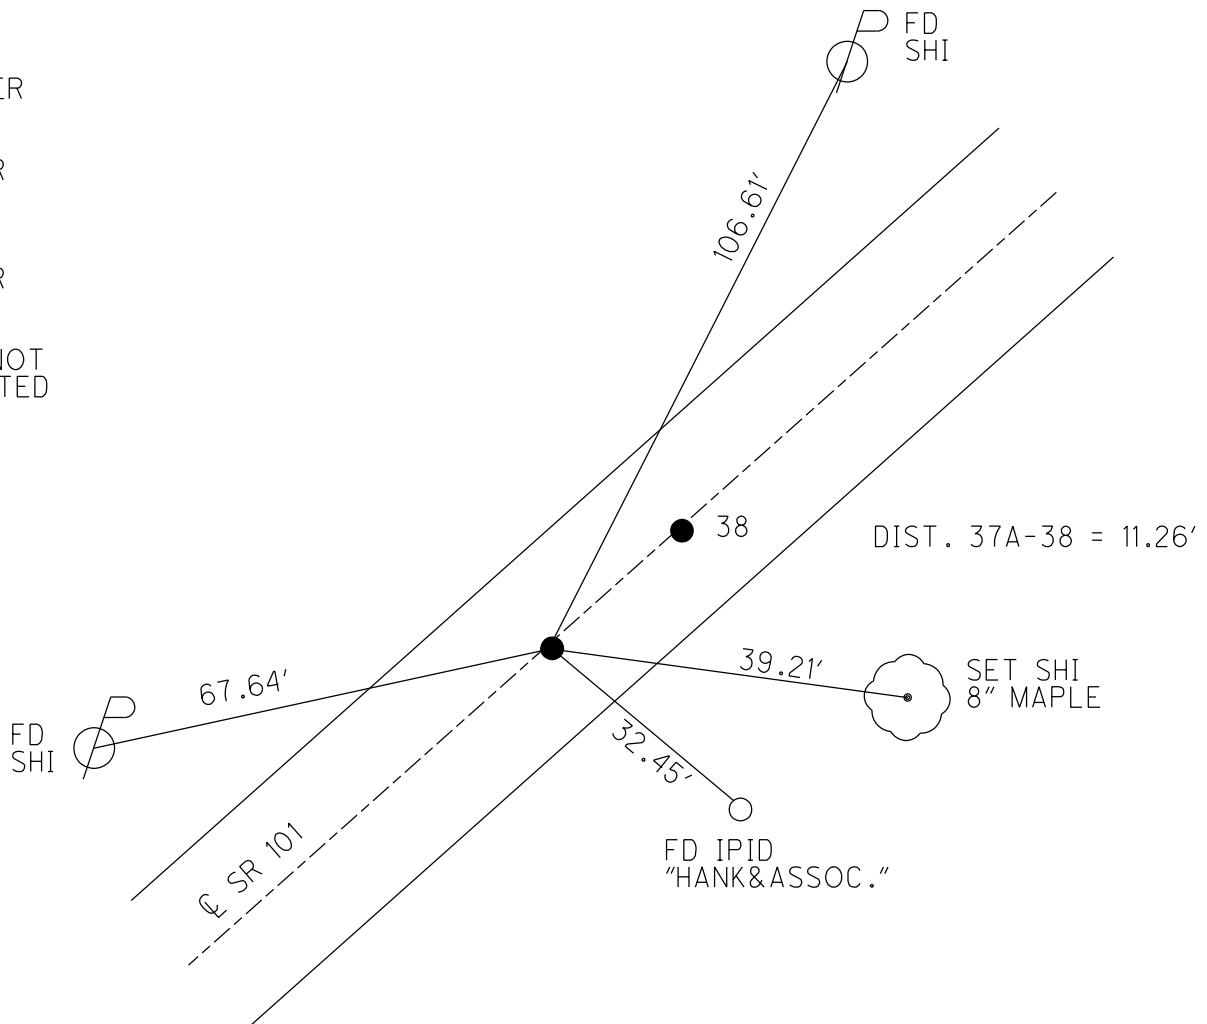

O.D.O.T. DISTRICT 2 SURVEY OFFICE (USE ONLY)

PERSONNEL

REFERENCE NO. 38

SHEET 16 OF 46

NOTES MILLER

DATE 8/7/24

ROUTE SR 101

H.C. MILLER

WEATHER CLOUDY/WINDY

COUNTY SENECA

R.C. BARRIERE

TEMP. 75°F

TOWNSHIP ADAMS

BLUBAUGH, ASTON, PRESTON-COLVIN

SECTION 19

DWG BY BLUBAUGH

PID 114849

T 3 N R 16 E

TYPE MONUMENT MAG/WASHER

ON SURFACE - ~~BELOW~~ 0.5"

OFFSET $\mathcal{C}$ PAVEMENT 1' LT : ~~RT~~

-- TO -- EDGE PAVEMENT

STATION: 467+57

HORZ.DATUM: NAD83 (2011)


GEOID: NAVD88-2018

GRID: NORTHING: 558528.393


EASTING: 1813251.893

LDP: NORTHING: 327491.74

EASTING: 187667.048

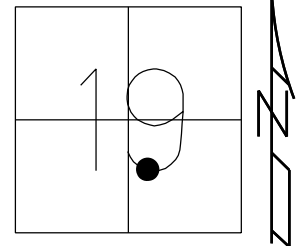

RECORD: P.I.
STA. 44+76.8
STA. 469+42.37
FD IPIN
SET P.K./WASHER
8/27/90
FD P.K./WASHER
2/4/05, SAH
FD P.K./WASHER
REF38
7/21/09, DCH
SET MAG/WASHER
NEWREF38
10/8/09, DCH
FD MAG/WASHER
REF38
6/14/16
9/18/17, JFO
FD MAG/WASHER
REF38
12/14/23, JAM
FD TONE. DID NOT
UNCOVER. PAINTED
8/7/24, JAM

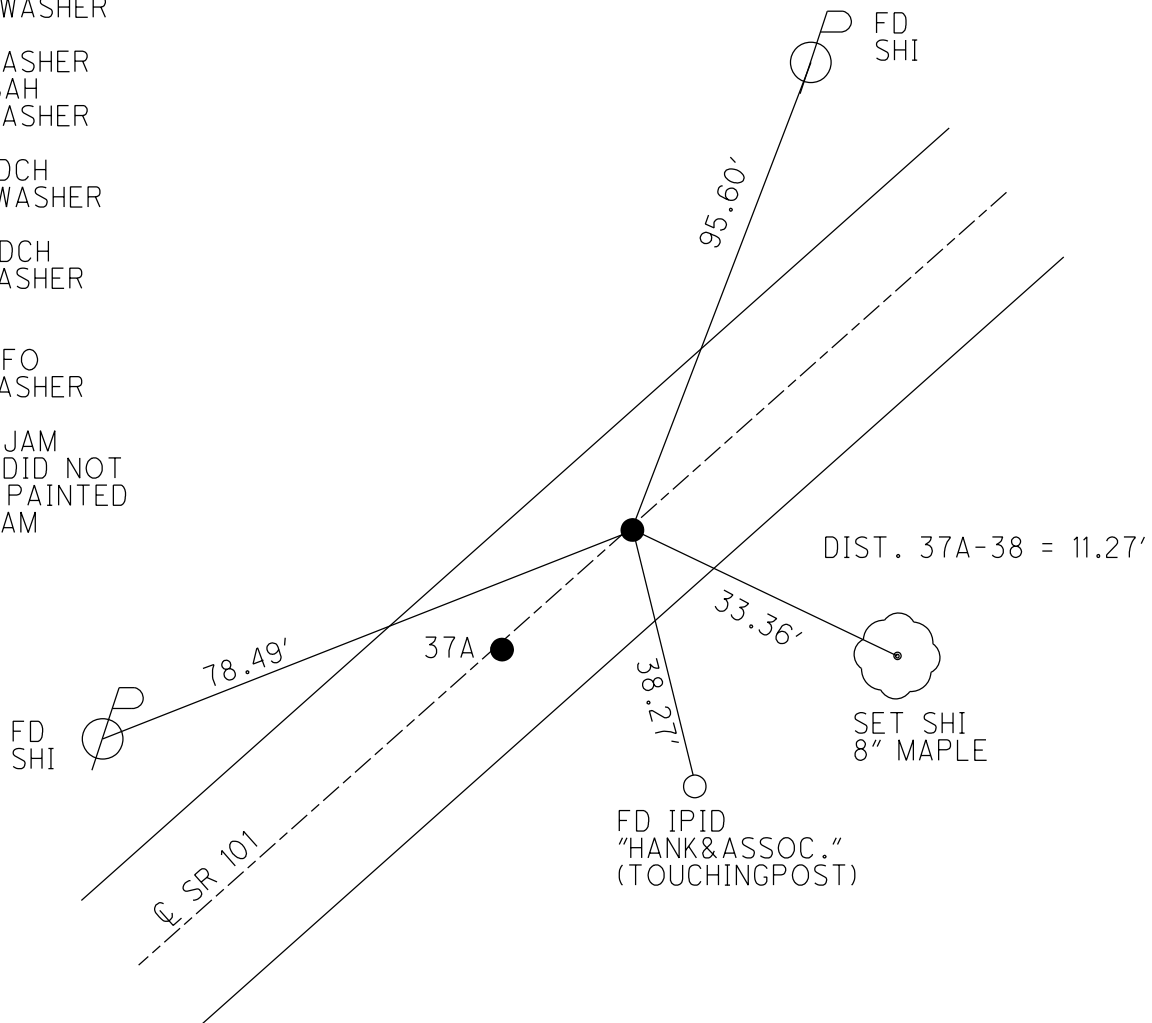

O.D.O.T. DISTRICT 2 SURVEY OFFICE (USE ONLY)

PERSONNEL

REFERENCE NO. 39

SHEET 17 OF 46

NOTES MILLER

DATE 8/7/24

ROUTE SR 101

H.C. MILLER

WEATHER CLOUDY/WINDY

COUNTY SENECA

R.C. BARRIERE

TEMP. 70°F

TOWNSHIP ADAMS

BLUBAUGH, ASTON, PRESTON-COLVIN

SECTION 19

DWG BY BLUBAUGH

PID 114849

T 3 N R 16 E

TYPE MONUMENT MAG/WASHER

ON SURFACE - ~~BELOW~~ ON

OFFSET $\mathcal{C}$ PAVEMENT ON LT : RT

-- TO -- EDGE PAVEMENT

STATION: 494+89

HORZ.DATUM: NAD83 (2011)


GEOID: NAVD88-2018

GRID: NORTHING: 560572.335


EASTING: 1815060.100

LDP: NORTHING: 329548.246

EASTING: 189460.172

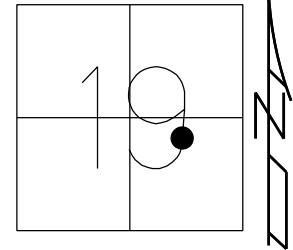

RECORD:
STA. 64+05.92
FD MINE SPIKE
SET P.K./WASHER
8/27/90, BARBOUR
FD P.K./WASHER
2/4/05, SAH
FD P.K./WASHER
REF39
7/21/09, DCH
SET MAG/WASHER
NEWREF39
10/8/09, DCH
FD MAG/WASHER
REF39
6/14/16
9/18/17, JFO
FD MAG/WASHER
REF39
12/14/23, JAM
FD TONE. DID
NOT UNCOVER
PAINTED
8/7/24, JAM

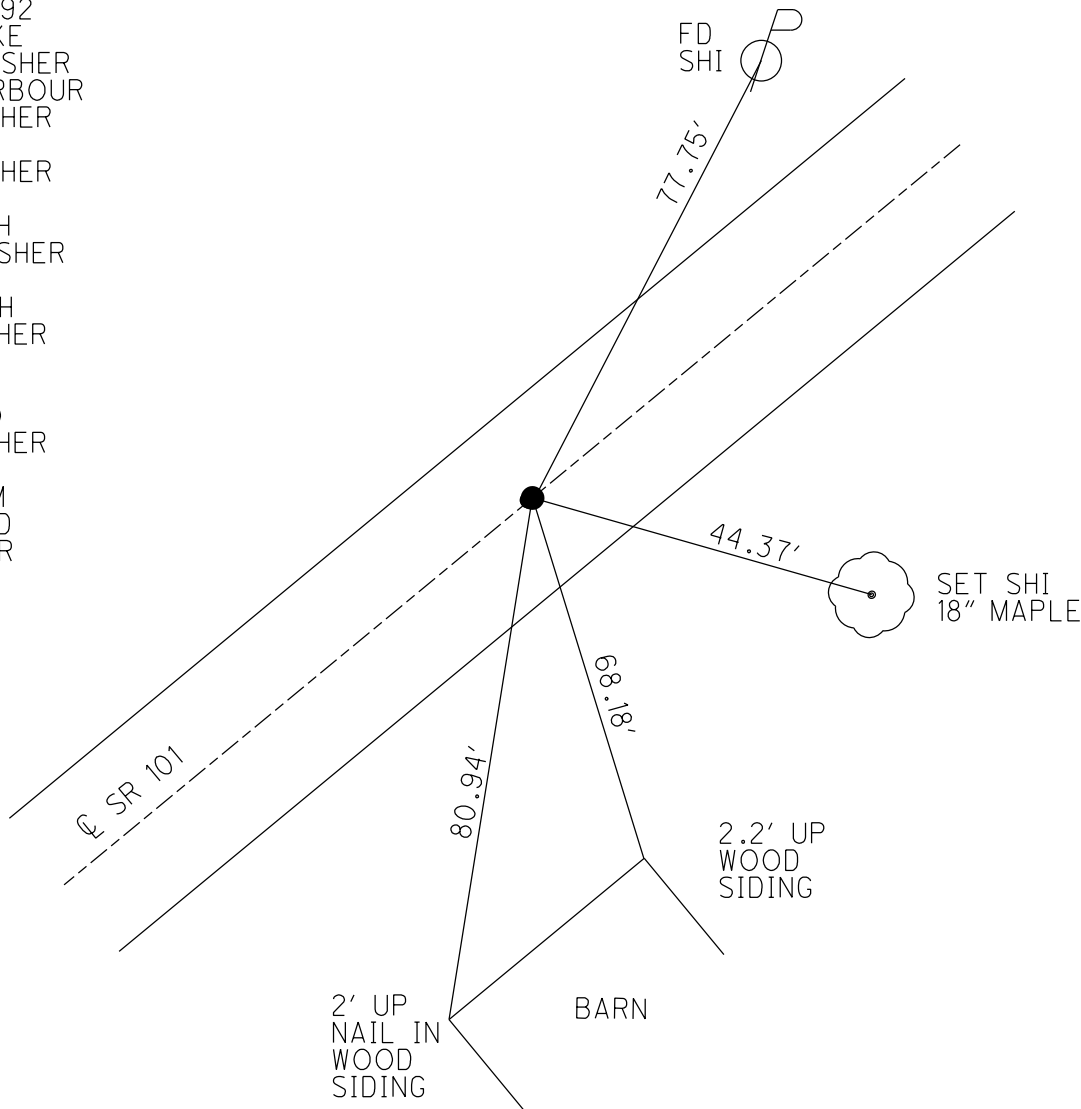

O.D.O.T. DISTRICT 2 SURVEY OFFICE (USE ONLY)

PERSONNEL

REFERENCE NO. 40

SHEET 18 OF 46

NOTES MILLER

DATE 8/7/24

ROUTE SR 101

H.C. MILLER
D.O.

WEATHER CLOUDY/WINDY

COUNTY SENECA

R.C. BARRIERE
PLUMBING & HEATING ACTON BRESTON

TEMP. 70°F
COL VIN

TOWNSHIP ADAMS
SECTION 16

BLUBAUGH, ASTON, PRESTON-COLVIN

DWG BY BLUBAUGH

PID 114849

T₃ N R₁₆ F

TYPE MONUMENT MAG/WASHER

~~ON SURFACE~~ - BELOW 0.5"

OFFSET $\frac{1}{4}$ PAVEMENT ON LT : RT

---TO--- EDGE PAVEMENT

STATION: 509+76



HORZ.DATUM: NAD83 (2011)

GEOID: NAVD88-2018

GRID: NORTHING: 561671.714

EASTING: 1816059.780

LDP: NORTHING: 330655.180

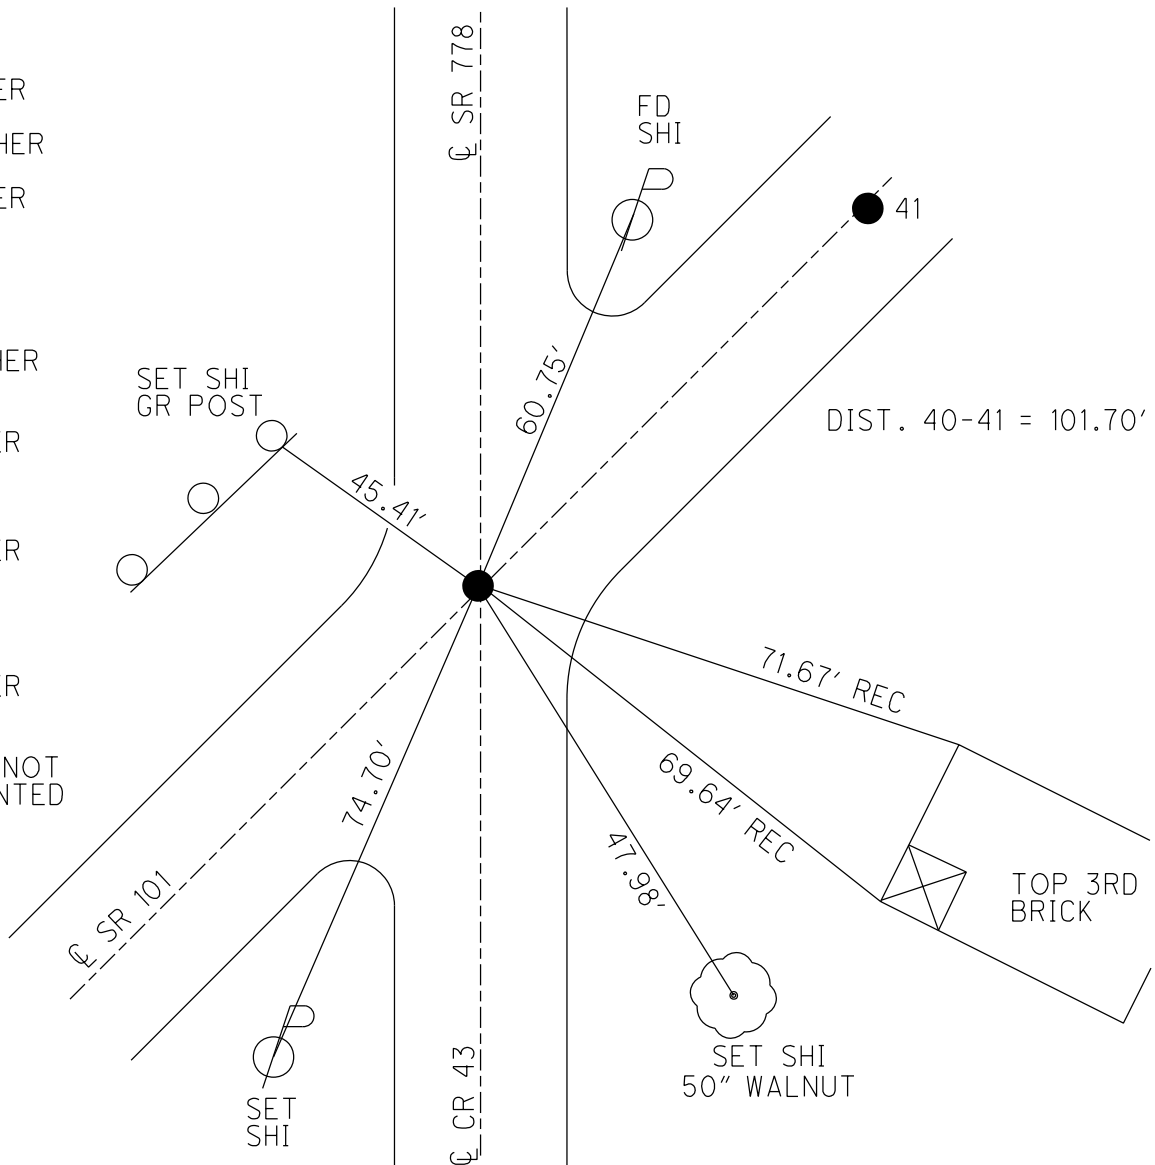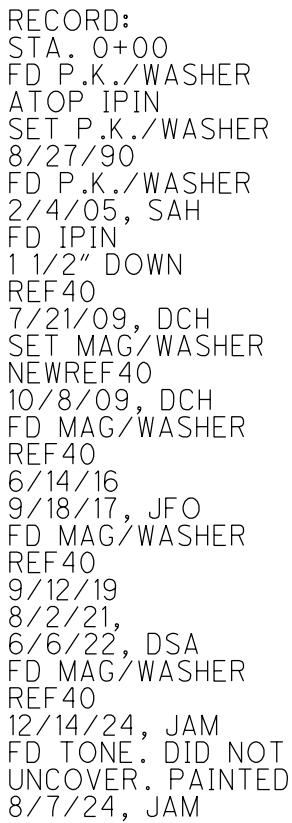EASTING: 190451.695

O.D.O.T. DISTRICT 2 SURVEY OFFICE (USE ONLY)

PERSONNEL

REFERENCE NO. 41

SHEET 19 OF 46

NOTES MILLER

DATE 8/7/24

ROUTE SR 101

H.C. MILLER

WEATHER CLOUDY/WINDY

COUNTY SENECA

R.C. BARRIERE

TEMP. 85°F

TOWNSHIP ADAMS

BLUBAUGH, ASTON, PRESTON-COLVIN

SECTION 20

DWG BY BLUBAUGH

PID 114849

T 3 N R 16 E

TYPE MONUMENT MAG/WASHER

ON SURFACE - ~~BELOW~~ 0.5"

OFFSET $\mathcal{C}$ PAVEMENT 2' ~~LT~~ : RT

-- TO -- EDGE PAVEMENT

STATION: 510+78

HORIZ.DATUM: NAD83 (2011)



GEOID: NAVD88-2018

GRID: NORTHING: 561744.998

EASTING: 1816130.320

LDP: NORTHING: 330728.983

EASTING: 190521.663

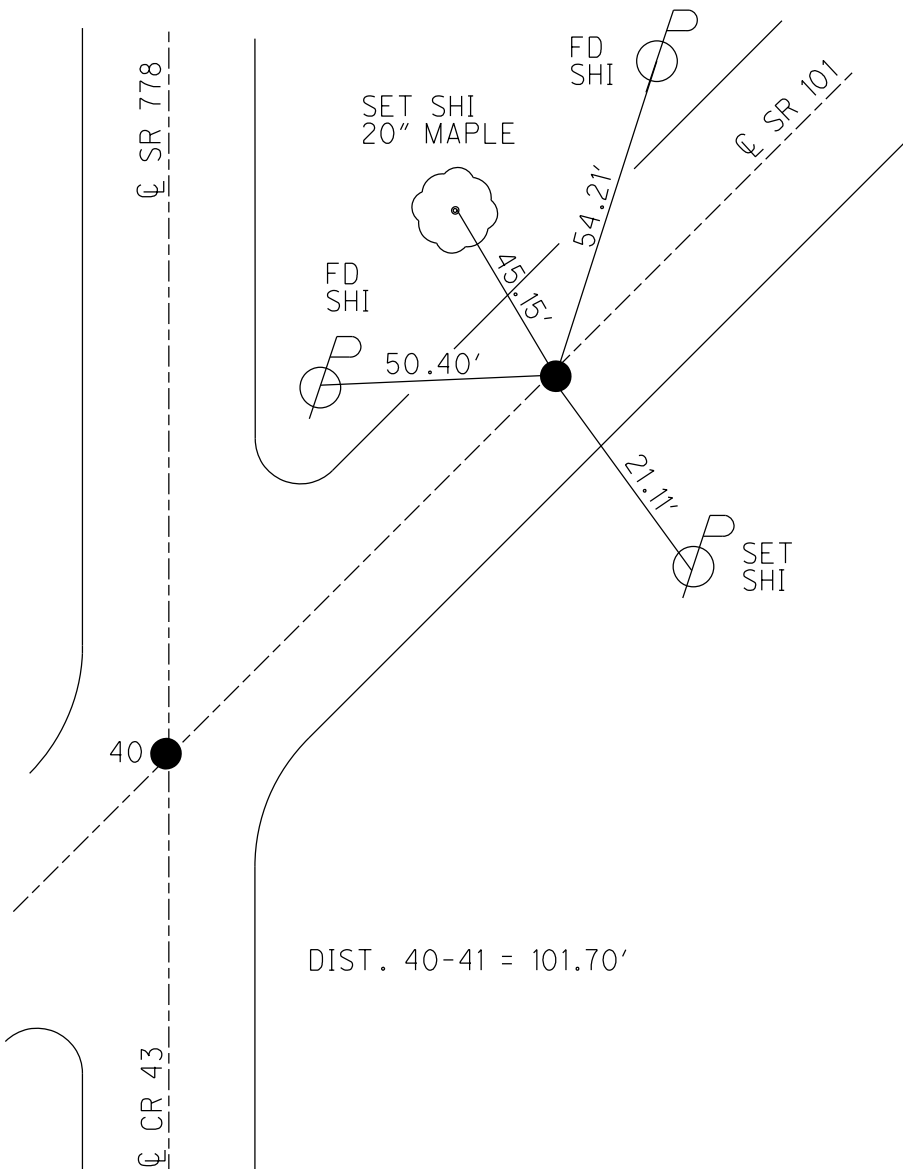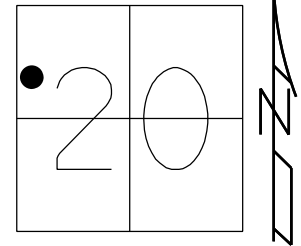

RECORD:
 STA. 1+00
 FD P.K.NAIL
 ATOP R.R.SPIKE
 SET P.K./WASHER
 8/27/90, BARBOUR
 FD P.K./WASHER
 2/7/05, SAH
 FD P.K./WASHER
 REF41
 7/21/09, DCH
 SET MAG/WASHER
 NEWREF41
 10/8/09, DCH
 FD MAG/WASHER
 REF41
 6/14/16
 9/18/17, JFO
 FD MAG/WASHER
 REF 41
 9/12/19
 8/2/21,
 6/6/22, DSA
 FD MAG/WASHER
 REF41
 12/14/23, JAM
 FD TONE. DID NOT
 UNCOVER PAINTED
 8/7/24, JAM

O.D.O.T. DISTRICT 2 SURVEY OFFICE (USE ONLY)

PERSONNEL

REFERENCE NO. 42

SHEET 20 OF 46

NOTES MILLER

DATE 8/7/24

ROUTE SR 101

H.C. MILLER
D.C. BARRIÈRE

WEATHER CLOUDY/WINDY

COUNTY SENECA

R.C. BARRIERE
BLUBAUGH ACTON DIRECTOR

TEMP. 70°F

TOWNSHIP ADAMS
SECTION 22

BLUBAUGH, ASTON, PRESTON-COLVIN

DWG BY BLUBAUGH

PID 114849

T³ N¹ R¹⁶ F

TYPE MONUMENT MAG/WASHER

ON SURFACE - ~~BELOW~~ 0.5"

OFFSET $\frac{1}{2}$ PAVEMENT _____ ON _____ LT : RT


____TO____EDGE PAVEMENT

STATION: 517+79


HORZ.DATUM: NAD83 (2011)

GEOID: NAVD88-2018A

GRID: NORTHING: 562272.665

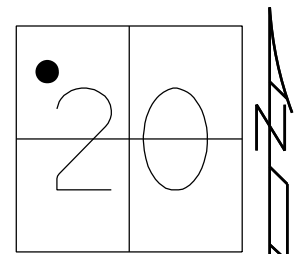EASTING: 1816590.285LDP: NORTHING: 331260.138EASTING: 190977.749

RECORD:
STA.8+00
FD P.K./WASHER
ATOP R.R.SPIKE
SET P.K./WASHER
8/27/90
FD P.K./WASHER
2/7/05, SAH
FD P.K./WASHER
REF42
7/21/09, DCH
SET MAG/WASHER
NEWREF42
10/5/09, DCH
FD MAG/WASHER
REF42
6/14/16
9/18/17, JFO
FD MAG/WASHER
REF 42
9/25/2019, JLL
8/2/21,
6/6/22, DSA
FD MAG/WASHER
REF42
12/14/23, JAM
FD TONE. DID NOT
UNCOVER. PAINTED
8/7/24, JAM

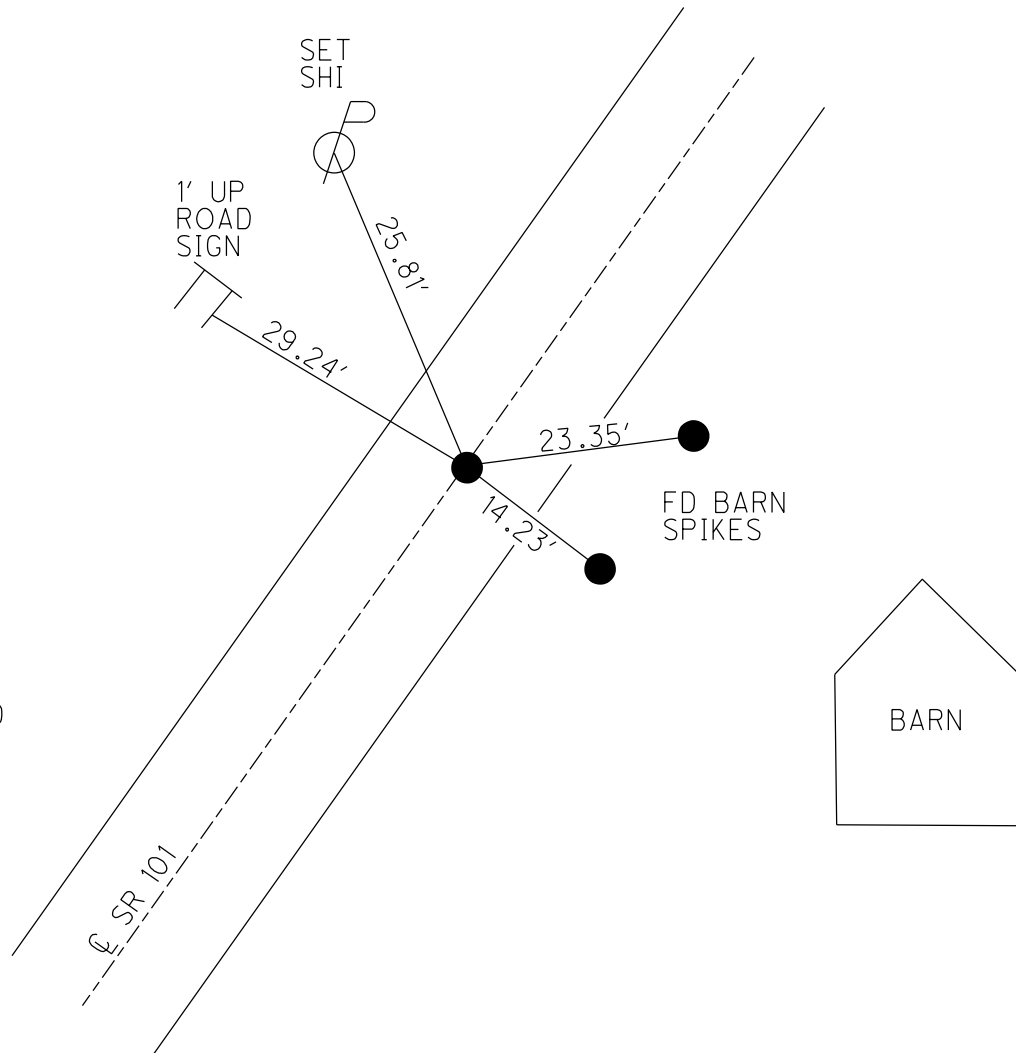

O.D.O.T. DISTRICT 2 SURVEY OFFICE (USE ONLY)

PERSONNEL

REFERENCE NO. 43

SHEET 21 OF 46

NOTES MILLER

DATE 8/7/24

ROUTE SR 101

H.C. MILLER

WEATHER WINDY

COUNTY SENECA

R.C. BARRIERE

TEMP. 70°F

TOWNSHIP ADAMS

BLUBAUGH, ASTON, PRESTON-COLVIN

SECTION 20

DWG BY BLUBAUGH

PID 114849

T 3 N R 16 E

TYPE MONUMENT R.R.SPIKE

~~ON SURFACE~~ - BELOW 7.5"

OFFSET $\odot$ PAVEMENT 1.1' LT : ~~RT~~

10.7' TO LT EDGE PAVEMENT

STATION: 531+16

HORIZ.DATUM: NAD83 (2011)


GEOID: NAVD88-2018

GRID: NORTHING: 563284.576

EASTING: 1817480.462

LDP: NORTHING: 332279.006

EASTING: 191860.486

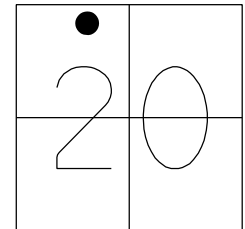

RECORD:

STA. 21+50

FD P.K.NAIL

ATOP R.R.SPIKE

SET P.K./WASHER

8/27/90

FD P.K./WASHER

2/7/05, SAH

FD P.K./WASHER

REF43

7/21/09, DCH

SET MAG/WASHER

NEWREF43

10/5/09, DCH

D.N.F.

6/14/16, JFO

FD R.R.SPIKE

7 1/4" DOWN

REF 43

9/25/19, JLL

FD R.R.SPIKE

REF 43

8/2/21,

6/6/22, DSA

FD R.R.SPIKE


REF43

12/14/23, JAM

FD TONE. DID NOT

UNCOVER. PAINT

8/7/24, JAM

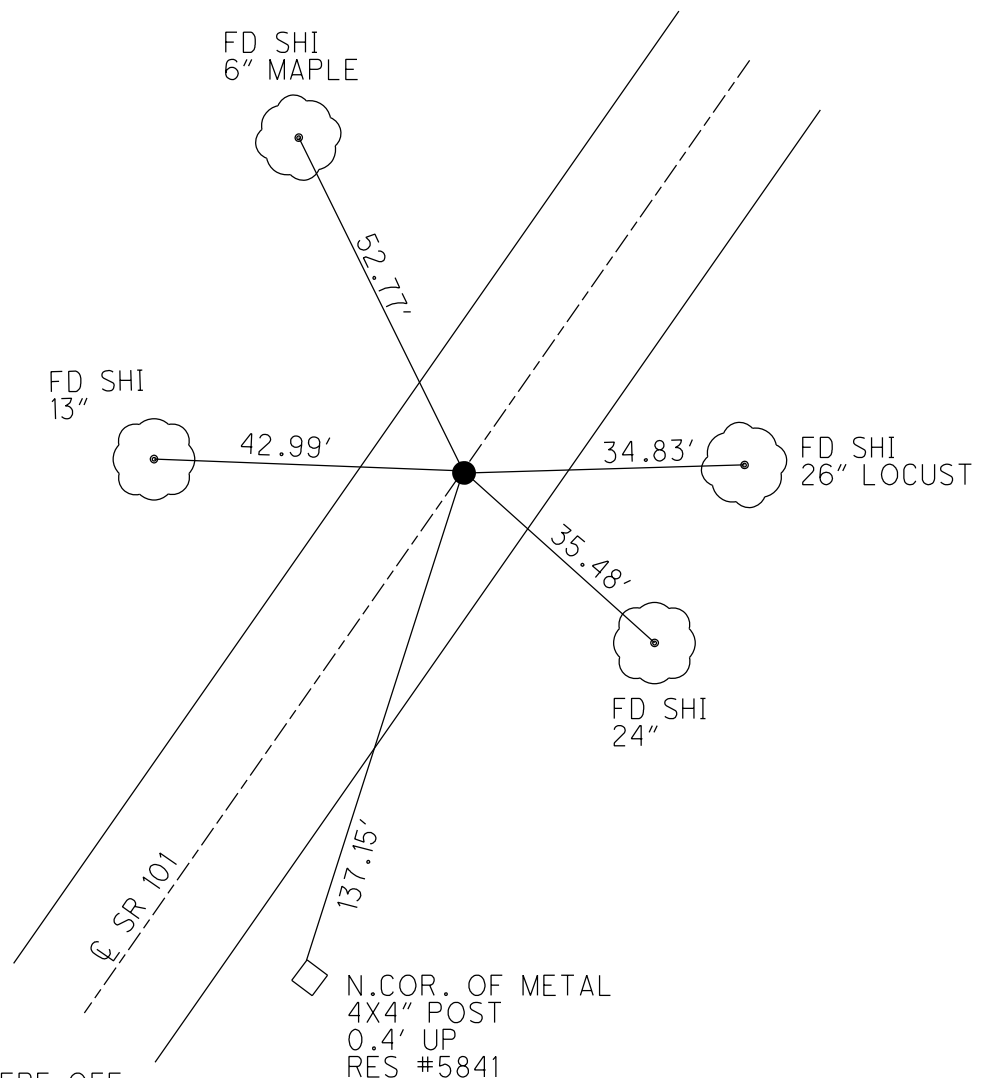

*PULLED TIES TO SET. TIES WERE OFF

O.D.O.T. DISTRICT 2 SURVEY OFFICE (USE ONLY)

PERSONNEL

REFERENCE NO. 44

SHEET 22 OF 46

NOTES MILLER

DATE 8/7/24

ROUTE SR 101

H.C. MILLER

WEATHER WINDY

COUNTY SENECA

R.C. BARRIERE

TEMP. 70°F

TOWNSHIP ADAMS

BLUBAUGH, ASTON, PRESTON-COLVIN

SECTION 20

DWG BY BLUBAUGH

PID 114849

T 3 N R 16 E

TYPE MONUMENT MAG/WASHER

ON SURFACE - ~~BELOW~~ 0.5"

OFFSET Q PAVEMENT 3 1/2' LT : ~~RT~~

-- TO -- EDGE PAVEMENT

STATION: 538+80

HORIZ.DATUM: NAD83 (2011)


GEOID: NAVD88-2018

GRID: NORTHING: 563802.121


EASTING: 1818022.071

LDP: NORTHING: 332800.360

EASTING: 192398.206

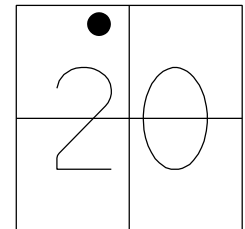

RECORD: P.I.
STA. 29+00
FD P.K./WASHER
ATOP R.R.SPIKE
SET P.K./WASHER
8/27/90
FD P.K./WASHER
2/7/05, SAH
FD P.K./WASHER
REF44
7/21/09, DCH
SET MAG/WASHER
NEWREF44
10/5/09, DCH
FD MAG/WASHER
REF44
6/14/16
9/18/17, JFO
FD MAG/WASHER
REF 44
9/25/19, JLL
8/02/21,
6/6/22, DSA
FD MAG/WASHER
REF44
12/14/23, JAM
FD TONE. DID NOT
UNCOVER. PAINTED
8/7/24
FD MAG/WASHER
REF 44
12/14/23, JAM
FD TONE. DID NOT
UNCOVER. PAINTED
8/7/24, JAM

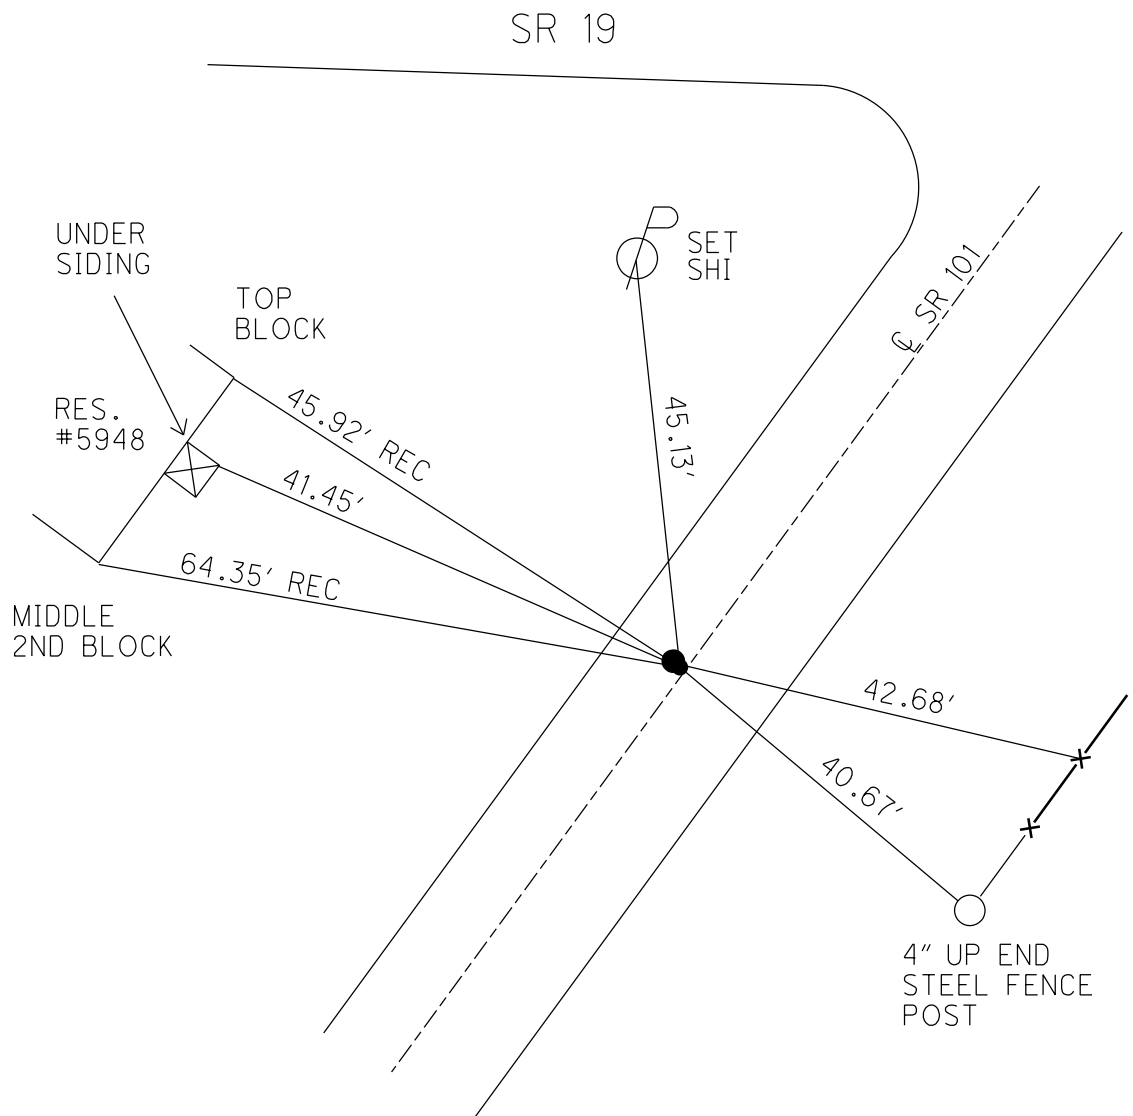

O.D.O.T. DISTRICT 2 SURVEY OFFICE (USE ONLY)

PERSONNEL

REFERENCE NO. 45

SHEET 23 OF 46

NOTES MILLER

DATE 8/7/24

ROUTE SR 101

H.C. MILLER

WEATHER WINDY

COUNTY SENECA

R.C. BARRIERE

TEMP. 70°F

TOWNSHIP ADAMS

BLUBAUGH, ASTON, PRESTON-COLVIN

SECTION 17

DWG BY BLUBAUGH

PID 114849

T 3 N R 16 E

TYPE MONUMENT MAG/WASHER

ON SURFACE - ~~BELOW~~ 0.5"

OFFSET Q PAVEMENT 1' LT : RT

-- TO -- EDGE PAVEMENT

STATION: 555+77

HORIZ.DATUM: NAD83 (2011)


GEOID: NAVD88-2018

GRID: NORTHING: 564794.453


EASTING: 1819400.025

LDP: NORTHING: 333803.017

EASTING: 193768.882

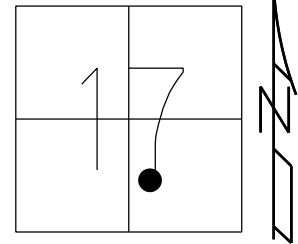

RECORD:
 STA. 46+00
 FD P.K.NAIL
 ATOP R.R.SPIKE
 SET P.K./WASHER
 8/27/90, BARBOUR
 FD P.K./WASHER
 2/7/05, SAH
 FD P.K./WASHER
 REF45
 7/21/09, DCH
 SET MAG/WASHER
 NEWREF45
 10/5/09, DCH
 FD MAG/WASHER
 REF45
 6/14/16
 9/18/17, JFO
 FD MAG/WASHER
 REF 45
 9/25/19, JLL
 6/6/22, DSA
 FD MAG/WASHER
 REF 45
 12/14/23, JAM
 FD TONE. DID NOT
 UNCOVER. PAINTED
 8/7/24, JAM

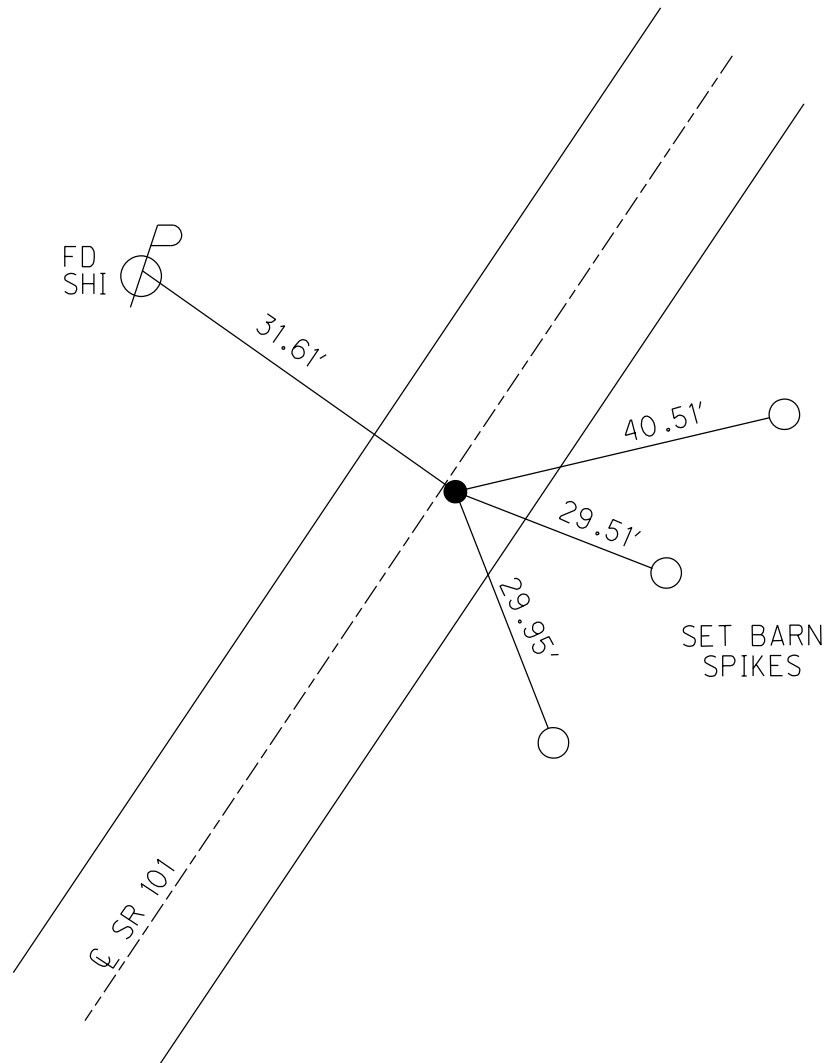

O.D.O.T. DISTRICT 2 SURVEY OFFICE (USE ONLY)

PERSONNEL

REFERENCE NO. 46

SHEET 24 OF 46

NOTES MILLER

DATE 8/7/24

ROUTE SR 101

H.C. MILLER

WEATHER WINDY

COUNTY SENECA

R.C. BARRIERE

TEMP. 70°F

TOWNSHIP ADAMS

BLUBAUGH, ASTON, PRESTON-COLVIN

SECTION 17

DWG BY BLUBAUGH

PID 114849

T 3 N R 16 E

TYPE MONUMENT MAG/WASHER

ON SURFACE - ~~BELOW~~ ON

OFFSET $\mathcal{C}$ PAVEMENT 1.5' LT : RT

-- TO -- EDGE PAVEMENT

STATION: 565+79

HORIZ.DATUM: NAD83 (2011)


GEOID: NAVD88-2018

GRID: NORTHING: 565434.287


EASTING: 1820169.785

LDP: NORTHING: 334448.639

EASTING: 194533.851

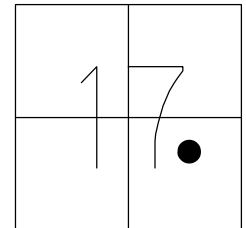

RECORD:
STA. 56+00
FD P.K.NAIL
ATOP R.R.SPIKE
SET P.K./WASHER
8/28/90
FD P.K./WASHER
2/7/05, SAH
FD P.K./WASHER
REF46
7/28/09, DCH
SET MAG/WASHER
NEWREF46
10/5/09, DCH
FD MAG/WASHER
REF46
6/14/16
9/18/17, JFO
REF46
12/13/23, JAM
FD TONE. DID NOT
UNCOVER. PAINTED
8/7/24, JAM

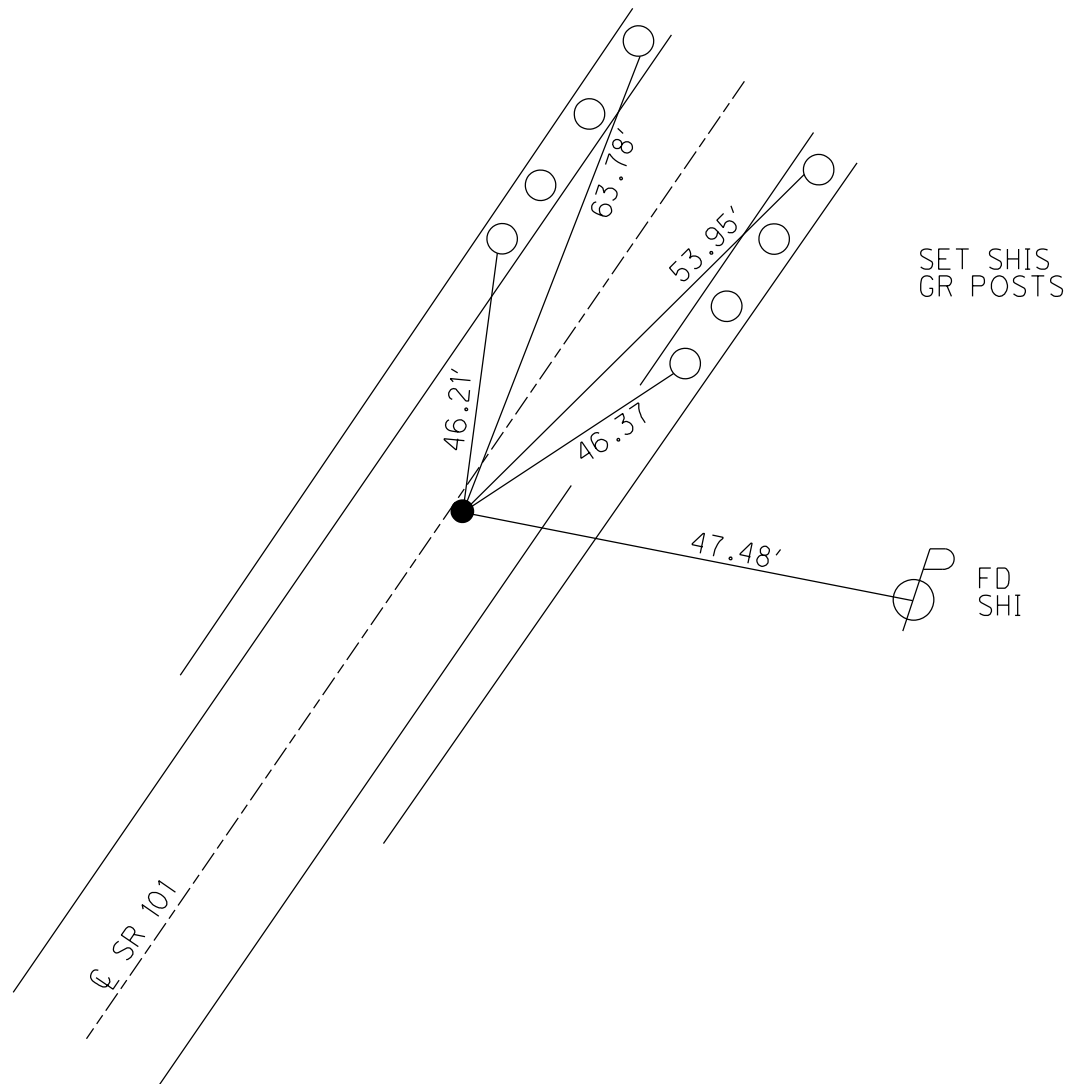

O.D.O.T. DISTRICT 2 SURVEY OFFICE (USE ONLY)

PERSONNEL

REFERENCE NO. 47

SHEET 24 OF 46

NOTES MILLER

DATE 8/7/24

ROUTE SR 101

H.C. MILLER

WEATHER WINDY

COUNTY SENECA

R.C. BARRIERE

TEMP. 70°F

TOWNSHIP ADAMS

BLUBAUGH, ASTON, PRESTON-COLVIN

SECTION 17

DWG BY BLUBAUGH

PID 114849

T 3 N R 16 E

TYPE MONUMENT MAG/WASHER

ON SURFACE - ~~BELOW~~ ON

OFFSET $\mathcal{C}$ PAVEMENT 1.5' LT : RT

-- TO -- EDGE PAVEMENT

STATION: 565+79

HORIZ.DATUM: NAD83 (2011)


GEOID: NAVD88-2018

GRID: NORTHING: 565434.287


EASTING: 1820169.785

LDP: NORTHING: 335455.602

EASTING: 195646.444

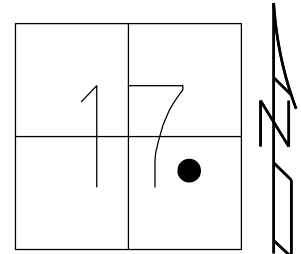

RECORD:
 STA. 56+00
 FD P.K.NAIL
 ATOP R.R.SPIKE
 SET SQ.HEADED
 NAIL/WASHER
 8/28/90, BARBOUR
 FD SQ.HEADED
 NAIL/WASHER
 2/7/05, SAH
 REF47
 7/28/09, DCH
 SET MAG/WASHER
 NEWREF47
 10/5/09, DCH
 FD MAG/WASHER
 REF47
 6/14/16
 9/18/17, JFO
 FD MAG/WASHER
 REF 47
 12/13/23, JAM
 FD TONE. DID NOT
 UNCOVER. PAINTED
 8/7/24, JAM

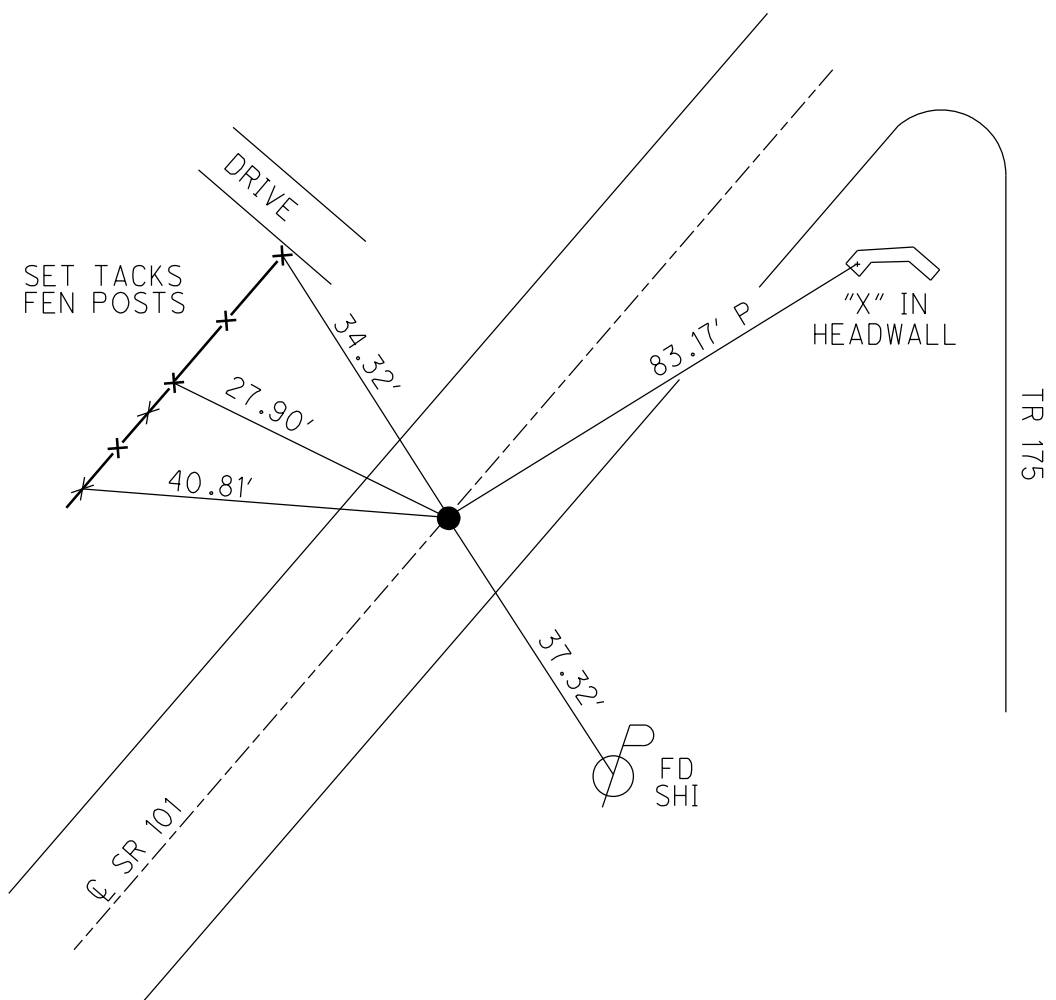

O.D.O.T. DISTRICT 2 SURVEY OFFICE (USE ONLY)

PERSONNEL

REFERENCE NO. 48

SHEET 26 OF 46

NOTES MILLER

DATE 8/7/24

ROUTE SR 101

H.C. MILLER

WEATHER WINDY

COUNTY SENECA

R.C. BARRIERE

TEMP. 70°F

TOWNSHIP ADAMS

BLUBAUGH, ASTON, PRESTON-COLVIN

SECTION 16

DWG BY BLUBAUGH

PID 114849

T 3 N R 16 E

TYPE MONUMENT MAG/WASHER

ON SURFACE - ~~BELOW~~ 0.5"

OFFSET Q PAVEMENT ON LT : RT

-- TO -- EDGE PAVEMENT

STATION: 590+83

HORIZ.DATUM: NAD83 (2011)


GEOID: NAVD88-2018

GRID: NORTHING: 567088.109


EASTING: 1822046.942

LDP: NORTHING: 336116.521

EASTING: 196398.794

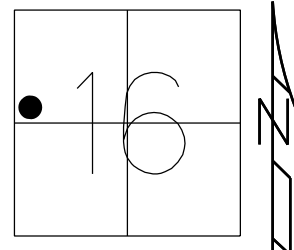

RECORD: P.O.T.
STA. 81+00
FD P.K.NAIL
ATOP R.R.SPIKE
SET SQ.HEADED
NAIL/WASHER
FD SQ.HEADED
NAIL/WASHER
2/7/05, SAH
REF48
7/28/09, DCH
SET MAG/WASHER
NEWREF48
10/6/09, DCH
FD MAG/WASHER
REF48
6/14/16
9/18/17, JFO
FD MAG/WASHER
REF48
12/13/23, JAM
FD TONE. DID NOT
UNCOVER. PAINTED
8/7/24, JAM

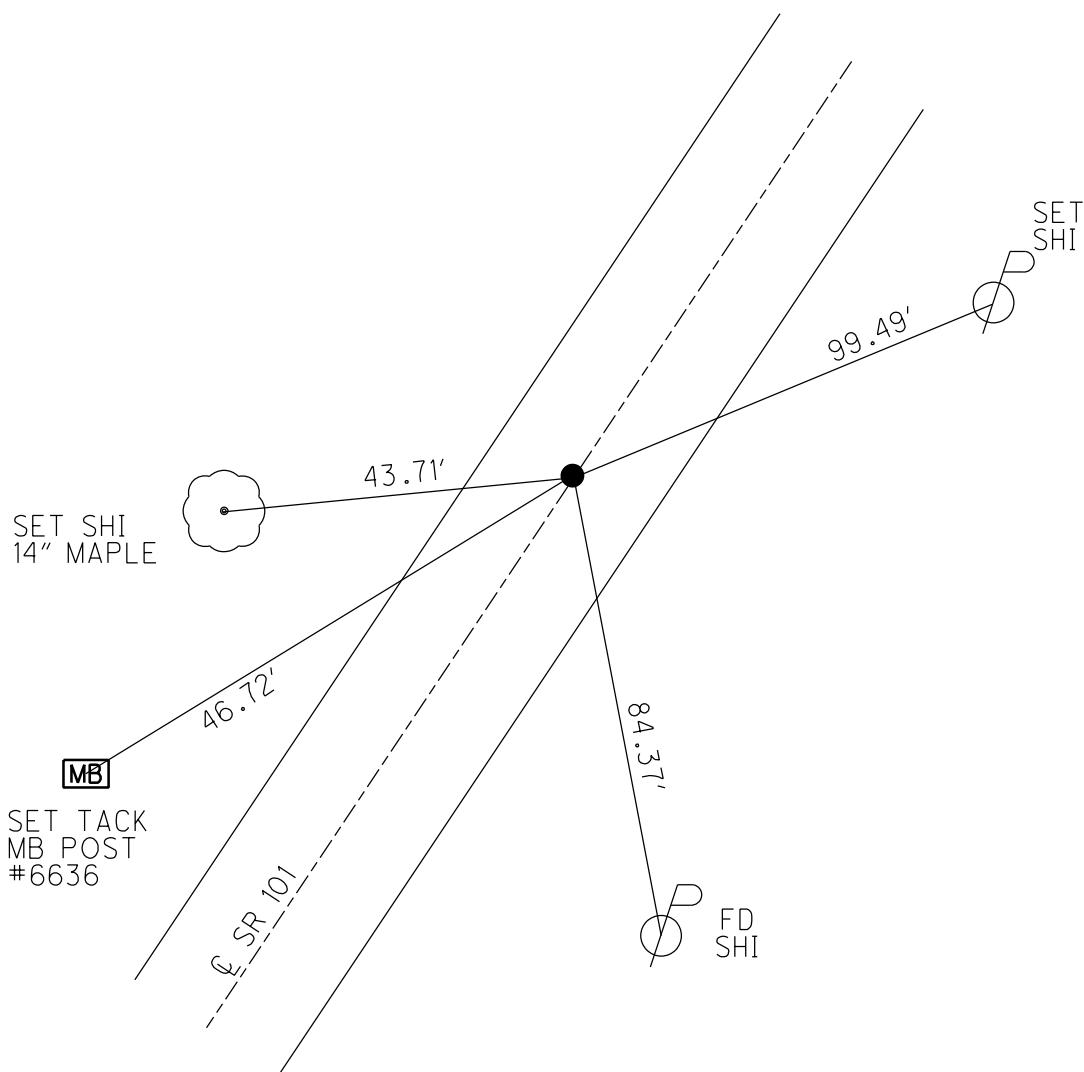

O.D.O.T. DISTRICT 2 SURVEY OFFICE (USE ONLY)

PERSONNEL

REFERENCE NO. 49

SHEET 27 OF 46

NOTES MILLER

DATE 8/7/24

ROUTE SR 101

H.C. MILLER

WEATHER WINDY

COUNTY SENECA

R.C. BARRIERE

TEMP. 34°F

TOWNSHIP ADAMS

BLUBAUGH, ASTON, PRESTON-COLVIN

SECTION 16

DWG BY BLUBAUGH

PID 114849

T 3 N R 16 E

TYPE MONUMENT R.R.SPIKE

~~ON SURFACE~~ - BELOW 6 1/2"

OFFSET $\odot$ PAVEMENT 1' LT : RT

-- TO -- EDGE PAVEMENT

STATION: 599+82

HORIZ.DATUM: NAD83 (2011)


GEOID: NAVD88-2018

GRID: NORTHING: 567676.511


EASTING: 1822727.247

LDP: NORTHING: 336709.977

EASTING: 197074.807

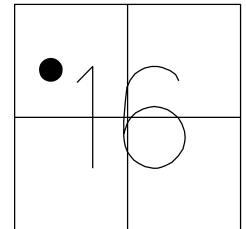

RECORD: P.O.T.
STA.90+00
FD P.K. NAIL
ATOP R.R. SPIKE
SET SQ. HEADED
NAIL/WASHER
8/23/90
FD SQ.HEADED
NAIL/WASHER
2/7/05, SAH
REF49
7/28/09, DCH
SET MAG/WASHER
10/6/09, DH
FD LG.R.R.SPIKE
6 1/2" DOWN
REF49
6/14/16
9/18/17, JFO
FD R.R.SPIKE
6 1/2" DOWN
REF 49
12/13/23, JAM
FD TONE. DID NOT
UNCOVER. PAINTED
8/7/24, JAM

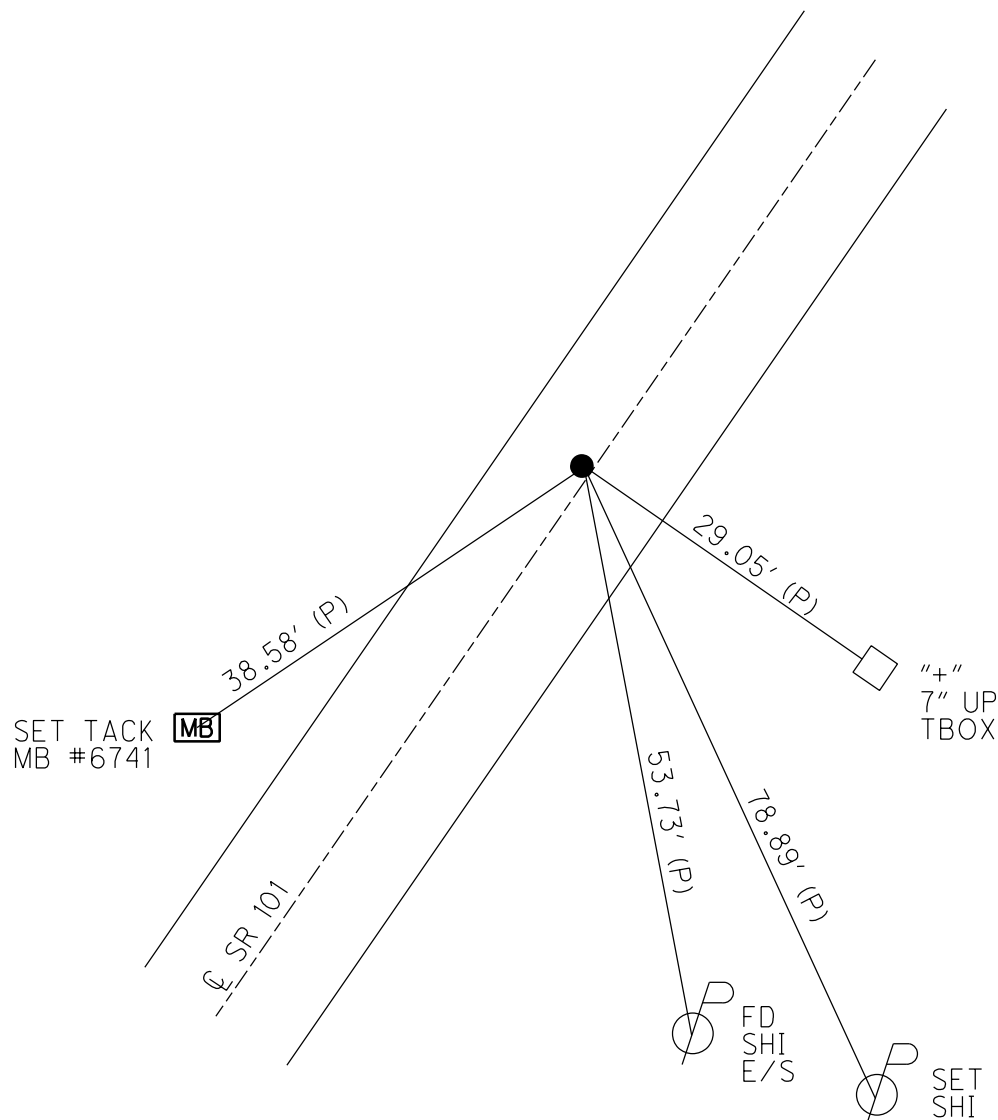

O.D.O.T. DISTRICT 2 SURVEY OFFICE (USE ONLY)

PERSONNEL

REFERENCE NO. 50

SHEET 28 OF 46

NOTES MILLER

DATE 8/7/24

ROUTE SR 101

H.C. MILLER

WEATHER WINDY

COUNTY SENECA

R.C. BARRIERE

TEMP. 70°F

TOWNSHIP ADAMS

BLUBAUGH, ASTON, PRESTON-COLVIN

SECTION 16

DWG BY BLUBAUGH

PID 114849

T 3 N R 16 E

TYPE MONUMENT MAG/WASHER

ON SURFACE - ~~BELOW~~ 0.5"

OFFSET $\mathcal{C}$ PAVEMENT 1.7' LT : ~~RT~~

-- TO -- EDGE PAVEMENT

STATION: 599+82

HORZ.DATUM: NAD83 (2011)


GEOID: NAVD88-2018

GRID: NORTHING: 567676.511


EASTING: 1822727.247

LDP: NORTHING: 337947.109

EASTING: 198447.627

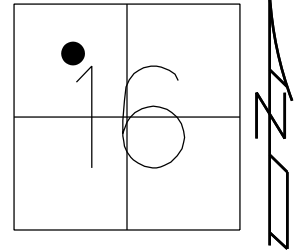

RECORD: P.O.T.
STA 108+50
FD P.K. NAIL
ATOP R.R. SPIKE
SET SQ HEADED
NAIL/WASHER
8/28/90
FD SQ HEADED
NAIL/WASHER
2/7/05, SAH
REF50
7/28/09, DCH
SET MAG/WASHER
NEWREF50
10-06-09, DH
FD MAG/WASHER
REF50
6/14/16
9/18/17, JFO
FD MAG/WASHER
REF50
12/13/23, JAM
FD TONE. DID NOT
UNCOVER. PAINTED
8/7/24, JAM

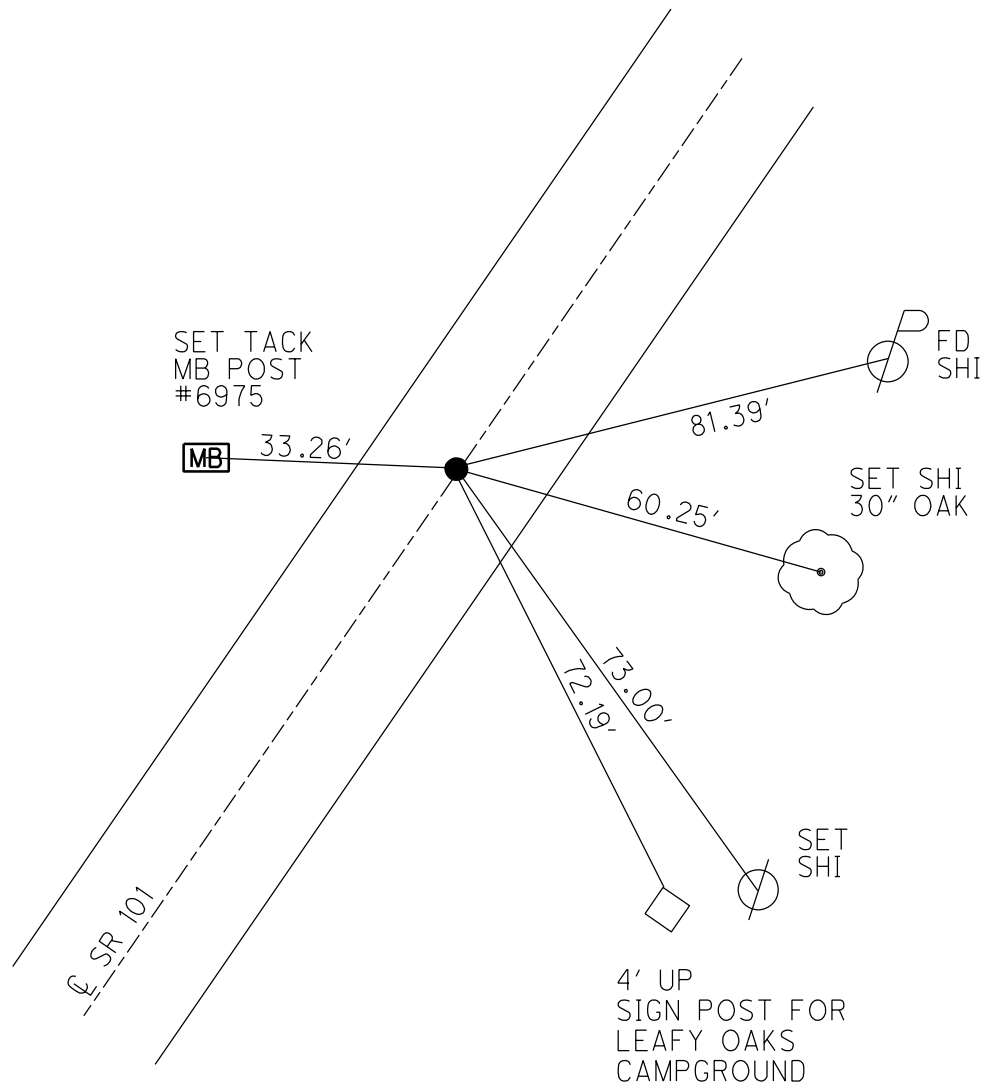

4' UP
SIGN POST FOR
LEAFY OAKS
CAMPGROUND

O.D.O.T. DISTRICT 2 SURVEY OFFICE (USE ONLY)

PERSONNEL

REFERENCE NO. 51

SHEET 28 OF 46

NOTES MILLER

DATE 8/7/24

ROUTE SR 101

H.C. MILLER

WEATHER WINDY

COUNTY SENECA

R.C. BARRIERE

TEMP. 70°F

TOWNSHIP ADAMS

BLUBAUGH, ASTON, PRESTON-COLVIN

SECTION 9

DWG BY BLUBAUGH

PID 114849

T 3 N R 16 E

TYPE MONUMENT MAG/WASHER

ON SURFACE - ~~BELOW~~ 0.5"

OFFSET Q PAVEMENT 2.3' LT : ~~RT~~

-- TO -- EDGE PAVEMENT

STATION: 625+83

HORIZ.DATUM: NAD83 (2011)


GEOID: NAVD88-2018

GRID: NORTHING: 569400.120


EASTING: 1824671.138

LDP: NORTHING: 338448.321

EASTING: 199005.990

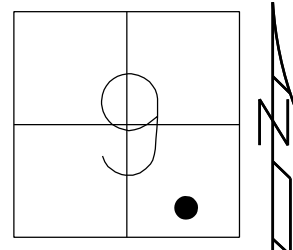

RECORD: P.O.T.
STA. 116+00
FD P.K. NAIL
ATOP R.R. SPIKE
SET SQ HEADED
NAIL/SHINER
8/28/90
FD SQ. HEADED
NAIL/WASHER
2/7/05, SAH
REF51
7/28/09, DCH
SET MAG/WASHER
NEWREF51
10-06-09, DH
FD MAG/WASHER
REF51
6/14/16
9/19/17, JFO
FD MAG/WASHER
REF51
12/13/23, JAM
FD TONE. DID NOT
UNCOVER. PAINTED
8/7/24, JAM

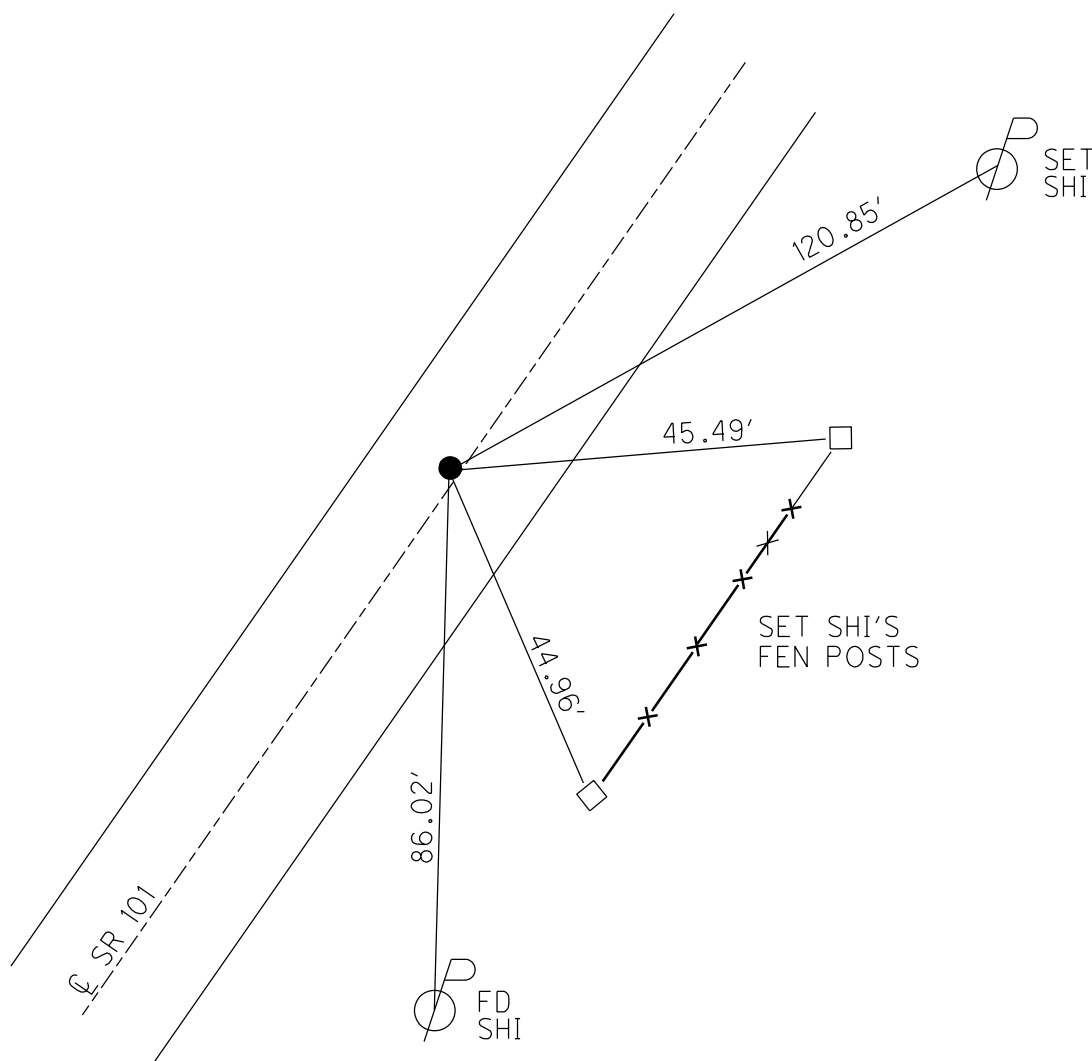

O.D.O.T. DISTRICT 2 SURVEY OFFICE (USE ONLY)

PERSONNEL

REFERENCE NO. 52

SHEET 30 OF 46

NOTES MILLER

DATE 8/7/24

ROUTE SR 101

H.C. MILLER

WEATHER WINDY

COUNTY SENECA

R.C. BARRIERE

TEMP. 70°F

TOWNSHIP ADAMS

BLUBAUGH, ASTON, PRESTON-COLVIN

SECTION 9

DWG BY BLUBAUGH

PID 114849

T 3 N R 16 E

TYPE MONUMENT MONBOX W/1" IPIN

ON SURFACE - ~~BELOW~~ ON

OFFSET Q PAVEMENT 1.5' ~~LT~~ : RT

-- TO -- EDGE PAVEMENT

STATION: 631+83

HORIZ.DATUM: NAD83 (2011)


GEOID: NAVD88-2018

GRID: NORTHING: 569781.799


EASTING: 1825133.241

LDP: NORTHING: 338833.448

EASTING: 199465.164

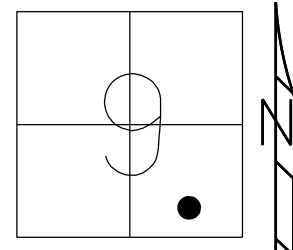

RECORD: P.O.T.
STA. 122+00
FD P.K. NAIL
ATOP R.R. SPIKE
SET SQ. HEADED
NAIL/SHINER
8/28/90, BARBOUR
FD MONBOX
W/PUNCH HOLE
2/7/05, SAH
REF53
7/21/09, DCH
FD MONBOX
W/ 1" IPIN
REF52
6/14/16
9/19/17, JFO
FD MONBOX
W/1" IPIN
REF52
12/13/23, JAM
FD MONBOX.
UNDISTURBED
8/7/24, JAM

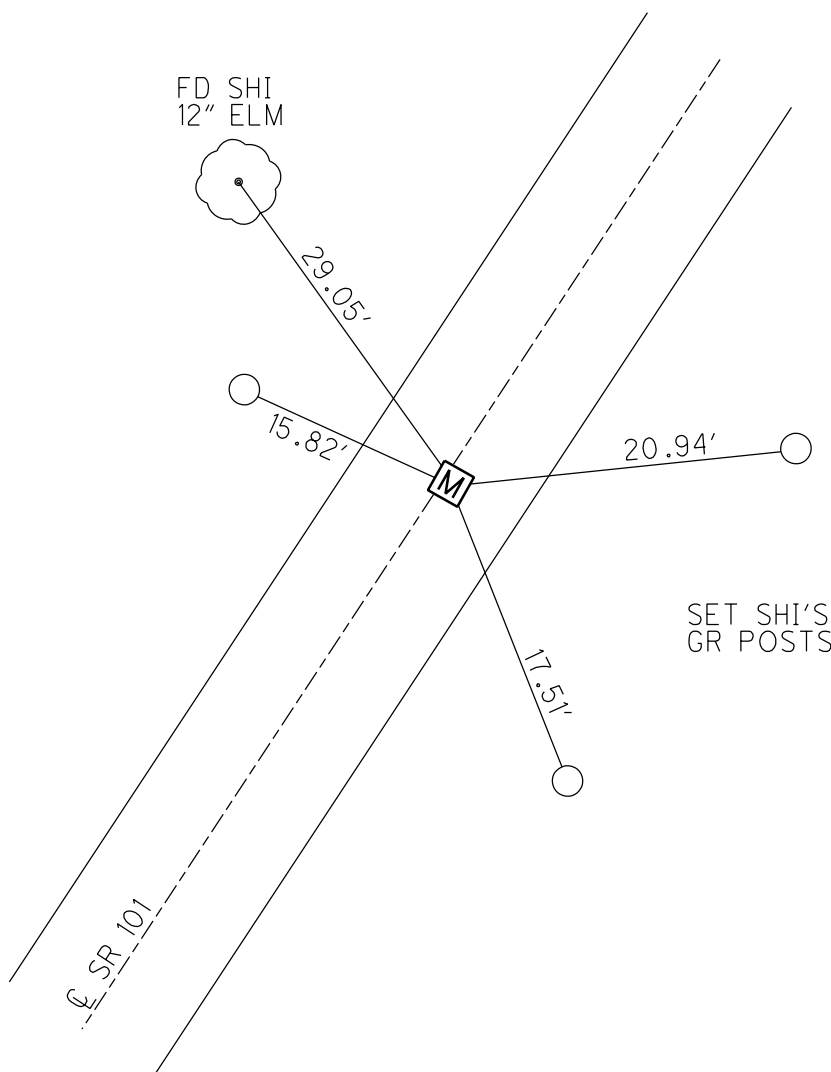

O.D.O.T. DISTRICT 2 SURVEY OFFICE (USE ONLY)

PERSONNEL

REFERENCE NO. 53

SHEET 31 OF 46

NOTES MILLER

DATE 8/7/24

ROUTE SR 101

H.C. MILLER
D.O. CARRIERS

WEATHER WINDY

COUNTY SENECA

R.C. BARRIERE

TEMP. 70°F

TOWNSHIP ADAMSBLUBAUGH, ASTON, PRESTON-COLVINDWG BY BLUBAUGH

PID 114849

T 3 N R 16 F

TYPE MONUMENT MAG/WASHER

ON SURFACE - ~~BELOW~~ ON _____

OFFSET $\frac{1}{4}$ PAVEMENT ON LT : RT

---TO---EDGE PAVEMENT

STATION: 638+82


HORZ.DATUM: NAD83 (2011)

GEOID: NAVD88-2018


GRID: NORTHING: 570102.751

EASTING: 1825507.334

LDP: NORTHING: 339157.193

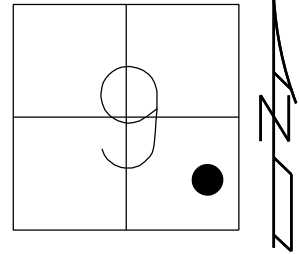EASTING: 199836.903

RECORD:
FD P.K. NAIL
ATOP R.R. SPIKE
SET SQ. HEADED
NAILS/WASHERS
8/28/90, BARBOUR
FD R.R.SPIKE
2" DOWN
REF53
6/29/09, DCH
SET MAG/WASHER
NEWREF53
10-06-09, DH
FD MAG/WASHER
REF53
6/14/16
9/19/17, JFO
FD MAG/WASHER
REF53
12/13/23, JAM
FD TONE. DID NOT
UNCOVER. PAINTED
8/7/24, JAM

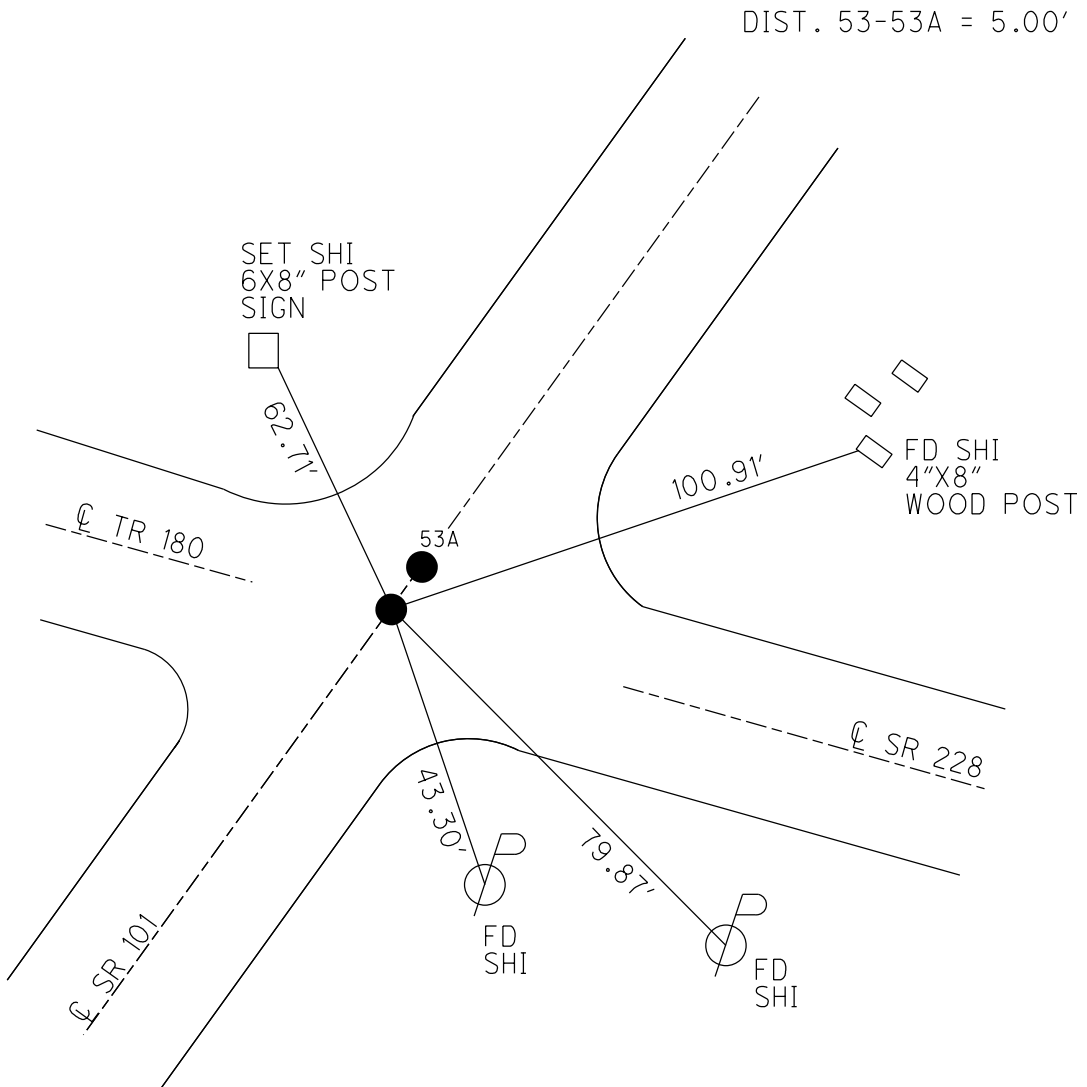

O.D.O.T. DISTRICT 2 SURVEY OFFICE (USE ONLY)

PERSONNEL

REFERENCE NO. 53A

SHEET 32 OF 46

NOTES_____MILLER

DATE 8/7/24

ROUTE SR 101

H.C. MILLER

WEATHER WINDY

COUNTY SENECA

R.C. BARRIERE

TEMP. 70°F

TOWNSHIP ADAMS

BLUBAUGH, ASTON, PRESTON-COLVIN

DWG BY BLUBAUGH

PID 114849

T_3_N R_16_E

TYPE MONUMENT MAG/WASHER

ON SURFACE - ~~BELOW~~ ON

OFFSET $\frac{1}{2}$ PAVEMENT ON LT : RT

____TO____EDGE PAVEMENT

STATION: 636+92

HORZ.DATUM: NAD83 (2011)

GEOID: NAVD88-2018

GRID: NORTHING: 570105.958

EASTING: 1825511.141

LDP: NORTHING: 339160.441

EASTING: 199840.683

RECORD:

SET SQ. HEADED

NAILS/WASHERS
 6 / 100 / 100 BARR

8/28/90, BARBOUR
ED. B. K. WASHED

FD P.K./WASHER
REF 453

REF A53
C 420 40

6/29/09, DCH
CFT MAC/WASH

SET MAG/WASHER
NEWDEAF3

NEWREF A53
10 06 00

10-06-09, DH
FD, MAC / WASH

FD MAG/WASHER
REF A53

REF A53
C 414 416

6/14/16
9/19/17

9/19/17, JFO
ED, MAC (WAG)

FD MAG/WASHER
DE5557A


REF53A
10 117 10

12/13/23, JAM
ED. TONE, BID

FD TONE. DID NOT
UNCOVER. PAINTED

UNCOVER. PAINTED

8/7/24, JAM

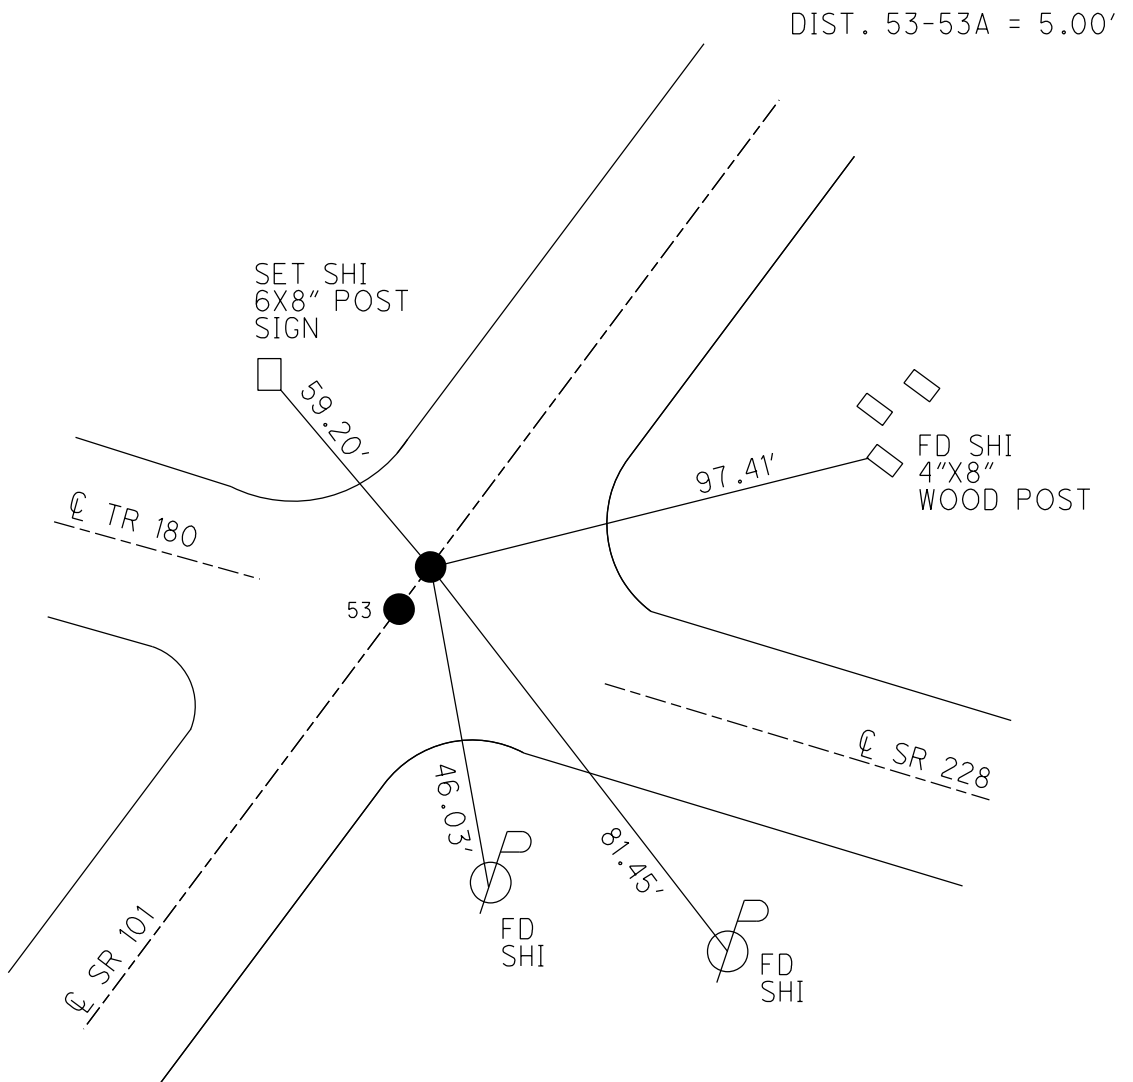

O.D.O.T. DISTRICT 2 SURVEY OFFICE (USE ONLY)

PERSONNEL

REFERENCE NO. 54

SHEET 33 OF 46

NOTES MILLER
H.C. MILLER
R.C. BARRIERE

DATE 8/7/24
WEATHER WINDY
TEMP. 70°F

ROUTE SR 101
COUNTY SENECA
TOWNSHIP ADAMS
SECTION 9

BLUBAUGH, ASTON, PRESTON-COLVIN

DWG BY BLUBAUGH PID 114849

T 3 N R 16 E

TYPE MONUMENT MAG/WASHER

ON ~~SURFACE~~ - BELOW 0.5"

OFFSET Q PAVEMENT 1' ~~LT~~ : RT

-- TO -- EDGE PAVEMENT

STATION: 639+35

HORZ.DATUM: NAD83 (2011)


GEOID: NAVD88-2018

GRID: NORTHING: 570269.846


EASTING: 1825701.753

LDP: NORTHING: 339325.710

EASTING: 200030.114

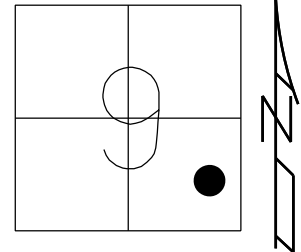

RECORD:
STA. 129+50
FD R.R.SPIKE
4" DOWN
SET SQ. HEADED
NAIL/WASHER
8/28/90, BARBOUR
FD SQ. HEADED
NAIL/WASHER
2/7/05, SAH
FD P.K.NAIL
REF54
7/8/09, DCH
SET MAG/WASHER
NEWREF54
10-06-09, DH
FD MAG/WASHER
REF54
6/15/16
9/19/17, JFO
FD MAG/WASHER
REF54
12/13/23, JAM
FD TONE. DID NOT
UNCOVER. PAINT
8/7/24, JAM

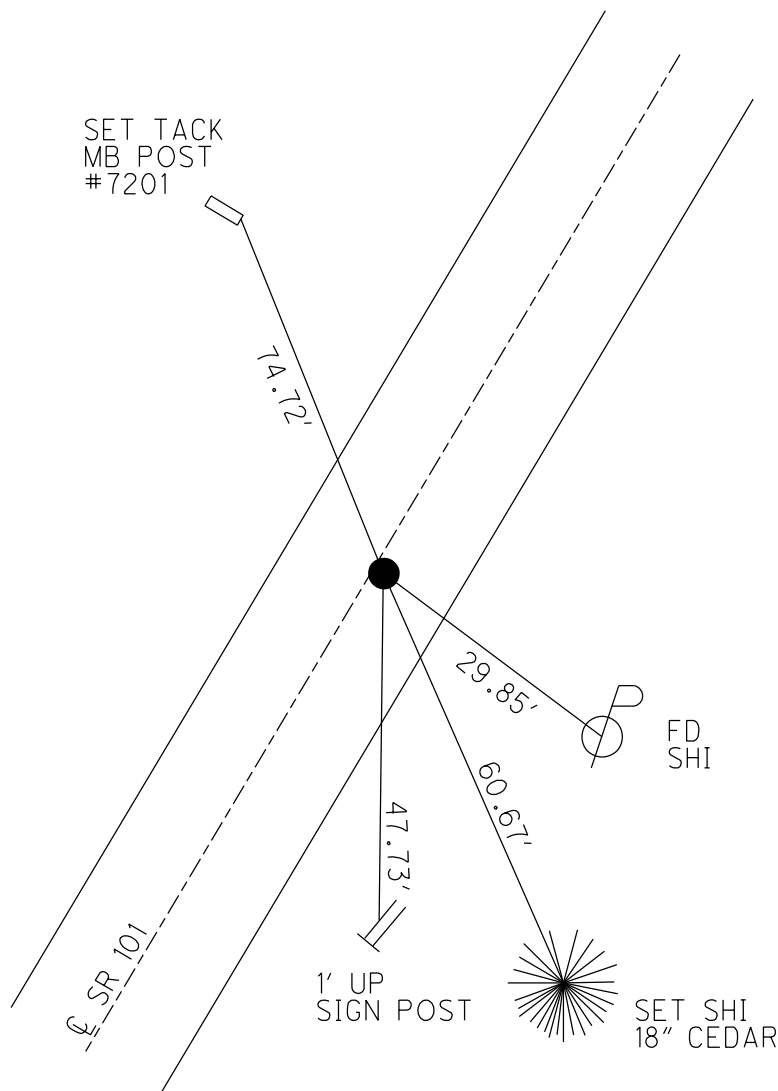

O.D.O.T. DISTRICT 2 SURVEY OFFICE (USE ONLY)

PERSONNEL

REFERENCE NO. 55

SHEET 33 OF 46

NOTES MILLER

DATE 8/7/24

ROUTE SR 101

H.C. MILLER

WEATHER WINDY

COUNTY SENECA

R.C. BARRIERE

TEMP. 70°F

TOWNSHIP ADAMS

BLUBAUGH, ASTON, PRESTON-COLVIN

SECTION 9

DWG BY BLUBAUGH

PID 114849

T 3 N R 16 E

TYPE MONUMENT MAG/WASHER

ON ~~SURFACE~~ - BELOW 0.5"

OFFSET Q PAVEMENT 1' ~~LT~~ : RT

-- TO -- EDGE PAVEMENT

STATION: 639+35

HORIZ.DATUM: NAD83 (2011)


GEOID: NAVD88-2018

GRID: NORTHING: 570604.009


EASTING: 1826093.928

LDP: NORTHING: 339662.820

EASTING: 200419.828

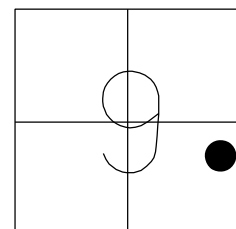

RECORD:
 STA. 134+65
 FD R.R. SPIKE
 4" DOWN
 SET SQ.HEADED
 NAIL/WASHER
 8/28/90, BARBOUR
 FD SQ.HEADED
 NAIL/WASHER
 2/7/05, SAH
 FD P.K.NAIL
 REF55
 7/8/09, DCH
 SET MAG/WASHER
 NEWREF55
 10-06-09, DH
 FD MAG/WASHER
 REF55
 6/15/16
 9/19/17, JFO
 FD MAG/WASHER
 REF55
 12/13/23, JAM
 FD TONE. DID NOT
 UNCOVER. PAINT
 8/7/24, JAM

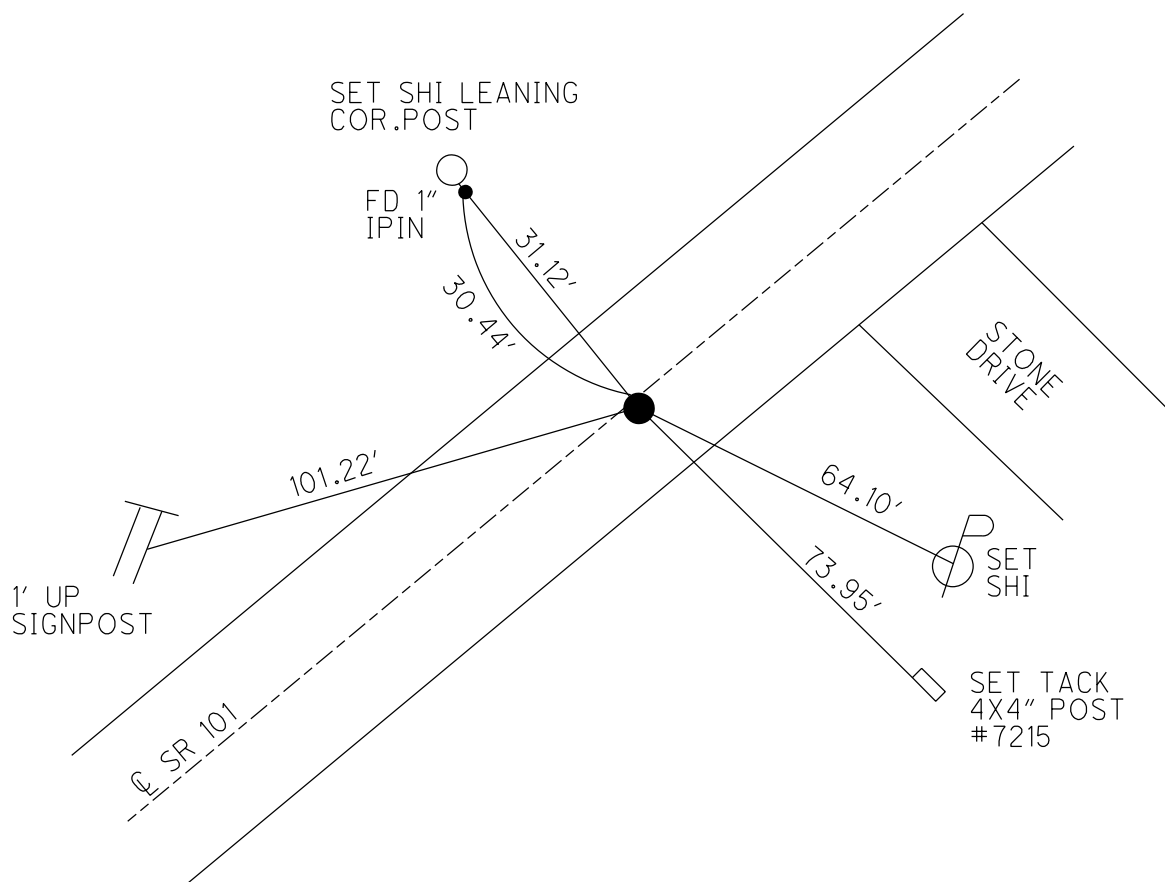

O.D.O.T. DISTRICT 2 SURVEY OFFICE (USE ONLY)

PERSONNEL

REFERENCE NO. 56

SHEET 33 OF 46

NOTES MILLER

DATE 8/7/24

ROUTE SR 101

H.C. MILLER

WEATHER WINDY

COUNTY SENECA

R.C. BARRIERE

TEMP. 70°F

TOWNSHIP ADAMS

BLUBAUGH, ASTON, PRESTON-COLVIN

SECTION 10

DWG BY BLUBAUGH

PID 114849

T 3 N R 16 E

TYPE MONUMENT MAG/WASHER

ON ~~SURFACE~~ - BELOW 0.5"

OFFSET Q PAVEMENT 1' LT : ~~RT~~

-- TO -- EDGE PAVEMENT

STATION: 654+20

HORIZ.DATUM: NAD83 (2011)


GEOID: NAVD88-2018

GRID: NORTHING: 571232.451


EASTING: 1826832.820

LDP: NORTHING: 340296.779

EASTING: 201154.113

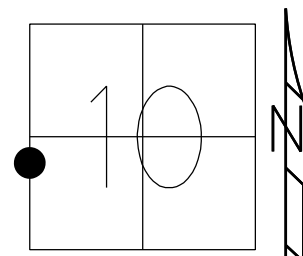

RECORD:
STA. 144+34.3
FD IPIPE
5" DOWN
SET SQ.HEADED
NAIL/WASHER
8/28/90, BARBOUR
FD SQ.HEADED
NAIL/WASHER
2/7/05, SAH
FD P.K.NAIL
REF56
7/8/09, DCH
SET MAG/WASHER
NEWREF56
10-06-09, DH
FD MAG/WASHER
REF56
6/15/16
9/19/17, JFO
FD MAG/W
REF56
12/12/23, TDN
FD TONE. DID NOT
UNCOVER. PAINTED
8/7/24, JAM

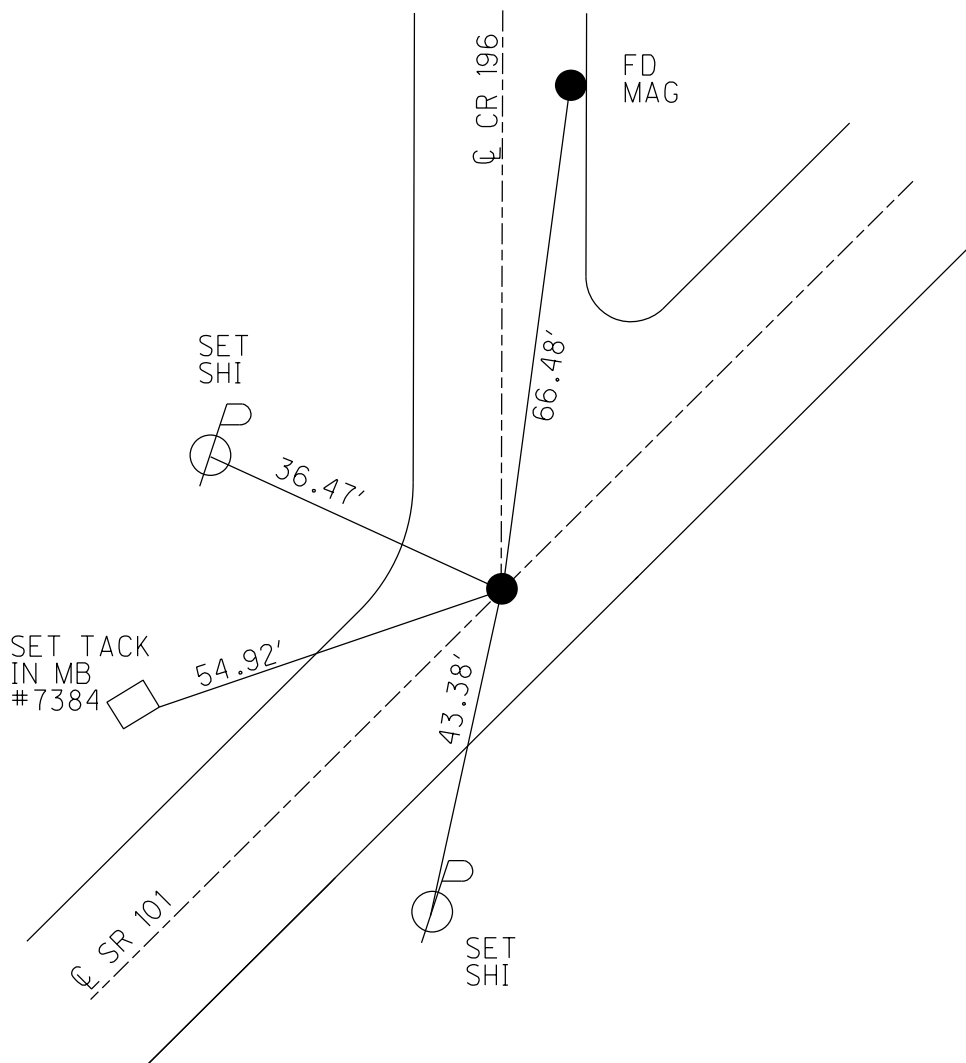

O.D.O.T. DISTRICT 2 SURVEY OFFICE (USE ONLY)

PERSONNEL

REFERENCE NO. 57

SHEET 36 OF 46

NOTES MILLER

DATE 8/7/24

ROUTE SR 101

H.C. MILLER

WEATHER SUNNY

COUNTY SENECA

R.C. BARRIERE

TEMP. 70°F

TOWNSHIP ADAMS

BLUBAUGH, ASTON, PRESTON-COLVIN

SECTION 10

DWG BY BLUBAUGH

PID 114849

T 3 N R 16 E

TYPE MONUMENT MAG/WASHER

ON ~~SURFACE~~ - BELOW 0.5"

OFFSET Q PAVEMENT 1' ~~LT~~ : RT

-- TO -- EDGE PAVEMENT

STATION: 669+83

HORIZ.DATUM: NAD83 (2011)


GEOID: NAVD88-2018

GRID: NORTHING: 572234.022


EASTING: 1828028.785

LDP: NORTHING: 341307.351

EASTING: 202342.691

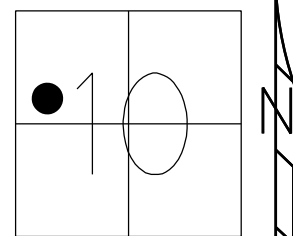

RECORD:
 STA. 160+00
 FD R.R. SPIKE
 4" DOWN
 8/28/90, BARBOUR
 FD P.K./WASHER
 2" DOWN
 7/7/05, SAH
 FD P.K./WASHER
 REF57
 7/8/09, DCH
 SET MAG/WASHER
 NEWREF57
 10/6/09, DH
 FD MAG/WASHER
 REF57
 6/15/16
 9/19/17, JFO
 FD MAG/W
 REF57
 12/12/23, TDN
 FD TONE. DID NOT
 UNCOVER. PAINTED
 8/7/24, JAM

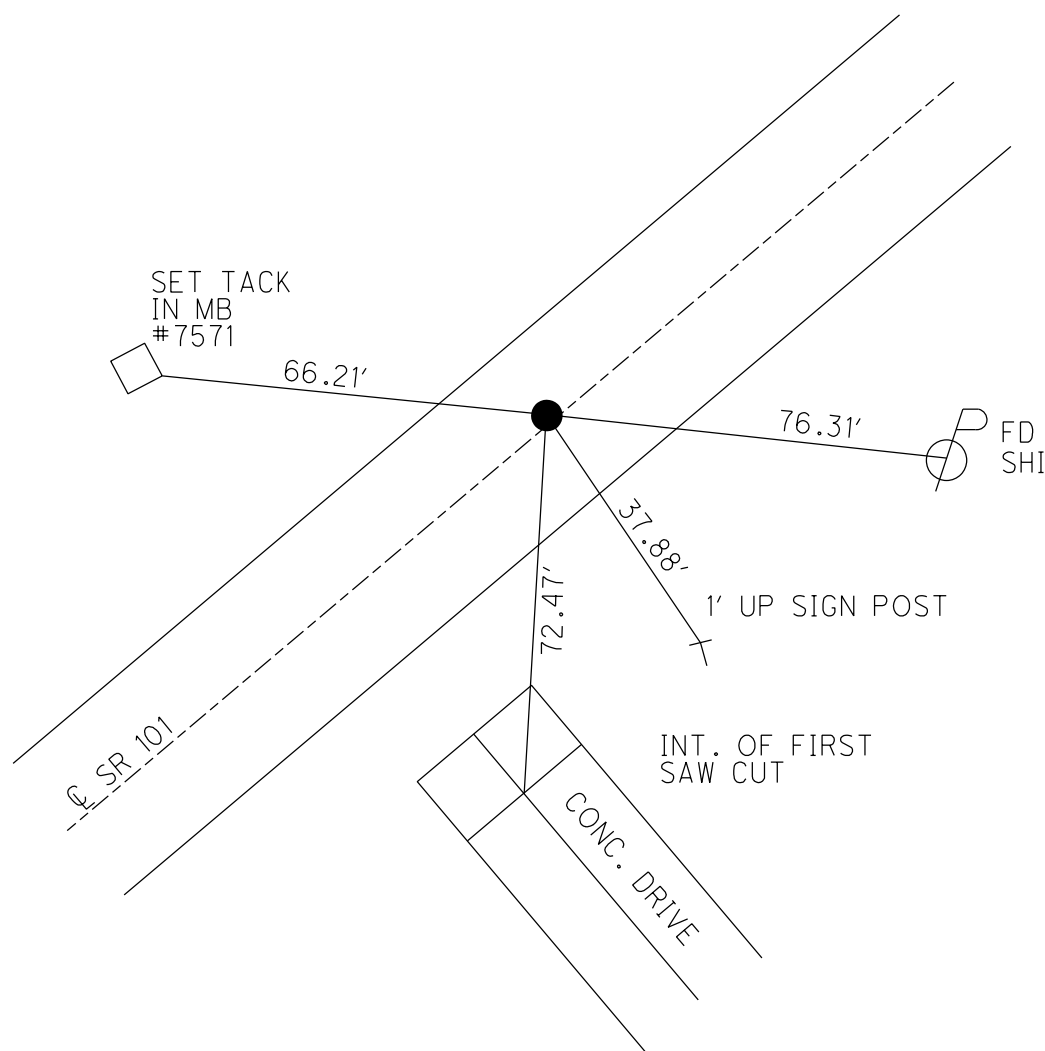

O.D.O.T. DISTRICT 2 SURVEY OFFICE (USE ONLY)

PERSONNEL

REFERENCE NO. 58

SHEET 37 OF 46

NOTES MILLER

DATE 8/7/24

ROUTE SR 101

H.C. MILLER

WEATHER SUNNY

COUNTY SENECA

R.C. BARRIERE

TEMP. 70°F

TOWNSHIP ADAMS

BLUBAUGH, ASTON, PRESTON-COLVIN

SECTION 10

DWG BY BLUBAUGH

PID 114849

T 3 N R 16 E

TYPE MONUMENT MAG/WASHER

~~ON SURFACE~~ - BELOW 0.5"

OFFSET $\odot$ PAVEMENT ON LT : RT

-- TO -- EDGE PAVEMENT

STATION: 682+94

HORIZ.DATUM: NAD83 (2011)


GEOID: NAVD88-2018

GRID: NORTHING: 573073.894


EASTING: 1829032.964


LDP: NORTHING: 342154.849

EASTING: 203340.608

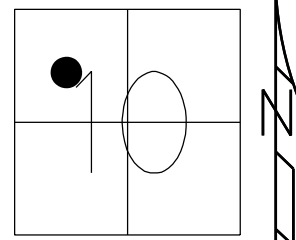

RECORD:
STA. 173+68.3
FD R.R. SPIKE
4" DOWN
SET P.K./WASHER
8/29/90, DCH
FD P.K./WASHER
REF58
7/8/09, DCH
SET MAG/WASHER
NEWREF58
10-06-09, DH
FD MAG/WASHER
REF58
6/15/16
9/19/17, JFO
FD MAG/W
REF58
12/12/23, TDN
FD TONE. DID NOT
UNCOVER. PAINTED
8/7/24, JAM

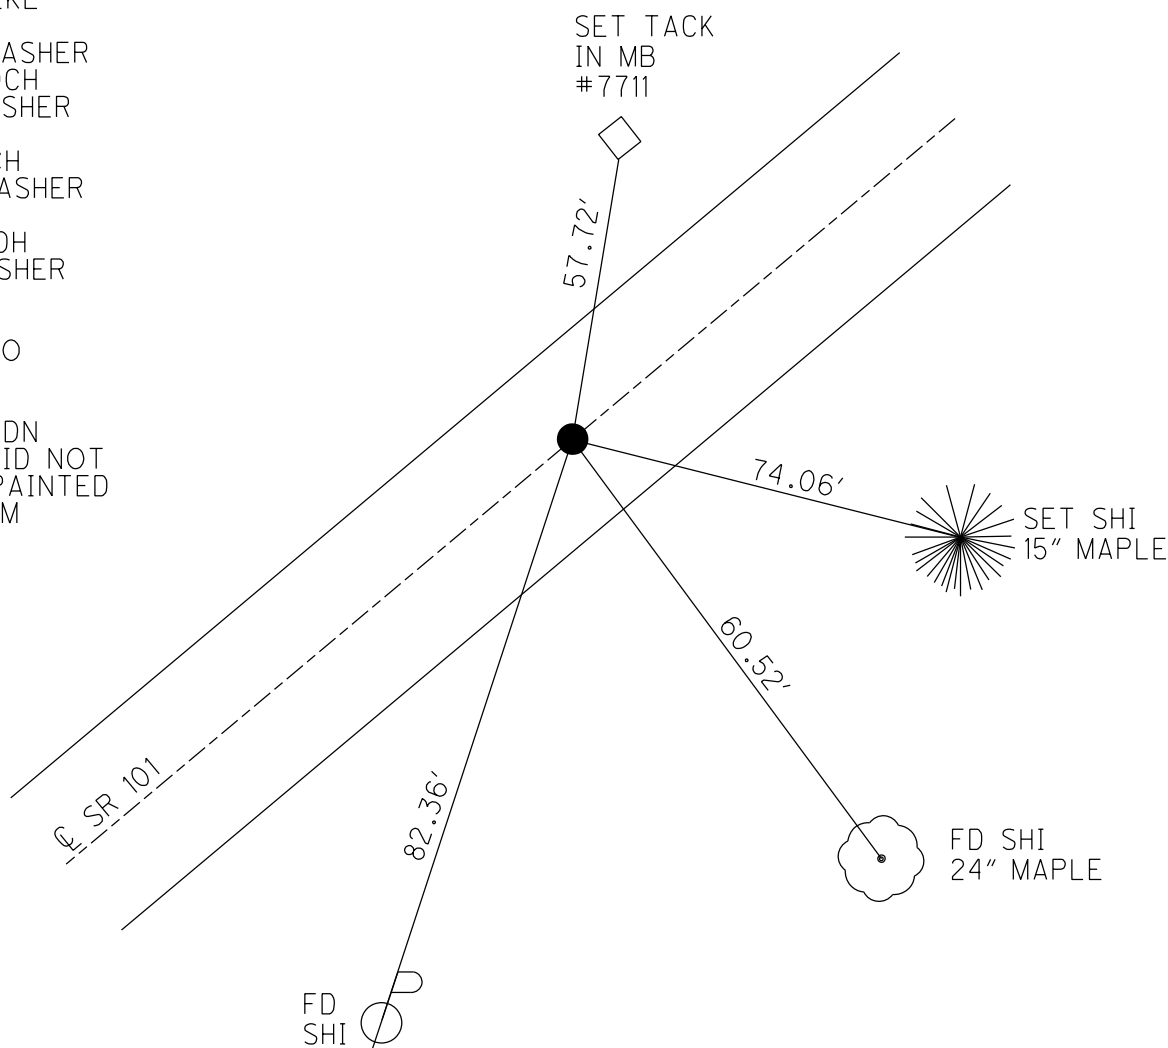

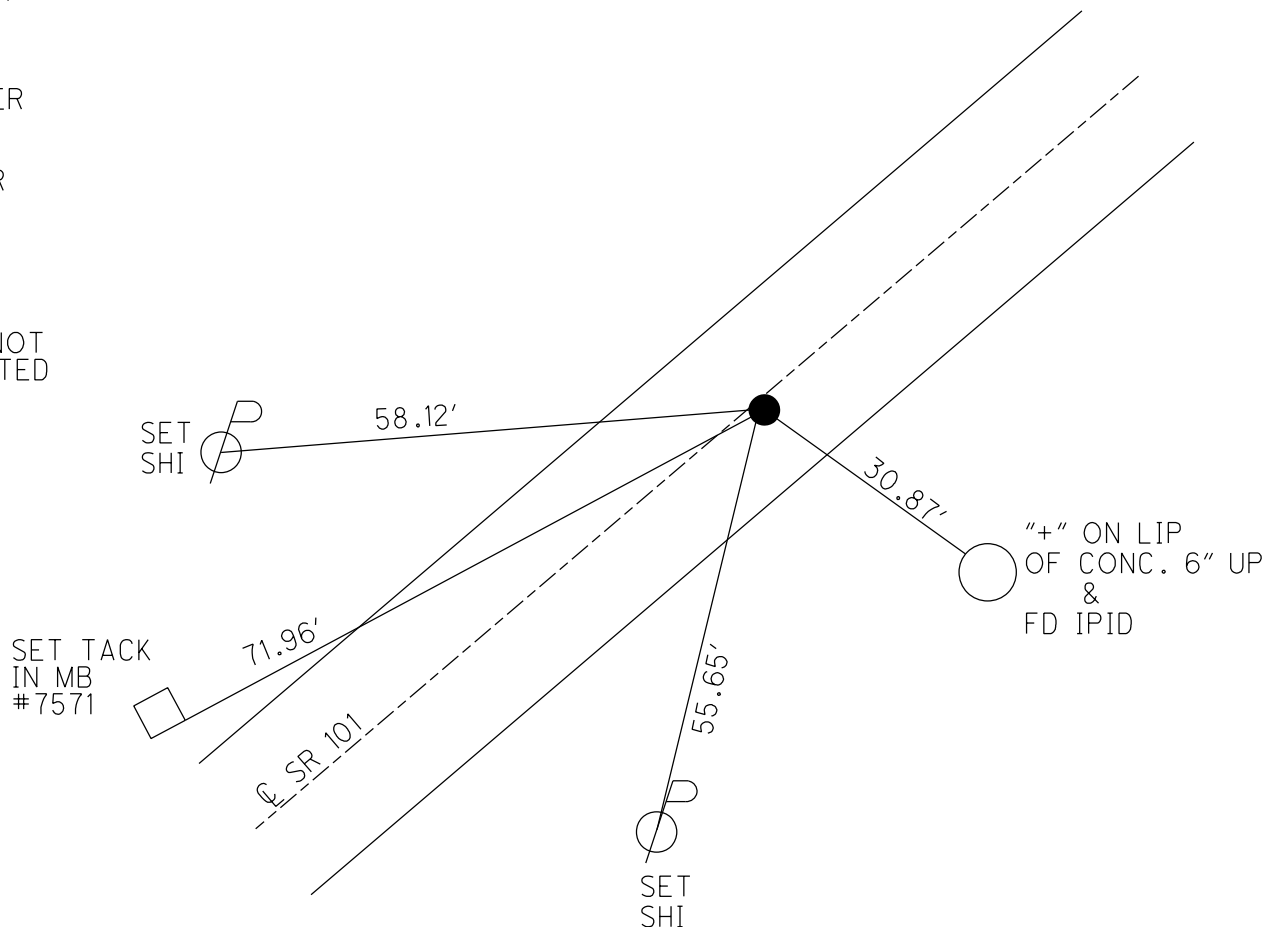

O.D.O.T. DISTRICT 2 SURVEY OFFICE (USE ONLY)

PERSONNEL

REFERENCE NO. 60

SHEET 39 OF 46

NOTES MILLER

DATE 8/7/24

ROUTE SR 101

H.C. MILLER

WEATHER SUNNY

COUNTY SENECA

R.C. BARRIERE

TEMP. 70°F

TOWNSHIP ADAMS

BLUBAUGH, ASTON, PRESTON-COLVIN

SECTION 3

DWG BY BLUBAUGH

PID 114849

T 3 N R 16 E

TYPE MONUMENT MAG/WASHER

~~ON SURFACE~~ - BELOW 0.5"

OFFSET $\odot$ PAVEMENT 0.2' ~~LT~~ : RT

-- TO -- EDGE PAVEMENT

STATION: 682+94

HORIZ.DATUM: NAD83 (2011)


GEOID: NAVD88-2018

GRID: NORTHING: 574280.650


EASTING: 1830481.781

LDP: NORTHING: 343372.427

EASTING: 204780.544

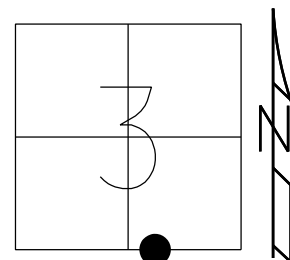

RECORD:
FD P.K.NAIL
REF60
7/8/09, DCH
SET MAG/WASHER
NEWREF60
10-06-09, DH
FD MAG/WASHER
REF60
6/15/16
9/12/17, JFO
REF60
12/12/23, TDN
FD TONE. DID NOT
UNCOVER. PAINTED
8/7/24, JAM

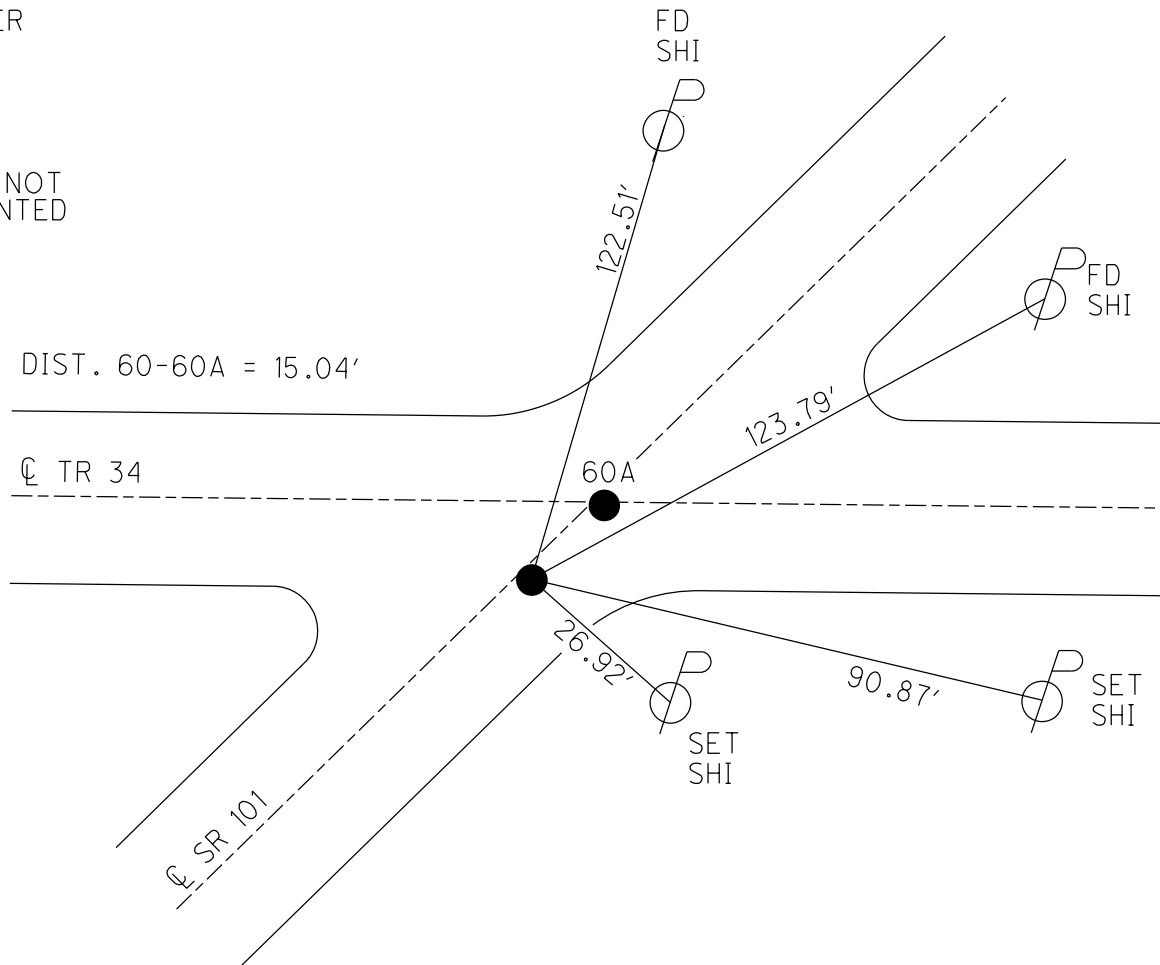

O.D.O.T. DISTRICT 2 SURVEY OFFICE (USE ONLY)

PERSONNEL

REFERENCE NO. 60 A

SHEET 40 OF 46

NOTES MILLER

DATE 8/7/24

ROUTE SR 101

H.C. MILLER

WEATHER SUNNY

COUNTY SENECA

R.C. BARRIERE

TEMP. 70°F

TOWNSHIP ADAMS

BLUBAUGH, ASTON, PRESTON-COLVIN

SECTION 3

DWG BY BLUBAUGH

PID 114849

T 3 N R 16 E

TYPE MONUMENT MAG/WASHER

~~ON SURFACE~~ - BELOW 0.5"

OFFSET Q PAVEMENT 2' ~~LT~~ : RT

-- TO -- EDGE PAVEMENT

STATION: 701+95

HORIZ.DATUM: NAD83 (2011)


GEOID: NAVD88-2018

GRID: NORTHING: 574290.410


EASTING: 1830493.199

LDP: NORTHING: 343382.277

EASTING: 204791.913

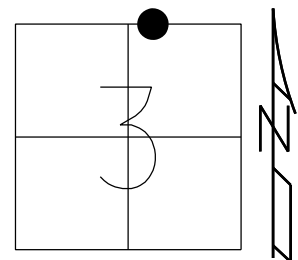

RECORD:
STA. 192+00
FD R.R. SPIKE
5" DOWN
SET P.K./WASHER
1" DOWN
8/29/90, BARBOUR
FD P.K.NAIL
2" DOWN
REF A60
7/8/09, DCH
SET MAG/WASHER
NEW REF A60
10-06-09, DH
FD MAG/WASHER
REF A60
6/15/16
9/19/17, JFO
REF 60A
12/12/23, TDN
FD TONE. DID NOT
UNCOVER. PAINTED
8/7/24, JAM

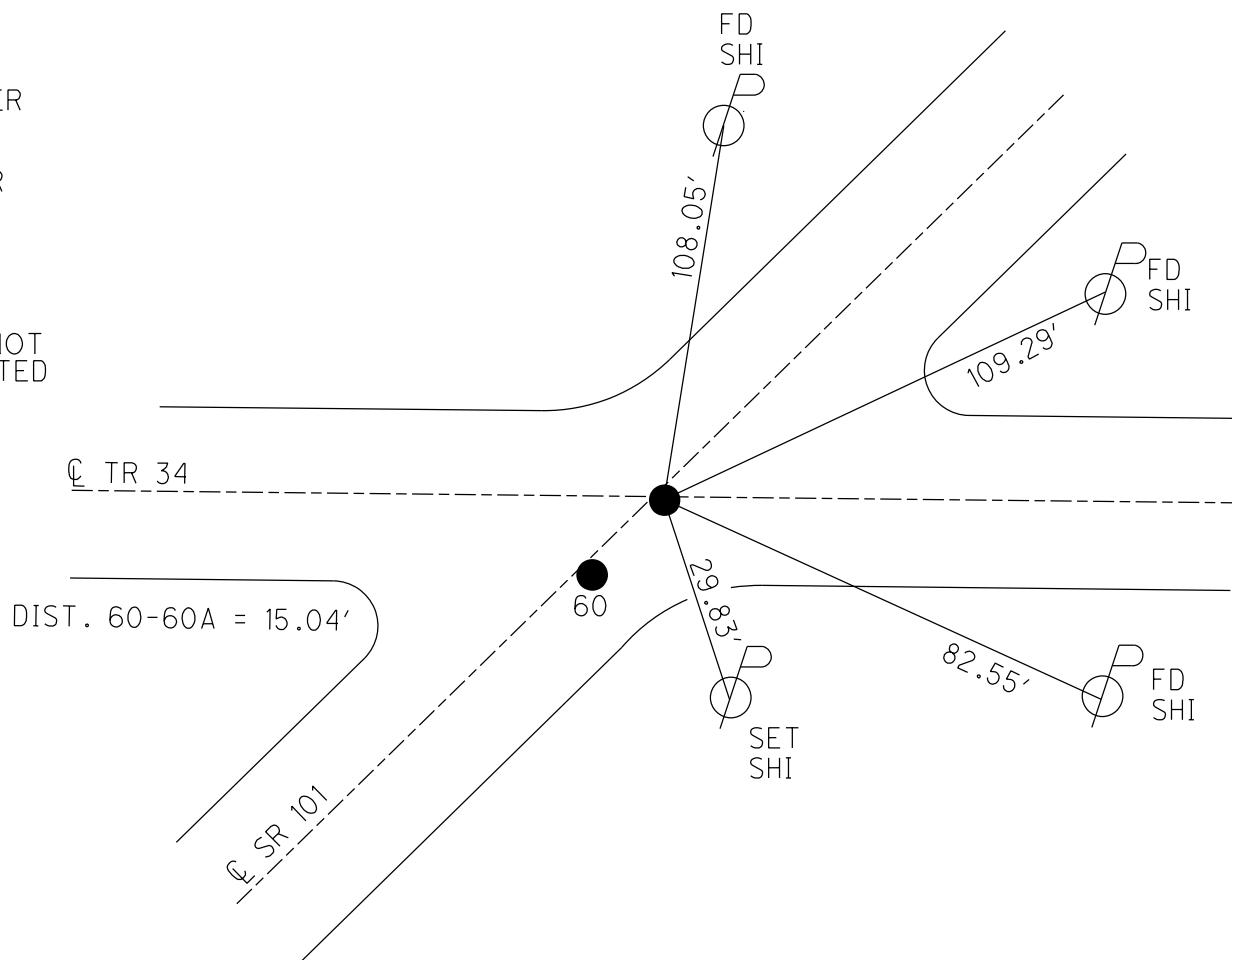

O.D.O.T. DISTRICT 2 SURVEY OFFICE (USE ONLY)

PERSONNEL

REFERENCE NO. 61

SHEET 41 OF 46

NOTES MILLER

DATE 8/7/24

ROUTE SR 101

H.C. MILLER

WEATHER SUNNY

COUNTY SENECA

R.C. BARRIERE

TEMP. 75°F

TOWNSHIP ADAMS

BLUBAUGH, ASTON, PRESTON-COLVIN

SECTION 3

DWG BY BLUBAUGH

PID 114849

T 3 N R 16 E

TYPE MONUMENT MAG/WASHER

~~ON SURFACE~~ - BELOW 0.5"

OFFSET $\odot$ PAVEMENT ON ~~LT~~ : RT

-- TO -- EDGE PAVEMENT

STATION: 720.97

HORIZ.DATUM: NAD83 (2011)


GEOID: NAVD88-2018

GRID: NORTHING: 575519.992


EASTING: 1831940.301

LDP: NORTHING: 344622.753

EASTING: 206229.864

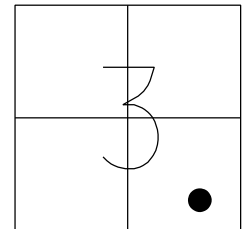

RECORD:
 STA. 211+00
 FD R.R. SPIKE
 4" DOWN
 SET P.K./WASHER
 8/29/90, BARBOUR
 FD P.K./WASHER
 2/7/05, SAH
 REF61
 7/8/09, DCH
 SET MAG/WASHER
 NEWREF61
 10-06-09, DH
 FD MAG/WASHER
 REF61
 6/15/16, JFO
 9/12/17, JMR
 REF61
 12/12/23, TDN
 FD TONE. DID NOT
 UNCOVER. PAINTED
 8/7/24, JAM

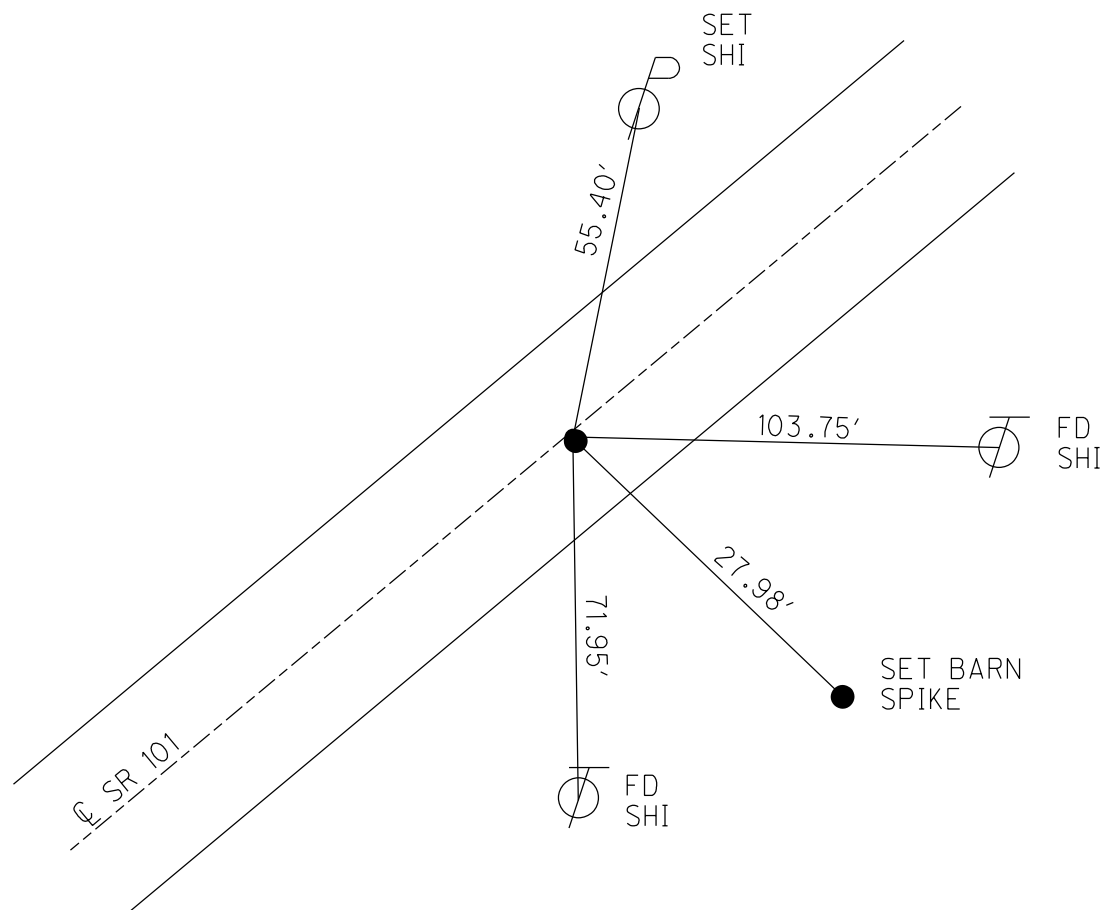

O.D.O.T. DISTRICT 2 SURVEY OFFICE (USE ONLY)

PERSONNEL

REFERENCE NO. 62

SHEET 42 OF 46

NOTES MILLER

DATE 8/7/24

ROUTE SR 101

H.C. MILLER

WEATHER SUNNY

COUNTY SENECA

R.C. BARRIERE

TEMP. 75°F

TOWNSHIP ADAMS

BLUBAUGH, ASTON, PRESTON-COLVIN

SECTION 2

DWG BY BLUBAUGH

PID 114849

T 3 N R 16 E

TYPE MONUMENT MAG/WASHER

~~ON SURFACE~~ - BELOW 0.5"

OFFSET Q PAVEMENT 1.0' LT : ~~RT~~

-- TO -- EDGE PAVEMENT

STATION: 720.97

HORIZ.DATUM: NAD83 (2011)


GEOID: NAVD88-2018

GRID: NORTHING: 576362.605


EASTING: 1832931.398

LDP: NORTHING: 345472.829

EASTING: 207214.761

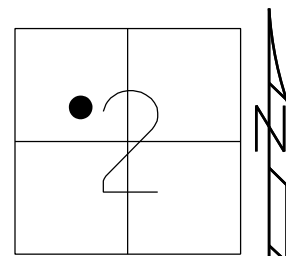

RECORD:
 STA. 224+00
 FD R.R. SPIKE
 4" DOWN
 SET P.K./WASHER
 8/29/90, BARBOUR
 FD P.K./WASHER
 2/7/05, SAH
 REF62
 6/30/09, DCH
 SET MAG/WASHER
 NEWREF62
 10-07-09, DH
 FD MAG/WASHER
 REF62
 6/16/16, JFO
 9/12/17, JMR
 REF62
 12/12/23, TDN
 FD TONE. DID NOT
 UNCOVER. PAINTED
 8/7/24, JAM

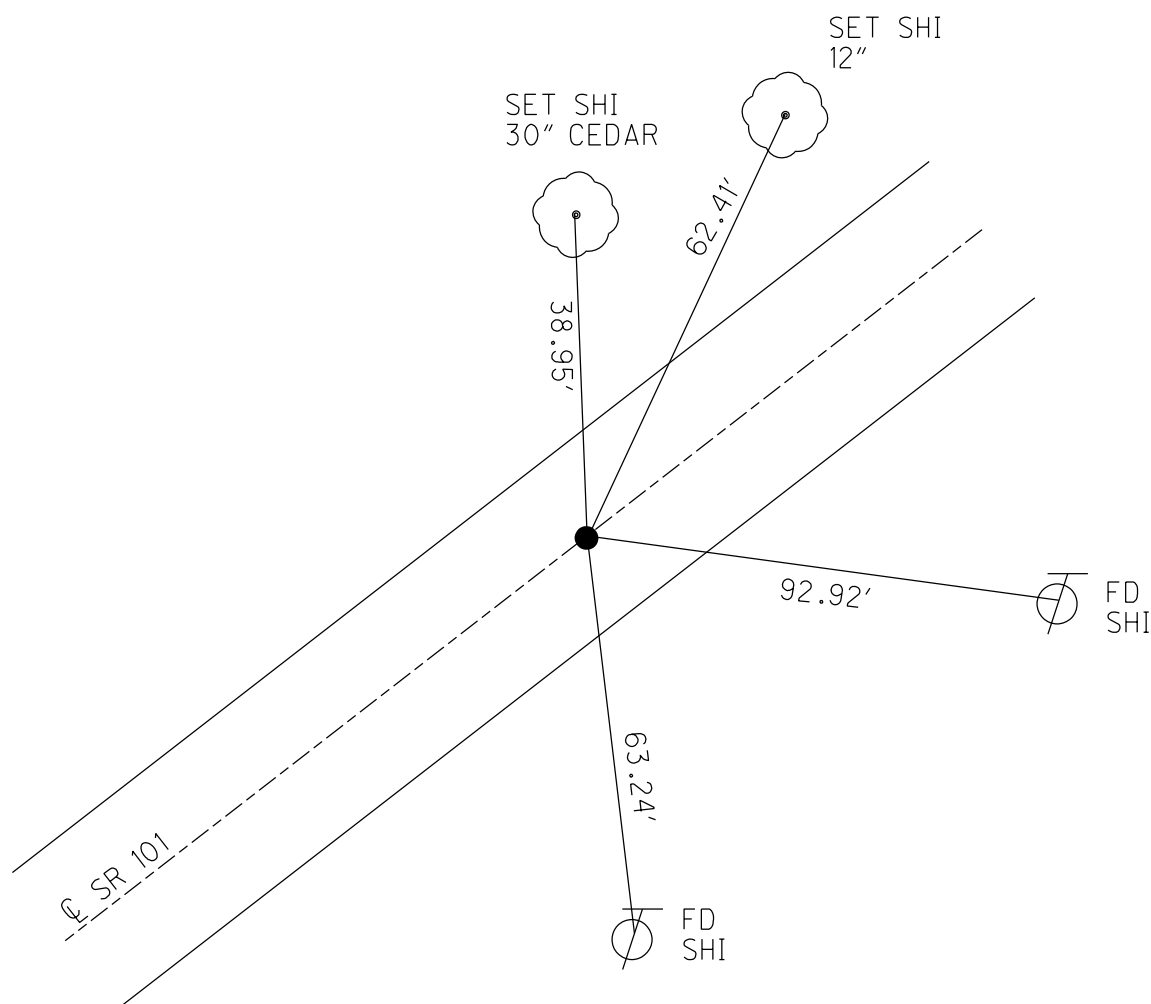

O.D.O.T. DISTRICT 2 SURVEY OFFICE (USE ONLY)

PERSONNEL

REFERENCE NO. 63

SHEET 43 OF 46

NOTES MILLER

DATE 8/7/24

ROUTE SR 101

H.C. MILLER

WEATHER SUNNY

COUNTY SENECA

R.C. BARRIERE

TEMP. 75°F

TOWNSHIP ADAMS

BLUBAUGH, ASTON, PRESTON-COLVIN

SECTION 2

DWG BY BLUBAUGH

PID 114849

T 3 N R 16 E

TYPE MONUMENT MAG NAIL

~~ON SURFACE~~ - BELOW 0.5"

OFFSET $\odot$ PAVEMENT ON LT : RT

-- TO -- EDGE PAVEMENT

STATION: 742+00

HORIZ.DATUM: NAD83 (2011)


GEOID: NAVD88-2018

GRID: NORTHING: 576880.385


EASTING: 1833540.368

LDP: NORTHING: 345995.177

EASTING: 207819.888

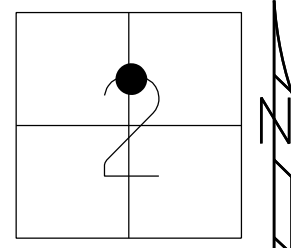

RECORD:
STA. 232+00
FD IPIN
4" BELOW
SET P.K./WASHER
8/29/90, BARBOUR
FD IPIN
4" DOWN
REF63
6/30/09, DCH
SET MAG/WASHER
NEWREF63
10-07-09, DH
FD MAG/WASHER
REF63
6/16/16, JFO
9/12/17, JMR
FD MAG NAIL
REF63
12/12/23, TDN
FD TONE. DID
NOT UNCOVER.
PAINTED
8/7/24, JAM

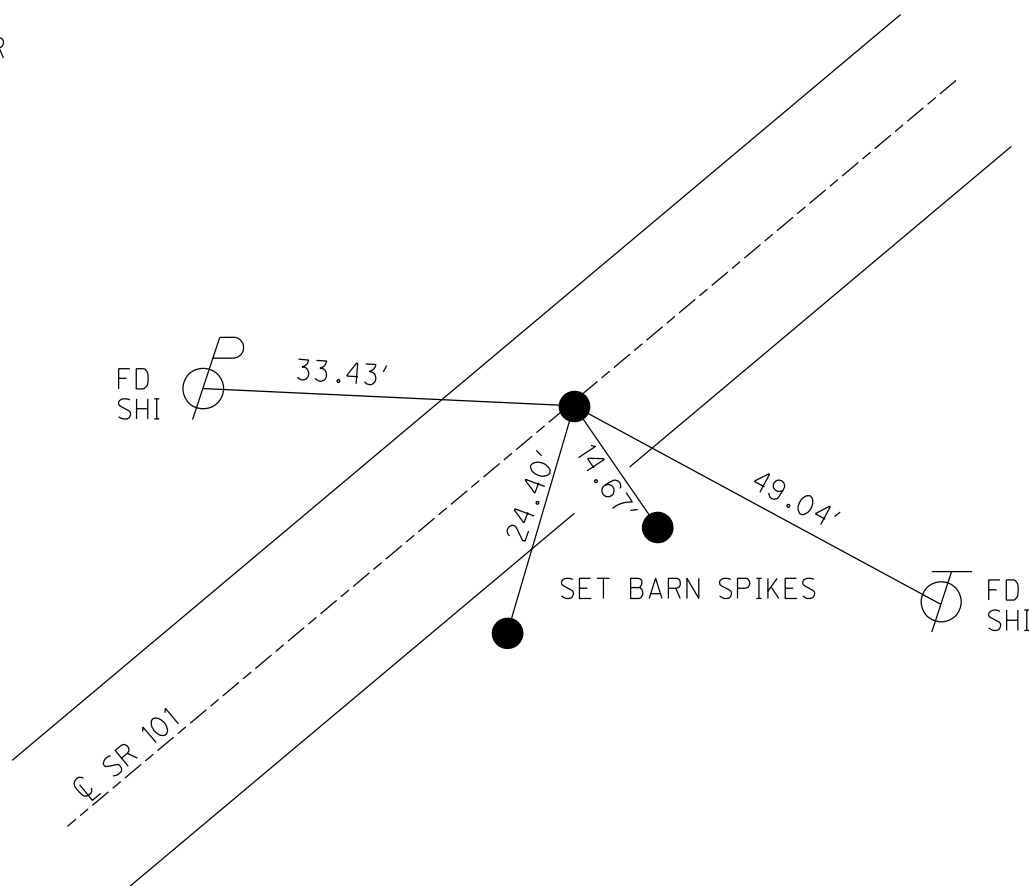

O.D.O.T. DISTRICT 2 SURVEY OFFICE (USE ONLY)

PERSONNEL

REFERENCE NO. 64

SHEET 44 OF 46

NOTES MILLER

DATE 8/7/24

ROUTE SR 101

H.C. MILLER

WEATHER SUNNY

COUNTY SENECA

R.C. BARRIERE

TEMP. 38°F

TOWNSHIP ADAMS

BLUBAUGH, ASTON, PRESTON-COLVIN

SECTION 2

DWG BY BLUBAUGH

PID 114849

T 3 N R 16 E

TYPE MONUMENT MAG/WASHER

ON SURFACE - ~~BELOW~~ ON

OFFSET Q PAVEMENT 1' LT : ~~RT~~

-- TO -- EDGE PAVEMENT

STATION: 759+04

HORIZ.DATUM: NAD83 (2011)


GEOID: NAVD88-2018

GRID: NORTHING: 576880.385

EASTING: 1833540.368

LDP: NORTHING: 347104.007

EASTING: 209111.861

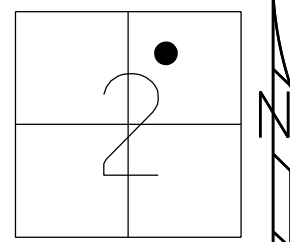

RECORD:

STA. 759+04

FD R.R. SPIKE

4" DOWN

SET P.K./WASHER

8/29/90, BARBOUR

FD P.K./WASHER

2/7/05, SAH

REF64

6/30/09, DCH

SET MAG/WASHER

NEWREF64

10-07-09, DH

FD MAG/WASHER

REF64

6/16/16, JFO

9/12/17, JMR


REF64

12/12/TDN

FD TONE. DID NOT

UNCOVER. PAINTED

8/7/24, JAM

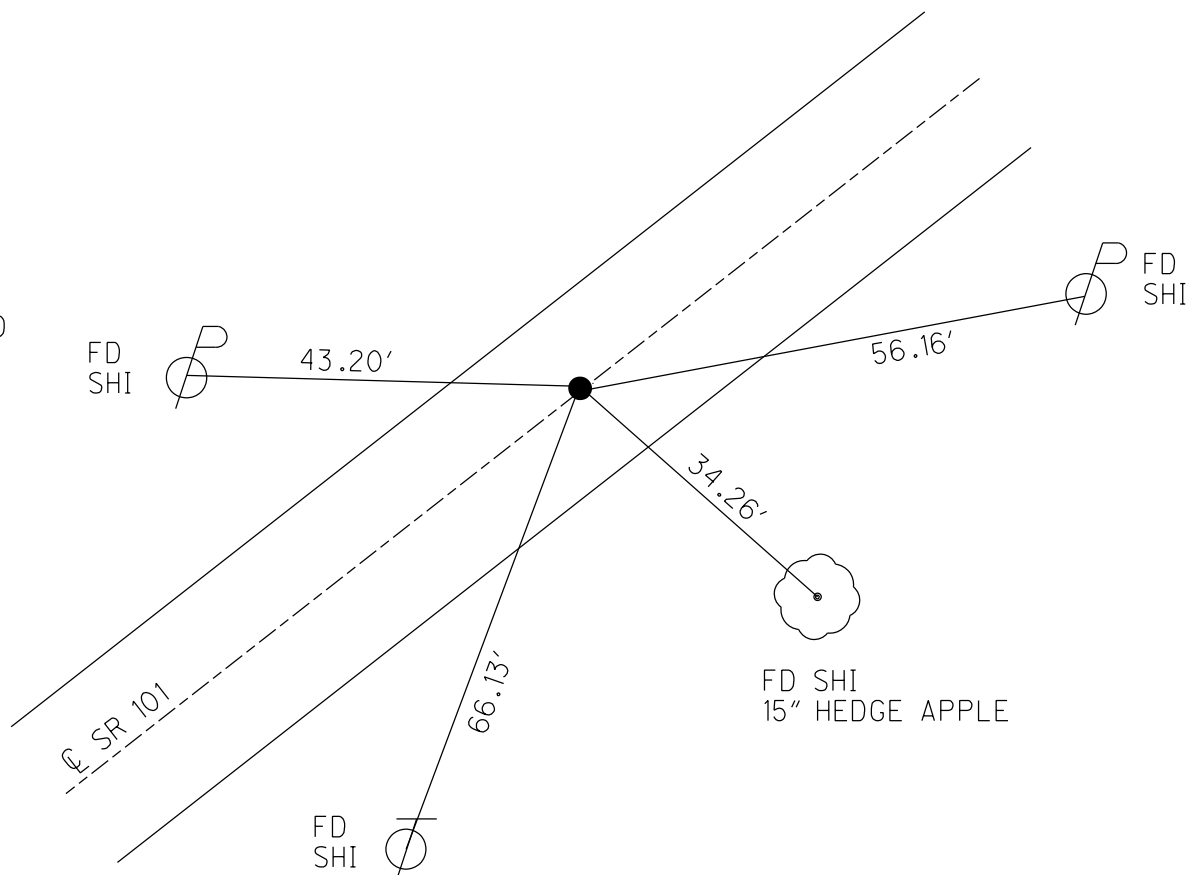

O.D.O.T. DISTRICT 2 SURVEY OFFICE (USE ONLY)

PERSONNEL

REFERENCE NO. 65

SHEET 45 OF 46

NOTES MILLER

DATE 8/7/24

ROUTE SR 101

H.C. MILLER

WEATHER SUNNY

COUNTY SENECA

R.C. BARRIERE

TEMP. 70°F

TOWNSHIP ADAMS

BLUBAUGH, ASTON, PRESTON-COLVIN

SECTION 2

DWG BY BLUBAUGH

PID 114849

T 3 N R 16 E

TYPE MONUMENT MAG/WASHER

~~ON SURFACE~~ - BELOW 0.5"

OFFSET Q PAVEMENT 1' LT : RT

-- TO -- EDGE PAVEMENT

STATION: 768+96

HORIZ.DATUM: NAD83 (2011)


GEOID: NAVD88-2018

GRID: NORTHING: 578620.258


EASTING: 1835595.787

LDP: NORTHING: 347750.526

EASTING: 209862.473

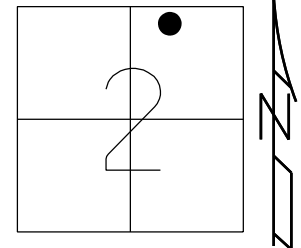

RECORD:
STA. 259+00
FD IPIN
4" BELOW
SET P.K./WASHER
8/29/90, BARBOUR
FD P.K./WASHER
2/7/05, SAH
REF65
6/30/09, DCH
SET MAG/WASHER
NEWREF65
10-07-09, DH
FD MAG/WASHER
REF65
6/16/16, JFO
9/12/17, JMR
REF65
12/12/23, TDN
FD TONE. DID NOT
UNCOVER. PAINTED
8/7/24, JAM

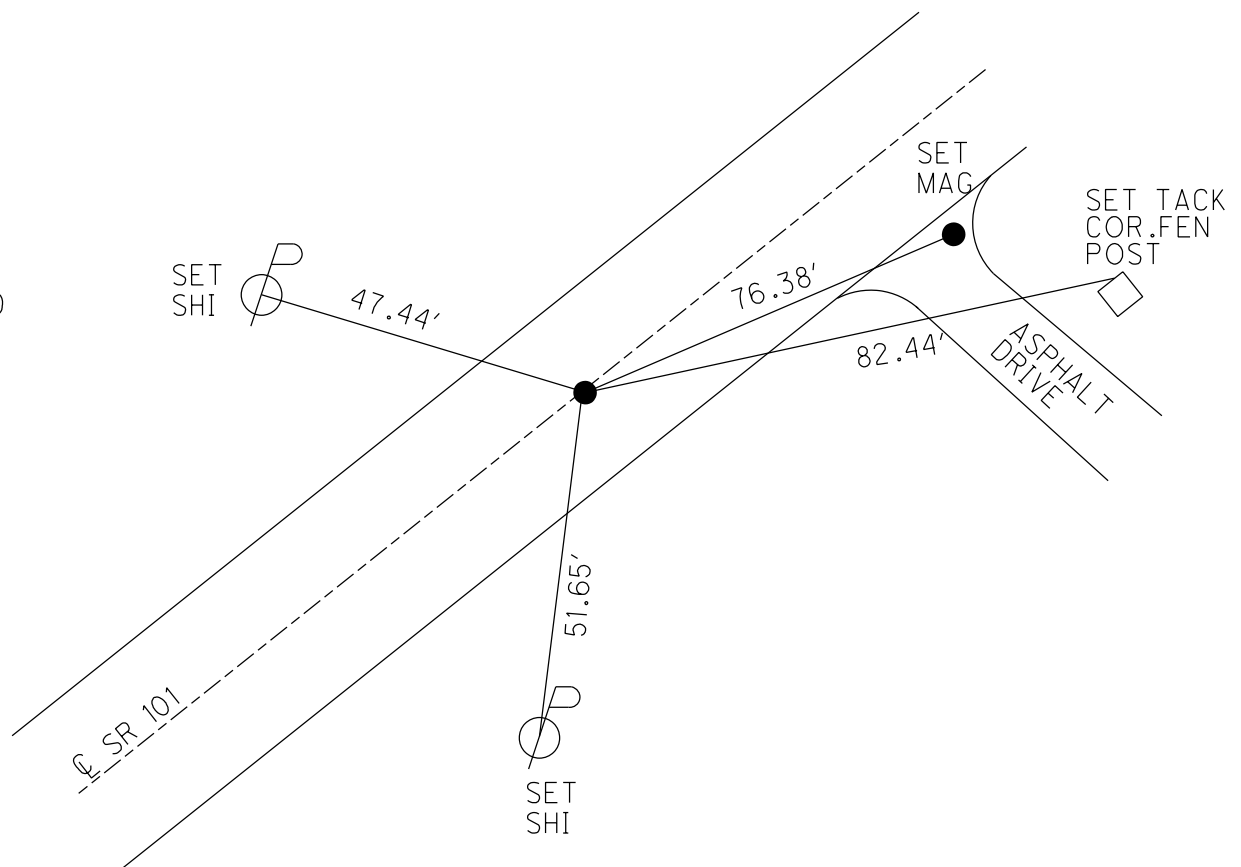

O.D.O.T. DISTRICT 2 SURVEY OFFICE (USE ONLY)

PERSONNEL

REFERENCE NO. 66

SHEET 45 OF 46

NOTES MILLER

DATE 8/7/24

ROUTE SR 101

H.C. MILLER

WEATHER SUNNY

COUNTY SENECA

R.C. BARRIERE

TEMP. 43°F

TOWNSHIP ADAMS

BLUBAUGH, ASTON, PRESTON-COLVIN

SECTION 2

DWG BY BLUBAUGH

PID 114849

T 3 N R 16 E

TYPE MONUMENT 5/8" IPIN

~~ON SURFACE~~ - BELOW 6.5"

OFFSET $\odot$ PAVEMENT 10.5' LT : RT

-- TO -- EDGE PAVEMENT

STATION: 782+25

HORIZ.DATUM: NAD83 (2011)


GEOID: NAVD88-2018

GRID: NORTHING: 579407.932

EASTING: 1836662.427

LDP: NORTHING: 348546.110

EASTING: 210923.317

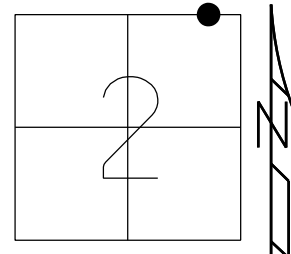

RECORD: P.I.
STA. 782+00
FD IPIN
5" DOWN
SET P.K./WASHER
10/1/92, BARBOUR
FD P.K./WASHER
REF66
10/7/09, DCH
FD 5/8" IPIN
6.5" DOWN
REF1
6/16/16, JFO
9/12/17, JMR
REF1
12/11/23, JAM
FD TONE. DID NOT
UNCOVER. PAINTED
8/7/24, JAM

NOTE: REF 66 SEN CO.

