


O.D.O.T. DISTRICT 2 SURVEY OFFICE (USE ONLY)


PERSONNEL	REFERENCE NO. <u>26</u>	SHEET <u>27</u> OF <u>27</u>
NOTES <u>MILLER</u>	DATE <u>8/7/24</u>	ROUTE <u>SR 101</u>
H.C. <u>MILLER</u>	WEATHER <u>SUNNY</u>	COUNTY <u>SENECA</u>
R.C. <u>BARRIERE</u>	TEMP. <u>66</u>	TOWNSHIP <u>CLINTON</u>
		SECTION <u>2</u>
DWG BY <u>BLUBAUGH</u>	PID <u>114849</u>	T <u>2</u> N R <u>15</u> E

TYPE MONUMENT MAG/WASHER
 ON SURFACE - ~~BELOW~~ ON
 OFFSET CL PAVEMENT 2' LT : RT
8' TO RT EDGE PAVEMENT
 STATION: 291+23.53

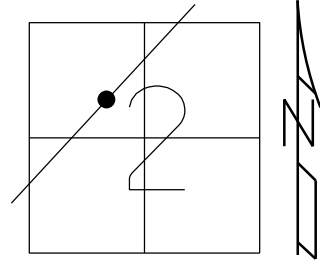

HORZ.DATUM: <u>NAD83 2011</u>	GEOID: <u>2012A NAVD88</u>
GRID: NORTHING: <u>545478.800</u>	EASTING: <u>1801435.843</u>
LDP: NORTHING: <u>314352.220</u>	EASTING: <u>175947.561</u>

RECORD: P.C.
 STA. 49+35.6
 R.R.SPIKE ON CL R/W
 11-23-95
 FD P.K.NAIL
 7/21/92, CHENEY
 SET P.K./WASHER
 10-1-92
 FD MAG/WASHER
 REF 26
 6-14-16, JFO
 SET MAG/WASHER
 10-9-18, JFO
 FD MAG/WASH
 REF 26
 12/20/23, DSA
 8/9/24, JAM

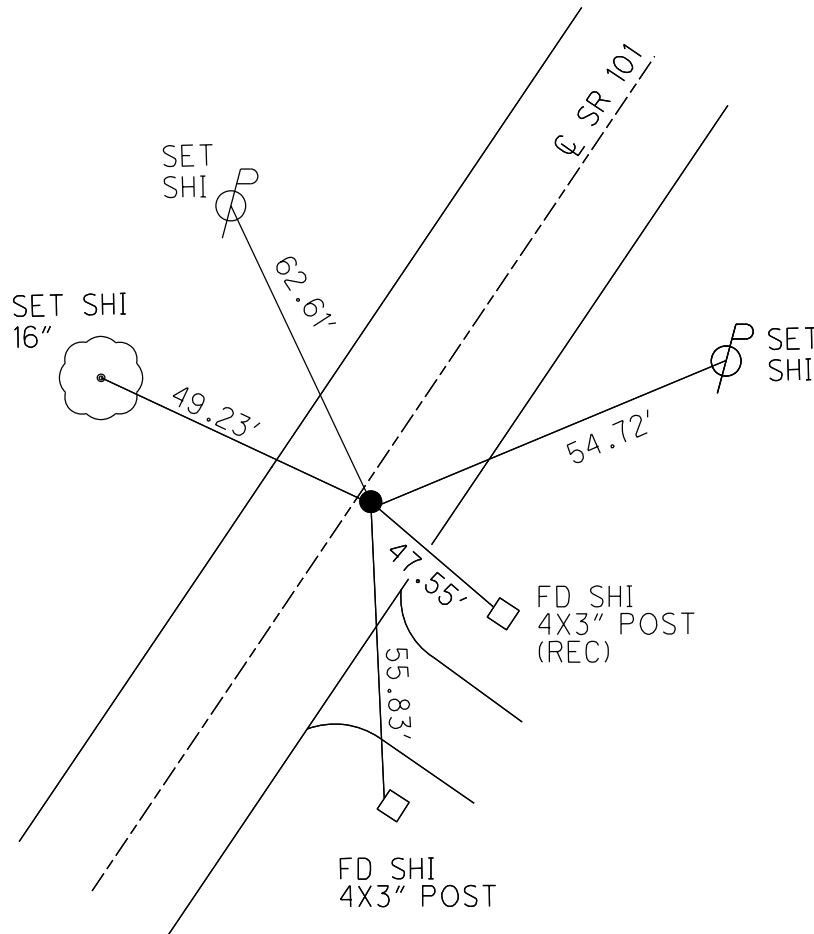

O.D.O.T. DISTRICT 2 SURVEY OFFICE (USE ONLY)

PERSONNEL

REFERENCE NO. 26

SHEET 27 OF 27

NOTES RHOADES
H.C. O'DONNELL
R.C. SEAMAN

DATE 3/23/18
WEATHER SUNNY
TEMP. 33°

ROUTE SR 101
COUNTY SENECA
TOWNSHIP CLINTON
SECTION 2

DWG BY MILLER PID 102817

T 2 N R 15 E

TYPE MONUMENT MAG/WASHER

ON SURFACE - ~~BELOW~~ ON

OFFSET 8' TO RT EDGE PAVEMENT
PAVEMENT 2' LT : RT


STATION: 291+23.53

HORZ. DATUM: NAD83 2011


GEOID: 2012A NAVD88

GRID: NORTHING: 545478.800

EASTING: 1801435.843

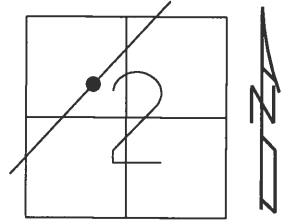

RECORD: P.C.
STA. 49+35.6
R.R. SPIKE ON $\angle$ R/W
11-23-95
FD P.K. NAIL
7/21/92, CHENEY
SET P.K./WASHER
10-1-92
FD MAG/WASHER
REF 26
6-14-16, JFO
SET MAG/WASHER
10-9-18, JFO

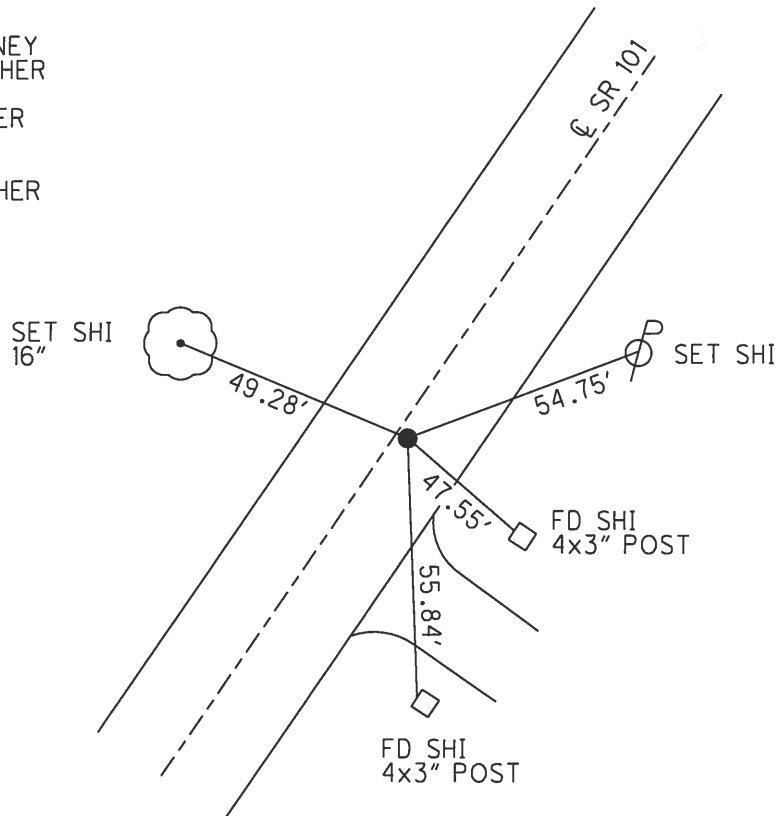

O.D.O.T. DISTRICT 2 SURVEY OFFICE (USE ONLY)

PERSONNEL

REFERENCE NO.

26

SHEET 27 OF 27

NOTES

CHENEY

DATE

7/21/92

ROUTE SR 101

H.C.

RIPPLE

WEATHER

SUNNY

COUNTY SENECA

R.C.

BARBOUR

TEMP.

55°

TOWNSHIP CLINTON

SECTION 2

T 2 N R 15 E

TYPE MONUMENT P.K.NAIL


ON SURFACE - ~~BELOW~~ ON

LEFT - C PAV'T - RIGHT 2'


8' TO RT EDGE PAVEMENT

S.L.M. 291+31

GRID: NORTHING: 545478.802 EASTING: 1801435.854

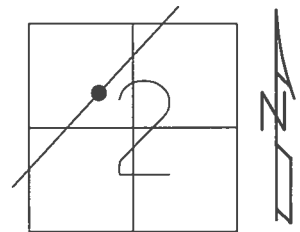

RECORD: P.C.
STA. 49+35.6
R.R.SPIKE ON C R/W
11/23/95
SET P.K./WASHER
10/1/92
FD MAG/WASHER
REF26
6/14/16, JFO

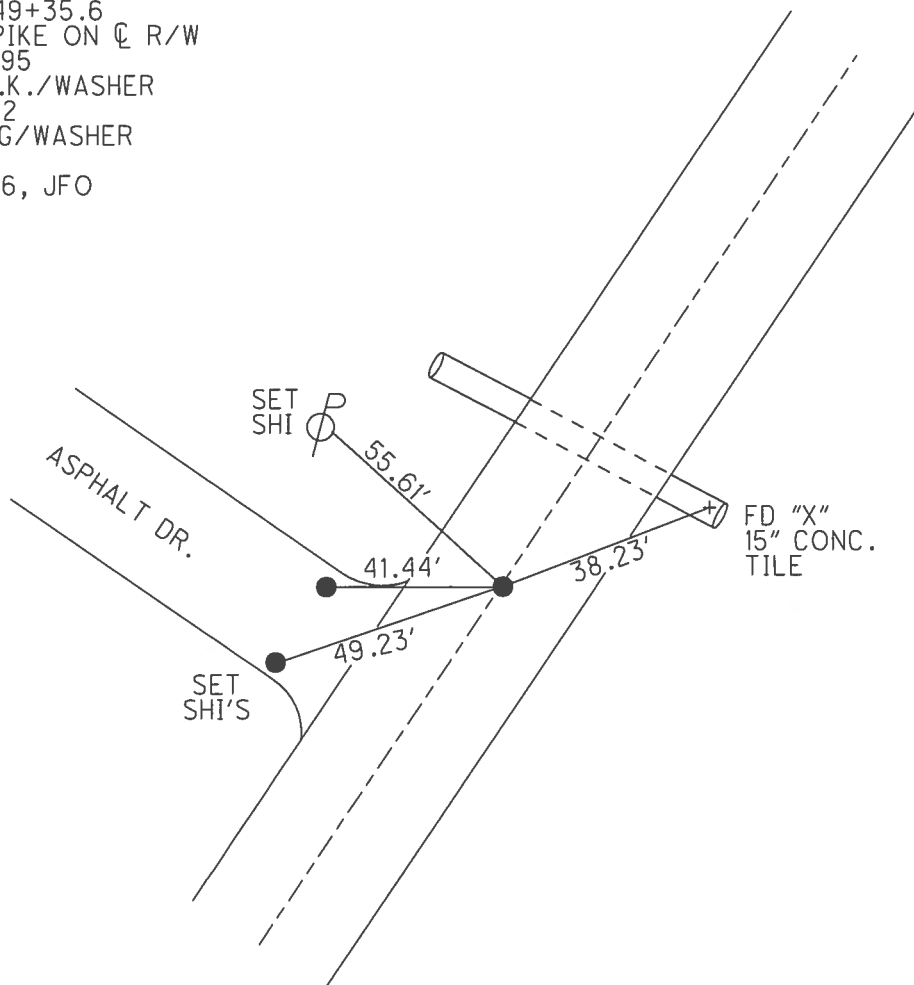

O.D.O.T. DISTRICT 2 SURVEY OFFICE (USE ONLY)

PERSONNEL

REFERENCE NO.

26

SHEET 27 OF 27

NOTES

CHENEY

DATE

7/21/92

ROUTE SR 101

H.C.

RIPPLE

WEATHER

SUNNY

COUNTY SENECA

R.C.

BARBOUR

TEMP.

55°

TOWNSHIP CLINTON

SECTION 2

T 2 N R 15 E

TYPE MONUMENT P.K.NAIL


ON SURFACE - ~~BELOW~~ ON

~~LEFT~~ - C PAV'T - RIGHT 2'


8' TO RT EDGE PAVEMENT

S.L.M. 291+31

GRID: NORTHING: - EASTING: -

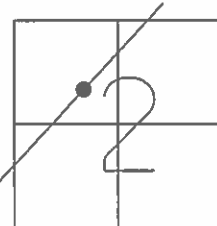

RECORD: P.C.
STA. 49+35.6
R.R.SPIKE ON C R/W
11/23/95
SET P.K./WASHER
10/1/92

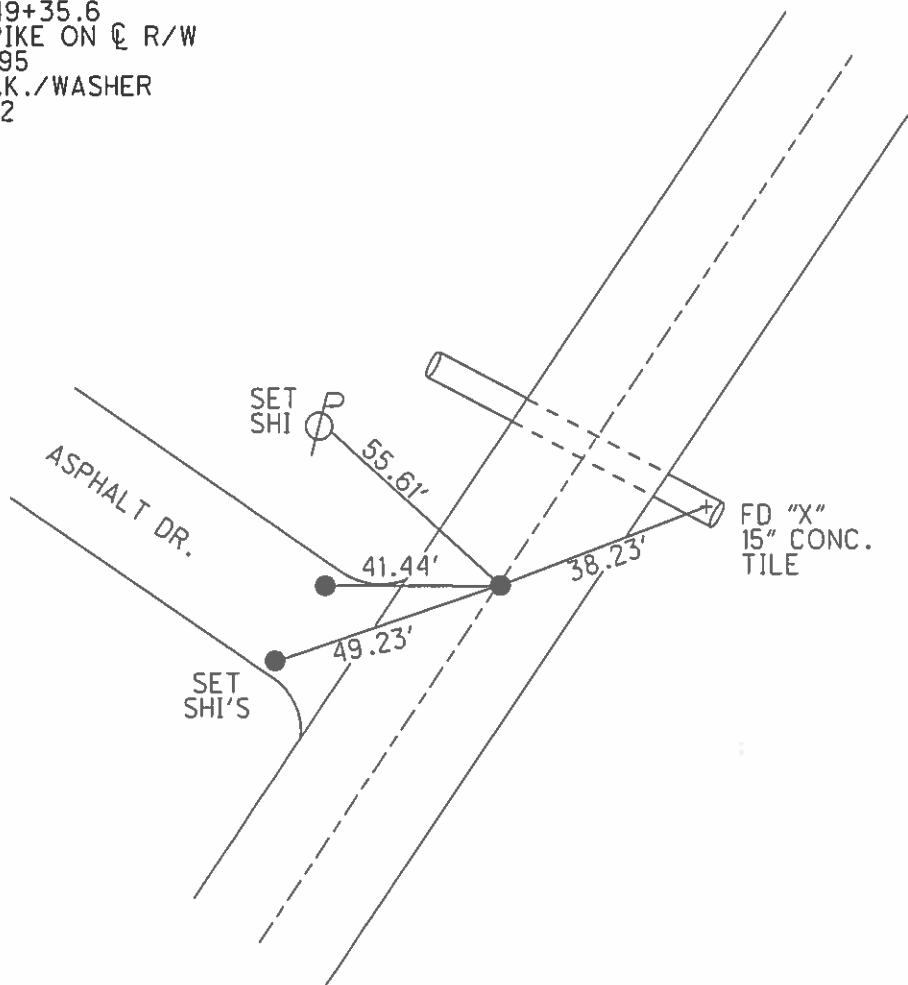

O.D.O.T. DISTRICT 2 SURVEY OFFICE

PERSONNEL

REFERENCE NO. 26

SHEET 26 OF 26

NOTES Cheney

H.C. RIPPLE

R.C. BARBOUR

DATE 7-21-92

WEATHER SUNNY

TEMP. 55°

ROUTE S.R.# 101

COUNTY SENECA

TOWNSHIP CLINTON

SECTION 2

T2NR15E

TYPE MONUMENT P.K.?

ON SURFACE - ~~BELOW~~ yes

~~LEFT~~ - @ PAN'T. - RIGHT '2'

8' TO RT. EDGE PAVEMENT

S.L.M. 291+31


Set
P.K. & Washer
10-01-92

3	2
10	11



RECORD: 11-23-65
Fd. RR Spk on E R/W
STA. 49+35.6
P.C. = R.R. Spk
down station

$$291 + 20$$
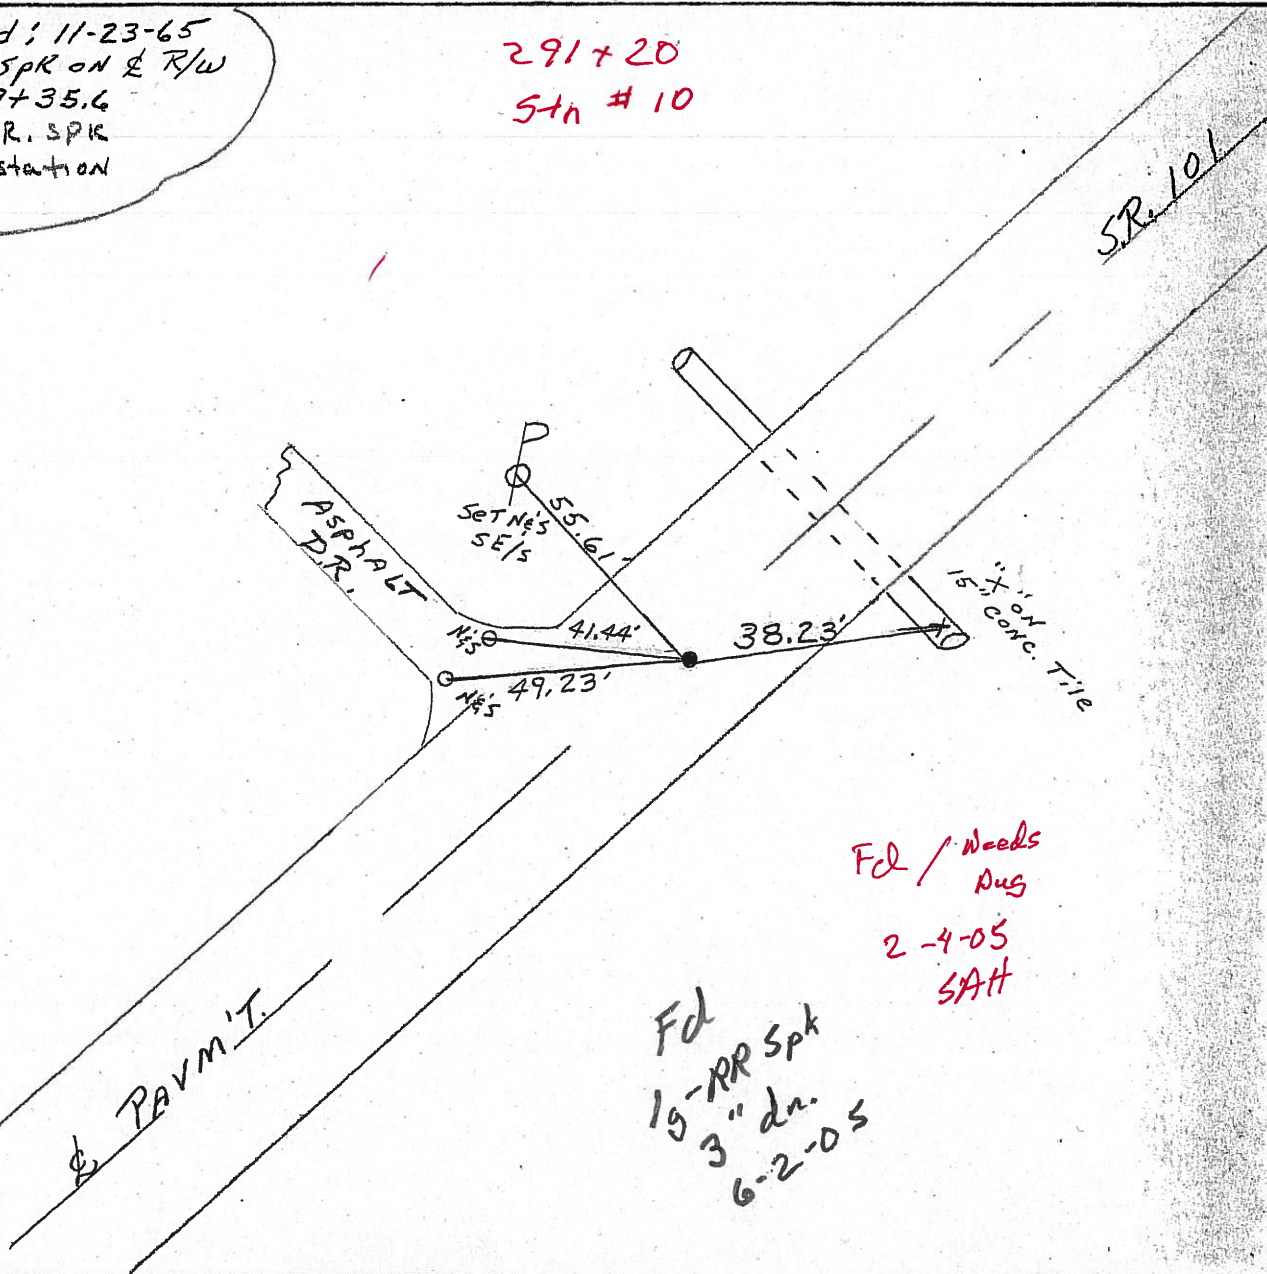
$$5th \# 10$$


O.D.O.T. DISTRICT 2 SURVEY OFFICE

PERSONNEL

REFERENCE NO. 26

SHEET 27 OF 27

NOTES Cheney

H.C. RIPPLE

R.C. BARBOUR

DATE 17-21-92

WEATHER SUNNY

TEMP. 55°

ROUTE SR. #101

COUNTY SENECA

TOWNSHIP CLINTON

SECTION 2

T. 2 N R. 15 E

TYPE MONUMENT P.K. ?

ON SURFACE - BELOW yes

LEFT - C PAV'T. - RIGHT 2'

8' TO RT. EDGE PAVEMENT


S.L.M. 291#31

Set
P.K. # washer
10-01-92

3	2
10	11



Record: 11-23-65
Fd. RR SPK on & R/W
STA. 49+35.6 = P.C.
P.C. = R.R. SPK
down station

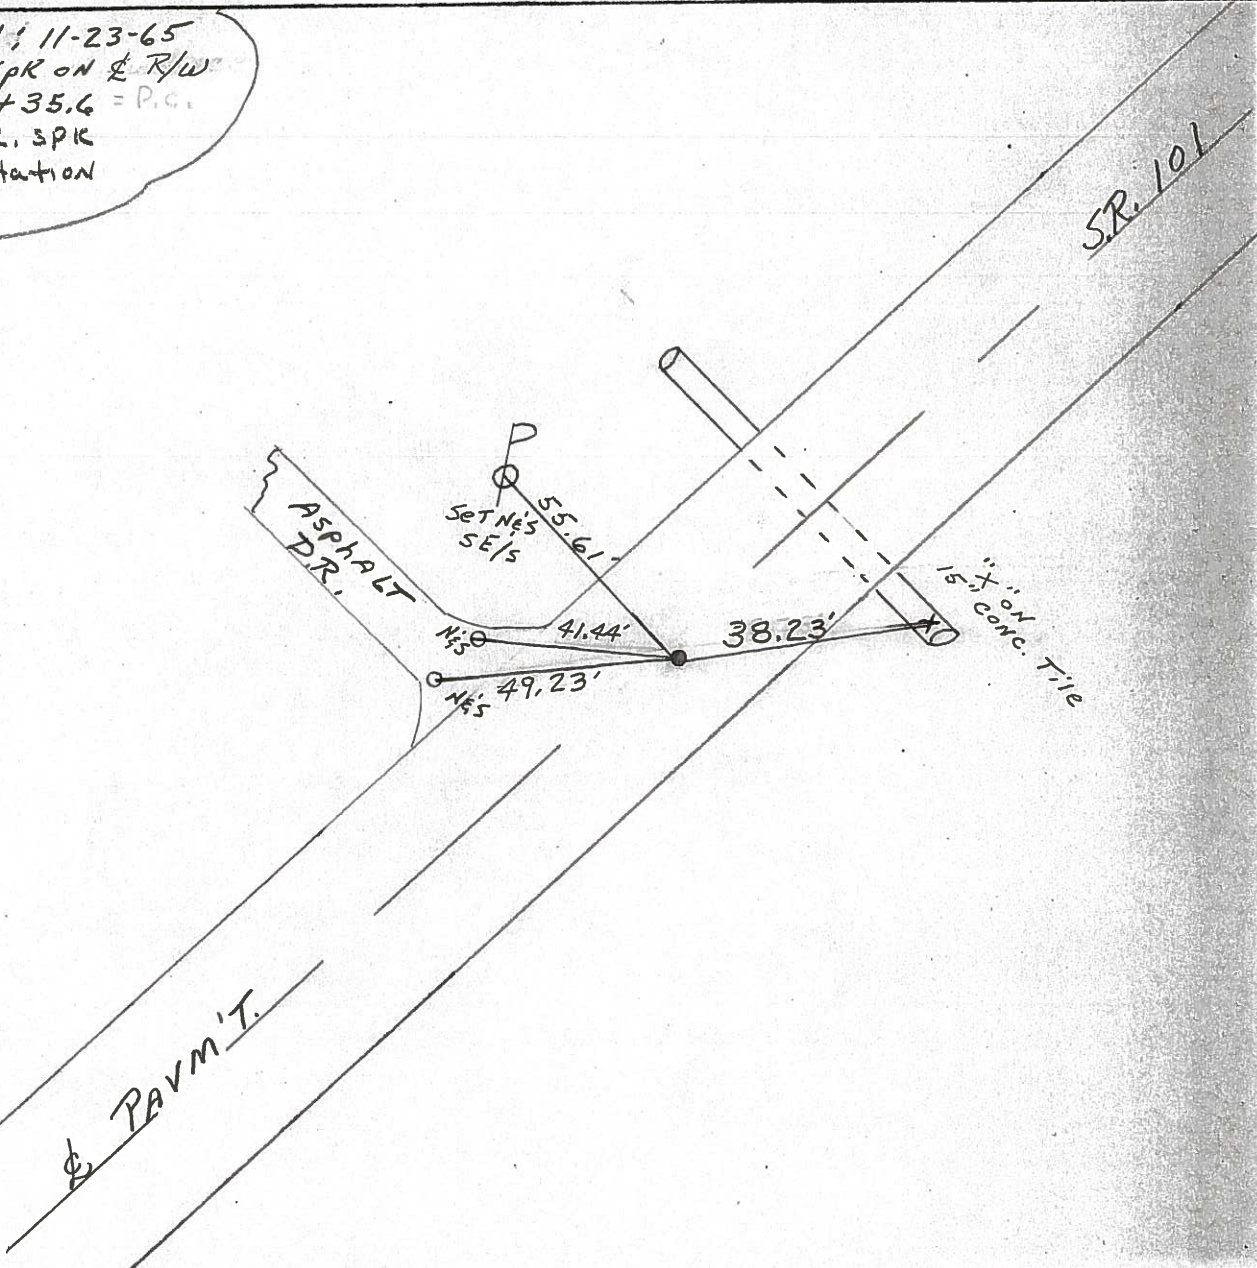

PERSONNEL TITLE PERSONNEL TITLE

COUNTY Seneca DATE 11-23-65

S. R. # 101 WEATHER

SEC. TEMP. 50°

DESCRIPTION LEFT CENTER LINE RIGHT JOB NO.

29

Ties Good 2/24/69
Sta. 115+72
R.R. spk. on & R/W
1 1/2" below surface

381

8477

28

Ties Good 2/24/69
Sta. 191+00
R.R. spk. on & R/W
1 1/2" below surface

380

8476

27

Ties Good - 2/24/69
Sta. 77+00
P.K. R.R. spk. on & R/W
1" 2" below surface

8475

379

Found
RT. - R.R. spk. 2-24-69
Ties Good 2/24/69

26

Sta. 49430.6
R.R. spk. on & R/W
on surface
2' R.R. & P.T.

8474


378

Found
P.C. - R.R. spk. 2-24-69

25

Found
Found R.R. spk.
on surface

8472

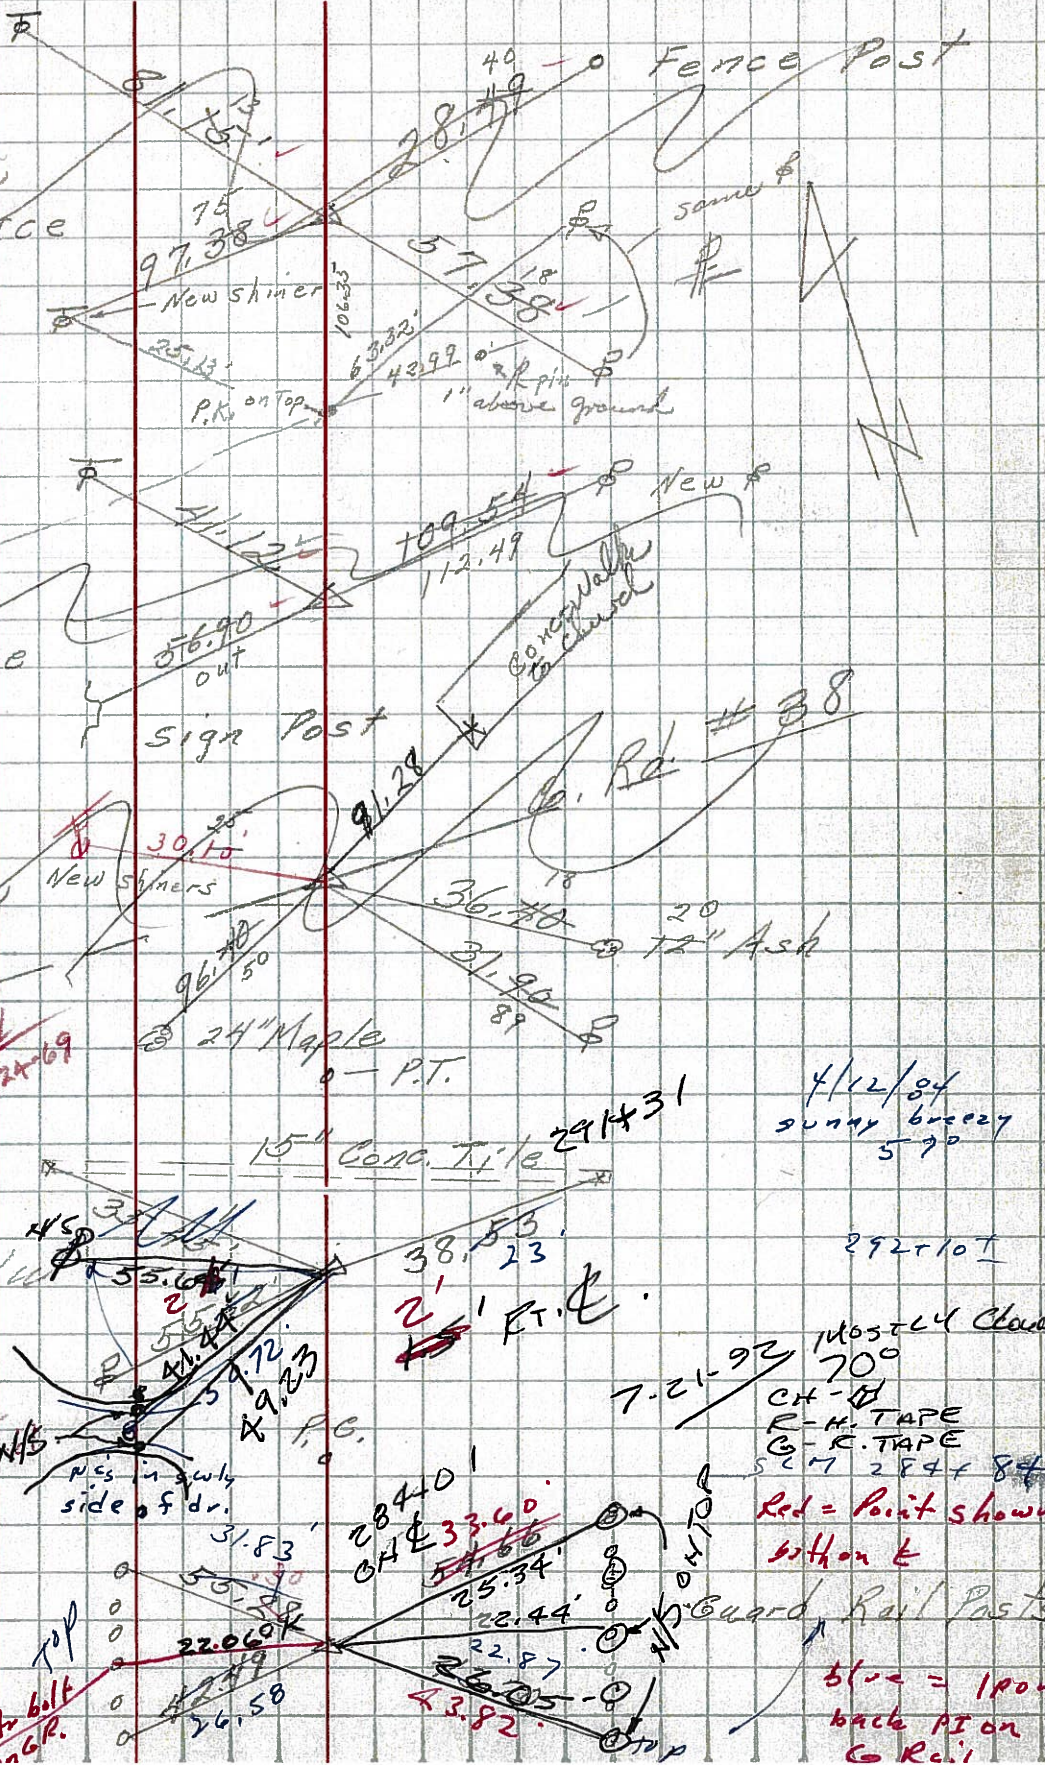

4/12/84
sunny breezy
5-70

292+10T

7-21-92
Mostly clear
700
CH - 1
R-H. TAPE
G-R. TAPE
SCT 284+84

Red = Point shown
on map

blue = 100
back P.I. on
G. Rd.

PERSONNEL

TITLE

PERSONNEL

TITLE

COUNTY Seneca

DATE

KrabillKowalskiGeymanS. R. # 101

WEATHER

SEC.

TEMP.

DESCRIPTION

LEFT

CENTER LINE

RIGHT

JOB NO.

(26)

STA. 44+24.59

R. R. Spike

397(A)