


O.D.O.T. DISTRICT 2 SURVEY OFFICE (USE ONLY)


PERSONNEL	REFERENCE NO. <u>27</u>	SHEET <u>1</u> OF <u>46</u>
NOTES <u>MILLER</u>	DATE <u>8/9/24</u>	ROUTE <u>SR 101</u>
H.C. <u>MILLER</u>	WEATHER <u>SUNNY</u>	COUNTY <u>SENECA</u>
R.C. <u>BARRIERE</u>	TEMP. <u>65</u>	TOWNSHIP <u>PLEASENT</u>
<u>BLUBAUGH</u>		SECTION <u>35</u>
DWG BY <u>BLUBAUGH</u>	PID <u>114849</u>	T <u>3</u> N R <u>15</u> E

TYPE MONUMENT MAG/WASHER
 ON SURFACE - ~~BELOW~~ 0.5"
 OFFSET $\oslash$ PAVEMENT ON LT : RT
-- TO -- EDGE PAVEMENT
 STATION: 318+73.57

HORZ.DATUM: <u>NAD83 2011</u>	GEOID: <u>NAVD88-2012A</u>
GRID: NORTHING: <u>547506.005</u>	EASTING: <u>1803294.084</u>
LDP: NORTHING: <u>316393.358</u>	EASTING: <u>177790.774</u>

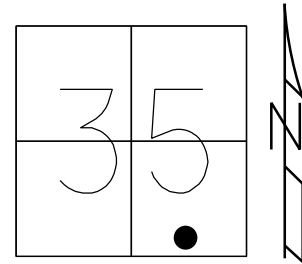

RECORD: P.O.T.
 SLM. 77+00
 SET P.K./ WASHER
 8-27-90
 FD P.K./WASHER
 2-4-05, SAH
 SET P.K./WASHER
 6/30/09, DCH
 SET MAG/WASHER
 NEWREF27
 10-05-09, DCH
 FD MAG/WASHER
 REF27
 6-14-16, JFO
 10-12-16, JFO
 9-18-17, JFO
 FD MAG/WASH
 REF27
 12/20/23, DSA
 FD TONE, DID NOT
 UNCOVER, PAINTED
 8/9/24, JAM

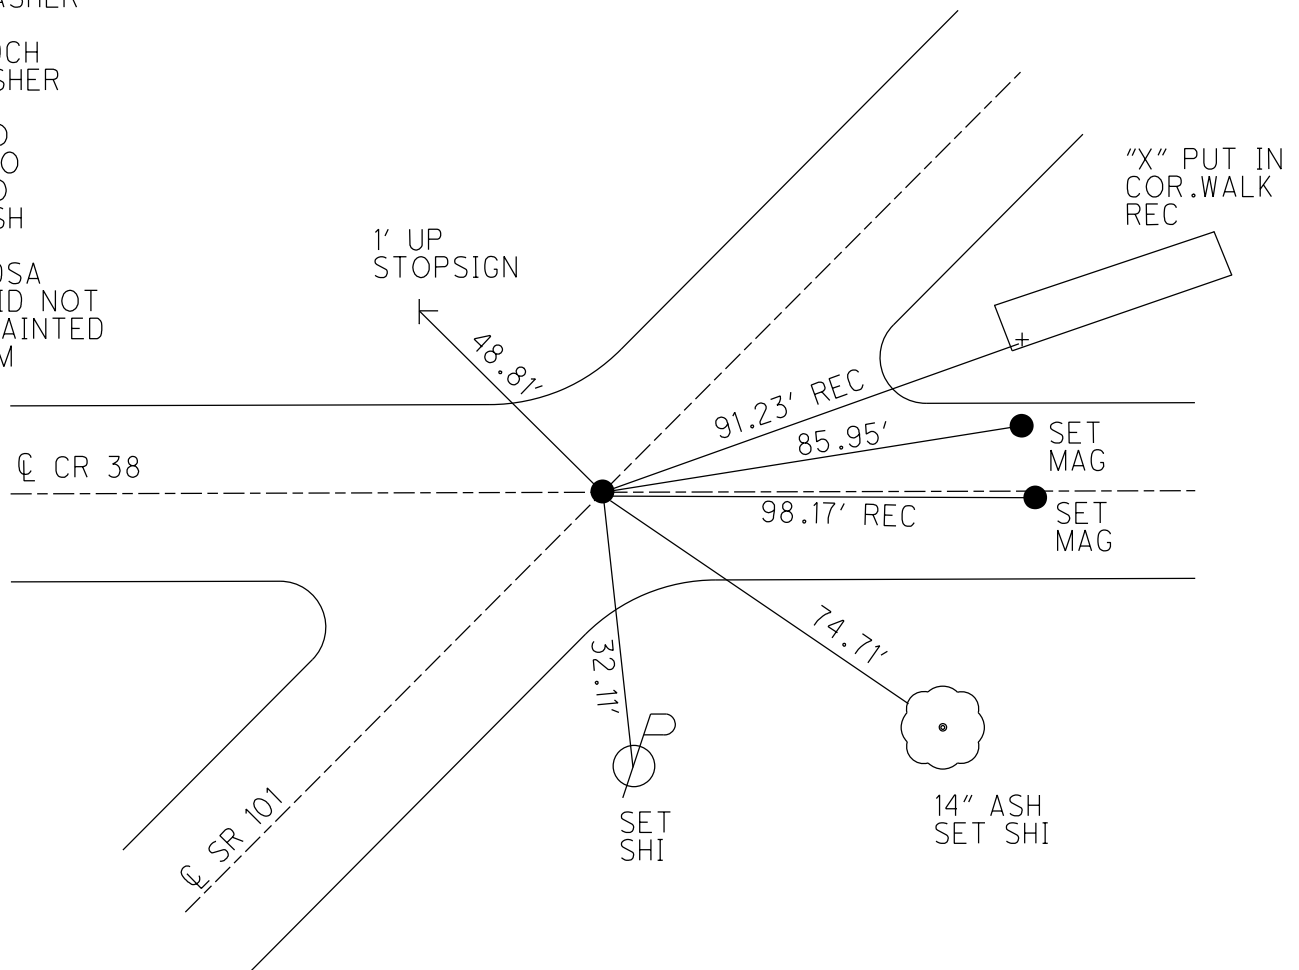

O.D.O.T. DISTRICT 2 SURVEY OFFICE (USE ONLY)

PERSONNEL

REFERENCE NO. 27

SHEET 1 OF 46

NOTES HOMAN

DATE 6-30-09

ROUTE SR 101

H.C. HOMAN

WEATHER SUNNY

COUNTY SENECA

R.C. ROUSOS

TEMP. 65°F

TOWNSHIP PLEASENT

SECTION 35

DWG BY MAHLER

PID 100787

T 3 N R 15 E

TYPE MONUMENT MAG/WASHER

ON SURFACE - ~~BELOW~~ ON

OFFSET $\oslash$ PAVEMENT ON LT : RT

- TO - EDGE PAVEMENT


STATION: 318+73.57

HORZ.DATUM: NAD83 2011


GEOID: NAVD88-2012A

GRID: NORTHING: 547506.005

EASTING: 1803294.084

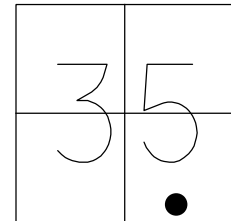


RECORD: P.O.T.
SLM. 77+00
SET P.K./ WASHER
8-27-90
FD P.K./WASHER
2-4-05, SAH
SET P.K./WASHER
6/30/09, DCH
SET MAG/WASHER
NEWREF27
10-05-09, DCH
FD MAG/WASHER
REF27
6-14-16, JFO
10-12-16, JFO
9-18-17, JFO

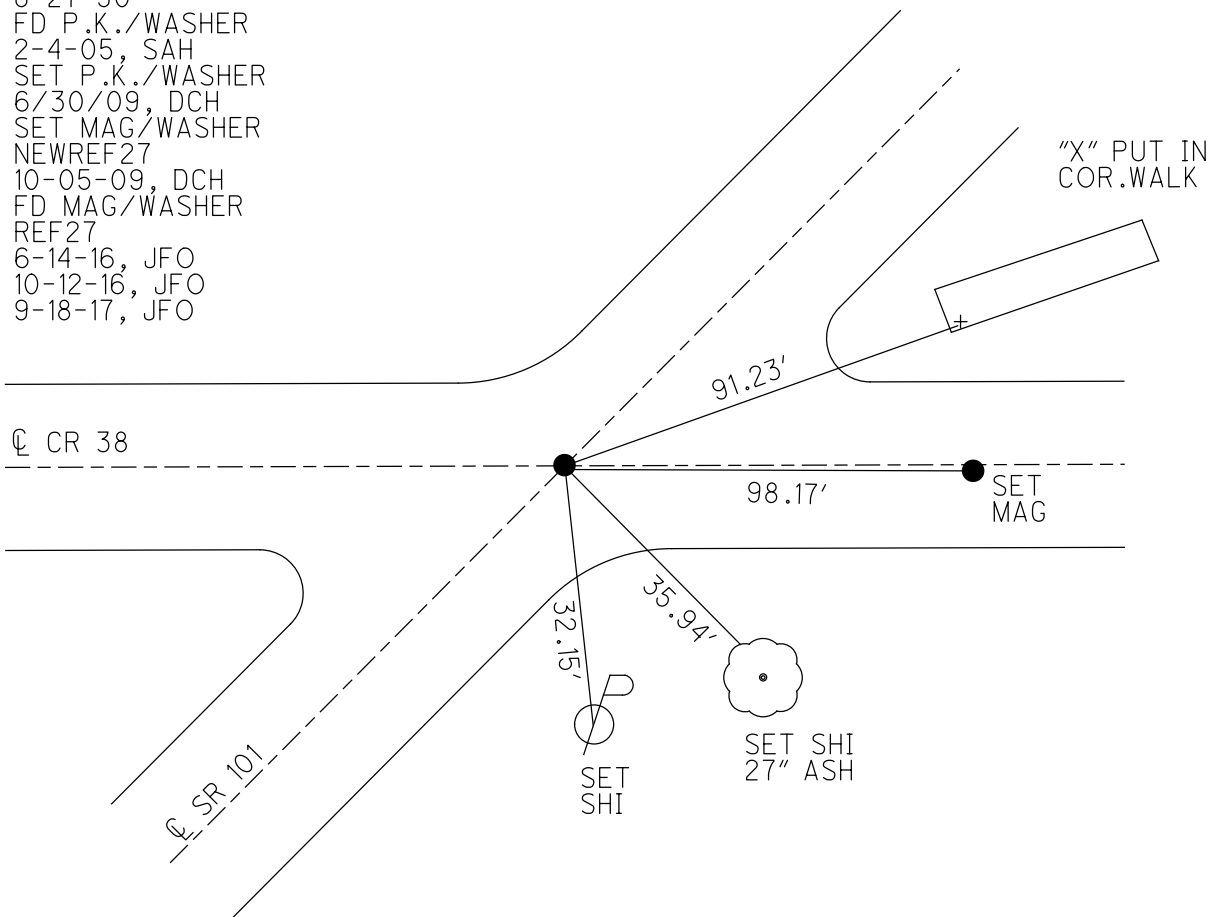

O.D.O.T. DISTRICT 2 SURVEY OFFICE (USE ONLY)


PERSONNEL	REFERENCE NO. <u>27</u>	SHEET <u>1</u> OF <u>46</u>
NOTES	DATE <u>6/30/09</u>	ROUTE <u>SR 101</u>
H.C. <u>HOMAN</u>	WEATHER <u>SUNNY</u>	COUNTY <u>SENECA</u>
R.C. <u>ROUSOS</u>	TEMP. <u>65°</u>	TOWNSHIP <u>PLEASANT</u>
		SECTION <u>35</u>
		T <u>3</u> N R <u>15</u> E

TYPE MONUMENT MAG/WASHER
 ON SURFACE - ~~BELOW~~ ON
 LEFT - ℄ PAV'T - RIGHT ON
- TO - EDGE PAVEMENT
 S.L.M. 318+73.57

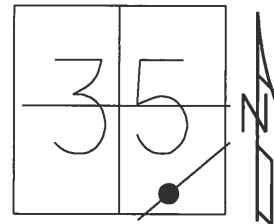

GRID: NORTHING: 547506.027 EASTING: 1803294.082


RECORD: P.O.T.
 SLM. 77+00
 SET P.K./ WASHER
 8-27-90
 FD P.K./WASHER
 2-4-05, SAH
 SET P.K./WASHER
 6/30/9, DCH
 SET MAG/WASHER
 10-05-09, DCH
 FD MAG/WASHER
 REF27
 6-14-16, JFO
 FD MAG/WASHER
 REF27
 10-12-16, JFO
 9-18-17, JFO

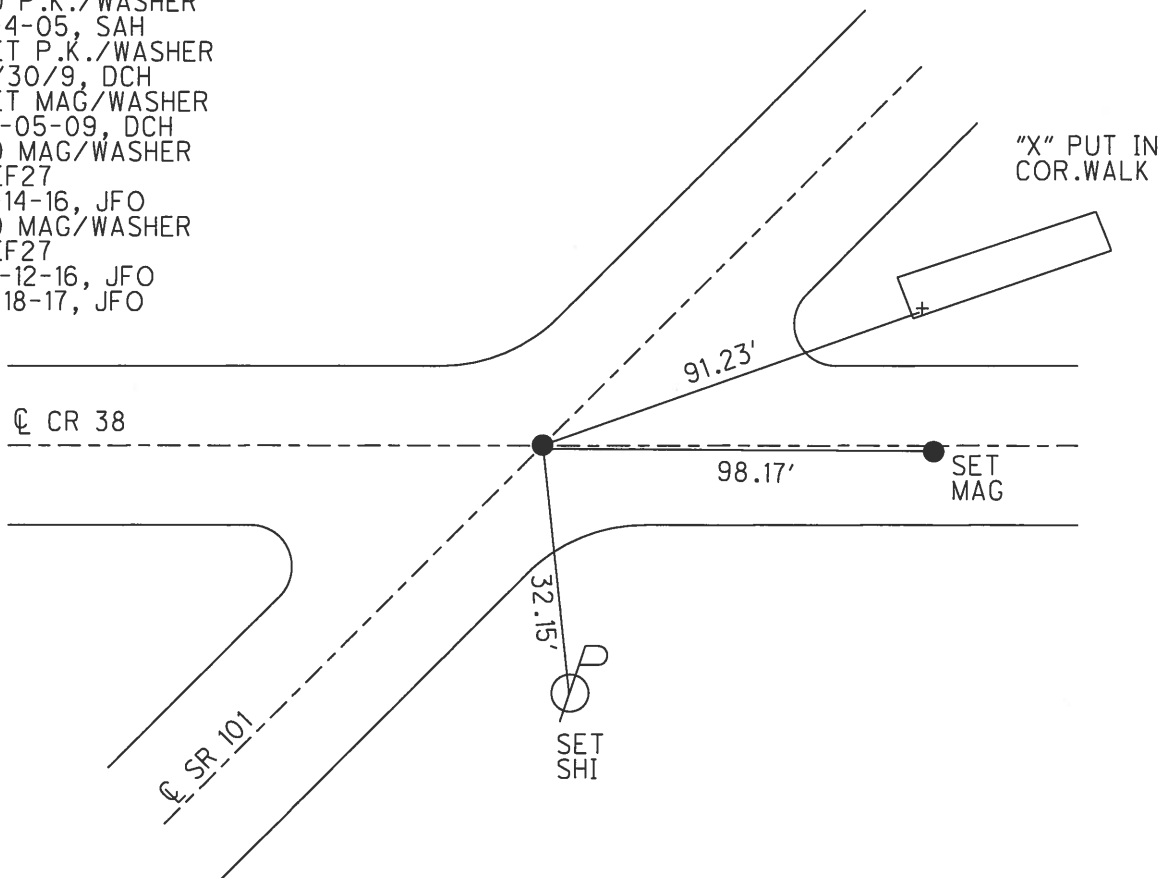

O.D.O.T. DISTRICT 2 SURVEY OFFICE (USE ONLY)


PERSONNEL _____ REFERENCE NO. 27 SHEET 1 OF 46
 NOTES HOMAN _____ DATE 6/30/09 ROUTE SR 101
 H.C. HOMAN _____ WEATHER SUNNY COUNTY SENECA
 R.C. ROUSOS _____ TEMP. 65° TOWNSHIP PLEASANT
 _____ SECTION 35
 _____ T 3 N R 15 E

TYPE MONUMENT _____ P.K./WASHER _____
 ON SURFACE - ~~BELOW~~ _____ ON _____
 LEFT - $\odot$ PAV'T - RIGHT _____ ON _____
 - TO - EDGE PAVEMENT _____
 S.L.M. 318+73

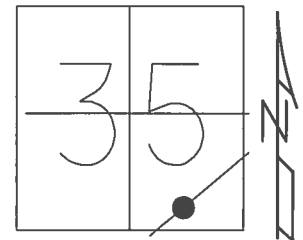

GRID: NORTHING: 547506.005 EASTING: 1803294.084


RECORD: P.O.T.
 SLM. 77+00
 SET P.K./ WASHER
 8/27/90
 FD P.K./WASHER
 2/4/05, SAH
 SET MAG/WASHER
 10-05-09, DH
 FD MAG/WASHER
 REF27
 6/14/16, JFO
 UNCOVERED
 9/18/17, JFO

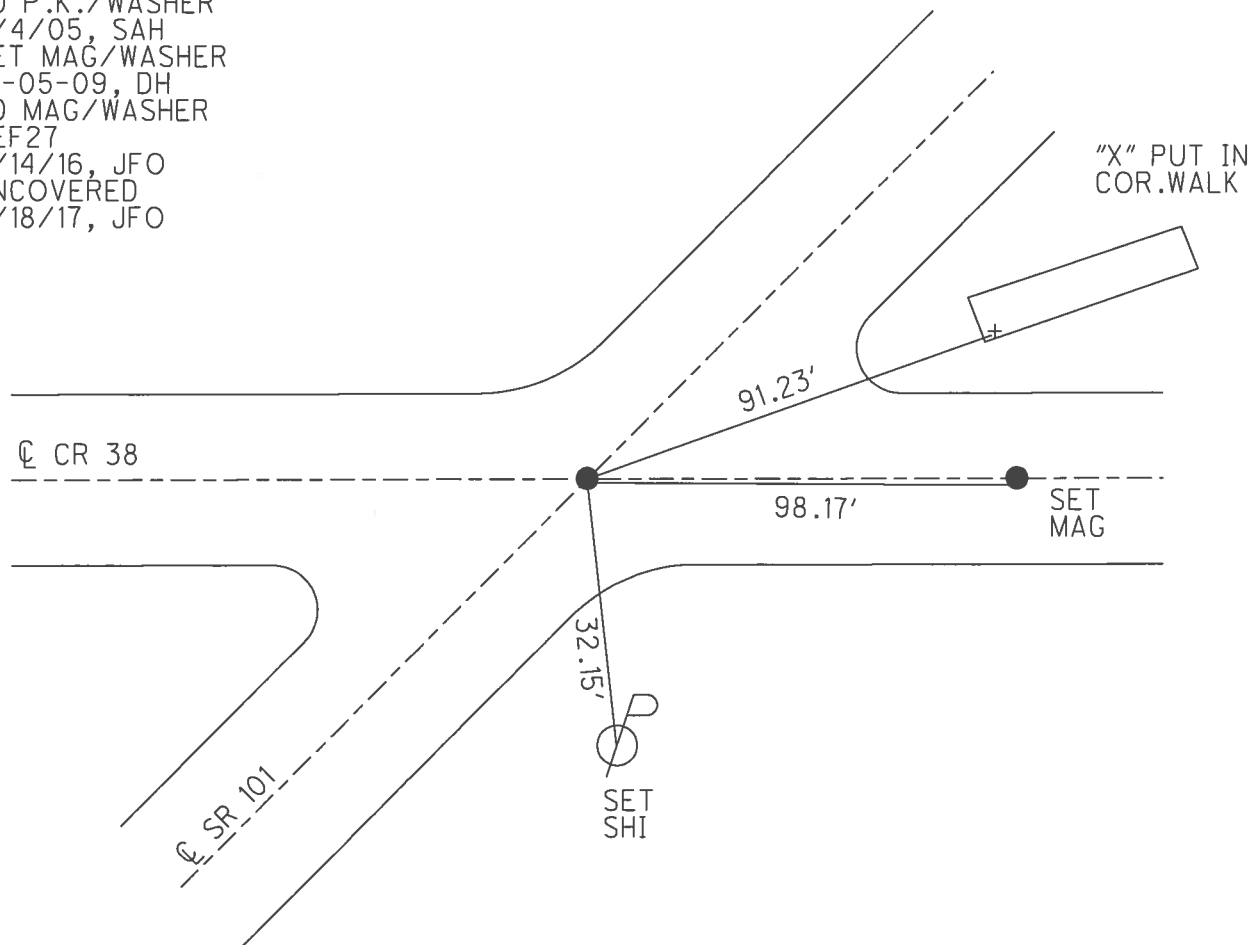

O.D.O.T. DISTRICT 2 SURVEY OFFICE (USE ONLY)


PERSONNEL	REFERENCE NO.	27	SHEET	1	OF	46
NOTES	HOMAN	DATE	6/30/09	ROUTE	SR 101	
H.C.	HOMAN	WEATHER	SUNNY	COUNTY	SENECA	
R.C.	ROUSOS	TEMP.	65°	TOWNSHIP	PLEASANT	
				SECTION	35	
				T	3	N
				R	15	E

TYPE MONUMENT P.K./WASHER
 ON SURFACE - ~~BELOW~~ ON
 LEFT - Q PAV'T - RIGHT ON
- TO - EDGE PAVEMENT
 S.L.M. 318+73

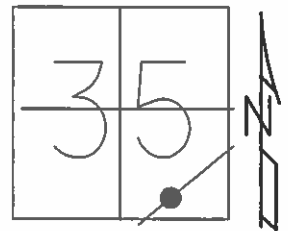

GRID: NORTHING: 547506.058 EASTING: 1803294.020

RECORD: P.O.T.
 SLM. 77+00
 SET P.K./ WASHER
 8/27/90
 FD P.K./WASHER
 2/4/05, SAH
 SET MAG/WASHER
 10-05-09, DH

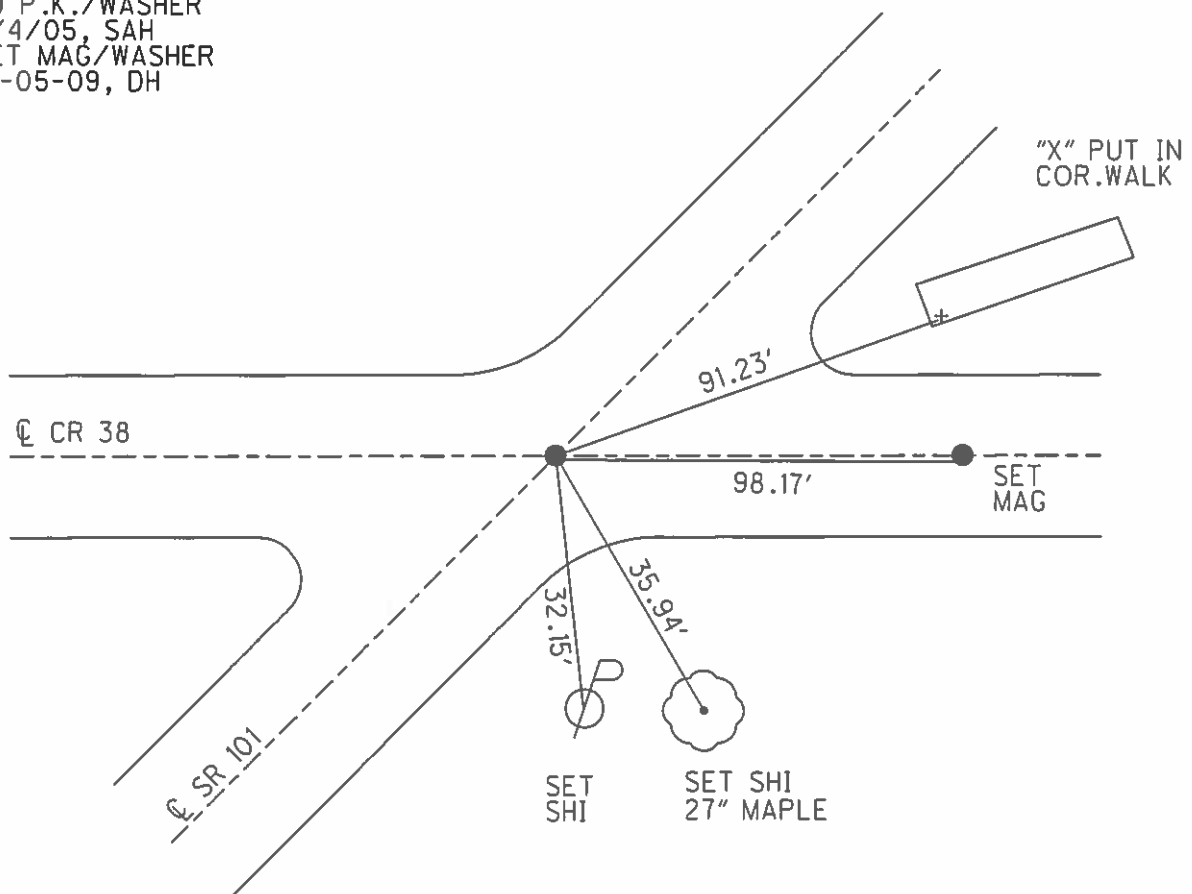

O.D.O.T. DISTRICT 2 SURVEY OFFICE

PERSONNEL

REFERENCE NO. 27

SHEET 1 OF 41

NOTES Rippie

H.C. BARBOUR

R.C. _____

DATE 8/27/90

WEATHER SUNNY

TEMP. 73°

ROUTE SR#101

COUNTY SENECA

TOWNSHIP PLEASANT

SECTION 35

T 3 N R 15 E


TYPE MONUMENT SET P.K. & WASHER

ON SURFACE - BELOW P.K. NAIL

LEFT - CL PAW'T. - RIGHT CL

TO EDGE PAVEMENT

S.L.M. _____

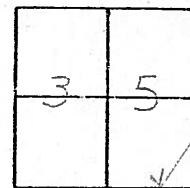

P.O.T. 77+00

318+73

CONC. WALK
"X" CUT IN CORNER
WALK

Co. Rd. #387

Fd
02-04-05
SAH

24" Ash

THIS Ref. out - North
CHECK OLD Ref
TIES ON FILE

SR#101

O.D.O.T. DISTRICT 2 SURVEY OFFICE

PERSONNEL

REFERENCE NO. 27

SHEET 1 OF 41

NOTES Ripple

H.C. BARBOUR

R.C. _____

DATE 8/27/90

WEATHER SUNNY

TEMP. 73°

ROUTE SR#101

COUNTY SENECA

TOWNSHIP PLEASANT

SECTION 35

T 3 N R 15 E


TYPE MONUMENT SET P.K. & WASHER

ON SURFACE - BELOW P.K. NAIL


LEFT- & PAV'T. - RIGHT &

TO EDGE PAVEMENT

S.L.M. _____

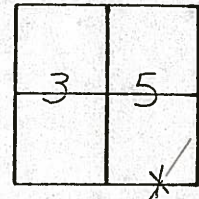

P.O.T. 77+00

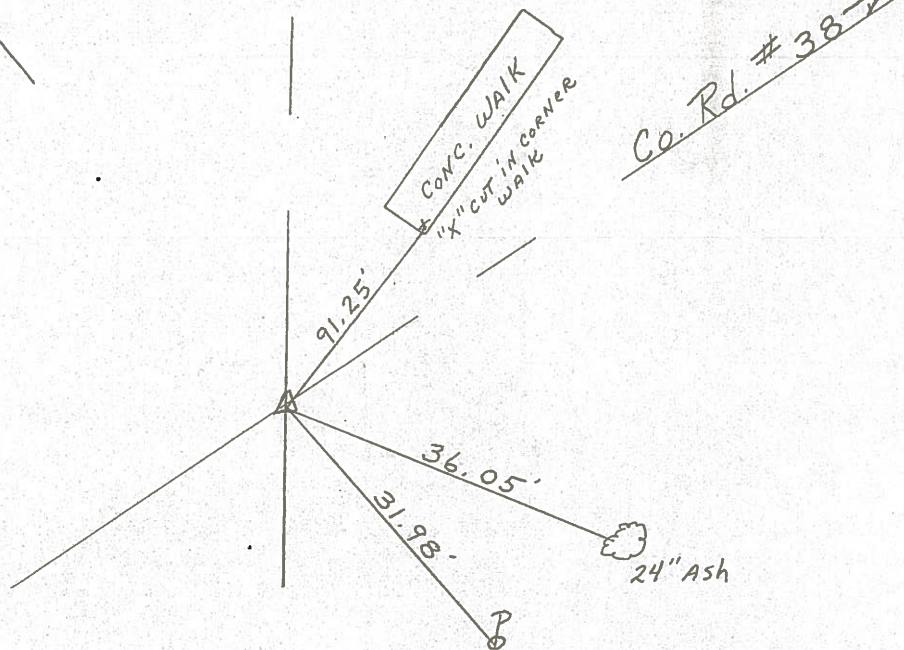

THIS REF. ONLY - NOT A
CHECK OLD REF
TIES ON FILE

Q.D.O.T. DISTRICT 2 SURVEY OFFICE

Sht. ____ of ____

County Seneca S.R. 101

Township Pleasant

Section 35

T₃N, R₁₅E

Personnel Schneider



Mosser

Barbour

Date 6-26-79

Weather Fair

Temp. 65°

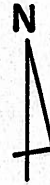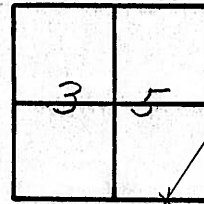

(27)

~~#36~~




R.O.T.

77+00

P.K. on & Rlw

Reset P.K. Nail

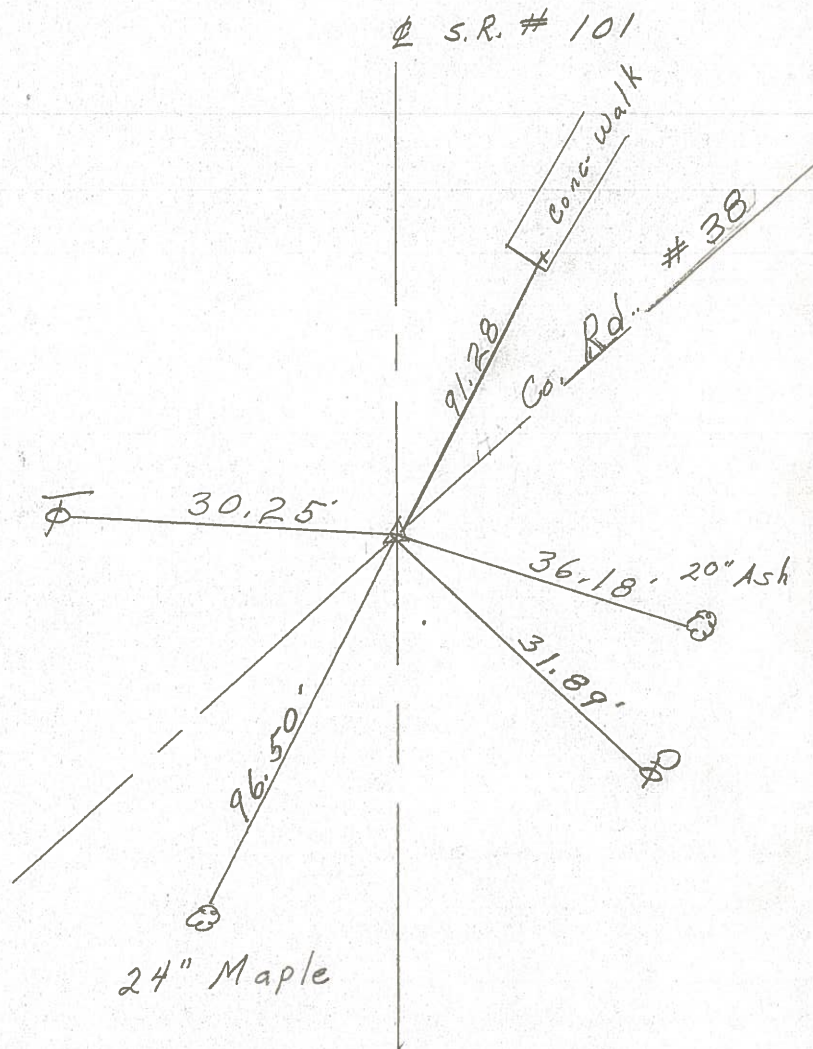

3-21-79

PERSONNEL TITLE PERSONNEL TITLE

COUNTY Seneca

DATE 11-23-69

S. R. # 101

WEATHER

SEC.

TEMP.

50°

DESCRIPTION

LEFT

CENTER LINE

RIGHT

JOB NO.

29

Ties Good 2/24/69

Sta. 115+72

R.R. spk. on & R/W
1 1/2" below surface

381

8477

28

Ties Good 2/24/69

Sta. 141+00

R.R. spk. on & R/W
1 1/2" below surface

380

8476

27

Ties Good - 2/24/69

Sta. 77+00

P.K. R.R. spk. on & R/W
1" & 2" below surface

8475

379

P.T. - R.R. spk. Found

2-24-69

8935
3792
1783

Ties Good 2/24/69

Sta. 19+35.6

R.R. spk. on & R/W
on surface126
1783
1817

26

8474

378


P.C. - R.R. spk. Found

2-24-69

25

Found R.R. spk.
on surface

8472

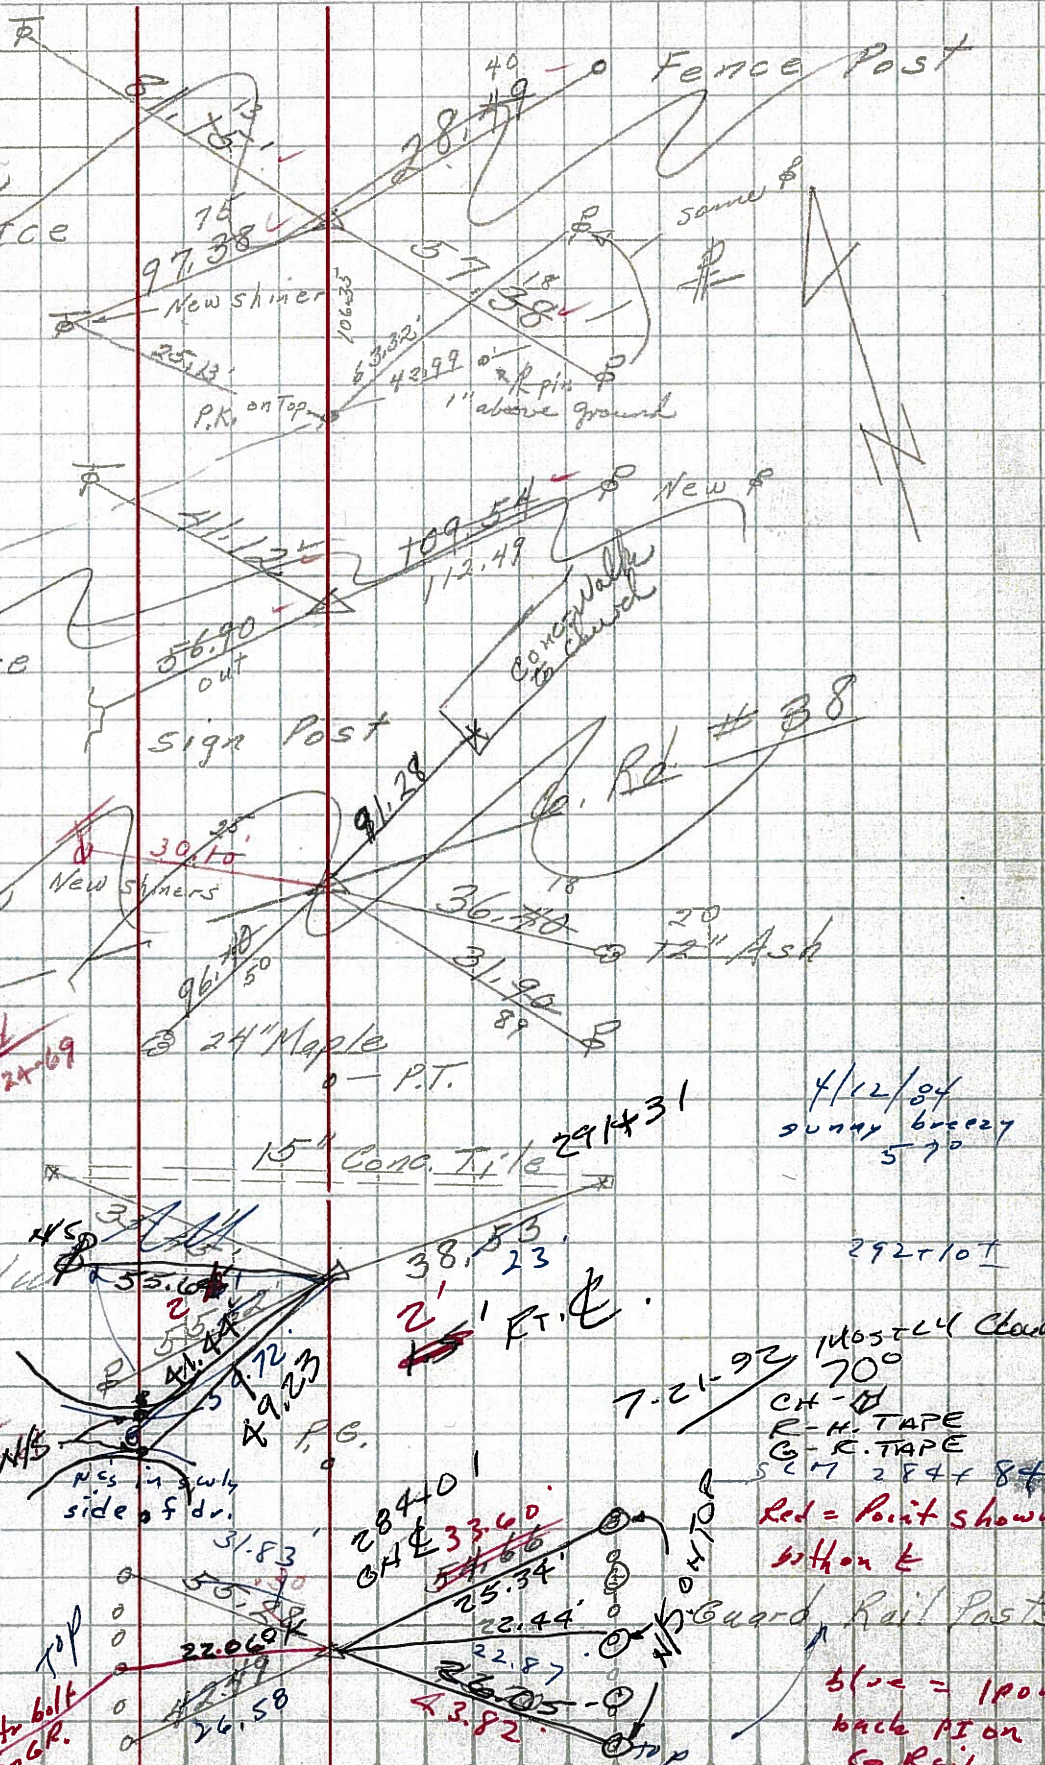chr bolt
on R.R.4/12/84
sunny breezy
57°

292+10+

Mostly clay
70°CH - H
R - K. TAPE
G - K. TAPE
SC - 284 x 84Red = Point shown
with on EBlue = 190°
back on
Co Rd

PERSONNEL TITLE PERSONNEL TITLE

COUNTY Seneca DATES. R. 101 WEATHER

SEC. TEMP.

DESCRIPTION LEFT CENTER LINE RIGHT JOB NO.

49+35.6

#378

RR spike

2-10-64

(27)

77+00

#379

P. Knail

2-10-64

Seneca Co Rd #38

Pleasant Twp

Seneca Co Rd #38

24' Maple 96.47'

Clinton Twp

31.25' (2)

(28)

101+00

#380

RR spike

2-10-64

#381

Pleasant Twp

steel stake

41.18'

109.53'

56.90'

(35)

(29)

115+72

P. Knail

2-10-64

81.15'

28.45'

Fence post

97.38'

57.38'

(36)