

O.D.O.T. DISTRICT 2 SURVEY OFFICE (USE ONLY)

PERSONNEL

REFERENCE NO. 29

SHEET 3 OF 46

NOTES MILLER

DATE 8/9/24

ROUTE SR 101

H.C. MILLER

WEATHER SUNNY

COUNTY SENECA

R.C. BARRIERE

TEMP. 66

TOWNSHIP PLEASENT

BLUBAUGH

SECTION 36

DWG BY BLUBAUGH

PID 114849

T 3 N R 15 E

TYPE MONUMENT P.K.NAIL

ON SURFACE - ~~BELOW~~ ON

OFFSET Q PAVEMENT ON LT : RT

-- TO -- EDGE PAVEMENT

STATION: 356+20

HORIZ.DATUM: NAD83 2011


GEOID: NAVD88-2018

GRID: NORTHING: 550274.188

EASTING: 180531.862


LDP: NORTHING: 319173.846

EASTING: 180302.508

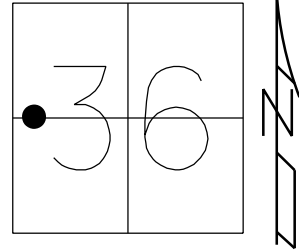

RECORD:
STA.115+72
FD. P.K./WASHER
ATOP R.R. SPIKE
SET P.K./WASHER
8/27/90
FD P.K./WASHER
2/4/05, SAH
FD P.K.NAIL
REF29
7/14/09, DCH
SET MAG/WASHER
NEWREF29
10-08-09, DCH
FD MAG/WASHER
REF29
6/14/16, JFO
9/18/17, JFO
FD MAGNAIL
REF29
12/20/23, DSA
FD TONE, DID NOT UNCOVER,PAINTED
8/9/24, JAM

DIST.
29-29A = 8.79'
29-29B = 106.47'
29A-29B = 97.69'

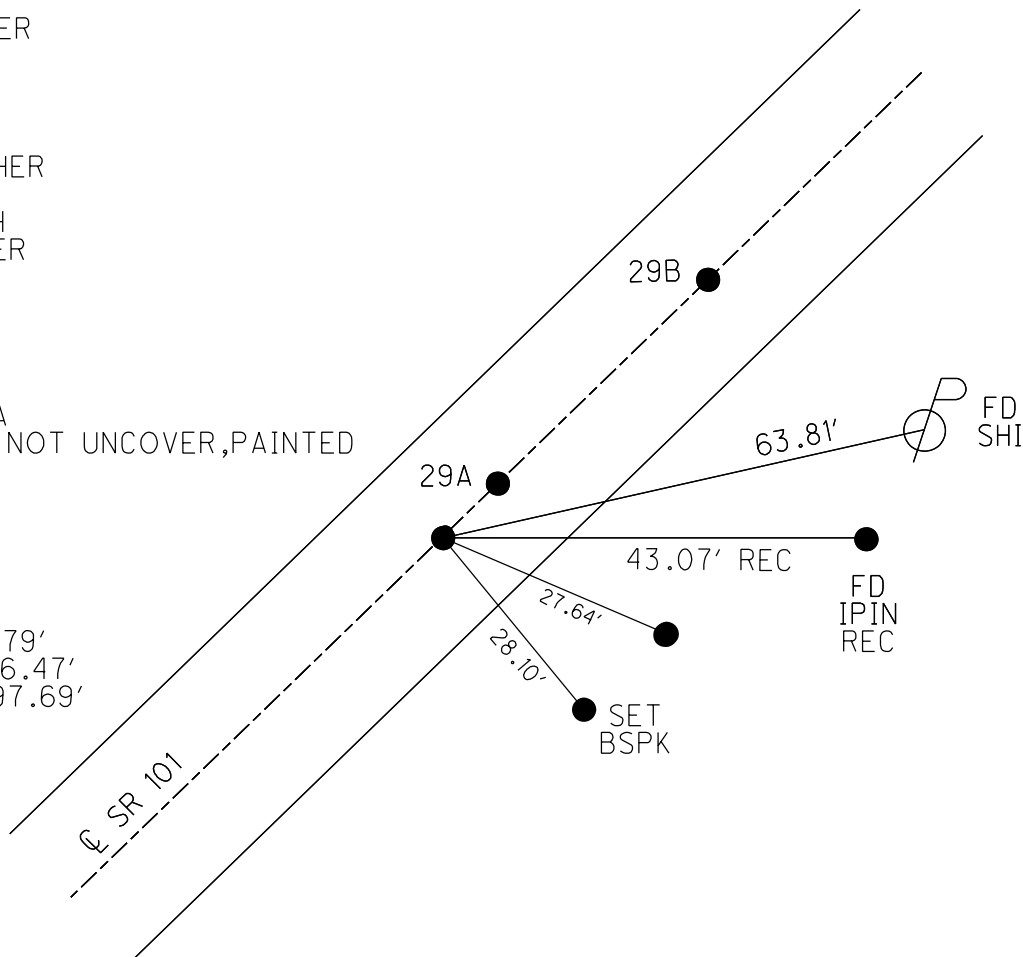


O.D.O.T. DISTRICT 2 SURVEY OFFICE (USE ONLY)

PERSONNEL NOTES <u>MILLER</u> H.C. <u>MILLER</u> R.C. <u>BARRIERE</u> <u>BLUBAUGH</u> DWG BY <u>BLUBAUGH</u>	REFERENCE NO. <u>29</u> DATE <u>8/9/24</u> WEATHER <u>SUNNY</u> TEMP. <u>66</u> PID <u>114849</u>	SHEET <u>3</u> OF <u>46</u> ROUTE <u>SR 101</u> COUNTY <u>SENECA</u> TOWNSHIP <u>PLEASENT</u> SECTION <u>36</u> T <u>3</u> N R <u>15</u> E
TYPE MONUMENT <u>P.K.NAIL</u> ON SURFACE - BELOW <u>ON</u> OFFSET $\oslash$ PAVEMENT <u>ON</u> LT : RT -- TO -- <u>EDGE PAVEMENT</u> STATION: <u>356+20</u>		
HORZ.DATUM: <u>NAD83 2011</u> GEOID: <u>NAVD88-2018</u> GRID: NORTHING: <u>550274.188</u> EASTING: <u>180531.862</u> LDP: NORTHING: <u>319173.846</u> EASTING: <u>180302.508</u>		

RECORD:
 STA.115+72
 FD. P.K./WASHER
 ATOP R.R. SPIKE
 SET P.K./WASHER
 8/27/90
 FD P.K./WASHER
 2/4/05, SAH
 FD P.K.NAIL
 REF29
 7/14/09, DCH
 SET MAG/WASHER
 NEWREF29
 10-08-09, DCH
 FD MAG/WASHER
 REF29
 6/14/16, JFO
 9/18/17, JFO
 FD MAGNAIL
 REF29
 12/20/23, DSA
 FD TONE, DID NOT UNCOVER, PAINTED
 8/9/24, JAM

DIST.
 29-29A = 8.79'
 29-29B = 106.47'
 29A-29B = 97.69'

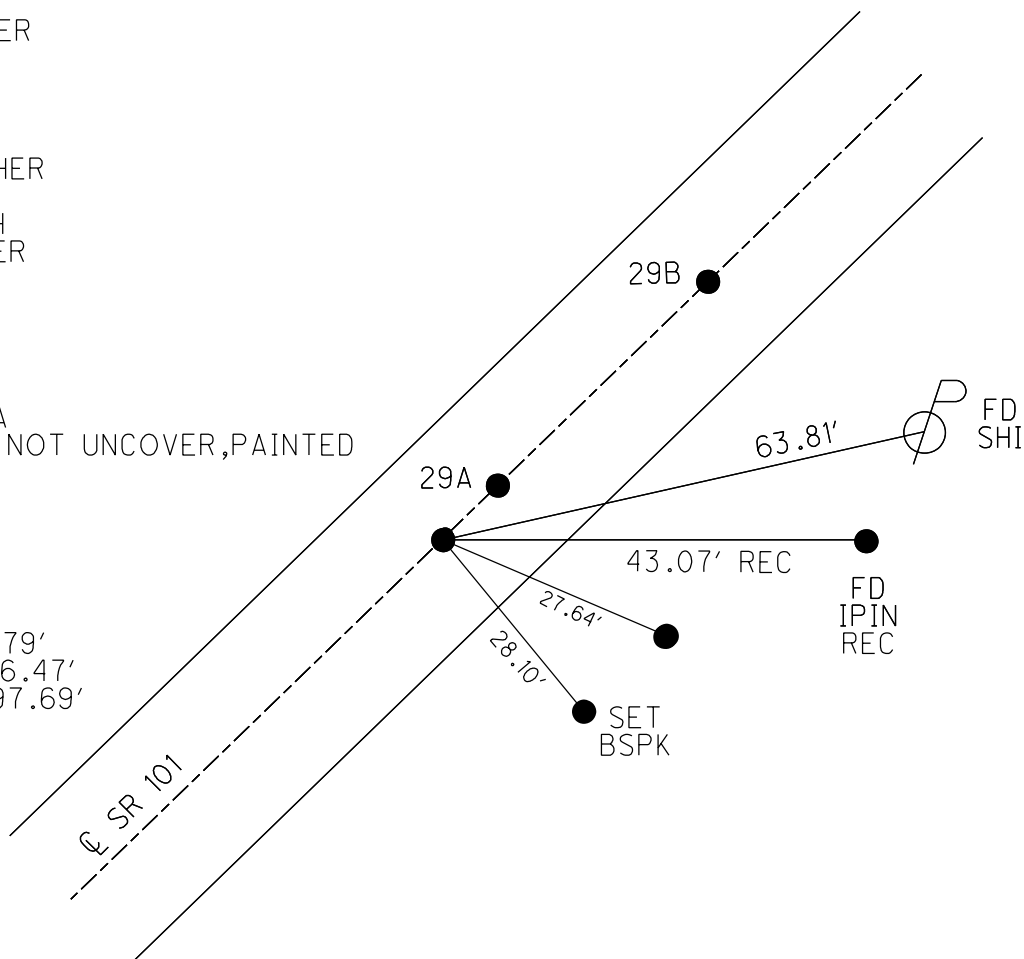

O.D.O.T. DISTRICT 2 SURVEY OFFICE (USE ONLY)

PERSONNEL

REFERENCE NO. 29

SHEET 3 OF 46

NOTES HOMAN

DATE 7-14-09

ROUTE SR 101

H.C. HOMAN

WEATHER SUNNY

COUNTY SENECA

R.C. ROUSOS

TEMP. 75°F

TOWNSHIP PLEASANT

SECTION 36

DWG BY MAHLER

PID 100787

T 3 N R 15 E

TYPE MONUMENT P.K.NAIL

ON SURFACE - ~~BELOW~~ ON

OFFSET Q PAVEMENT ON LT : RT

- TO - EDGE PAVEMENT


STATION: 356+20

HORIZ.DATUM: NAD83 2011

GEOID: NAVD88-2012A


GRID: NORTHING: 550274.188

EASTING: 180531.862

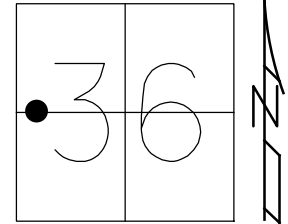

RECORD:
STA.115+72
FD. P.K./WASHER
ATOP R.R. SPIKE
SET P.K./WASHER
8/27/90
FD P.K./WASHER
2/4/05, SAH
FD P.K.NAIL
REF29
7/14/09, DCH
SET MAG/WASHER
NEWREF29
10-08-09, DCH
FD MAG/WASHER
REF29
6/14/16, JFO
9/18/17, JFO

DIST.
29-29A = 8.70'
29-29B = 106.40'
29A-29B = 97.70'

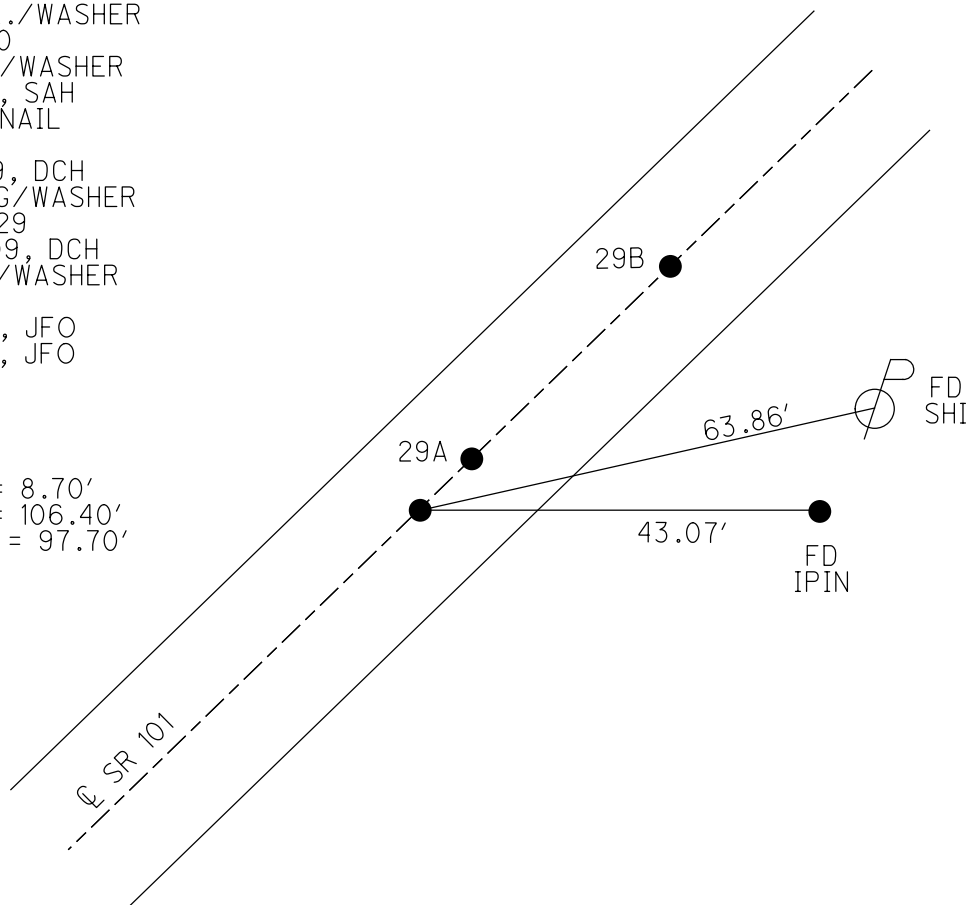


O.D.O.T. DISTRICT 2 SURVEY OFFICE (USE ONLY)

PERSONNEL	REFERENCE NO. <u>29</u>	SHEET <u>3</u> OF <u>46</u>
NOTES	DATE <u>7/14/09</u>	ROUTE <u>SR 101</u>
H.C. <u>HOMAN</u>	WEATHER <u>SUNNY</u>	COUNTY <u>SENECA</u>
R.C. <u>ROUSOS</u>	TEMP. <u>75°</u>	TOWNSHIP <u>PLEASANT</u>
		SECTION <u>36</u>
		T <u>3</u> N R <u>15</u> E


TYPE MONUMENT P.K.NAIL
 ON SURFACE - ~~BELOW~~ ON
 LEFT - ℄ PAV'T - RIGHT ON
- TO - EDGE PAVEMENT
 S.L.M. 356+20

GRID: NORTHING: 550274.188 EASTING: 1805831.862

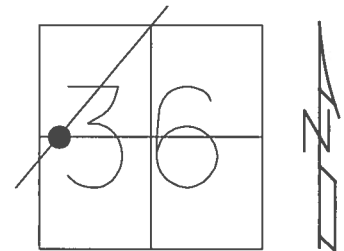

RECORD:
 STA. 115+72
 FD. P.K./WASHER
 A TOP R.R. SPIKE
 SET P.K. & WASHER
 8/27/90
 FD P.K/WASHER
 2/4/05, SAH
 SET MAG/WASHER
 10-08-09, DH
 FD MAG/WASHER
 REF29
 6/14/16, JFO
 UNCOVERED
 9/18/17, JFO

DIST.
 29-29A = 8.70'
 29-29B = 106.40'
 29A-29B = 97.70'

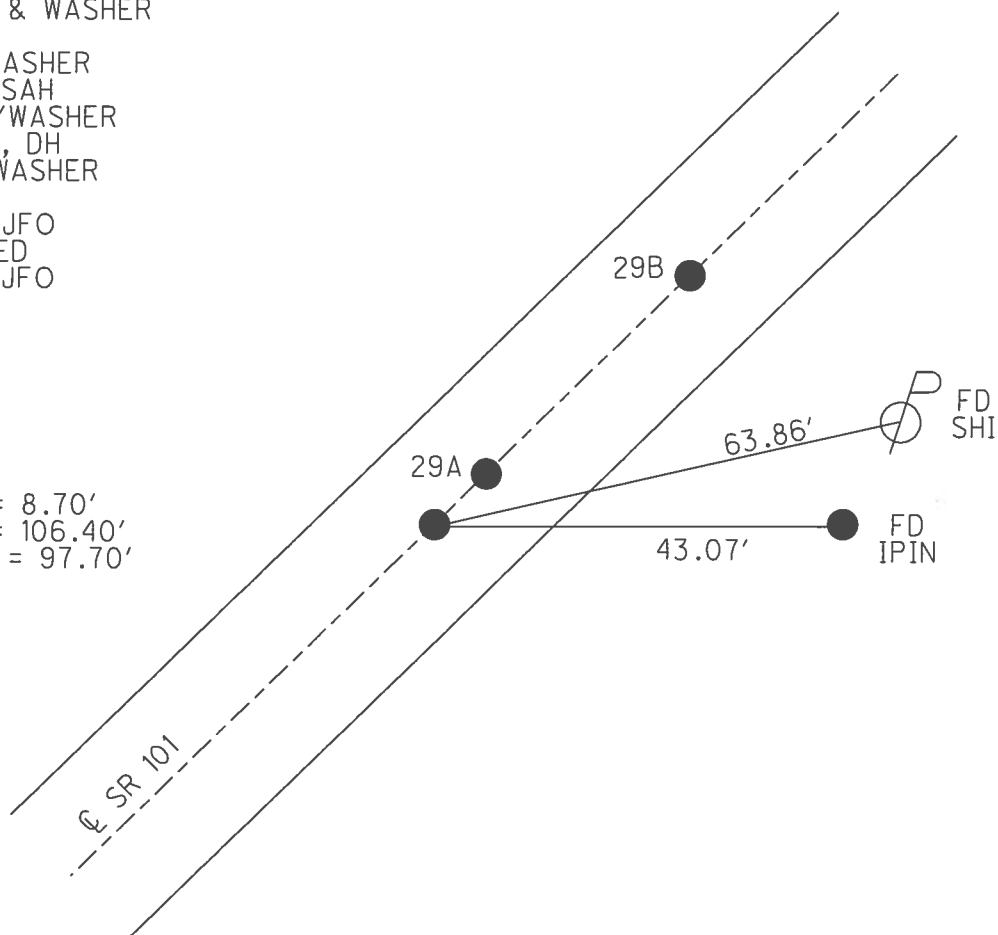

O.D.O.T. DISTRICT 2 SURVEY OFFICE (USE ONLY)

PERSONNEL

REFERENCE NO. 29

SHEET 3 OF 46

NOTES HOMAN

DATE 7/14/09

ROUTE SR 101

H.C. HOMAN

WEATHER SUNNY

COUNTY SENECA

R.C. ROUSOS

TEMP. 75°

TOWNSHIP PLEASANT

SECTION 36

T 3 N R 15 E

TYPE MONUMENT P.K.NAIL

ON SURFACE - ~~BELOW~~ ON


LEFT - Q PAV'T - RIGHT ON

- TO - EDGE PAVEMENT

S.L.M. 356+20

GRID: NORTHING: 550267.595

EASTING: 1805826.203

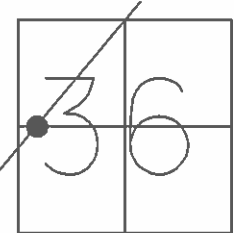

RECORD:

STA. 115+72

FD. P.K./WASHER

A TOP R.R. SPIKE

SET P.K. & WASHER

8/27/90

FD P.K./WASHER

2/4/05, SAH

SET MAG/WASHER


10-08-09, DH

DIST.

29-29A = 8.70'

29-29B = 106.40'

29A-29B = 97.70'

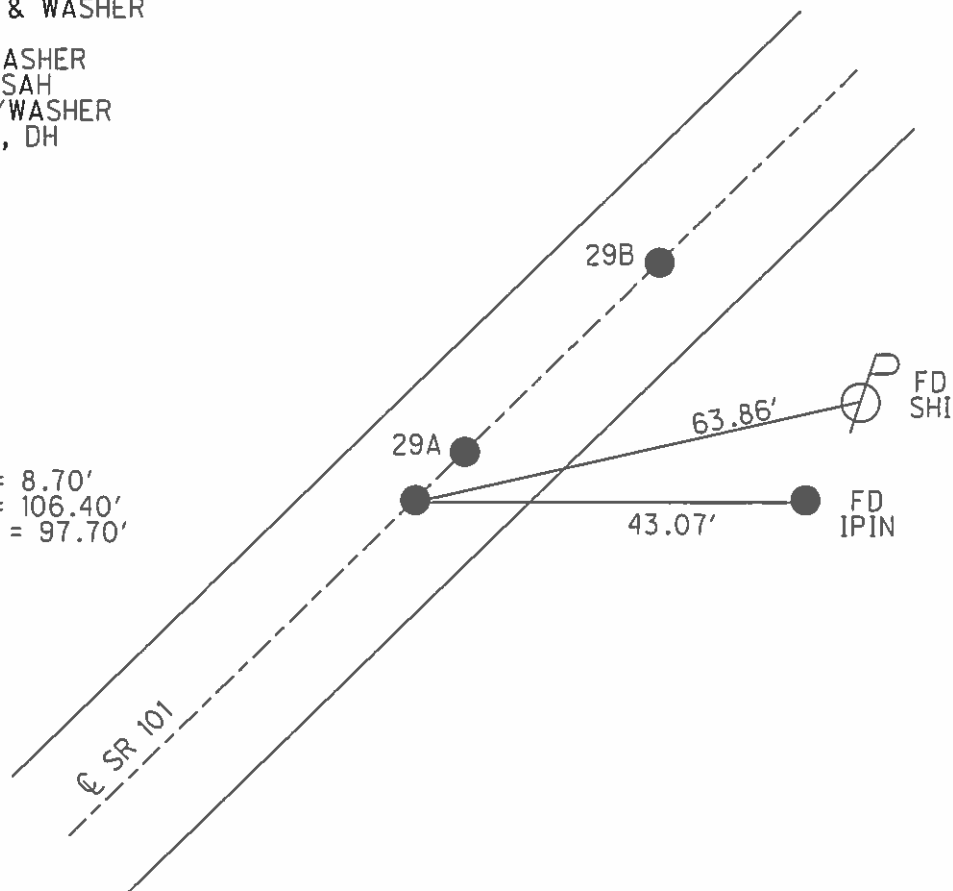

O.D.O.T. DISTRICT 2 SURVEY OFFICE

PERSONNEL

REFERENCE NO. 29

SHEET 3 OF 41

NOTES Ripple

H.C. BARbour

R.C. _____

DATE 8/27/90

WEATHER SUNNY

TEMP. 73°

ROUTE S.R.# 101




COUNTY Seneca

TOWNSHIP Pleasant

SECTION 36

T3 NR 15 E

TYPE MONUMENT Set P.K. & Washer
ON SURFACE - BELOW P.K. NAIL AT TOP R/R SPIKE
LEFT - 0 PAV'T. - RIGHT 0
_____ TO _____ EDGE PAVEMENT
S.L.M. _____

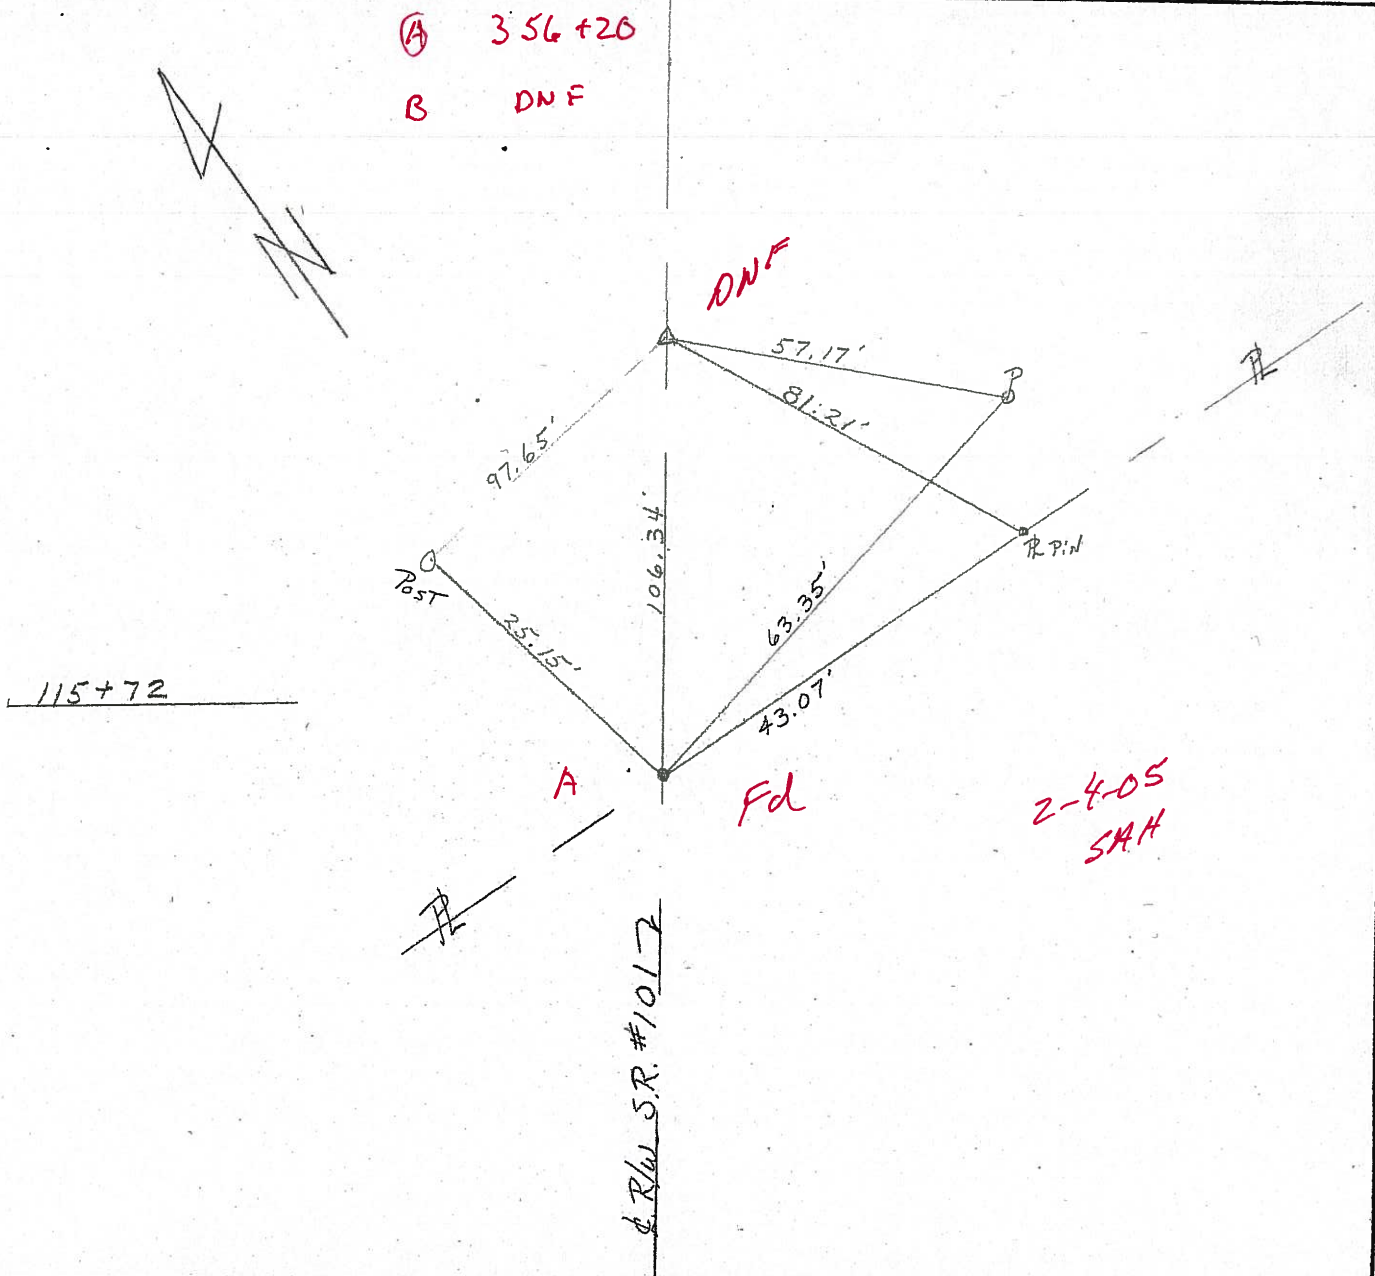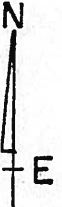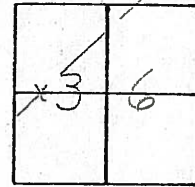

O.D.O.T. DISTRICT 2 SURVEY OFFICE

PERSONNEL

REFERENCE NO. 29

SHEET 3 OF 41

NOTES Ripple

H.C. Barbour

R.C. _____

DATE 8/27/90

WEATHER SUNNY

TEMP. 73°

ROUTE S.R.# 101

COUNTY Seneca

TOWNSHIP Pleasant

SECTION 36



T.3 N R.15 E


TYPE MONUMENT Set P.K. & Washer
ON SURFACE - BELOW P.K. Nail A Top R/R Spike

LEFT - CL PAV'T. - RIGHT CL

TO EDGE PAVEMENT

S.L.M. _____

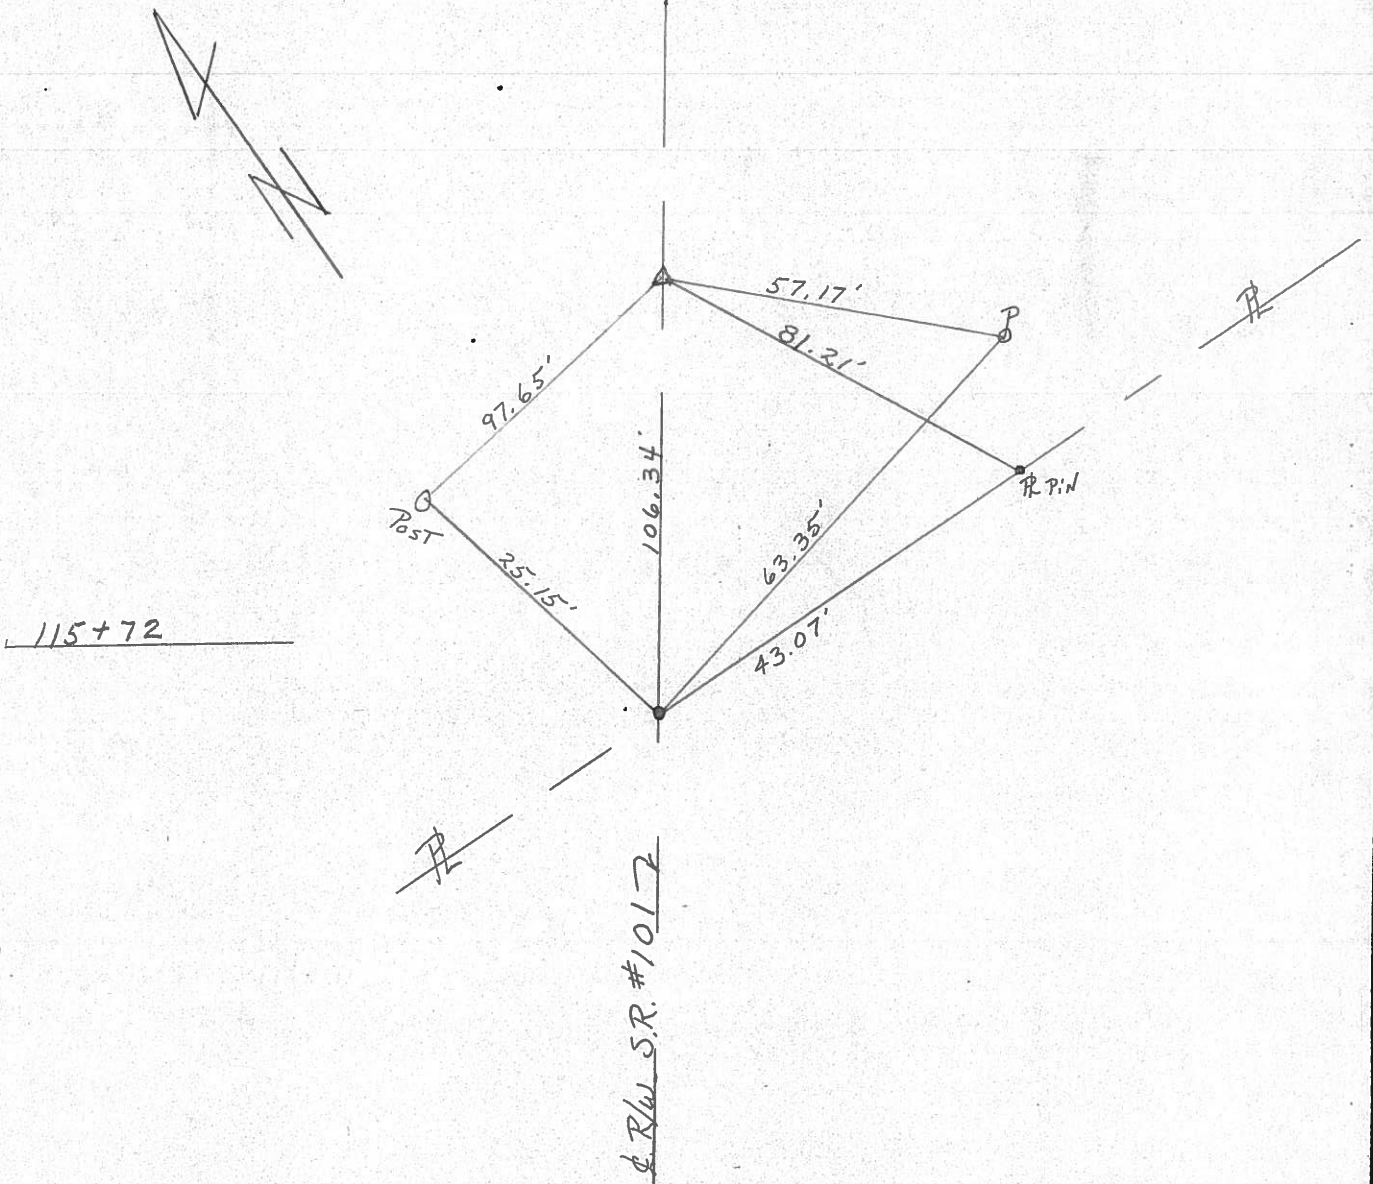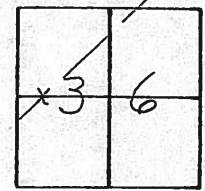

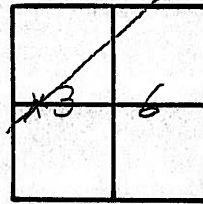
County Seneca S.R. 101Township PleasantSection 36T 3 N, R 15 EPersonnel SchneiderMosserBarbourDate 6-26-79Weather FairTemp. 65°

P.I.

115 + 72

R.R. 5pk. on E R/W

Reset P.K. Nail

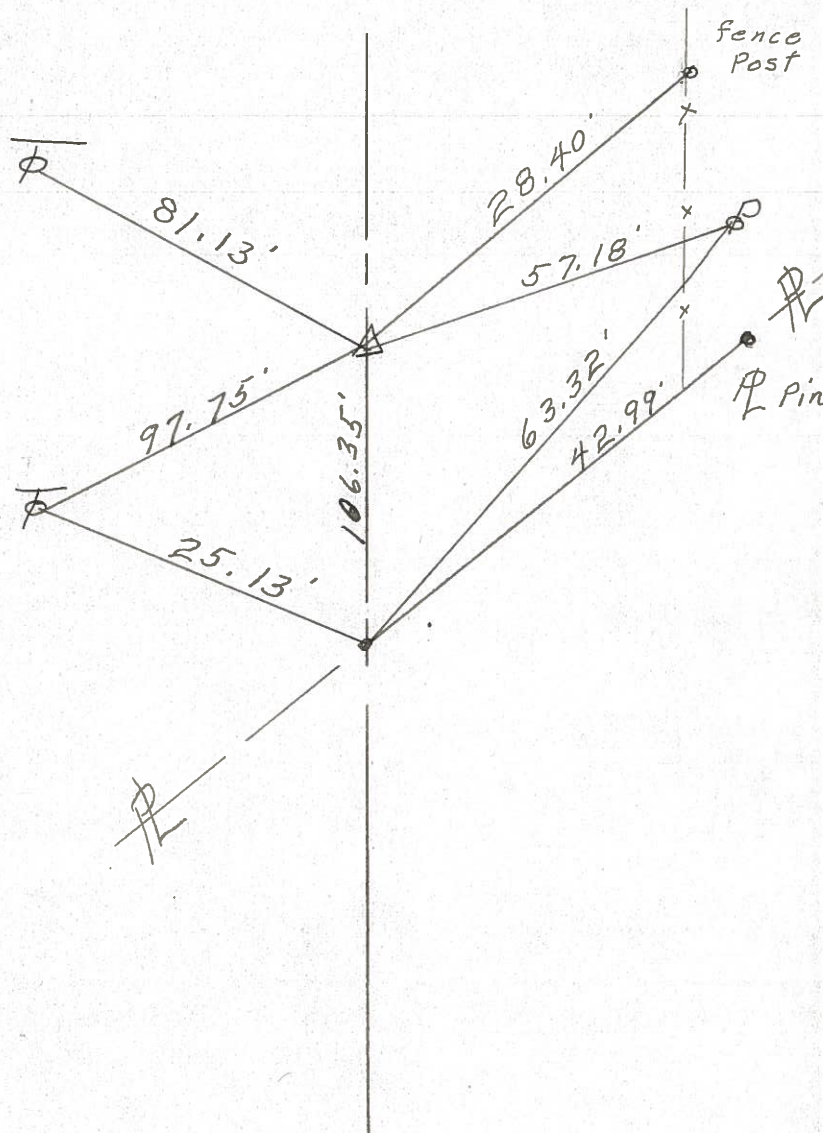 $\Delta = 0^\circ - 18' \text{ LT.}$ 

PERSONNEL TITLE PERSONNEL TITLE

COUNTY Seneca

WEATHER

S. R. # 101

SEC

TEMP. 50°

DESCRIPTION

LEFT

CENTER LINE

RIGHT

JOB NO.

29

Ties Good 2/24/69
Sta. 115+72
R.R. spk. on & R/W
1 1/2" below surface

381

8477

28

Ties Good 2/24/69
Sta. 191+00
R.R. spk. on & R/W
1 1/2" below surface

380

8476

27

Ties Good - 2/24/69
Sta. 77+00
R.R. spk. on & R/W
1" & 2" below surface

8475 379

P.T. - R.R. spk. Found 2-24-69

Found

Ties Good 2/24/69

Sta. 49435.6

R.R. spk. on & R/W
on surface
2 R.R. & P.T.

26


8474 378

P.C. - R.R. spk. Found 2-24-69

Found

25

Found R.R. spk.
on surface

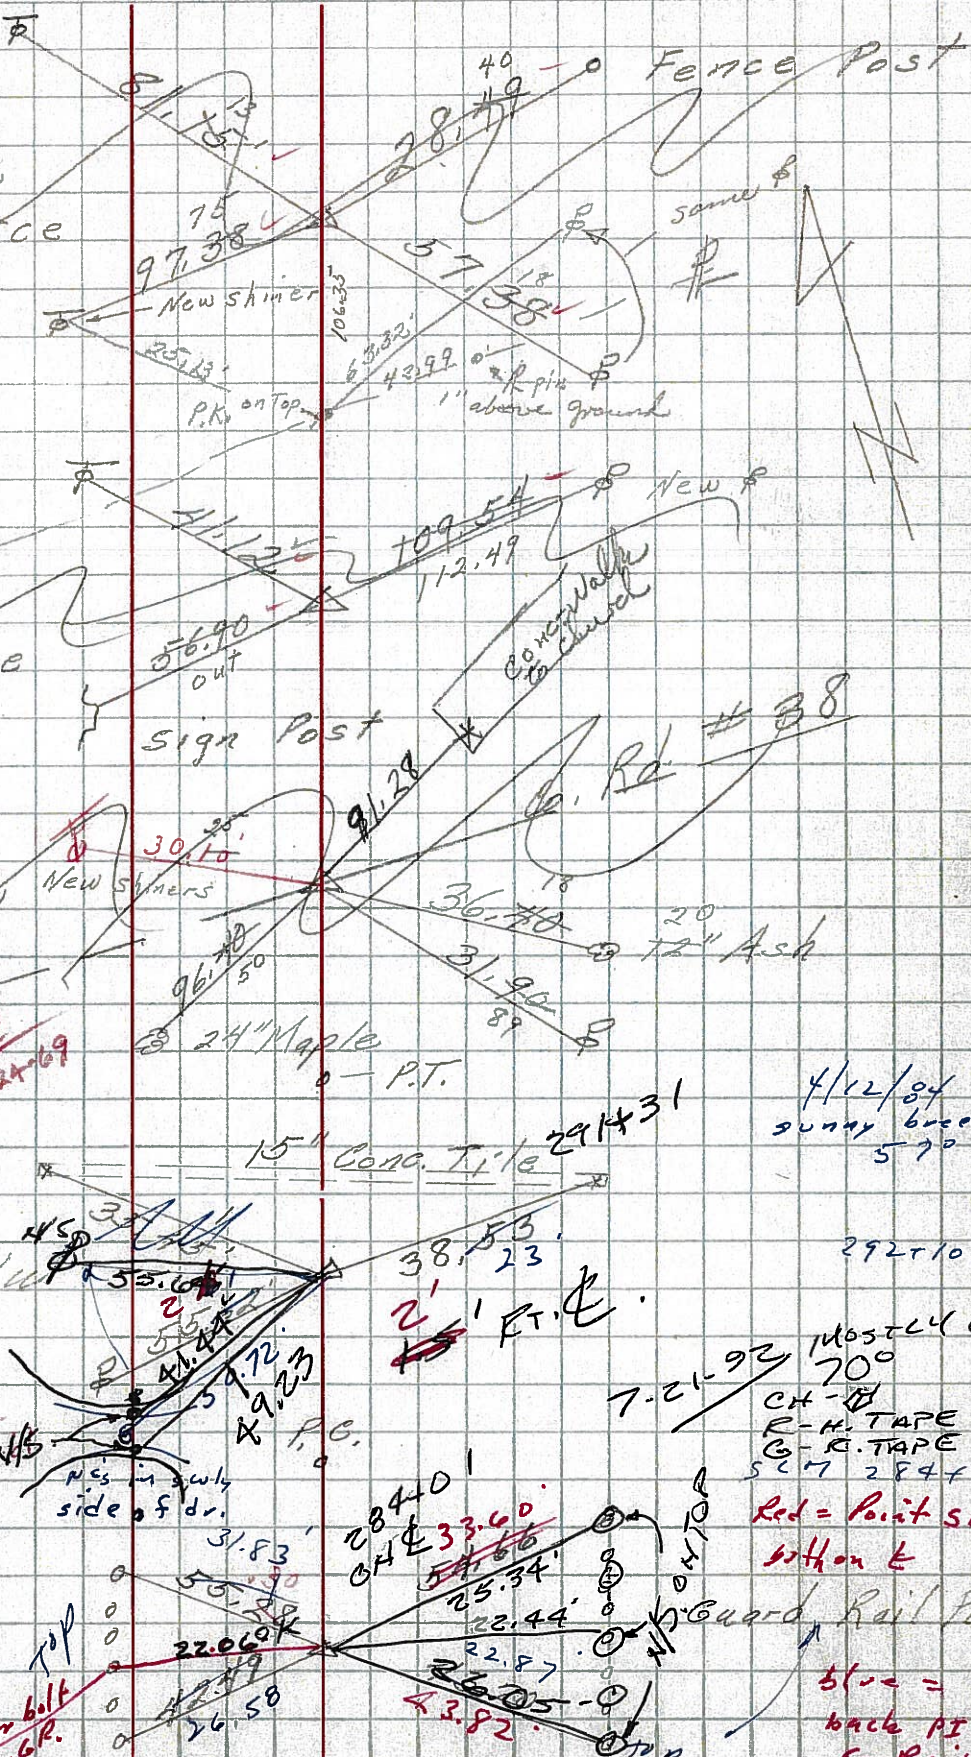

4/12/84
sunny breezy
57°

292+10T

Mostly Cloudy
70°

CH -
R - K. TAPE
G - R. TAPE
S - 17 284 x 84

Red = Point shown
on H &

Guard Rail Post

Blue = 190-
back P.I. on
C.P.

PERSONNEL	TITLE	PERSONNEL	TITLE	COUNTY	DATE
E Krabill				Seneca	
Kowaleski				S. R. 101	WEATHER
Geyman				SEC.	TEMP.
Bruggman					JOB NO.

DESCRIPTION	LEFT	CENTER LINE	RIGHT
-------------	------	-------------	-------

