

O.D.O.T. DISTRICT 2 SURVEY OFFICE (USE ONLY)

PERSONNEL

REFERENCE NO. 30

SHEET 6 OF 46

NOTES RIPPLE

DATE 8-27-90

ROUTE SR 101

H.C. BARBOUR

WEATHER SUNNY

COUNTY SENECA

R.C. -----

TEMP. 73°F

TOWNSHIP PLEASENT

DWG BY MAHLER

PID 100787

SECTION 36

T 3 N R 15 E

TYPE MONUMENT R.R.SPIKE

ON SURFACE - BELOW -----

OFFSET Q PAVEMENT ----- LT : RT

-- TO -- EDGE PAVEMENT

STATION: 376+73±

HORZ.DATUM: -----


GEOID: -----

GRID: NORTHING: -----


EASTING: -----

LDP: NORTHING: -----

EASTING: -----

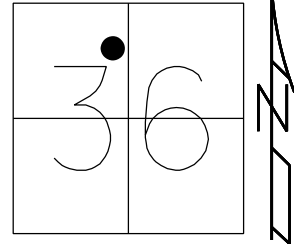

RECORD:
 STA. 135+00
 R.R.SPIKE
 ON R/W
 D.N.F.
 8/27/90, BARBOUR
 2/4/05, SAH
 7/14/09, DCH
 6/14/16, JFO
 8/9/24, JAM

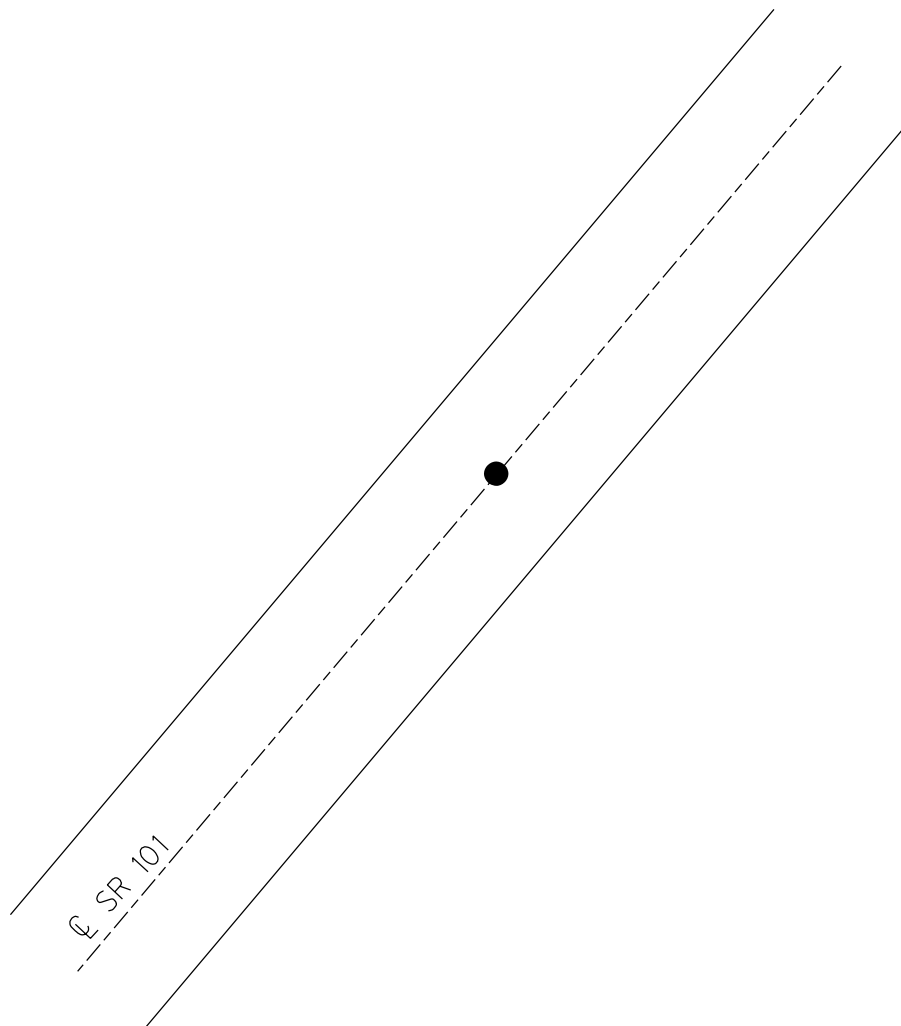

O.D.O.T. DISTRICT 2 SURVEY OFFICE (USE ONLY)

PERSONNEL

REFERENCE NO. 30

SHEET 6 OF 46

NOTES RIPPLE

DATE 8-27-90

ROUTE SR 101

H.C. BARBOUR

WEATHER SUNNY

COUNTY SENECA

R.C. _____

TEMP. 73°F

TOWNSHIP PLEASENT

DWG BY MAHLER

PID 100787

SECTION 36

T 3 N R 15 E

TYPE MONUMENT R.R.SPIKE

ON SURFACE - BELOW -

OFFSET Q PAVEMENT - LT : RT

- TO - EDGE PAVEMENT


STATION: 376+73±

HORZ.DATUM: -


GEOID: -

GRID: NORTHING: -

EASTING: -

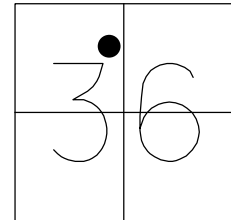


RECORD:
STA. 135+00
R.R.SPIKE
ON R/W
D.N.F.
8/27/90, BARBOUR
2/4/05, SAH
7/14/09, DCH
6/14/16, JFO

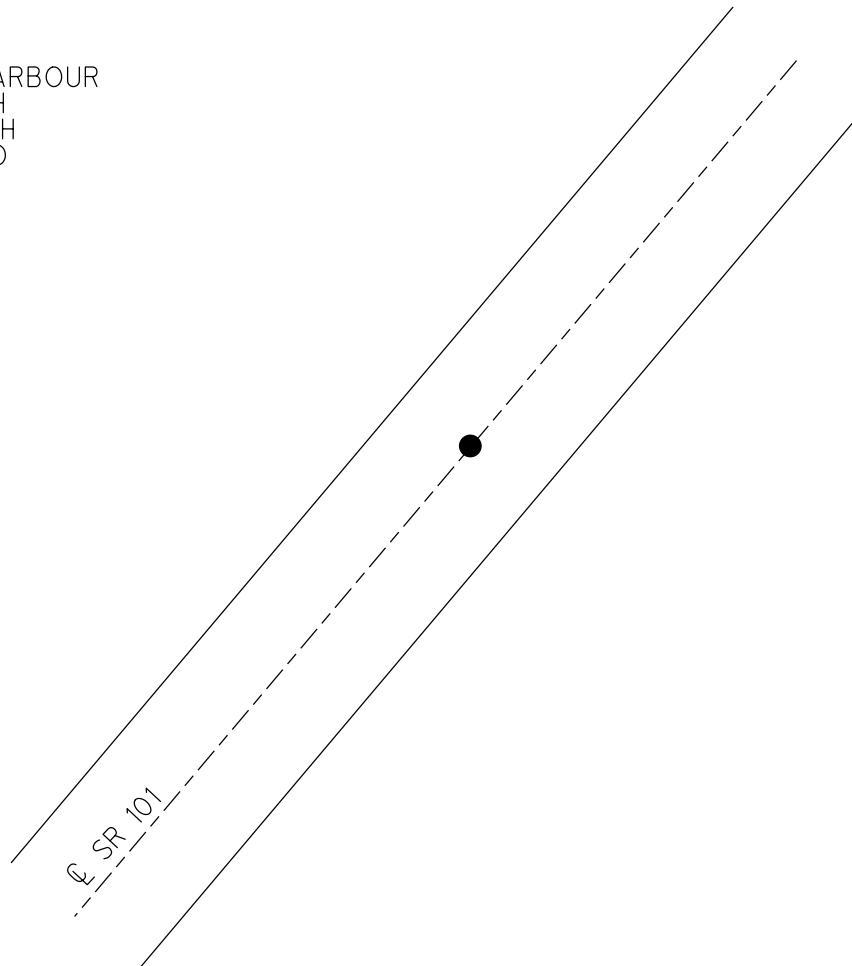


O.D.O.T. DISTRICT 2 SURVEY OFFICE (USE ONLY)

PERSONNEL _____ REFERENCE NO. 30 SHEET 6 OF 46
 NOTES RIPPLE _____ DATE 8/27/90 ROUTE SR 101
 H.C. BARBOUR WEATHER SUNNY COUNTY SENECA
 R.C. _____ TEMP. 73° TOWNSHIP PLEASANT
 _____ SECTION 36
 _____ T 3 N R 15 E

TYPE MONUMENT R.R.SPIKE
 ON SURFACE - BELOW _____
 LEFT - ℄ PAV'T - RIGHT _____
 _____ TO _____ EDGE PAVEMENT
 S.L.M. 376+73 ±
 GRID: NORTHING: _____ EASTING: _____

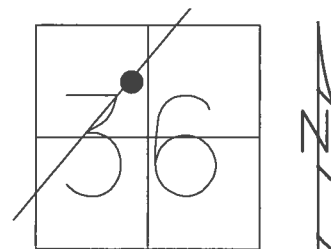


RECORD:
 STA. 135+00
 R.R.SPIKE
 ON R/W
 D.N.F.
 8/27/90
 2/4/05, SAH
 7/14/09, DH
 6/14/16, JFO

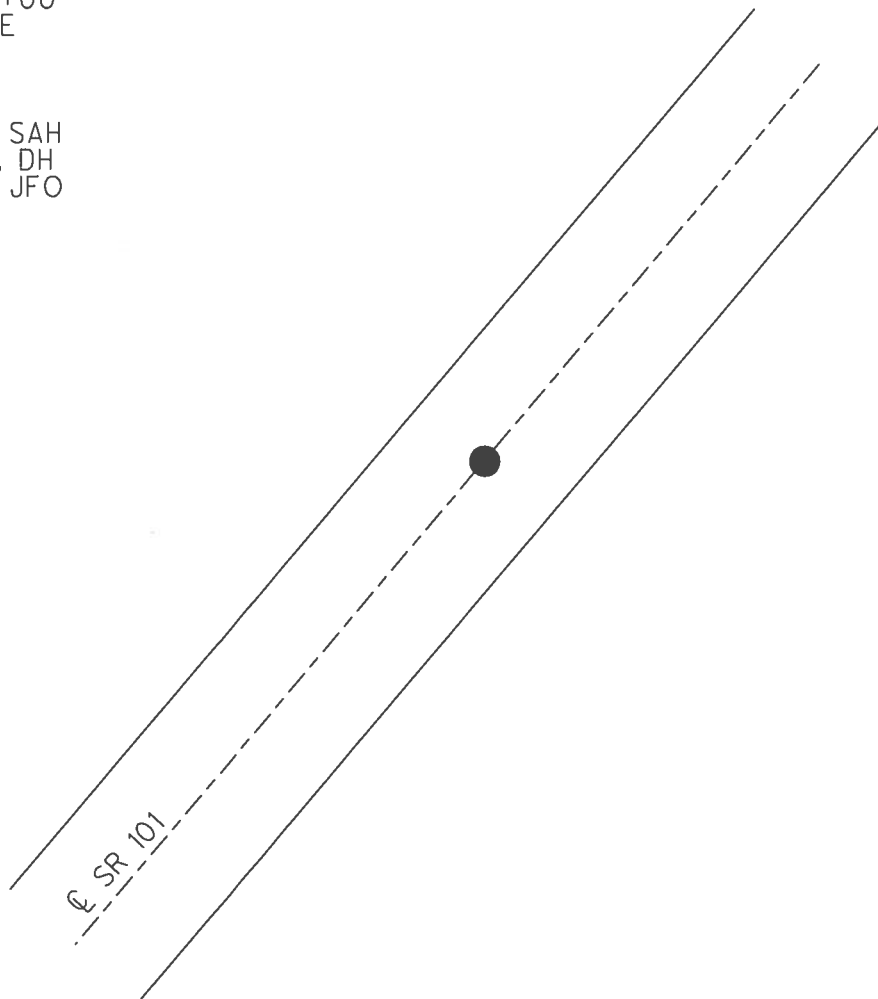


O.D.O.T. DISTRICT 2 SURVEY OFFICE (USE ONLY)

PERSONNEL _____ REFERENCE NO. 30 SHEET 6 OF 46
 NOTES RIPPLE DATE 8/27/90 ROUTE SR 101
 H.C. BARBOUR WEATHER SUNNY COUNTY SENECA
 R.C. _____ TEMP. 73° TOWNSHIP PLEASANT
 _____ SECTION 36
 T 3 N R 15 E

TYPE MONUMENT R.R.SPIKE
 ON SURFACE - BELOW _____
 LEFT - ℄ PAV'T - RIGHT _____
 _____ TO _____ EDGE PAVEMENT
 S.L.M. 376+73 ±
 GRID: NORTHING: _____ EASTING: _____

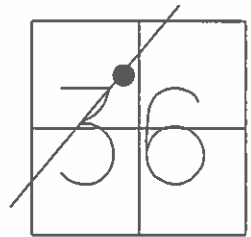

RECORD:
 STA. 135+00
 R.R.SPIKE
 ON R/W
 D.N.F.
 8/27/90
 2/4/05, SAH
 7/14/09, DH

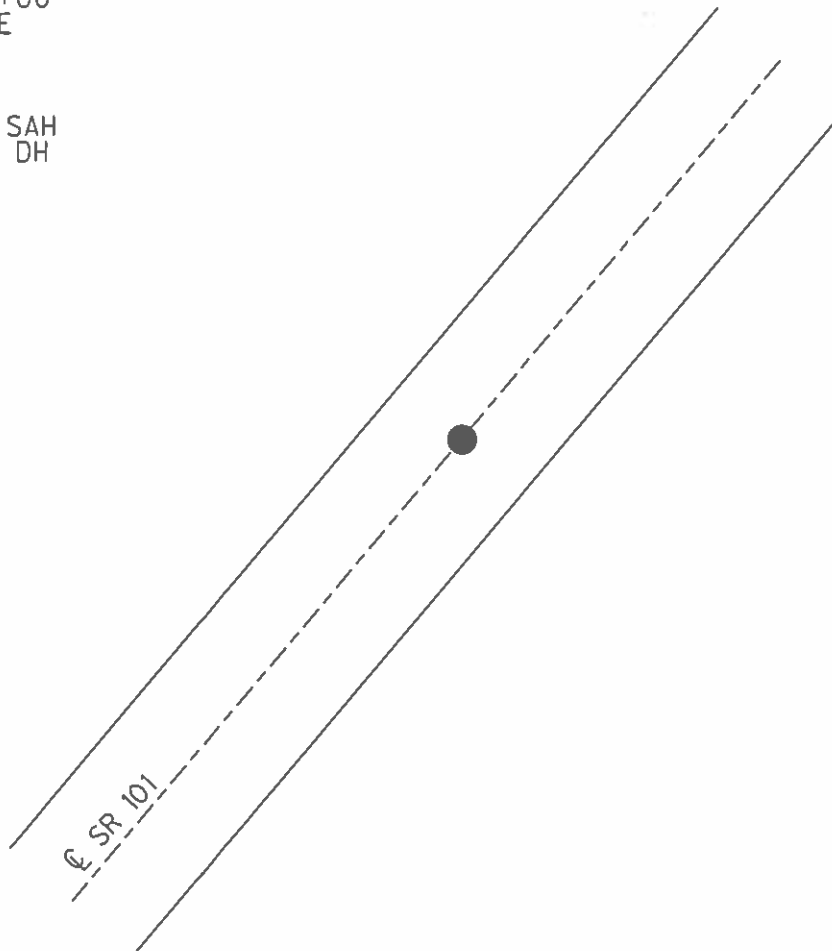

O.D.O.T. DISTRICT 2 SURVEY OFFICE

PERSONNEL

REFERENCE NO. 30

SHEET 4 OF 41

NOTES RIPPLE

H.C. BARBOUR

R.C. _____

DATE 8/27/90

WEATHER SUNNY

TEMP. 73°

ROUTE SR#101

COUNTY SENECA

TOWNSHIP PLEASANT

SECTION 36

T3 N R 15 E


TYPE MONUMENT Did Not Find

ON SURFACE - BELOW RR. SPIKE ON R/W

LEFT- & PAV'T. - RIGHT _____

TO _____ EDGE PAVEMENT


S.L.M. _____

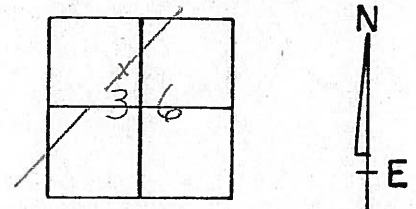

376 + 73 ±



Did Not Find
135+00

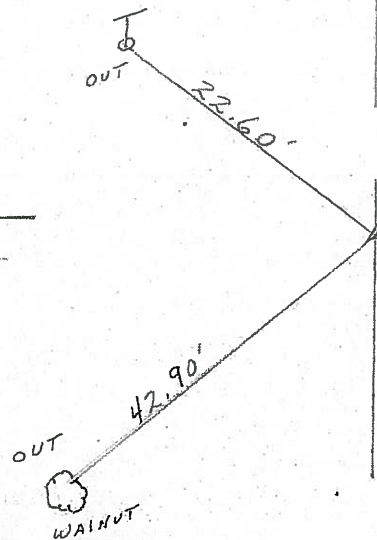

DNF
02-04-05
SAH

O.D.O.T. DISTRICT 2 SURVEY OFFICE

PERSONNEL

REFERENCE NO. 30

SHEET 4 OF 41

NOTES RIPPLE

H.C. Barbour

R.C. _____

DATE 8/27/90

WEATHER SUNNY

TEMP. 73°

ROUTE SR#101

COUNTY Seneca

TOWNSHIP Pleasant

SECTION 36

T3 N R 15 E


TYPE MONUMENT Did Not Find

ON SURFACE - BELOW RR. Spike on R/W

LEFT- & PAV'T. - RIGHT _____

TO _____ EDGE PAVEMENT

S.L.M. _____

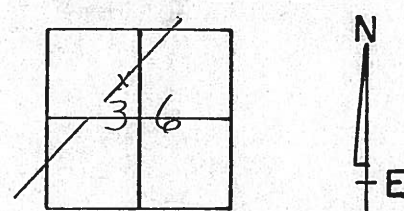

OUT 22.60'

Did Not Find
135+00

OUT 42.90'
WALNUT

Q.D.O.T. DISTRICT 2 SURVEY OFFICE

Sht. 4 of

County Seneca S.R. 101

Date 6-26-79

Township Pleasant

Weather Fair

Section 36

Temp. 70°



T 3 N, R 15 E

Personnel Schneider

Mosser

Barbour

(30)

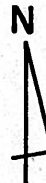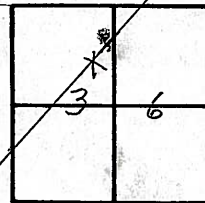

~~#35A~~

P.O.T.

135+00

R.R. spk. on E R/W

did not find

