

O.D.O.T. DISTRICT 2 SURVEY OFFICE (USE ONLY)

PERSONNEL

REFERENCE NO. 36

SHEET 13 OF 46

NOTES MILLER
H.C. MILLER
R.C. BARRIERE

DATE 8/7/24
WEATHER WINDY/CLOUDY
TEMP. 70°F

ROUTE SR 101
COUNTY SENECA
TOWNSHIP PLEASENT
SECTION 25
T 3 N R 15 E

BLUBAUGH, ASTON, PRESTON-COLVIN

DWG BY BLUBAUGH PID 114849

TYPE MONUMENT MAG/WASHER

ON SURFACE - ~~BELOW~~ 0.5"

OFFSET $\mathcal{C}$ PAVEMENT ON LT : RT

-- TO -- EDGE PAVEMENT

STATION: 438+11

HORZ.DATUM: NAD83 (2011)


GEOID: NAVD88-2018

GRID: NORTHING: 556296.638


EASTING: 1811336.255

LDP: NORTHING: 325244.535

EASTING: 185767.942

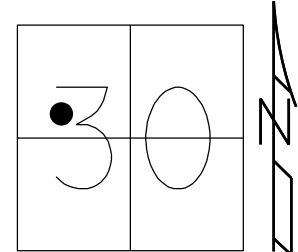

RECORD: P.O.T.
STA. 440+00
FD P.K.NAIL
SET P.K./WASHER
8/27/90, BARBOUR
FD P.K./WASHER
REF36
7/14/09, DCH
SET MAG/WASHER
NEWREF36
11/4/09, DCH
FD MAG/WASHER
REF36
6/14/16
9/18/17, JFO
FD MAG/WASHER
REF36
12/14/23, JAM
FD TONE. DID NOT
UNCOVER, PAINTED
8/7/24, JAM

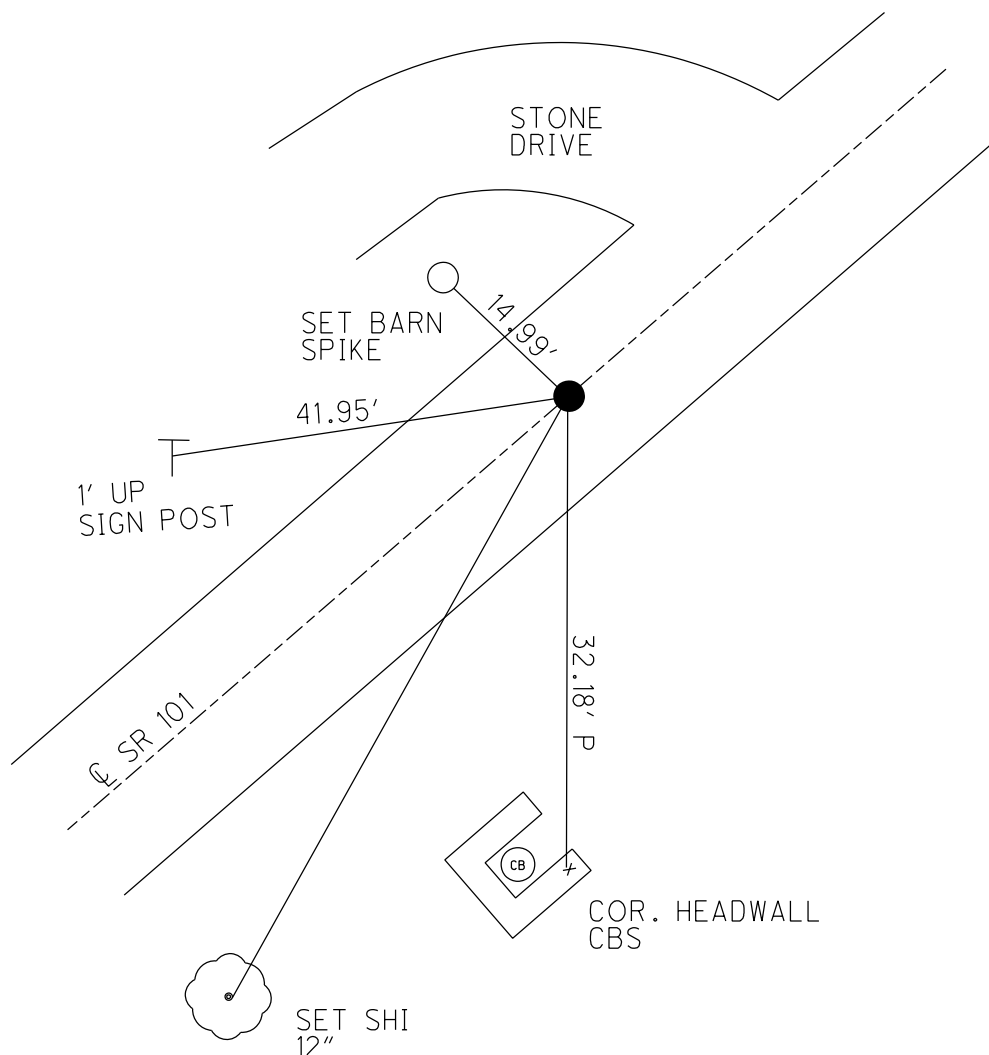

O.D.O.T. DISTRICT 2 SURVEY OFFICE (USE ONLY)

PERSONNEL

REFERENCE NO. 36

SHEET 13 OF 46

NOTES HOMAN

DATE 7-14-09

ROUTE SR 101

H.C. HOMAN

WEATHER SUNNY

COUNTY SENECA

R.C. ROUSOS

TEMP. 85°F

TOWNSHIP ADAMS

DWG BY MAHLER PID 100787

SECTION 30

T 3 N R 16 E

TYPE MONUMENT P.K./WASHER

ON SURFACE - ~~BELOW~~ ON

OFFSET Q PAVEMENT ON LT : RT

- TO - EDGE PAVEMENT


STATION: 438+11

HORIZ.DATUM: NAD83 (2011)


GEOID: NAVD88-2012A

GRID: NORTHING: 556296.638

EASTING: 1811336.255

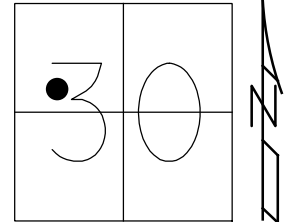

RECORD: P.O.T.
STA. 440+00
FD P.K.NAIL
SET P.K./WASHER
8/27/90, BARBOUR
FD P.K./WASHER
REF36
7/14/09, DCH
SET MAG/WASHER
NEWREF36
11/4/09, DCH
FD MAG/WASHER
REF36
6/14/16
9/18/17, JFO

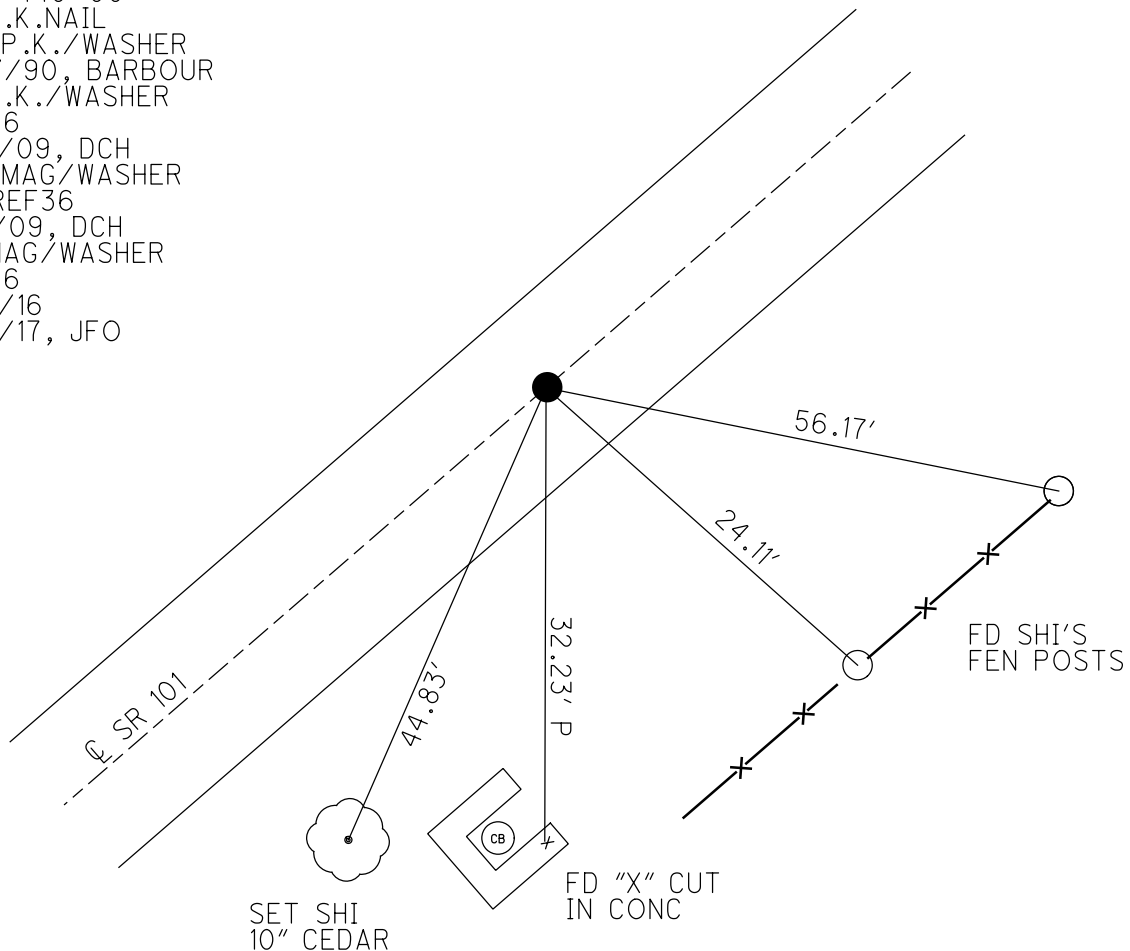

O.D.O.T. DISTRICT 2 SURVEY OFFICE (USE ONLY)

PERSONNEL

REFERENCE NO. 36

SHEET 13 OF 46

NOTES HOMAN

DATE 7/14/09

ROUTE SR 101

H.C. HOMAN

WEATHER SUNNY

COUNTY SENECA

R.C. ROUSOS

TEMP. 85°

TOWNSHIP ADAMS

SECTION 30

T_3_N R_16_E

TYPE MONUMENT P.K./WASHER


ON SURFACE - ~~BELOW~~ ON

LEFT - C PAV'T - RIGHT ON


____-____TO____-____EDGE PAVEMENT

S.L.M. 438+11

GRID: NORTHING: 556296.638 EASTING: 1811336.255

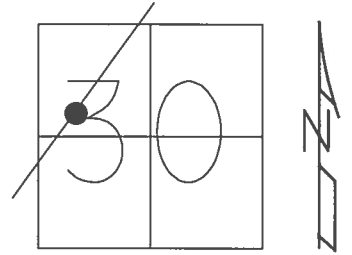


RECORD: P.O.T.
STA. 440+00
FD P.K.NAIL
SET P.K./WASHER
8/27/90
SET MAG/WASHER
11/4/09, DCH
FD MAG/WASHER
REF36
6/14/16, JFO
UNCOVERED
9/18/17, JFO

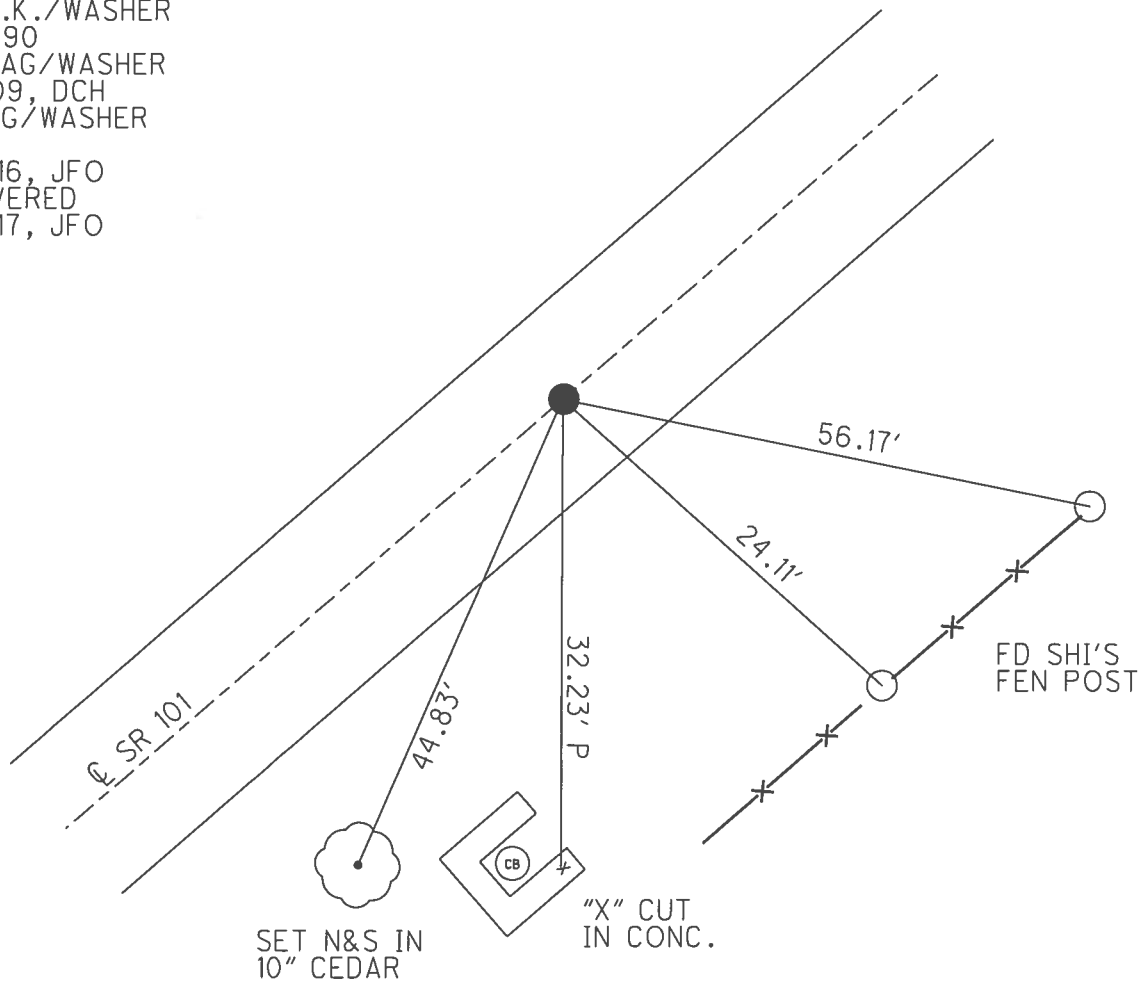

O.D.O.T. DISTRICT 2 SURVEY OFFICE (USE ONLY)


PERSONNEL _____ REFERENCE NO. 36 SHEET 13 OF 46
 NOTES _____ DATE 7/14/09 ROUTE SR 101
 H.C. HOMAN WEATHER SUNNY COUNTY SENECA
 R.C. ROUSOS TEMP. 85° TOWNSHIP ADAMS
 _____ SECTION 30
 _____ T 3 N R 16 E

TYPE MONUMENT P.K./WASHER
 ON SURFACE - ~~BELOW~~ ON
 LEFT - C PAV'T - RIGHT ON
 - TO - EDGE PAVEMENT
 S.L.M. 438+11

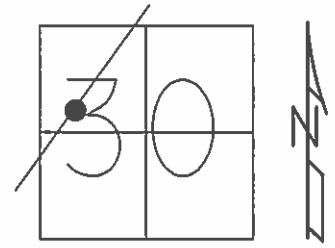

GRID: NORTHING: 556296.682 EASTING: 1808942.320

RECORD: P.O.T.
 STA. 440+00
 FD P.K.NAIL
 SET P.K./WASHER
 8/27/90
 SET MAG/WASHER
 11/4/09, DCH

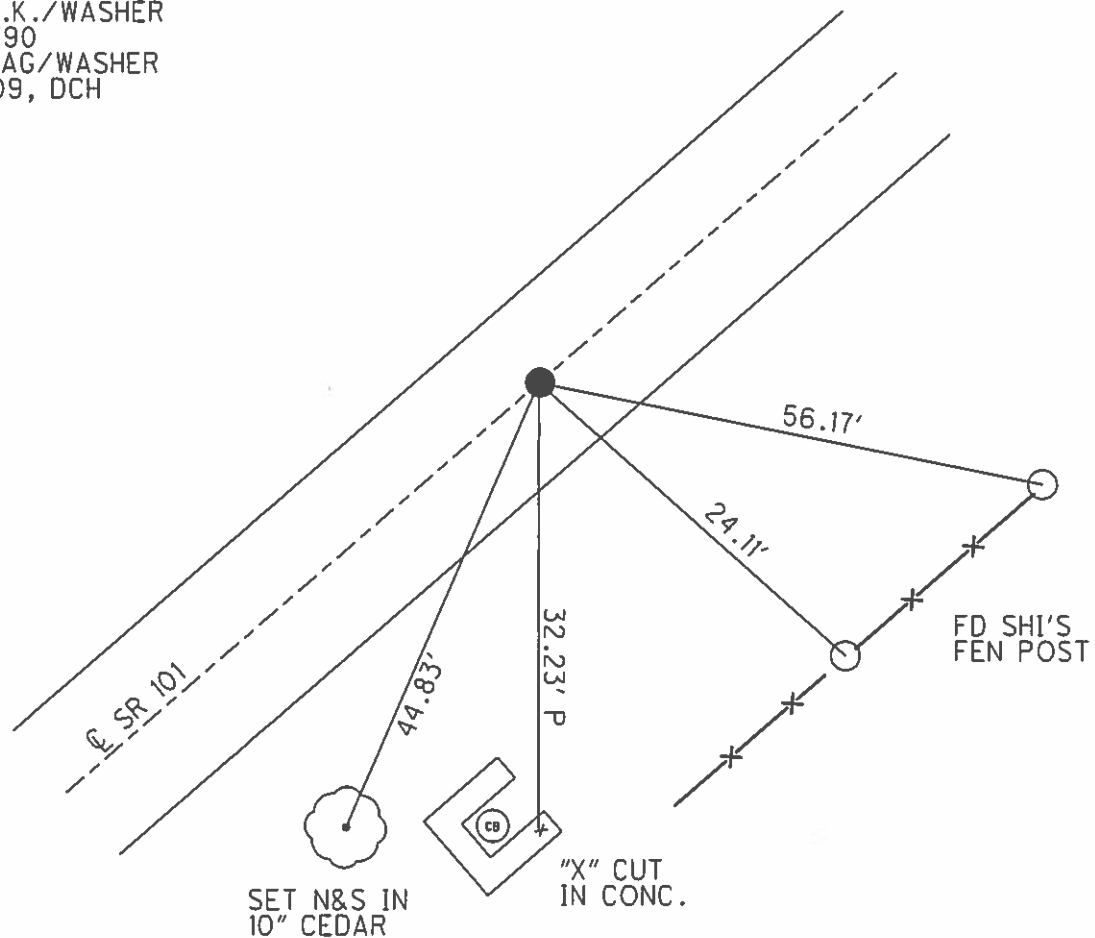

O.D.O.T. DISTRICT 2 SURVEY OFFICE

PERSONNEL

REFERENCE NO. 36

SHEET 10 OF 41

NOTES RIPPLE

H.C. BARBOUR

DATE 8/27/90

ROUTE SR. #101

R.C. GEYMAN

WEATHER SUNNY

COUNTY SENECA

TEMP. 92°

TOWNSHIP ADAMS

SECTION 30

T3 N R 16 E


TYPE MONUMENT SET P.K. & WASHER

ON SURFACE - BELOW P.K. NAIL

LEFT- & PAV'T. - RIGHT & PAV'T.



TO EDGE PAVEMENT

S.L.M.

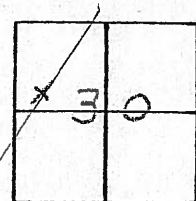

P.O.T.
440+00

438+11

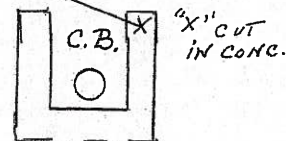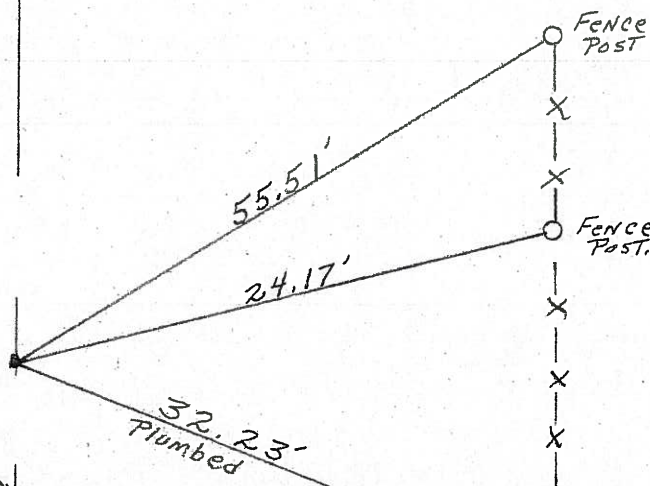

& R/W SR. #101

**Need
Traffic
Control**

O.D.O.T. DISTRICT 2 SURVEY OFFICE

PERSONNEL

REFERENCE NO. 36

SHEET 10 OF 41

NOTES Ripple

H.C. BARBOUR

R.C. Geyman

DATE 8/27/90

WEATHER SUNNY

TEMP. 92°

ROUTE SR. #101

COUNTY SENECA

TOWNSHIP ADAMS

SECTION 30

T3 NR 16 E


TYPE MONUMENT Set P.K. & washer

ON SURFACE - BELOW P.K. Nail

LEFT - & PAV'T. - RIGHT & Pav'T.


TO EDGE PAVEMENT

S.L.M.

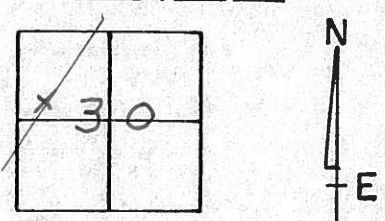

P.O.T.
440+00

& R/W SR. #101

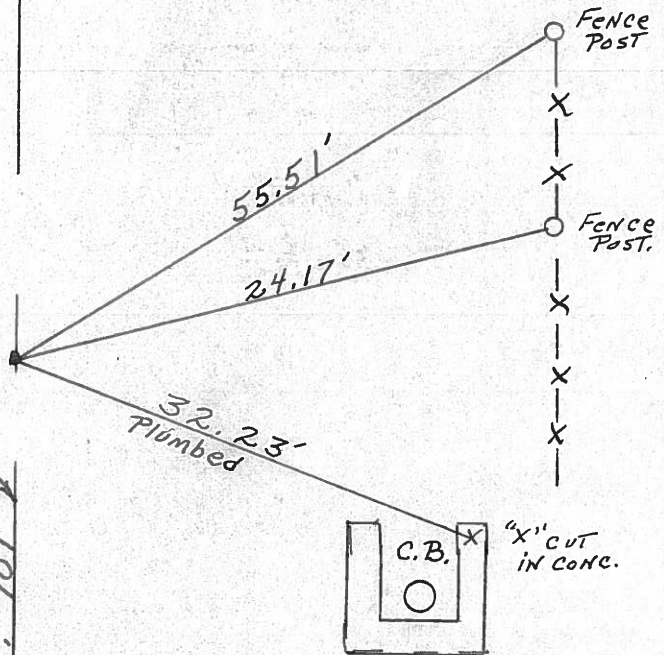

County Seneca S.R. 101

Township Adams

Section 30

T 3 N, R 16 E

Personnel Schneider

Mosser


Barbour

Date 6-26-79

Weather Fair

Temp. 75°

(36)

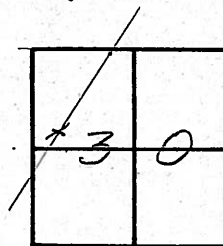

~~#41~~

¢ S.R. # 101

P.O.T.

440+00

P.K. Nail

1 1/2" down




16.37'

24.28'

32.24'

fence post

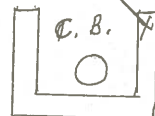

PERSONNEL	TITLE	PERSONNEL	TITLE	COUNTY	DATE
Schneider		Vinson		Seneca	9-29-71
Mosser				S. R. 101	WEATHER Hot
Barbour				SEC. Br. # 8.10	TEMP. 85°
Geyman					JOB NO. 02827(0)

DESCRIPTION

Ties for Control Points

LEFT

CENTER LINE

RIGHT

(38)

P.I.

469+42.37

small spk. on & R/w

~~43~~

42" Ash

34.73'

35.27'

36" Maple

54.94'

30" Oak

78.41'

30.94'

(37)

P.I.

447+43.01

 $\Delta = 1031'30" RT$

1/2" Iron pin on & R/w

2" down

~~42~~

P

41.10'

60.69'

16.22'

78.32'

Sub. cor. conc. Hdwl.

2 story Res.

(36)

P.O.T.

440+00

set P.K. Nail

~~41~~

1'x7' conc. Hdwl.

16.37'

24.28'

wood fence post

32.24'

