

O.D.O.T. DISTRICT 2 SURVEY OFFICE (USE ONLY)

PERSONNEL

REFERENCE NO. 37 A

SHEET 15 OF 46

NOTES MILLER

DATE 8/7/24

ROUTE SR 101

H.C. MILLER

WEATHER CLOUDY/WINDY

COUNTY SENECA

R.C. BARRIERE

TEMP. 75°F

TOWNSHIP ADAMS

BLUBAUGH, ASTON, PRESTON-COLVIN

SECTION 19

DWG BY BLUBAUGH

PID 114849

T 3 N R 16 E

TYPE MONUMENT MAG/WASHER

ON SURFACE - ~~BELOW~~ 0.5"

OFFSET $\mathcal{C}$ PAVEMENT 0.8' LT : ~~RT~~

-- TO -- EDGE PAVEMENT

STATION: 467+46

HORZ.DATUM: NAD82 (2011)


GEOID: NAVD88-2018

GRID: NORTHING: 558520.901


EASTING: 1813244.488


LDP: NORTHING: 327483.187

EASTING: 187659.745

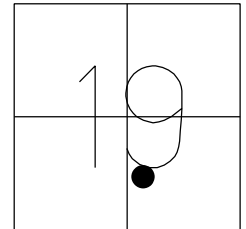

RECORD:
FD P.K.NAIL
REFA38
7/21/09, DCH
SET MAG/WASHER
NEWREFA38
10/8/09, DCH
FD MAG/WASHER
REFA37
6/14/16
9/18/17, JFO
FD MAG/WASHER
REF37A
12/14/23, JAM
FD TONE. DID NOT
UNCOVER. PAINTED
8/7/24, JAM

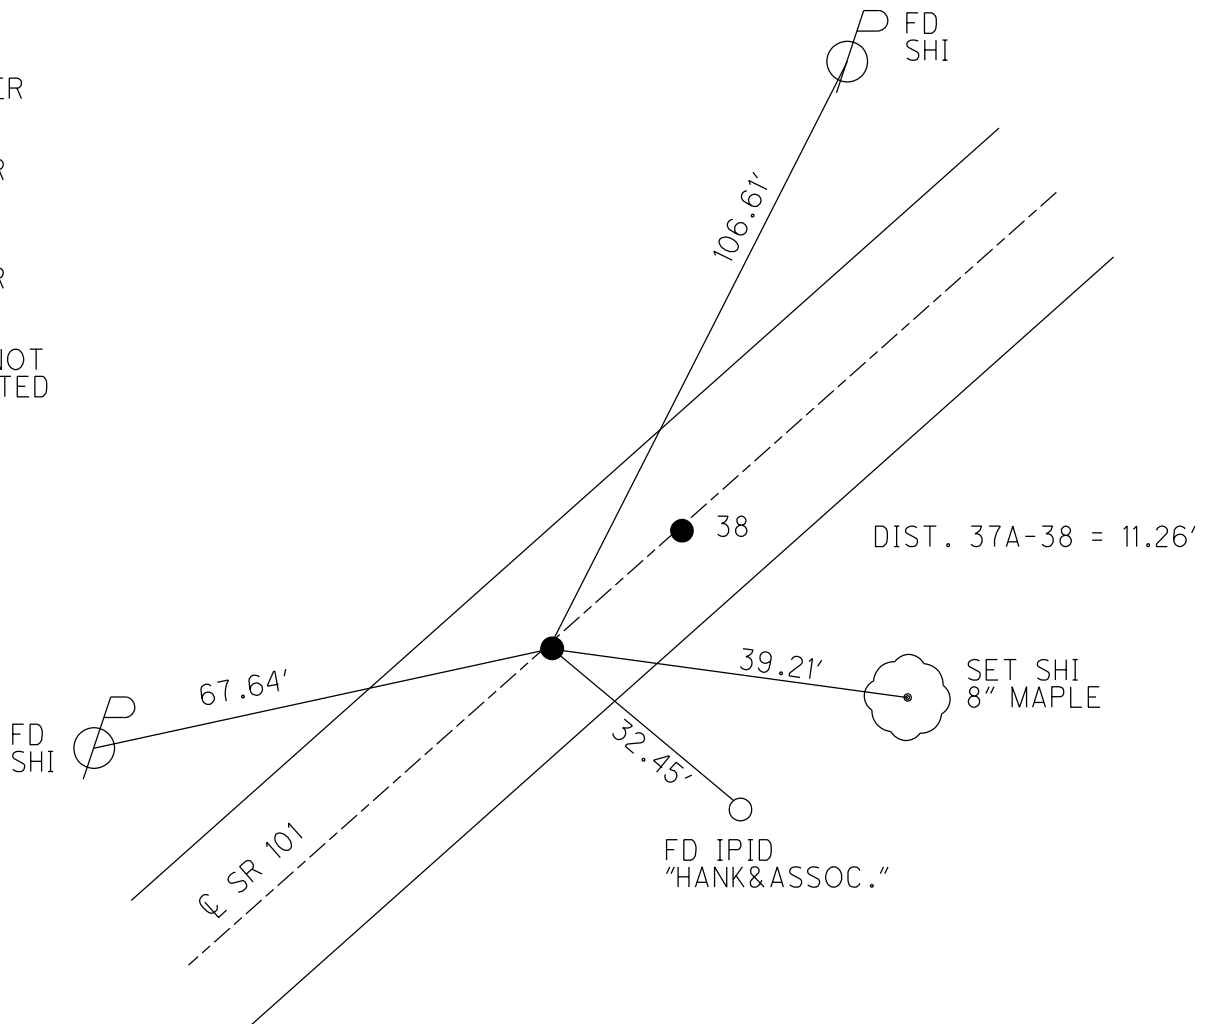

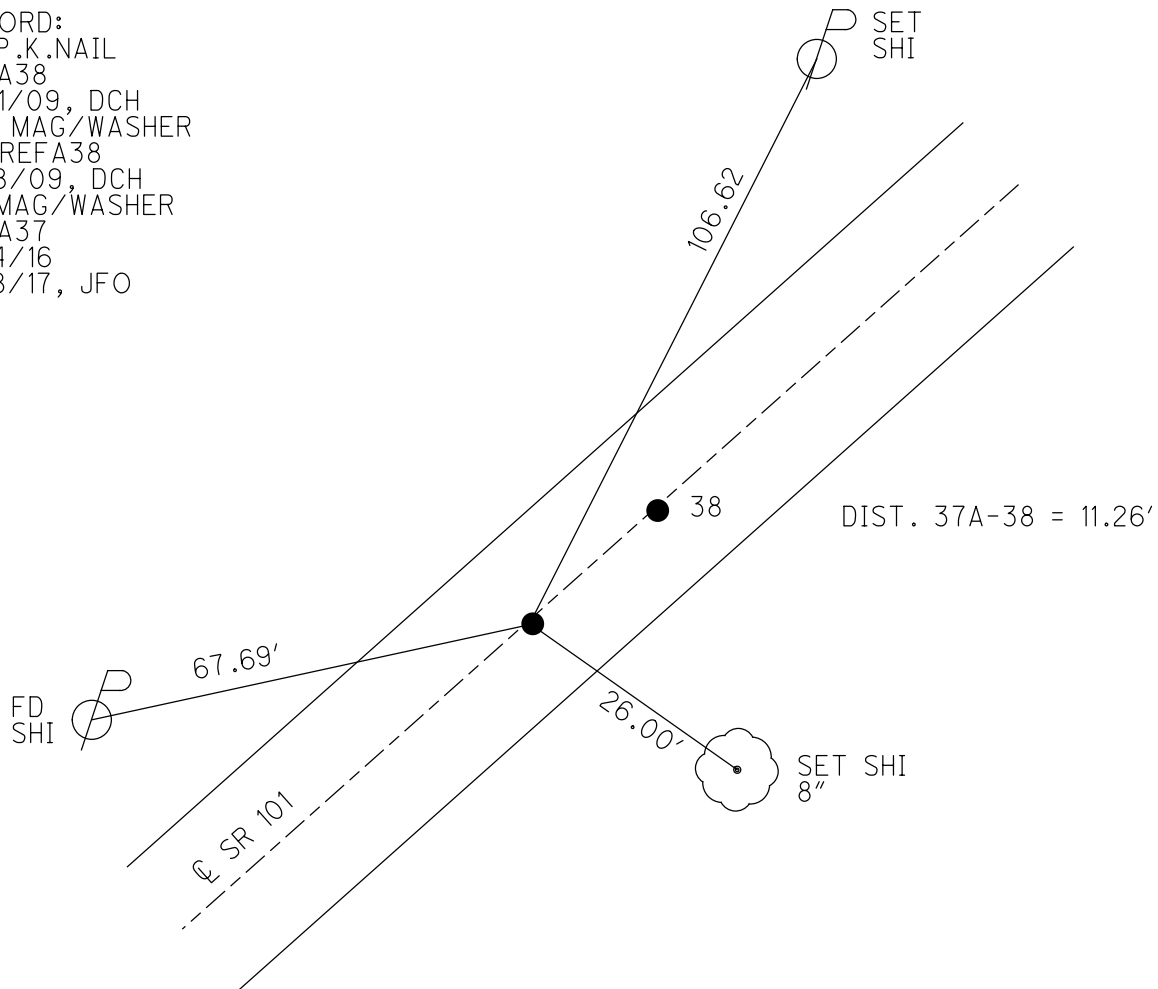


O.D.O.T. DISTRICT 2 SURVEY OFFICE (USE ONLY)


PERSONNEL	REFERENCE NO. <u>37 A</u>	SHEET <u>15</u> OF <u>46</u>
NOTES <u>HOMAN</u>	DATE <u>7/21/09</u>	ROUTE <u>SR 101</u>
H.C. <u>HOMAN</u>	WEATHER <u>SUNNY</u>	COUNTY <u>SENECA</u>
R.C. <u>ROUSOS</u>	TEMP. <u>75°</u>	TOWNSHIP <u>ADAMS</u>
		SECTION <u>19</u>
		T <u>3</u> N R <u>16</u> E

TYPE MONUMENT P.K.NAIL
 ON SURFACE - ~~BELOW~~ ON
 LEFT - C PAV'T - ~~RIGHT~~ 0.8'
- TO - EDGE PAVEMENT
 S.L.M. 467+46

GRID: NORTHING: 558520.901 EASTING: 1813244.488

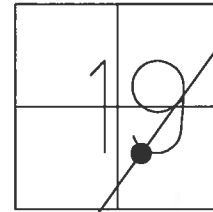

RECORD:
 SET MAG/WASHER
 10/8/09, DCH
 FD MAG/WASHER
 REFA37
 6/14/16, JFO
 UNCOVERED
 9/18/17, JFO

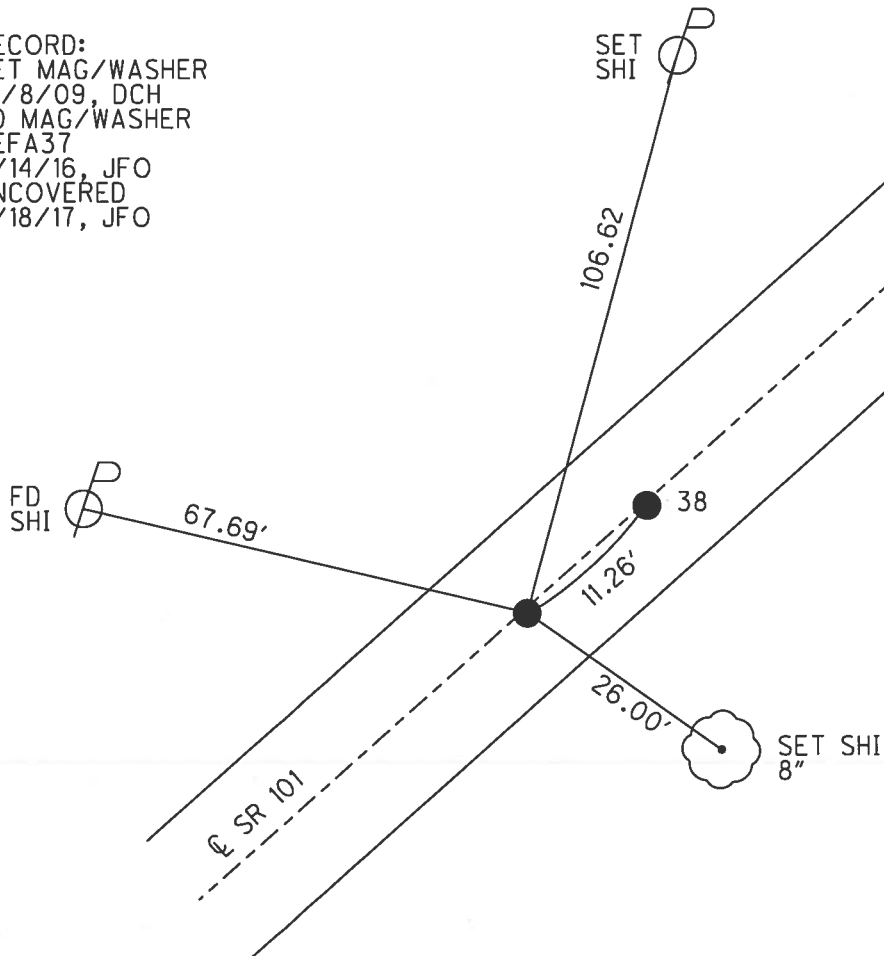

O.D.O.T. DISTRICT 2 SURVEY OFFICE (USE ONLY)

PERSONNEL _____ REFERENCE NO. 37 A SHEET 15 OF 46
 NOTES HOMAN DATE 7/21/09 ROUTE SR 101
 H.C. HOMAN WEATHER SUNNY COUNTY SENECA
 R.C. ROUSOS TEMP. 75° TOWNSHIP ADAMS
 _____ SECTION 19
 _____ T 3 N R 16 E

TYPE MONUMENT P.K.NAIL


ON SURFACE - ~~BELOW~~ ON

LEFT - Q PAV'T - RIGHT ON

- TO - EDGE PAVEMENT

S.L.M. 467+46

GRID: NORTHING: 5558520.976 EASTING: 1813244.450

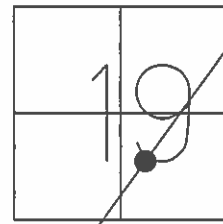

RECORD:
 SET MAG/WASHER
 10/8/09, DCH

