

O.D.O.T. DISTRICT 2 SURVEY OFFICE (USE ONLY)

PERSONNEL

REFERENCE NO. 38

SHEET 16 OF 46

NOTES MILLER

DATE 8/7/24

ROUTE SR 101

H.C. MILLER

WEATHER CLOUDY/WINDY

COUNTY SENECA

R.C. BARRIERE

TEMP. 75°F

TOWNSHIP ADAMS

BLUBAUGH, ASTON, PRESTON-COLVIN

SECTION 19

DWG BY BLUBAUGH

PID 114849

T 3 N R 16 E

TYPE MONUMENT MAG/WASHER

ON SURFACE - ~~BELOW~~ 0.5"

OFFSET $\mathcal{C}$ PAVEMENT 1' LT : ~~RT~~

-- TO -- EDGE PAVEMENT

STATION: 467+57

HORZ.DATUM: NAD83 (2011)


GEOID: NAVD88-2018

GRID: NORTHING: 558528.393


EASTING: 1813251.893

LDP: NORTHING: 327491.74

EASTING: 187667.048

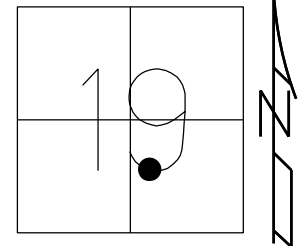

RECORD: P.I.
STA. 44+76.8
STA. 469+42.37
FD IPIN
SET P.K./WASHER
8/27/90
FD P.K./WASHER
2/4/05, SAH
FD P.K./WASHER
REF38
7/21/09, DCH
SET MAG/WASHER
NEWREF38
10/8/09, DCH
FD MAG/WASHER
REF38
6/14/16
9/18/17, JFO
FD MAG/WASHER
REF38
12/14/23, JAM
FD TONE. DID NOT
UNCOVER. PAINTED
8/7/24, JAM

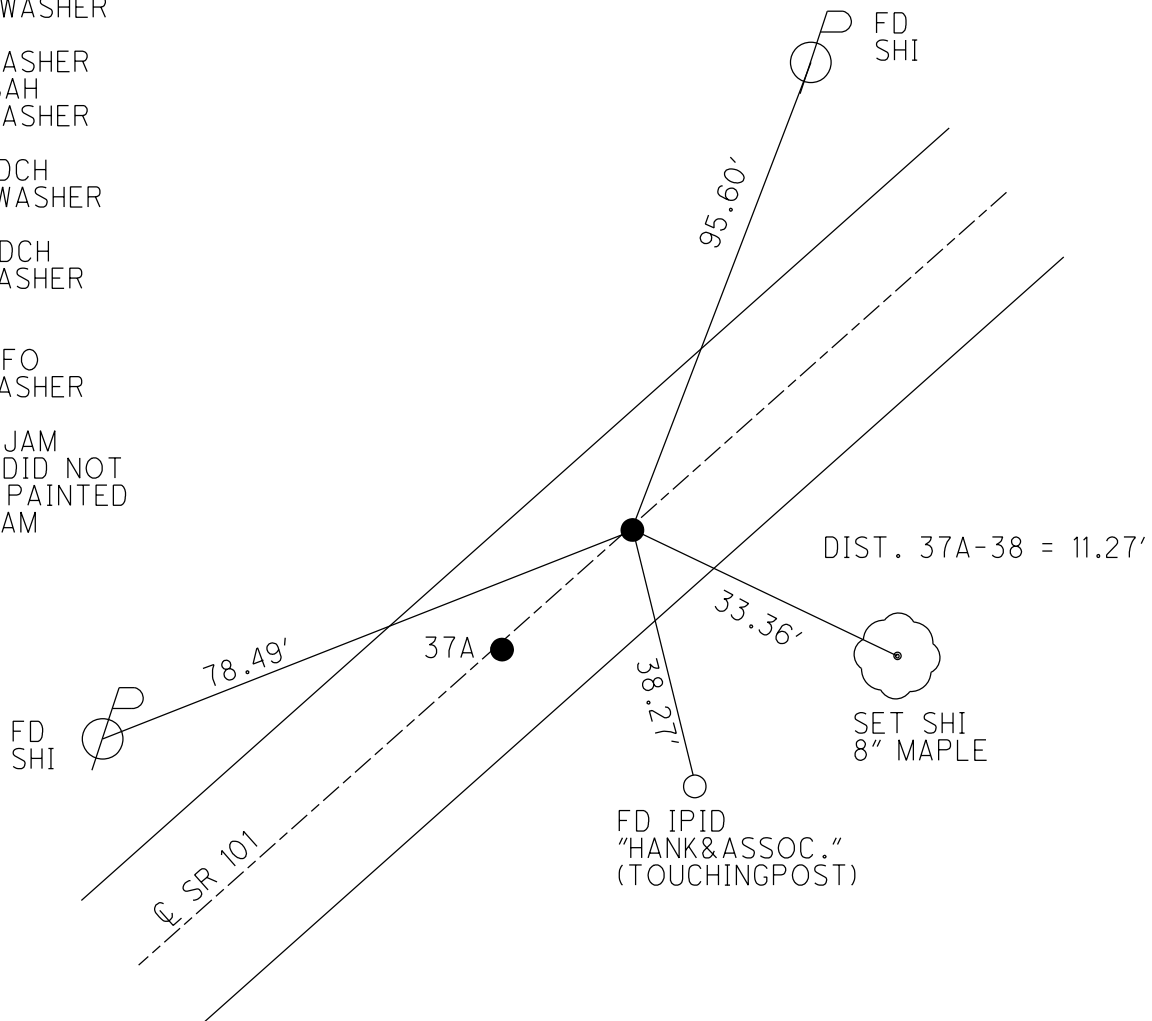

O.D.O.T. DISTRICT 2 SURVEY OFFICE (USE ONLY)

PERSONNEL

REFERENCE NO. 38

SHEET 16 OF 46

NOTES_____HOMAN

DATE 7-21-09

ROUTE SR 101

H.C. HOMAN

WEATHER SUNNY

COUNTY SENECA

R.C. ROUSOS

TEMP. 75°F

TOWNSHIP ADAMS

SECTION _____ 19

DWG BY MAHLER

PID 100787

T_3_N R_16_E

TYPE MONUMENT P.K./WASHER

ON SURFACE - ~~BELOW~~ ON

OFFSET C PAVEMENT 1' LT : RT


____TO____ EDGE PAVEMENT

STATION: 467+57


HORZ.DATUM: NAD83 (2011)

GEOID: NAVD88-2012A

GRID: NORTHING: 558529.393

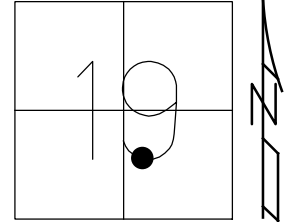EASTING: 1813251.893

RECORD: P.I.
STA. 44+76.8
STA. 469+42.37
FD IPIN
SET P.K./WASHER
8/27/90
FD P.K./WASHER
2/4/05, SAH
FD P.K./WASHER
REF38
7/21/09, DCH
SET MAG/WASHER
NEWREF38
10/8/09, DCH
FD MAG/WASHER
REF38
6/14/16
9/18/17, JFO

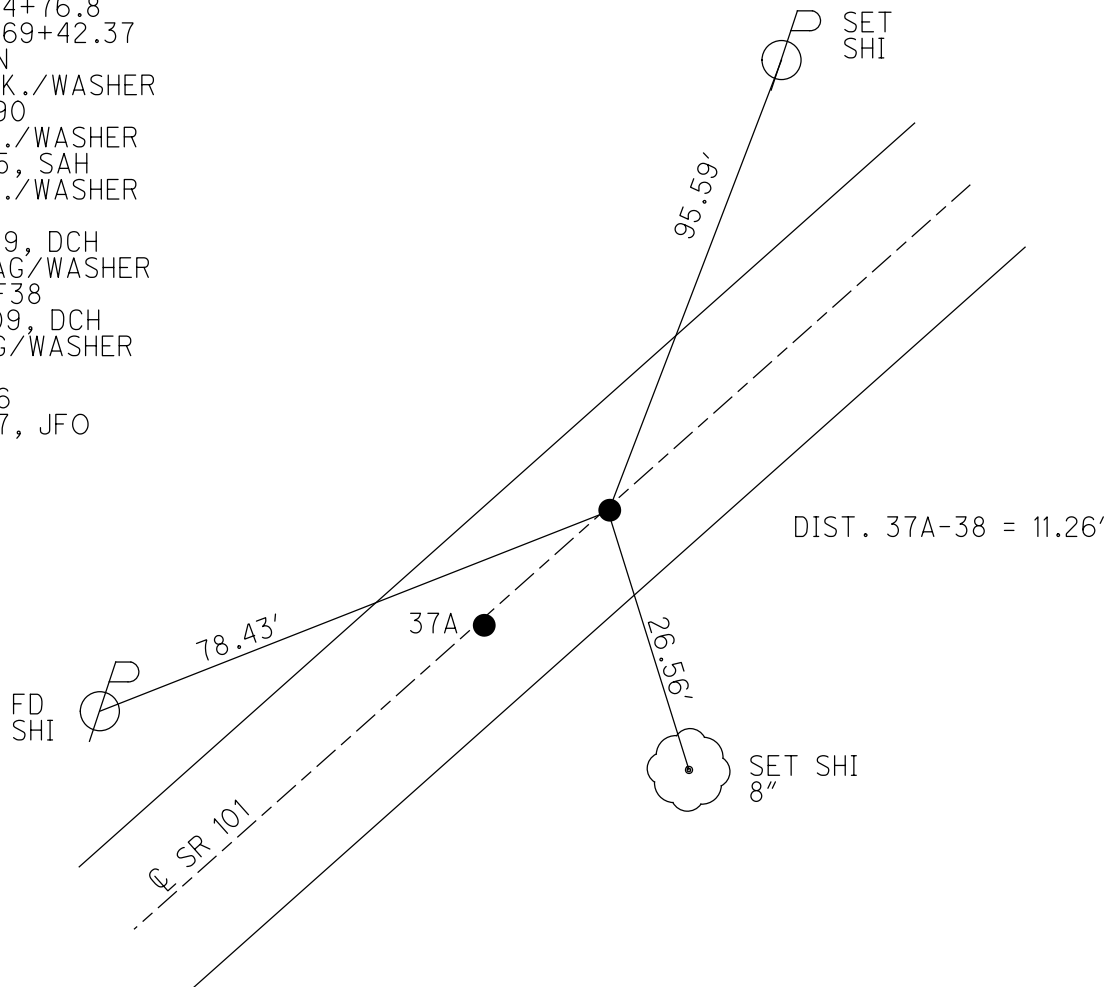


O.D.O.T. DISTRICT 2 SURVEY OFFICE (USE ONLY)


PERSONNEL	REFERENCE NO. <u>38</u>	SHEET <u>16</u> OF <u>46</u>
NOTES	DATE <u>7/21/09</u>	ROUTE <u>SR 101</u>
H.C. <u>HOMAN</u>	WEATHER <u>SUNNY</u>	COUNTY <u>SENECA</u>
R.C. <u>ROUSOS</u>	TEMP. <u>75°</u>	TOWNSHIP <u>ADAMS</u>
		SECTION <u>19</u>
		T <u>3</u> N R <u>16</u> E

TYPE MONUMENT P.K./WASHER
 ON SURFACE - ~~BELOW~~ ON
 LEFT - ℄ PAV'T - ~~RIGHT~~ 1'
- TO - EDGE PAVEMENT
 S.L.M. 467+57

GRID: NORTHING: 558529.393 EASTING: 1813251.893

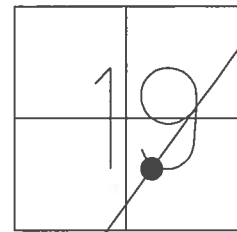

RECORD: P.I.
 STA. 44+76.8
 STA. 469+42.37
 FD IPIN
 SET P.K./WASHER
 8/27/90
 FD P.K./WASHER
 2/4/05, SAH
 SET MAG/WASHER
 10/8/09, DCH
 FD MAG/WASHER
 REF38
 6/14/16, JFO
 UNCOVERED
 9/18/17, JFO

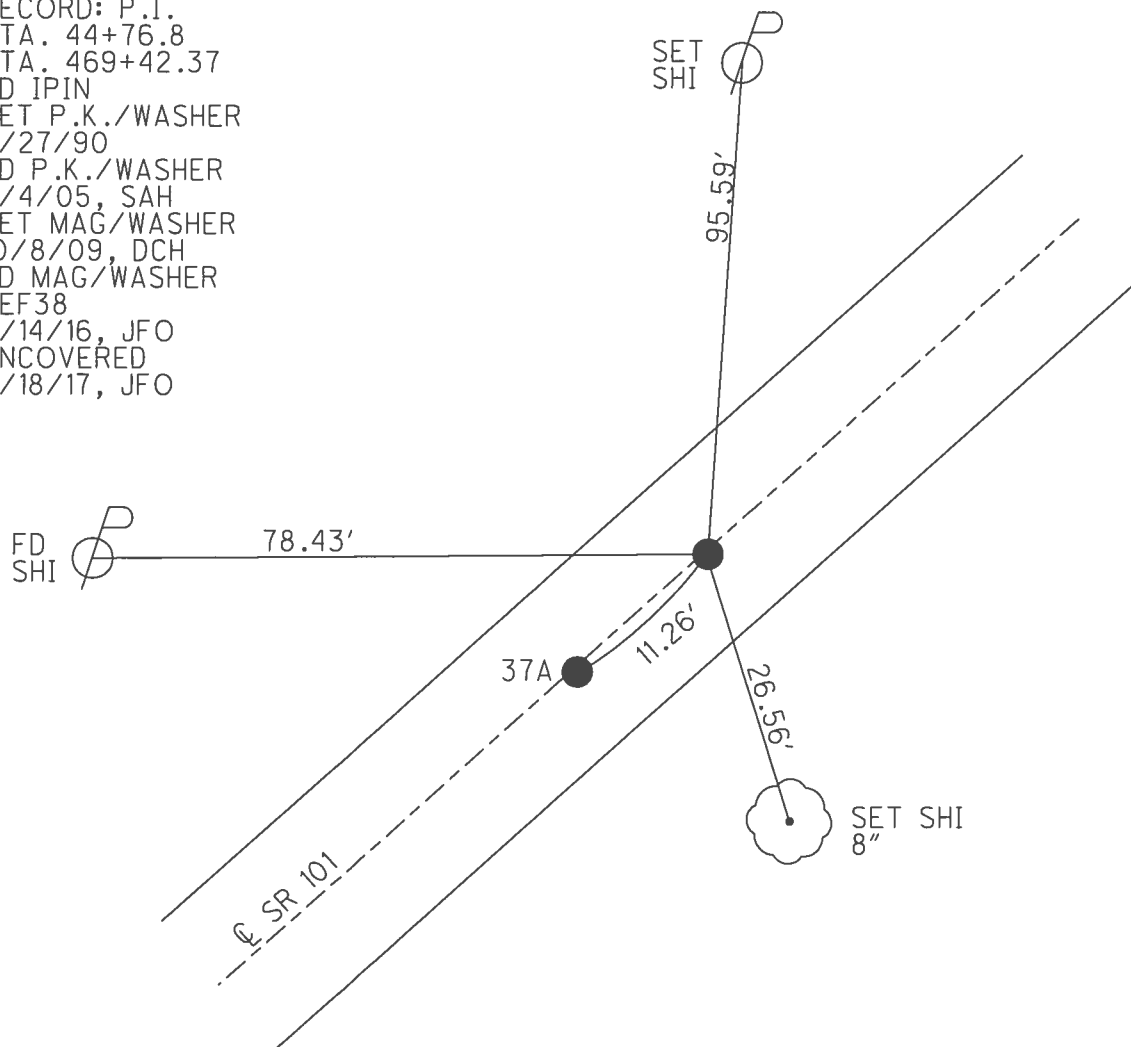


O.D.O.T. DISTRICT 2 SURVEY OFFICE (USE ONLY)


PERSONNEL	REFERENCE NO. <u>38</u>	SHEET <u>16</u> OF <u>46</u>	
NOTES	DATE <u>7/21/09</u>	ROUTE <u>SR 101</u>	
H.C. <u>HOMAN</u>	WEATHER <u>SUNNY</u>	COUNTY <u>SENECA</u>	
R.C. <u>ROUSOS</u>	TEMP. <u>75°</u>	TOWNSHIP <u>ADAMS</u>	
		SECTION <u>19</u>	
		T <u>3</u> N R <u>16</u> E	

TYPE MONUMENT P.K./WASHER
 ON SURFACE - ~~BELOW~~ ON
 LEFT - Q PAV'T - RIGHT ON
- TO - EDGE PAVEMENT
 S.L.M. 467+57

GRID: NORTHING: 558529.508 EASTING: 1813251.861

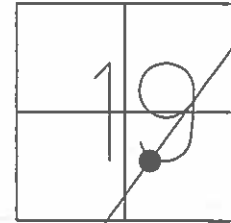

RECORD: P.I.
 STA. 44+76.8
 STA. 469+42.37
 FD IPIN
 SET P.K./WASHER
 8/27/90
 FD P.K./WASHER
 2/4/05, SAH
 SET MAG/WASHER
 10/8/09, DCH

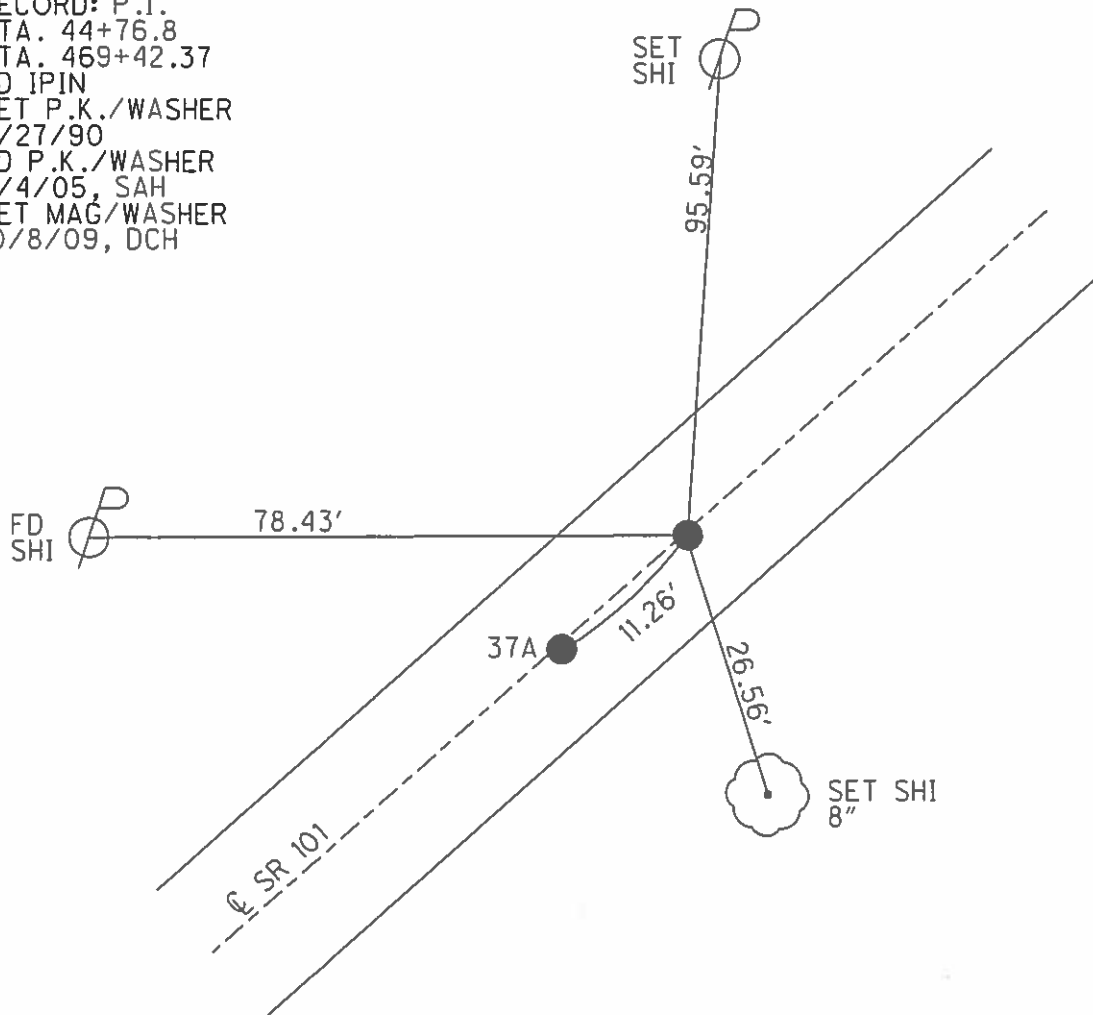

O.D.O.T. DISTRICT 2 SURVEY OFFICE

PERSONNEL

REFERENCE NO. 38

SHEET 12 OF 41

NOTES RIPPLE

H.C. BARBOUR

R.C. GEYMAN

DATE 8/27/90

WEATHER SUNNY

TEMP. 92°

ROUTE SR. #101



COUNTY SENECA

TOWNSHIP ADAMS

SECTION 19


T 3 N R 16 E

TYPE MONUMENT SET P.K. & WASHER
ON SURFACE - BELOW IRON PIN ON & R/W
LEFT - & PAV'T. - RIGHT & PAV'T
____ TO ____ EDGE PAVEMENT
S.L.M. _____

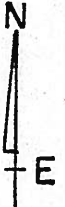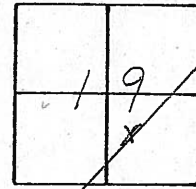

467+57

P.I. 41+76.8 = 469+42.37

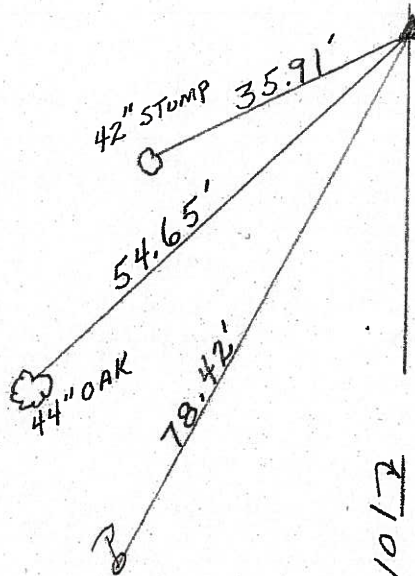

Fd
2-4-05
SAH

& R/W SR# 101

O.D.O.T. DISTRICT 2 SURVEY OFFICE

PERSONNEL

REFERENCE NO. 38

SHEET 12 OF 41

NOTES RIPPLE

H.C. BARBOUR

R.C. GEYMAN

DATE 8/27/90

WEATHER SUNNY

TEMP. 92°

ROUTE S.R. #101


COUNTY SENECA

TOWNSHIP ADAMS


SECTION 19

T3 NR 16 E

TYPE MONUMENT SET P.K. & WASHER
ON SURFACE - BELOW IRON PIN ON E R/W
LEFT - C PAV'T. - RIGHT E PAV'T
TO EDGE PAVEMENT
S.L.M. _____

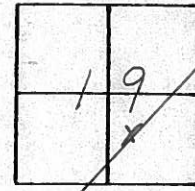


P.I. 41+76.8 = 469+42.37

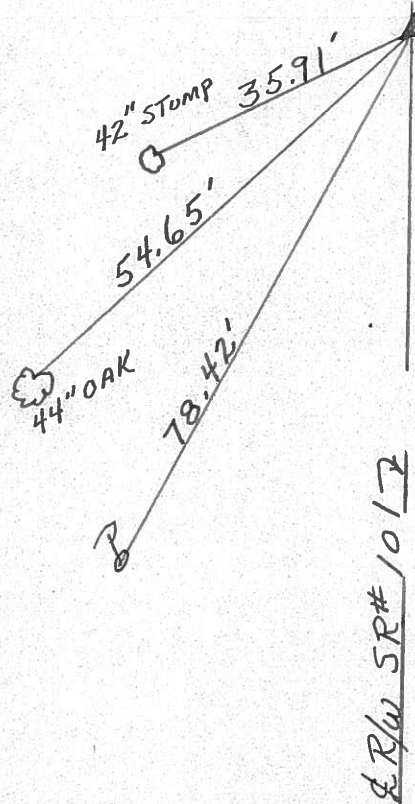

County Seneca S.R. 101Township AdamsSection 19T 3 N, R 16 EPersonnel SchneiderMosserBarbourDate 6-25-79Weather FairTemp. 60°

(38)

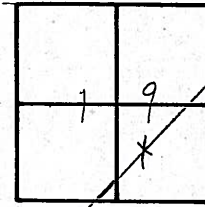~~#43~~

S.R. #101

P. I.

$$41 + 76.8 = 469 + 42.37$$

Iron Pin on E R/W

Reset P.K. Nail

42" Ash

30" Oak

35.89'

54.82'

78.41'

30.94'

PERSONNEL	TITLE	PERSONNEL	TITLE	COUNTY	DATE
Schneider		Vinson		Seneca	9-29-71
Mosser				S. R. 101	WEATHER Hot
Barbour				SEC. Br. # 8.10	TEMP. 85°
Geyman					JOB NO. 02827(0)

DESCRIPTION

Ties for Control Points

LEFT

CENTER LINE

RIGHT

(38)

P.I.

469+42.37

small spk. on E R/W

~~43~~

42" Ash

34.73'

35.27'


36" Maple

54.94'

30" Oak

78.41'

30.94'

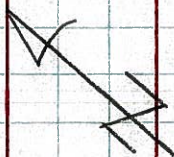

(37)

P.I.

447+43.01

 $\Delta = 1031'30''$ RT

1/2" Iron pin on E R/W

2" down

~~42~~

41.10'

60.69'

16.22'

78.32'

SW. cor. conc. Hdwl.

2 story Res.

(36)

P.O.T.

440+00

set P.K. Nail

~~41~~


1'x7' Conc. Hdwl.

16.37'

24.28'

x Wood fence post

32.24'

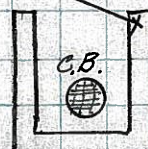

PERSONNEL TITLE PERSONNEL TITLE

COUNTY Seneca DATES. R. 101 WEATHER

SEC. TEMP.

DESCRIPTION LEFT CENTER LINE RIGHT JOB NO.


(35)

184+16.5

#386

P.K. nail

2-10-64

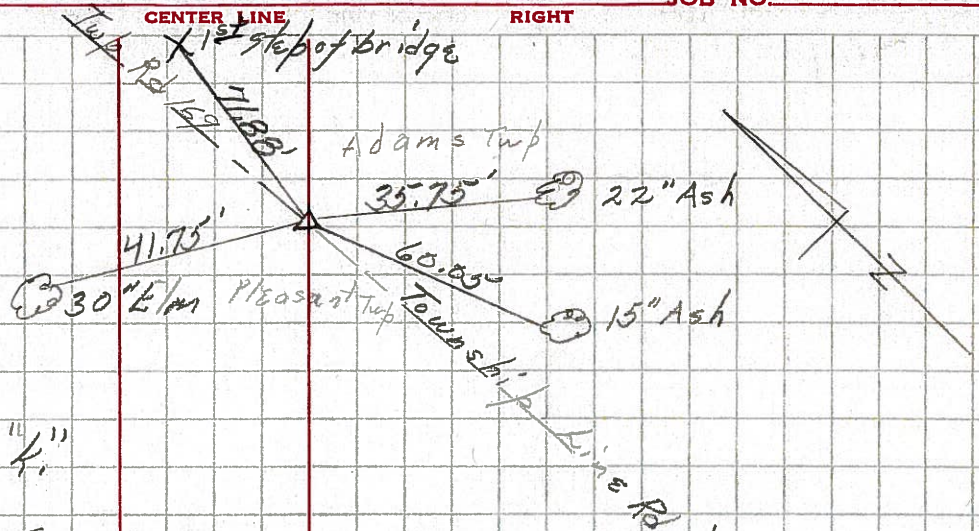

End of sec. 4

SEC 0 Sta 0+00 = 184+16.5 Sec 4

Start of sec. 0


(37)

19+77.65

#387

P.K. nail

2-10-64

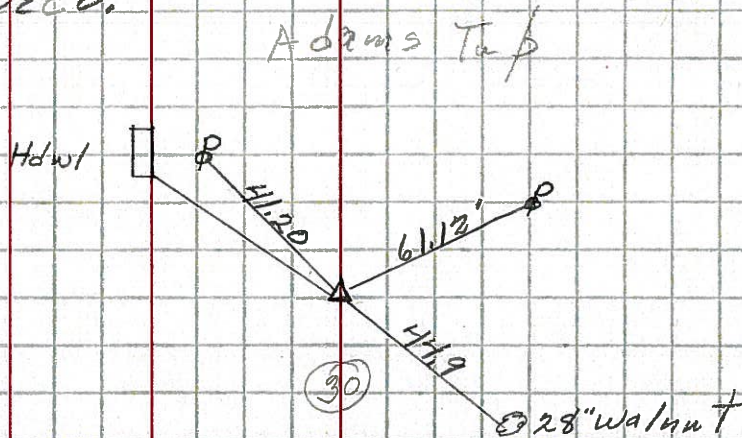

(38)

41+76.8

#388

P.K. nail

2-10-64

