

O.D.O.T. DISTRICT 2 SURVEY OFFICE (USE ONLY)

PERSONNEL

REFERENCE NO. 48

SHEET 26 OF 46

NOTES MILLER

DATE 8/7/24

ROUTE SR 101

H.C. MILLER

WEATHER WINDY

COUNTY SENECA

R.C. BARRIERE

TEMP. 70°F

TOWNSHIP ADAMS

BLUBAUGH, ASTON, PRESTON-COLVIN

SECTION 16

DWG BY BLUBAUGH

PID 114849

T 3 N R 16 E

TYPE MONUMENT MAG/WASHER

ON SURFACE - ~~BELOW~~ 0.5"

OFFSET Q PAVEMENT ON LT : RT

-- TO -- EDGE PAVEMENT

STATION: 590+83

HORIZ.DATUM: NAD83 (2011)


GEOID: NAVD88-2018

GRID: NORTHING: 567088.109


EASTING: 1822046.942

LDP: NORTHING: 336116.521

EASTING: 196398.794

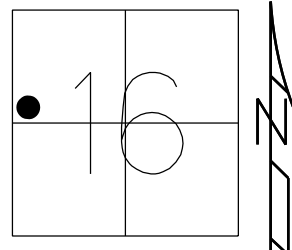

RECORD: P.O.T.
STA. 81+00
FD P.K.NAIL
ATOP R.R.SPIKE
SET SQ.HEADED
NAIL/WASHER
FD SQ.HEADED
NAIL/WASHER
2/7/05, SAH
REF48
7/28/09, DCH
SET MAG/WASHER
NEWREF48
10/6/09, DCH
FD MAG/WASHER
REF48
6/14/16
9/18/17, JFO
FD MAG/WASHER
REF48
12/13/23, JAM
FD TONE. DID NOT
UNCOVER. PAINTED
8/7/24, JAM

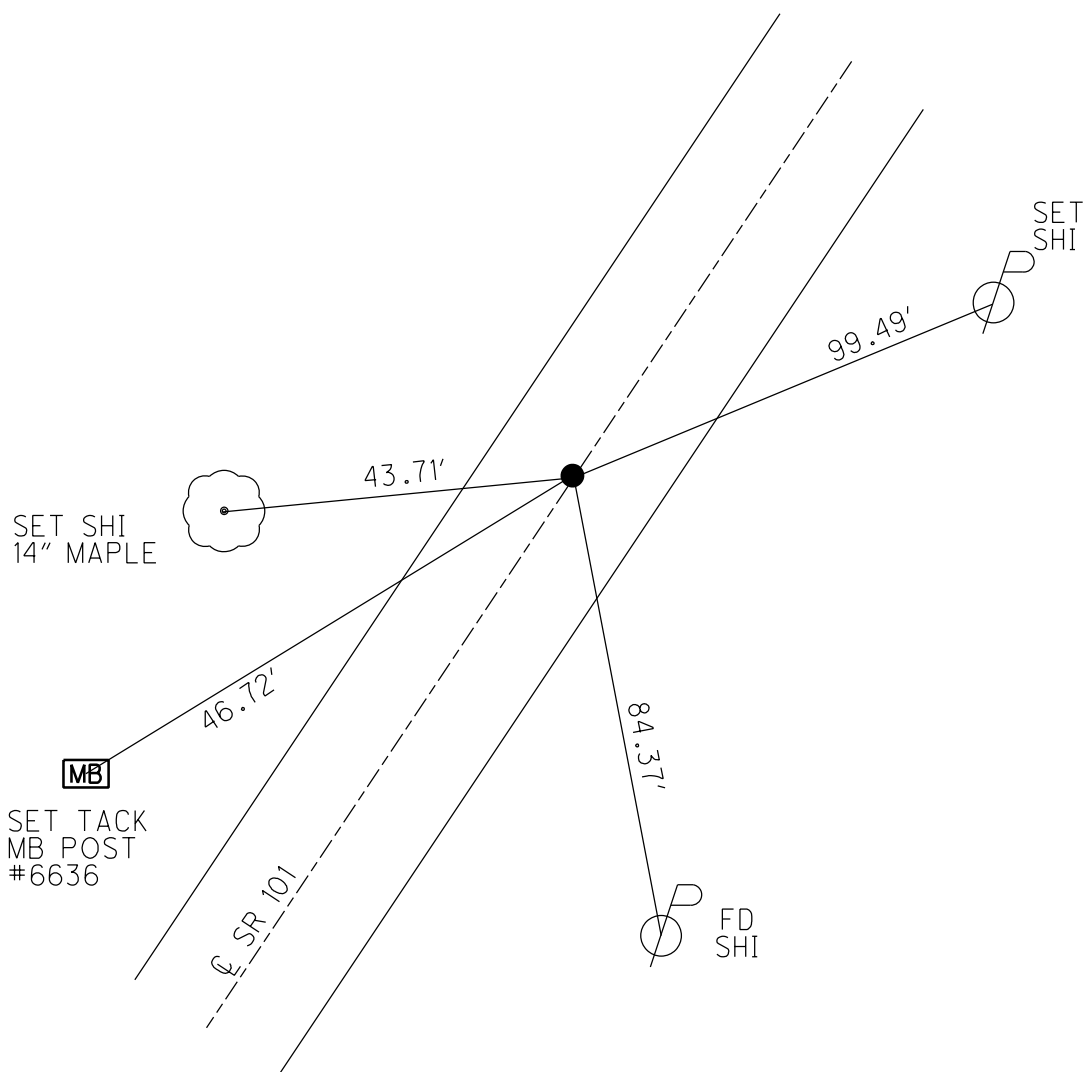

O.D.O.T. DISTRICT 2 SURVEY OFFICE (USE ONLY)

PERSONNEL

REFERENCE NO. 48

SHEET 26 OF 46

NOTES HOMAN

DATE 7-21-09

ROUTE SR 101

H.C. HOMAN

WEATHER SUNNY

COUNTY SENECA

R.C. ROUSOS

TEMP. 85°F

TOWNSHIP ADAMS

DWG BY MAHLER PID 100787

SECTION 16

T 3 N R 16 E

TYPE MONUMENT SQ HEADED NAIL/WASHER

ON SURFACE - ~~BELOW~~ ON

OFFSET Q PAVEMENT ON LT : RT

- TO - EDGE PAVEMENT


STATION: 590+83

HORZ.DATUM: NAD83 (2011)

GEOID: NAVD88-2012A

GRID: NORTHING: 567088.109

EASTING: 1822046.942

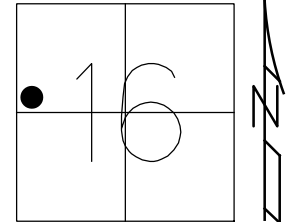

RECORD: P.O.T.

STA. 81+00

FD P.K.NAIL

ATOP R.R.SPIKE

SET SQ.HEADED

NAIL/WASHER

FD SQ.HEADED

NAIL/WASHER

2/7/05, SAH

REF48

7/28/09, DCH

SET MAG/WASHER

NEWREF48


10/6/09, DCH

FD MAG/WASHER

REF48

6/14/16


9/18/17, JFO

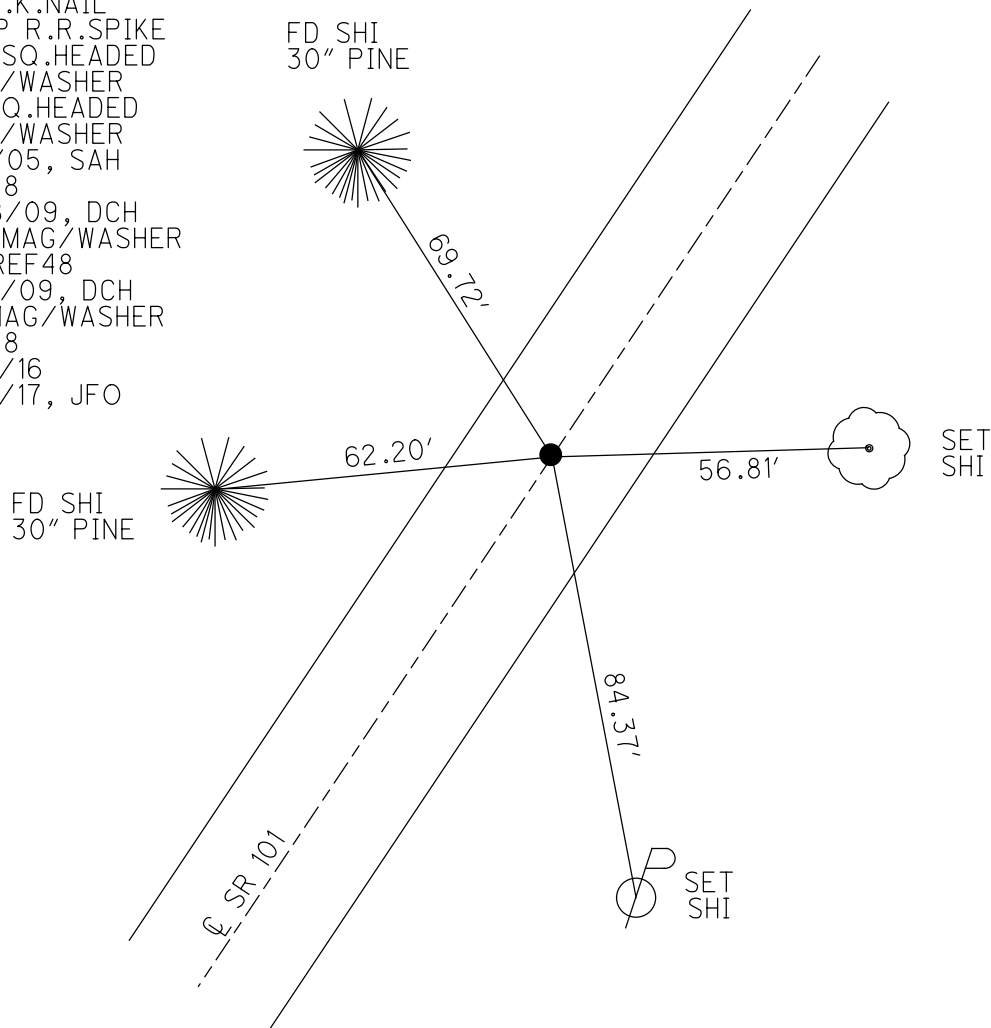

O.D.O.T. DISTRICT 2 SURVEY OFFICE (USE ONLY)


PERSONNEL	REFERENCE NO. <u>48</u>	SHEET <u>26</u> OF <u>46</u>	
NOTES	DATE <u>7/21/09</u>	ROUTE <u>SR 101</u>	
H.C. <u>HOMAN</u>	WEATHER <u>SUNNY</u>	COUNTY <u>SENECA</u>	
R.C. <u>ROUSOS</u>	TEMP. <u>85°</u>	TOWNSHIP <u>ADAMS</u>	
		SECTION <u>16</u>	
		T <u>3</u> N R <u>16</u> E	

TYPE MONUMENT SQ. HEADED NAIL / WASHER
 ON SURFACE - ~~BELOW~~ ON
 LEFT - ℄ PAV'T - RIGHT ON
- TO - EDGE PAVEMENT
 S.L.M. 590+83

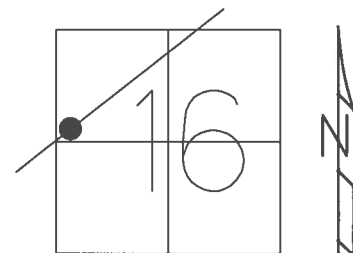

GRID: NORTHING: 567088.076 EASTING: 1822046.942

RECORD: P.O.T.
 STA. 81+00
 FD P.K. NAIL ATOP
 R.R. SPIKE
 SET SQ. HEADED
 NAIL / WASHER
 FD SQ. HEADED
 NAIL / WASHER
 2/7/05, SAH
 SET MAG / WASHER
 10/6/09, DCH
 FD MAG / WASHER
 REF 48
 6/14/16, JFO
 UNCOVERED
 9/18/17, JFO

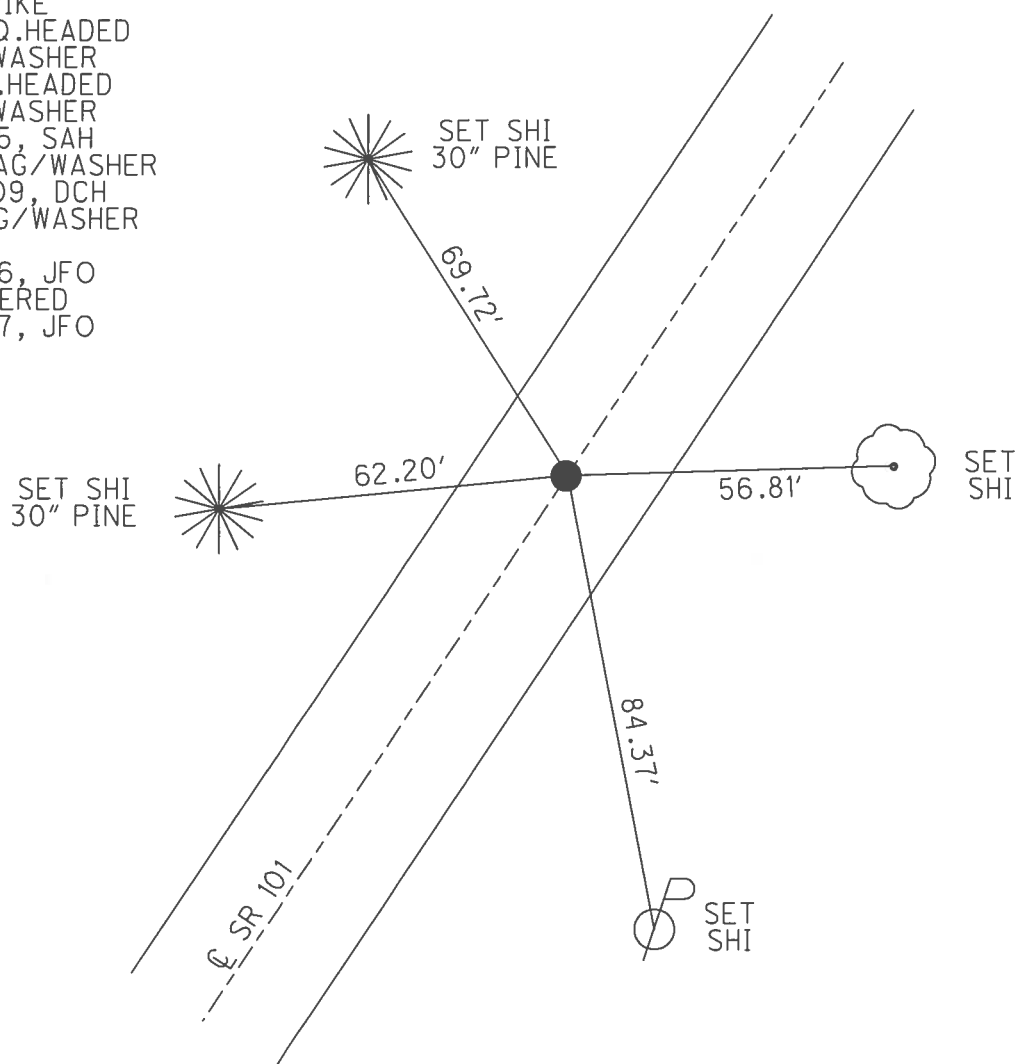


O.D.O.T. DISTRICT 2 SURVEY OFFICE (USE ONLY)


PERSONNEL _____ REFERENCE NO. 48 SHEET 26 OF 46
 NOTES HOMAN DATE 7/21/09 ROUTE SR 101
 H.C. HOMAN WEATHER SUNNY COUNTY SENECA
 R.C. ROUSOS TEMP. 85° TOWNSHIP ADAMS
 SECTION 16
 T 3 N R 16 E

TYPE MONUMENT SQ. HEADED NAIL / WASHER
 ON SURFACE - ~~BELOW~~ ON _____
 LEFT - ℄ PAV'T - RIGHT ON _____
 - TO - EDGE PAVEMENT
 S.L.M. 590+83

GRID: NORTHING: 567088.109 EASTING: 1822046.871

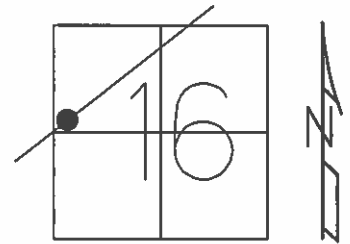

RECORD: P.O.T.
 STA. 81+00
 FD P.K. NAIL ATOP
 R.R. SPIKE
 SET SQ. HEADED
 NAIL / WASHER
 FD SQ. HEADED
 NAIL / WASHER
 2/7/05, SAH
 SET MAG / WASHER
 10/6/09, DCH

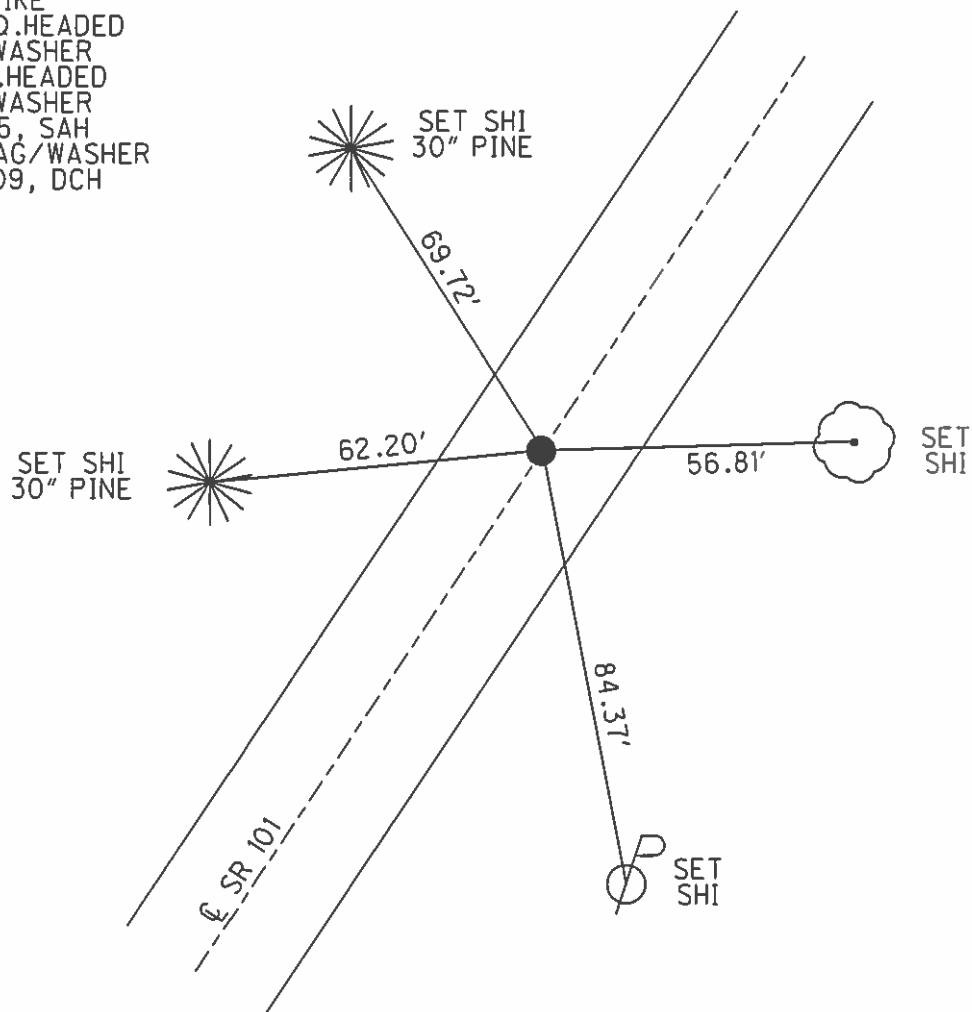

O.D.O.T. DISTRICT 2 SURVEY OFFICE

PERSONNEL

REFERENCE NO. 48

SHEET 22 OF 41

NOTES RIPPLE

H.C. BARBOUR

R.G. Geyman

DATE 8/28/90

WEATHER SUNNY

TEMP. 86°

ROUTE SR #101

COUNTY SENECA

TOWNSHIP ADAMS

SECTION 16

T 3 N R 16 E



TYPE MONUMENT Set Square Headed Nail & washer

ON SURFACE - BELOW PK Nail A Top RR spike

LEFT - ℄ PAV'T. - RIGHT ℄ PAV'T.


TO EDGE PAVEMENT

S.L.M.

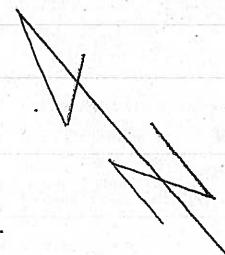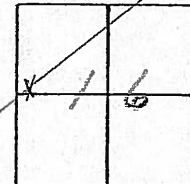

~~590+83~~
590+83

P.O.T. 81+00

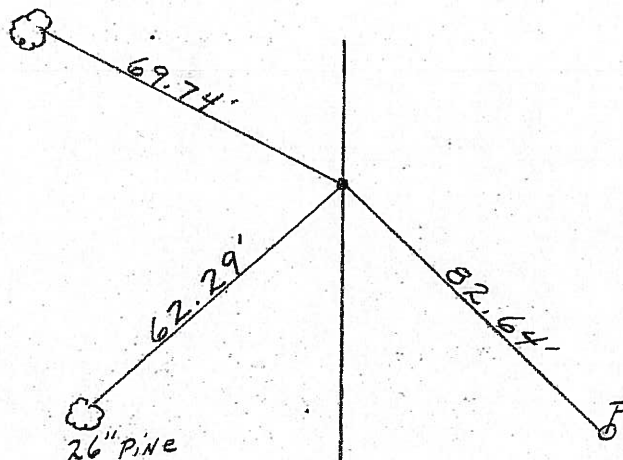

FD
2-7-05
SAH

℄ R/W SR #101

O.D.O.T. DISTRICT 2 SURVEY OFFICE

PERSONNEL

REFERENCE NO. 48

SHEET 22 OF 41

NOTES Ripple

H.C. BARBOUR

R.C. Geyman

DATE 8/28/90

WEATHER SUNNY

TEMP. 86°

ROUTE SR#101

COUNTY SENECA

TOWNSHIP ADAMS

SECTION 16

T 3 N R 16 E


TYPE MONUMENT SET SQUARE HEADED NAIL & WASHER

ON SURFACE - BELOW PK NAIL AT TOP RR SPIKE


LEFT - & PAV'T. - RIGHT & PAV'T.

TO EDGE PAVEMENT

S.L.M. _____

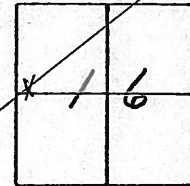

P.O.T. 81+00

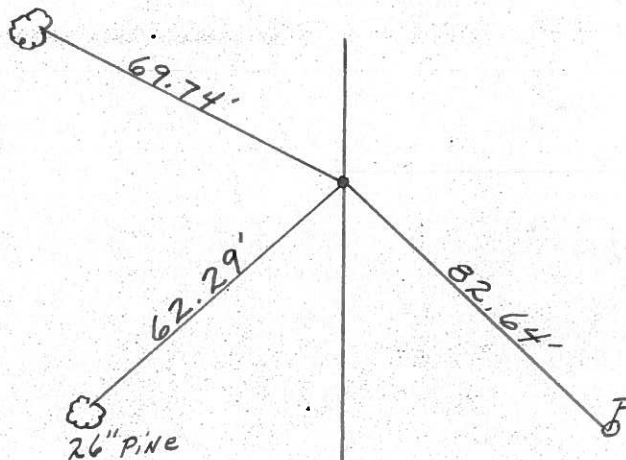

E.R/W SR. #101

Q.D.O.T. DISTRICT 2 SURVEY OFFICE

Sht. of

County Seneca S.R. # 101

Township Adams

Section 18

T3N, R16E


Personnel Schneider
Mosser
Barbour

Date 7-2-79


Weather Fair

Temp. 65°


(48)

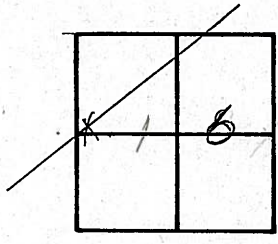

~~#47~~

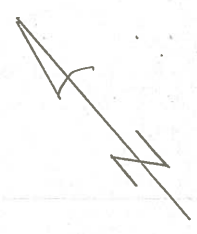

P. O. T.
81+00
R.R. spk. on E R/W
2" down
Reset P.K. Nail

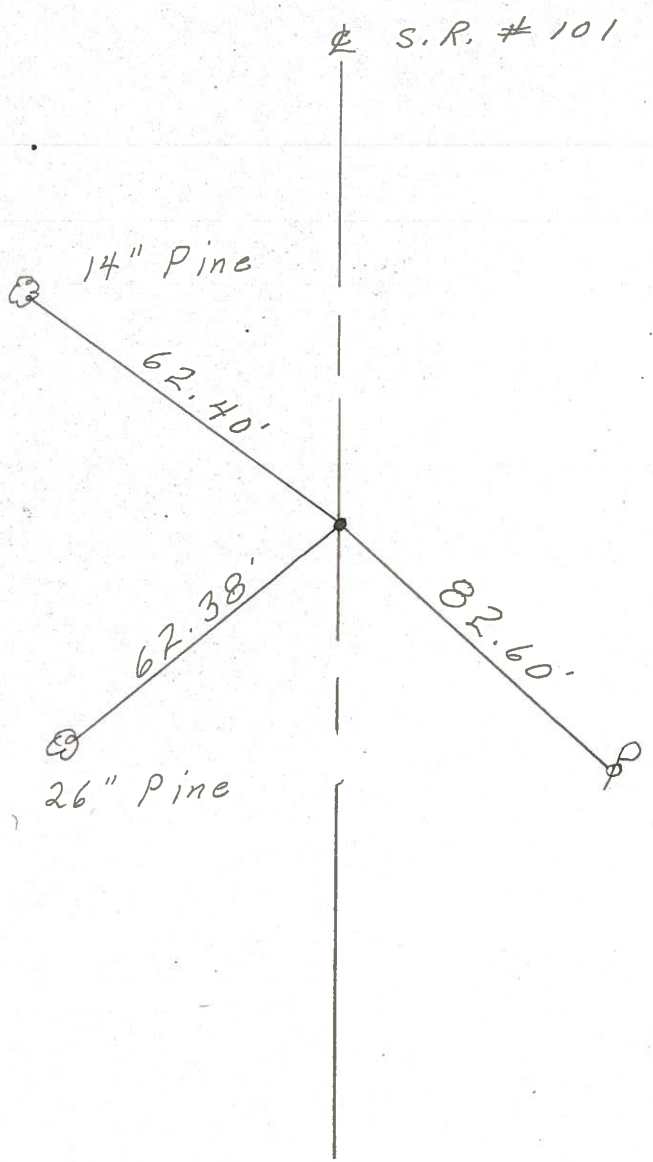

PERSONNEL TITLE PERSONNEL TITLE

COUNTY Seneca

DATE 2-11-64

Kra Bill

Kowaleski

S. R. #101

WEATHER

Geyman

SEC.

TEMP.

Bruggeman

DESCRIPTION S.R. #101 Tiffin To Sen. Co. Line

JOB NO.

LEFT


CENTER LINE

RIGHT

Adams


46

STA. 56+00

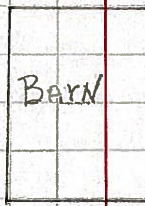Iron Pin
#395


47

STA. 71+00

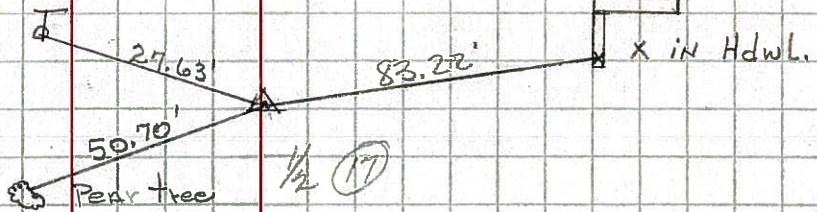Iron Pin
#396


48

STA. 81+00

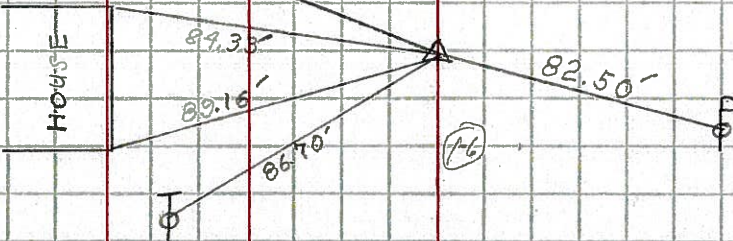Iron Pin
#397

49

STA. 90+00

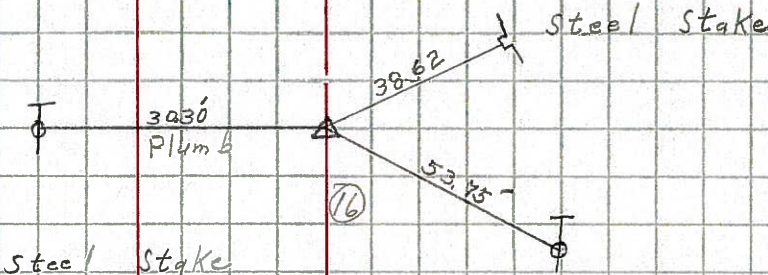Iron Pin
#398

STA. 97+00

Iron Pin
#399