

O.D.O.T. DISTRICT 2 SURVEY OFFICE (USE ONLY)

PERSONNEL

REFERENCE NO. 50

SHEET 28 OF 46

NOTES MILLER

DATE 8/7/24

ROUTE SR 101

H.C. MILLER

WEATHER WINDY

COUNTY SENECA

R.C. BARRIERE

TEMP. 70°F

TOWNSHIP ADAMS

BLUBAUGH, ASTON, PRESTON-COLVIN

SECTION 16

DWG BY BLUBAUGH

PID 114849

T 3 N R 16 E

TYPE MONUMENT MAG/WASHER

ON SURFACE - ~~BELOW~~ 0.5"

OFFSET $\mathcal{Q}$ PAVEMENT 1.7' LT : ~~RT~~

-- TO -- EDGE PAVEMENT

STATION: 599+82

HORZ.DATUM: NAD83 (2011)


GEOID: NAVD88-2018

GRID: NORTHING: 567676.511


EASTING: 1822727.247

LDP: NORTHING: 337947.109

EASTING: 198447.627

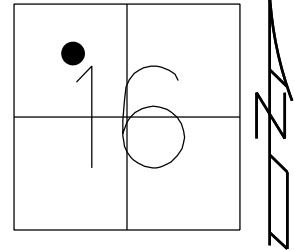

RECORD: P.O.T.
STA 108+50
FD P.K. NAIL
ATOP R.R. SPIKE
SET SQ HEADED
NAIL/WASHER
8/28/90
FD SQ HEADED
NAIL/WASHER
2/7/05, SAH
REF50
7/28/09, DCH
SET MAG/WASHER
NEWREF50
10-06-09, DH
FD MAG/WASHER
REF50
6/14/16
9/18/17, JFO
FD MAG/WASHER
REF50
12/13/23, JAM
FD TONE. DID NOT
UNCOVER. PAINTED
8/7/24, JAM

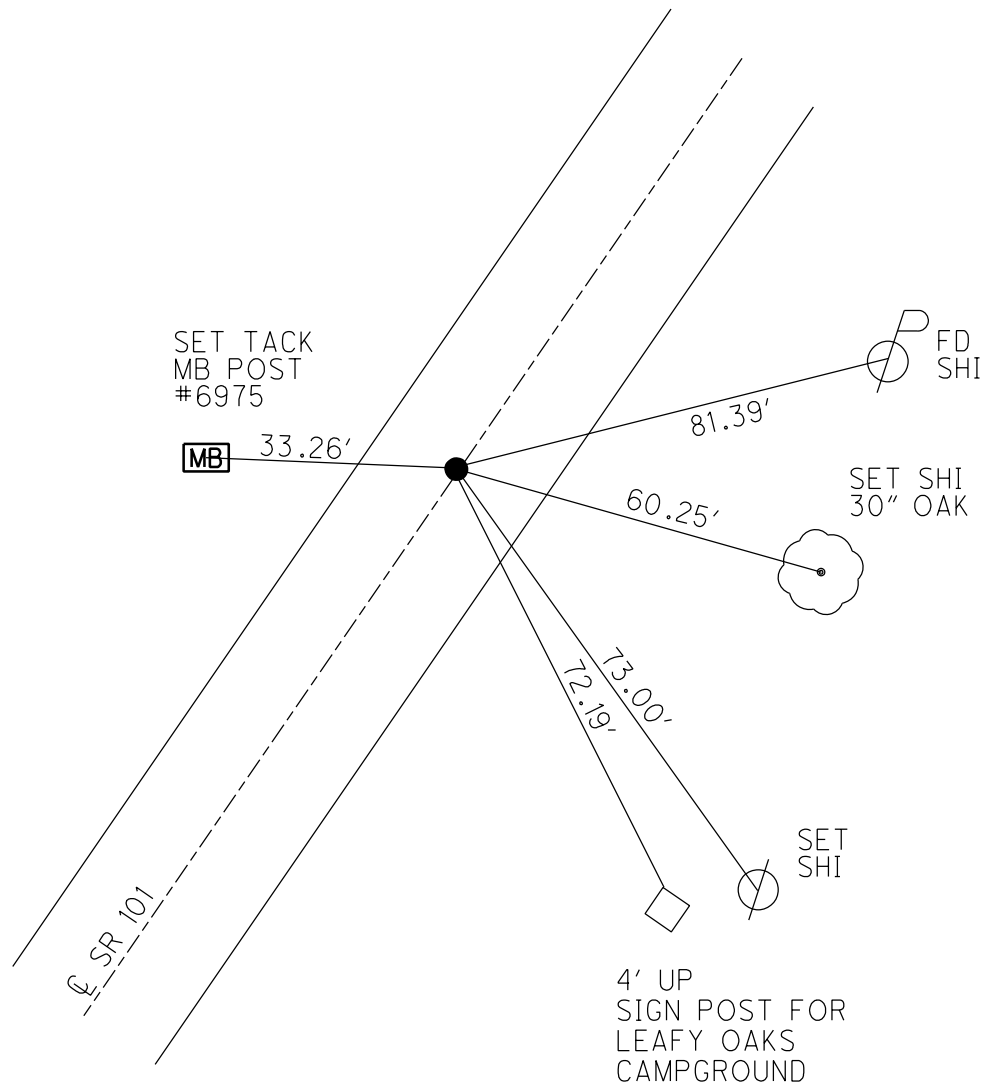

O.D.O.T. DISTRICT 2 SURVEY OFFICE (USE ONLY)

PERSONNEL

REFERENCE NO. 50

SHEET 28 OF 46

NOTES HOMAN

DATE 7-21-09

ROUTE SR 101

H.C. HOMAN

WEATHER SUNNY

COUNTY SENECA

R.C. ROUSOS

TEMP. 85°F

TOWNSHIP ADAMS

DWG BY MAHLER

PID 100787

SECTION 16

T 3 N R 16 E

TYPE MONUMENT SQ HEADED NAIL/WASHER

ON SURFACE - ~~BELOW~~ ON

OFFSET 1.7' LT : ~~RT~~

- TO - EDGE PAVEMENT


STATION: 618+32

HORZ.DATUM: NAD83 (2011)


GEOID: NAVD88-2012A

GRID: NORTHING: 568903.181

EASTING: 1824109.145

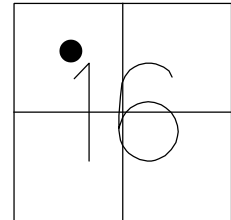

RECORD: P.O.T.
STA 108+50
FD P.K. NAIL
ATOP R.R. SPIKE
SET SQ HEADED
NAIL/WASHER
8/28/90
FD SQ HEADED
NAIL/WASHER
2/7/05, SAH
REF50
7/28/09, DCH
SET MAG/WASHER
NEWREF50
10-06-09, DH
FD MAG/WASHER
REF50
6/14/16
9/18/17, JFO

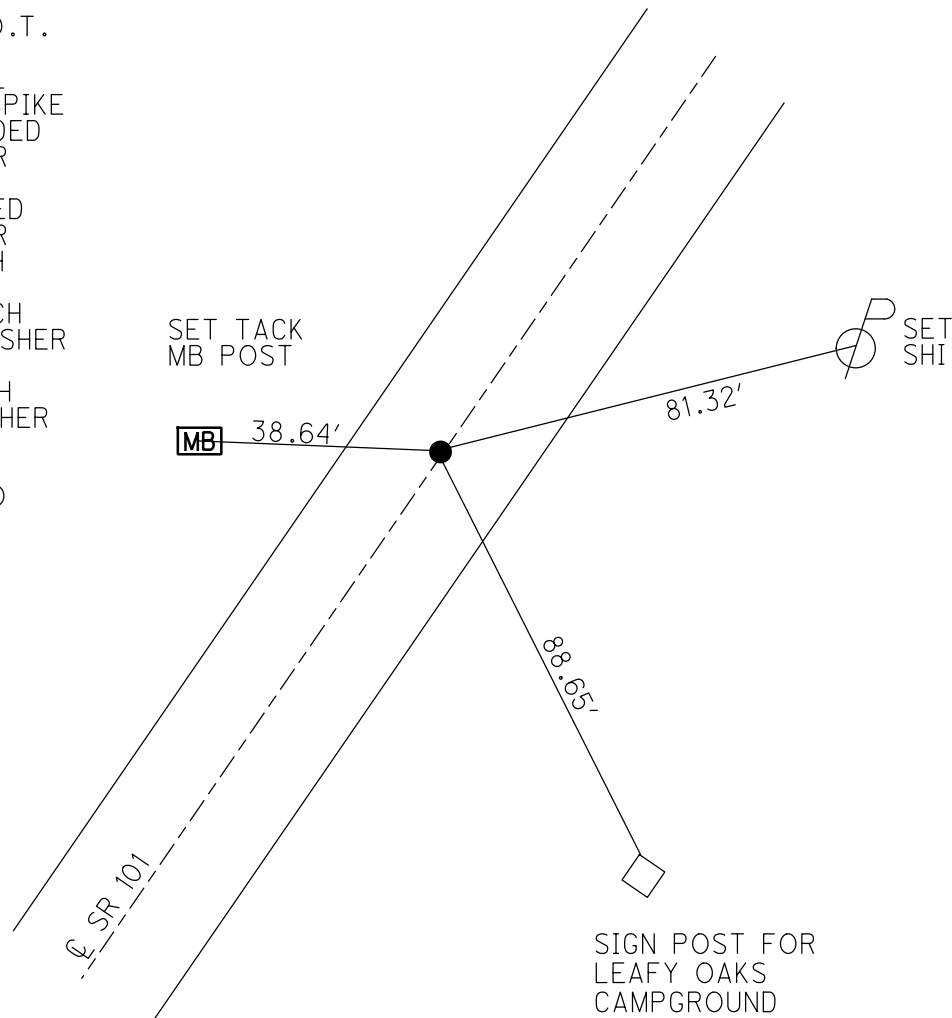


O.D.O.T. DISTRICT 2 SURVEY OFFICE (USE ONLY)


PERSONNEL	REFERENCE NO. <u>50</u>	SHEET <u>28</u> OF <u>46</u>
NOTES	DATE <u>7/21/09</u>	ROUTE <u>SR 101</u>
H.C. <u>HOMAN</u>	WEATHER <u>SUNNY</u>	COUNTY <u>SENECA</u>
R.C. <u>ROUSOS</u>	TEMP. <u>85°</u>	TOWNSHIP <u>ADAMS</u>
		SECTION <u>16</u>
		T <u>3</u> N R <u>6</u> E

TYPE MONUMENT SQ. HEADED NAIL/WASHER
 ON SURFACE - ~~BELOW~~ ON
 LEFT - ℄ PAV'T - ~~RIGHT~~ 1.7'
- TO - EDGE PAVEMENT
 S.L.M. 618+32

GRID: NORTHING: 568903.181 EASTING: 1824109.145

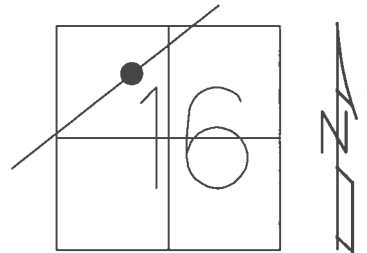

RECORD: P.O.T.
 STA 108+50
 FD P.K. NAIL A TOP
 R.R. SPIKE
 SET SQ HEADED
 NAIL/WASHER
 8/28/90
 FD SQ HEADED
 NAIL/WASHER
 2/7/05, SAH
 SET MAG/WASHER
 10-06-09, DH
 FD MAG/WASHER
 REF50
 6/14/16, JFO
 UNCOVERED
 9/18/17, JFO

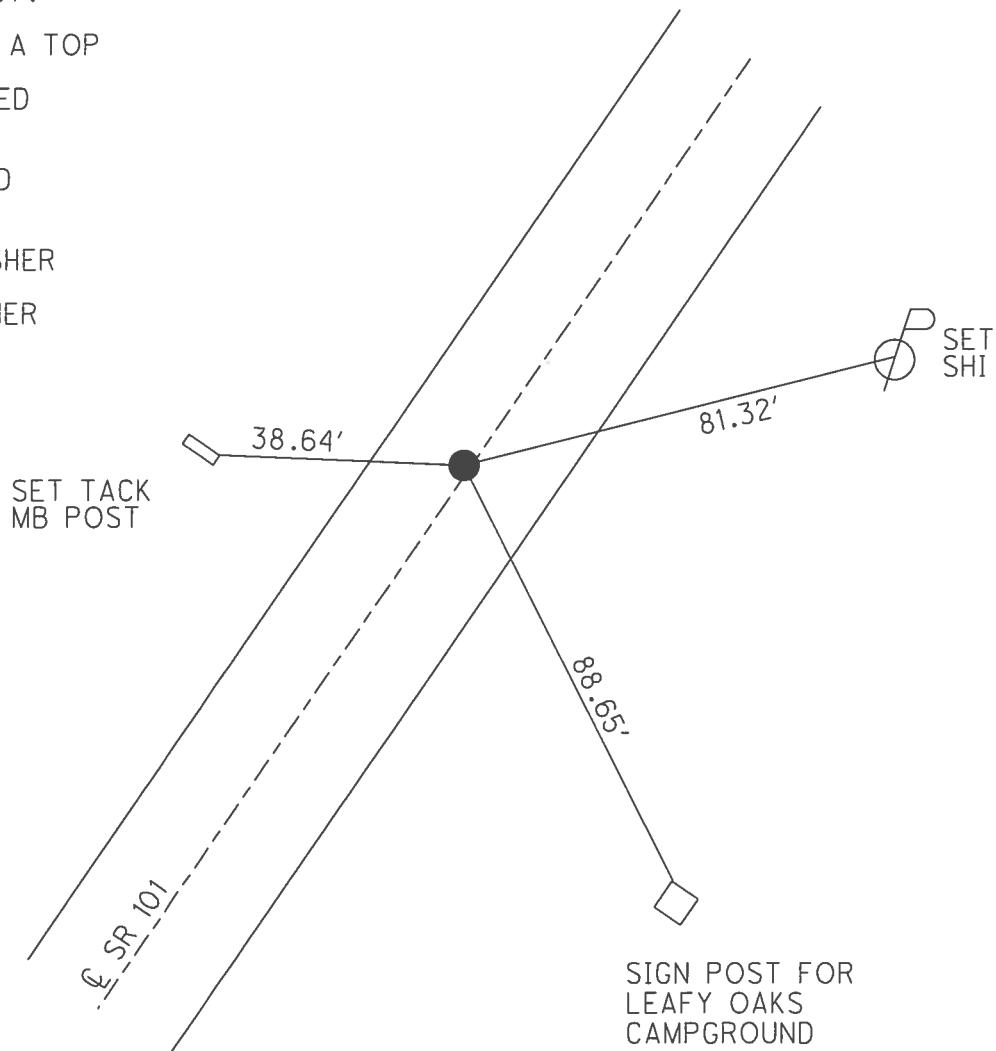

O.D.O.T. DISTRICT 2 SURVEY OFFICE (USE ONLY)

PERSONNEL

REFERENCE NO. 50

SHEET 28 OF 46

NOTES

HOMAN

DATE 7/21/09

ROUTE SR 101

H.C.

HOMAN

WEATHER SUNNY

COUNTY SENECA

R.C.

ROUSOS

TEMP. 85°

TOWNSHIP ADAMS

SECTION 16

T 3 N R 6 E

TYPE MONUMENT SQ. HEADED NAIL/WASHER


ON SURFACE - ~~BELOW~~ ON

LEFT - Q PAV'T - ~~RIGHT~~ 1.7'

- TO - EDGE PAVEMENT

S.L.M. 618+32

GRID: NORTHING: 568903.229 EASTING: 1824109.112

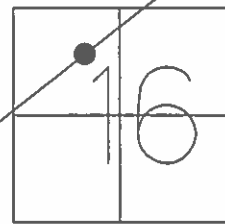

RECORD: P.O.T.

STA 108+50

FD P.K. NAIL A TOP

R.R. SPIKE

SET SQ HEADED

NAIL/WASHER

8/28/90

FD SQ HEADED

NAIL/WASHER

2/7/05, SAH

SET MAG/WASHER

10-06-09, DH

SET TACK
MB POST

38.64'

81.32'

88.65'

SET
SHI

SIGN POST FOR
CAMPGROUND

SR 101

O.D.O.T. DISTRICT 2 SURVEY OFFICE

PERSONNEL

REFERENCE NO. 50

SHEET 25 OF 41

NOTES RIPPLE

H.C. BARBOUR

R.C. GEYMAN

DATE 8/28/90

WEATHER SUNNY

TEMP. 86°

ROUTE S.R. #101

COUNTY SENECA

TOWNSHIP ADAMS

SECTION 16

T.3 N R.16 E


TYPE MONUMENT Set Square Headed Nail & washer

ON SURFACE - BELOW P.K. Nail A Top RR Spike

LEFT - 6 PAV'T. - RIGHT 1.7' LT. & PAV'T.


TO EDGE PAVEMENT

S.L.M.

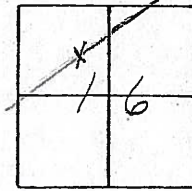

618+32

P.O.T. 108+50

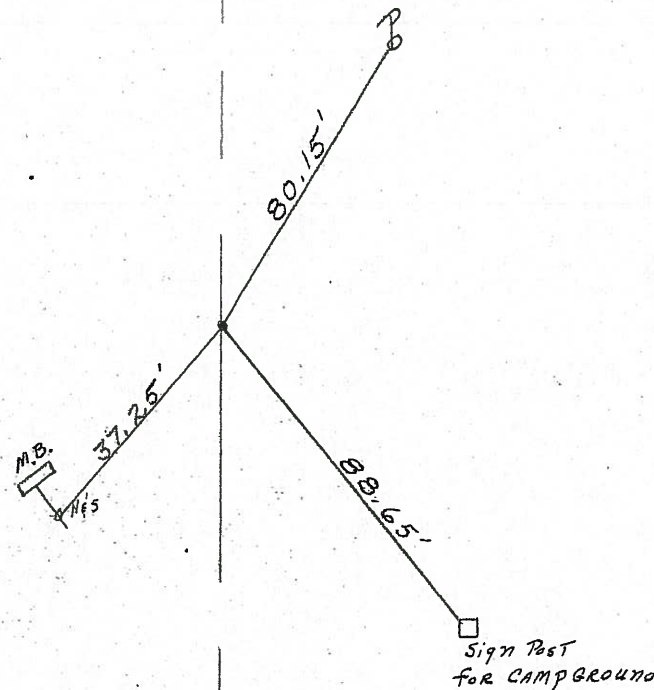

FL

2-7-05

SAH

O.D.O.T. DISTRICT 2 SURVEY OFFICE

PERSONNEL

REFERENCE NO. 50

SHEET 25 OF 41

NOTES RIPPLE

H.C. BARBOUR

R.C. GEYMAN

DATE 8/28/90

WEATHER SUNNY

TEMP. 86°

ROUTE S.R. #101

COUNTY SENECA

TOWNSHIP ADAMS

SECTION 16

T. 3 N R. 16 E


TYPE MONUMENT Set Square Headed Nail & washer

ON SURFACE - BELOW P.K. Nail A Top RR Spike


LEFT - CL PAV'T. - RIGHT 1.7' LT. CL PAV'T.

TO EDGE PAVEMENT

S.L.M. _____

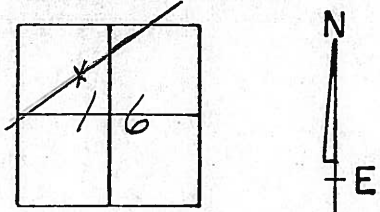

P.O.T. 108+50

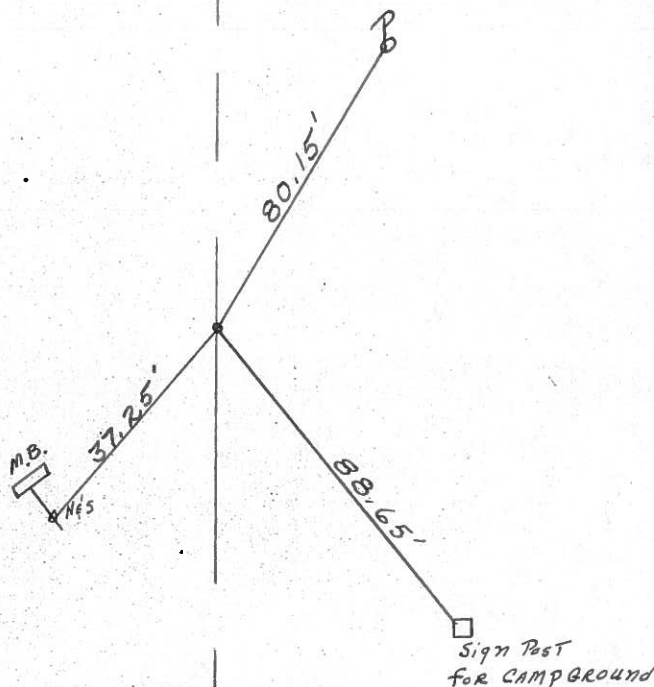

Date 6-26-79

Weather Fair

Temp. 75°

T₃N, R₁₆E



Personnel Schneider

Mosser

Barbour

Barbour

50

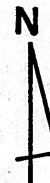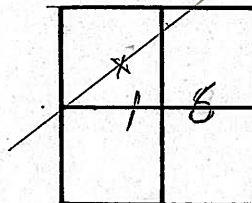

~~476~~

P. O. T.

 $108 + 50$

R. R. Spk. on £ R/w

R.K. Sp. 1.7' Lt. of £
2" down

Reset P.K. Nail

\$ S.R. # 101

48.02'

$$80.611$$

67.78

411

"stop" po
for dri

fence Posts

sign for
campground

PERSONNEL TITLE PERSONNEL TITLE

COUNTY Seneca DATE 2-11-64

Krehill

Kowaleski

Geyman

Bruggeman

S. R. # 101

WEATHER

SEC.

TEMP.

DESCRIPTION S.R. # 101 Tiffin to Sen. Co. Line

JOB NO.

LEFT

CENTER LINE


RIGHT

50

STA. 108+50

Hub

400

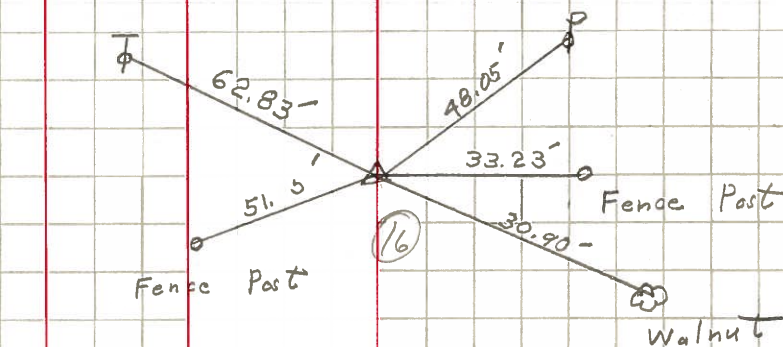


51

STA. 116+00

P.K.

401

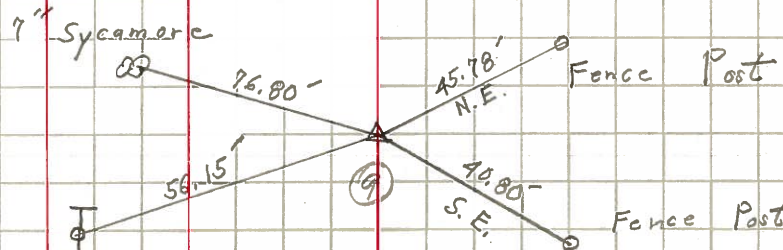


52

STA. 122+00

P.K.

402

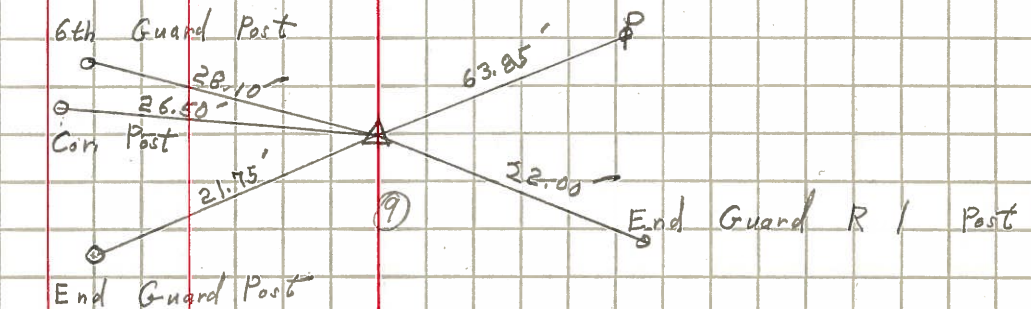


53

STA. 127+00

P.K.

403

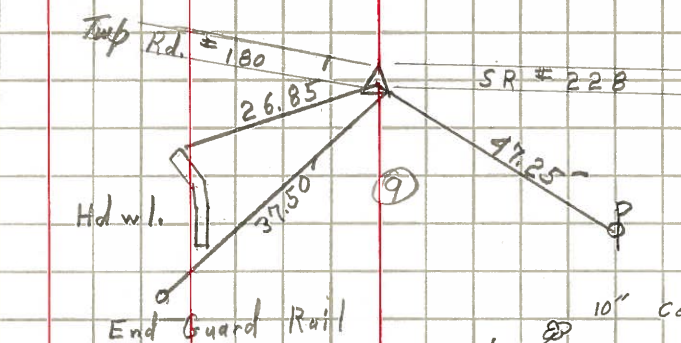

54

STA. 129+50

Iron Pin

404

