

O.D.O.T. DISTRICT 2 SURVEY OFFICE (USE ONLY)

PERSONNEL

REFERENCE NO. 51

SHEET 28 OF 46

NOTES MILLER

DATE 8/7/24

ROUTE SR 101

H.C. MILLER

WEATHER WINDY

COUNTY SENECA

R.C. BARRIERE

TEMP. 70°F

TOWNSHIP ADAMS

BLUBAUGH, ASTON, PRESTON-COLVIN

SECTION 9

DWG BY BLUBAUGH

PID 114849

T 3 N R 16 E

TYPE MONUMENT MAG/WASHER

ON SURFACE - ~~BELOW~~ 0.5"

OFFSET $\mathcal{C}$ PAVEMENT 2.3' LT : ~~RT~~

-- TO -- EDGE PAVEMENT

STATION: 625+83

HORIZ.DATUM: NAD83 (2011)


GEOID: NAVD88-2018

GRID: NORTHING: 569400.120


EASTING: 1824671.138

LDP: NORTHING: 338448.321

EASTING: 199005.990

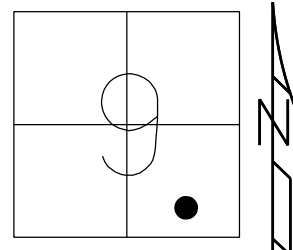

RECORD: P.O.T.
STA. 116+00
FD P.K. NAIL
ATOP R.R. SPIKE
SET SQ HEADED
NAIL/SHINER
8/28/90
FD SQ. HEADED
NAIL/WASHER
2/7/05, SAH
REF51
7/28/09, DCH
SET MAG/WASHER
NEWREF51
10-06-09, DH
FD MAG/WASHER
REF51
6/14/16
9/19/17, JFO
FD MAG/WASHER
REF51
12/13/23, JAM
FD TONE. DID NOT
UNCOVER. PAINTED
8/7/24, JAM

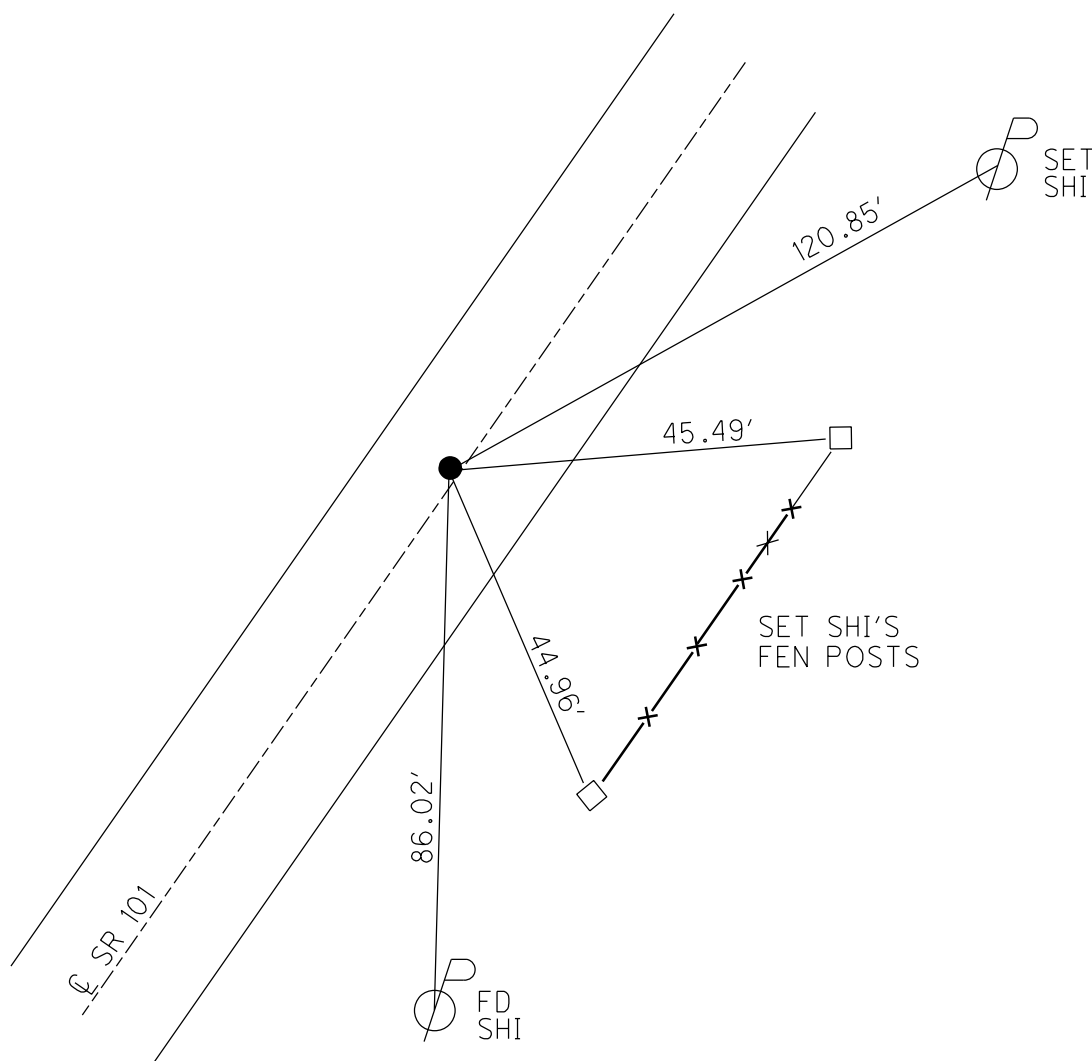

O.D.O.T. DISTRICT 2 SURVEY OFFICE (USE ONLY)

PERSONNEL

REFERENCE NO. 51

SHEET 29 OF 46

NOTES HOMAN

DATE 7-21-09

ROUTE SR 101

H.C. HOMAN

WEATHER SUNNY

COUNTY SENECA

R.C. ROUSOS

TEMP. 85°F

TOWNSHIP ADAMS

SECTION 9

DWG BY MAHLER

PID 100787

T 3 N R 16 E

TYPE MONUMENT SQ HEADED NAIL/WASHER

ON SURFACE - ~~BELOW~~ ON

OFFSET CL PAVEMENT 2.3' LT : ~~RT~~

- TO - EDGE PAVEMENT


STATION: 625+83

HORIZ.DATUM: NAD83 (2011)

GEOID: NAVD88-2012A


GRID: NORTHING: 569400.120

EASTING: 1824671.138

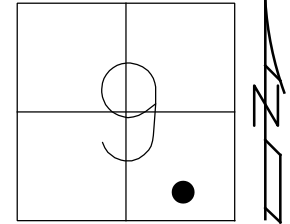

RECORD: P.O.T.
STA. 116+00
FD P.K. NAIL
ATOP R.R. SPIKE
SET SQ HEADED
NAIL/SHINER
8/28/90
FD SQ.HEADED
NAIL/WASHER
2/7/05, SAH
REF51
7/28/09, DCH
SET MAG/WASHER
NEWREF51
10-06-09, DH
FD MAG/WASHER
REF51
6/14/16
9/19/17, JFO

SIGN POST
COMMERCIAL-IND.
BUILDING MAINT.
SIGN

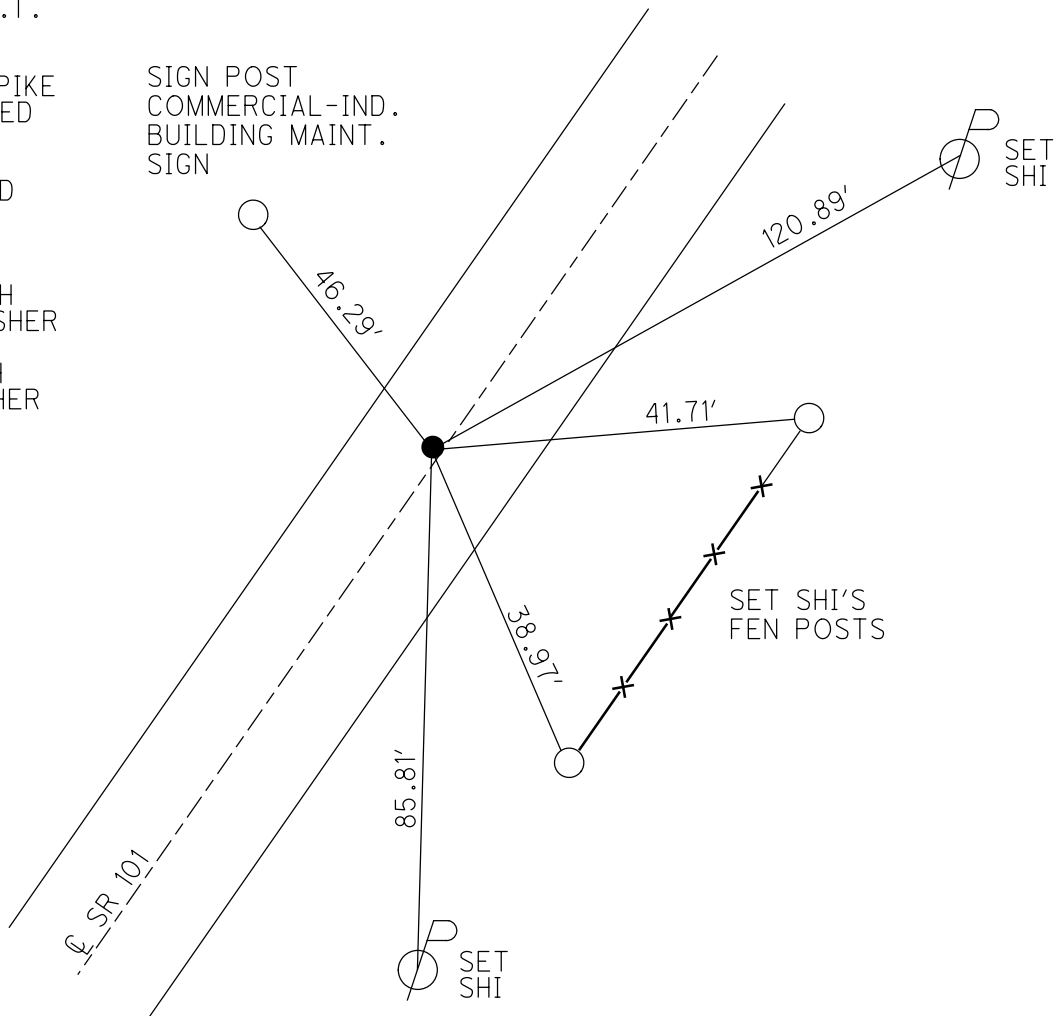

O.D.O.T. DISTRICT 2 SURVEY OFFICE (USE ONLY)

PERSONNEL

REFERENCE NO. 51

SHEET 29 OF 46

NOTES HOMAN

DATE 7/21/09

ROUTE SR 101

H.C. HOMAN

WEATHER SUNNY

COUNTY SENECA

R.C. ROUSOS

TEMP. 85°

TOWNSHIP ADAMSSECTION 9

T_3_N R_16_E

TYPE MONUMENT SQ HEADED NAIL/WASHER


ON SURFACE - ~~BELOW~~ ON _____

LEFT - C PAV'T - ~~RIGHT~~ 2.3'


____-____TO____-____EDGE PAVEMENT

S.L.M. 625+83

GRID: NORTHING: 569400.120 EASTING: 1824671.138

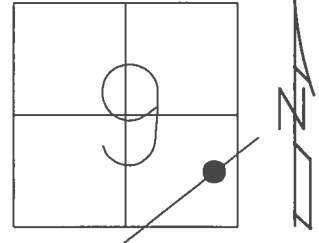

RECORD: P.O.T.
STA. 116+00
FD P.K. NAIL ATOP
R.R. SPIKE
SET SQ HEADED
NAIL/SHINER
8/28/90
FD SQ. HEADED
NAIL/WASHER
2/7/05, SAH
SET MAG/WASHER
10-06-09, DH
FD MAG/WASHER
REF51
6/14/16, JFO
UNCOVERED
9/19/17, JFO

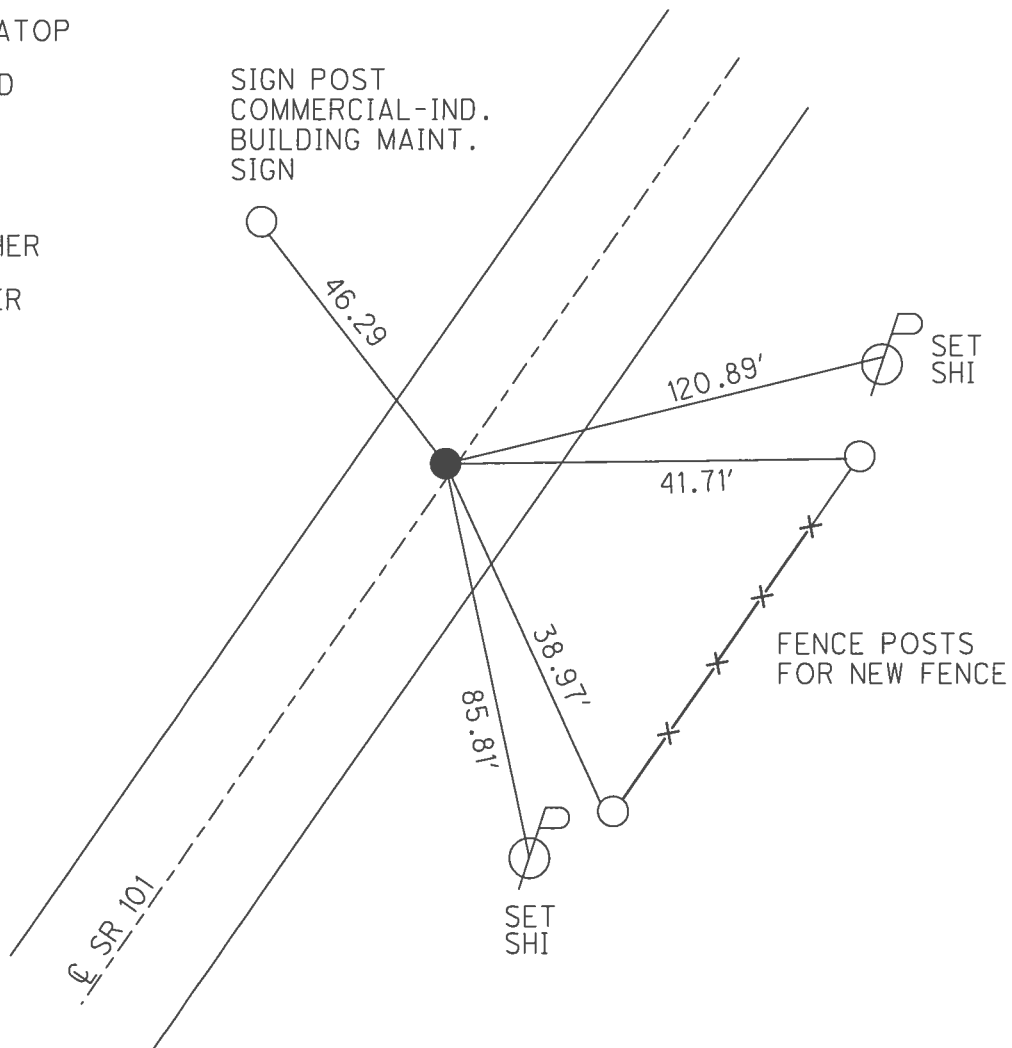


O.D.O.T. DISTRICT 2 SURVEY OFFICE (USE ONLY)


PERSONNEL _____ REFERENCE NO. 51 SHEET 29 OF 46
 NOTES HOMAN DATE 7/21/09 ROUTE SR 101
 H.C. HOMAN WEATHER SUNNY COUNTY SENECA
 R.C. ROUSOS TEMP. 85° TOWNSHIP ADAMS
 _____ SECTION 9
 _____ T 3 N R 16 E

TYPE MONUMENT SQ HEADED NAIL/WASHER
 ON SURFACE - ~~BELOW~~ ON
 LEFT - ℄ PAV'T - ~~RIGHT~~ 1'
 - TO - EDGE PAVEMENT
 S.L.M. 625+83

GRID: NORTHING: 569400.146 EASTING: 1824671.130

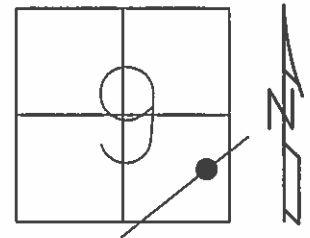

RECORD: P.O.T.
 STA. 116+00
 FD P.K. NAIL ATOP
 R.R. SPIKE
 SET SQ HEADED
 NAIL/SHINER
 8/28/90
 FD SQ HEADED
 NAIL/WASHER
 2/7/05, SAH
 SET MAG/WASHER
 10-06-09, DH

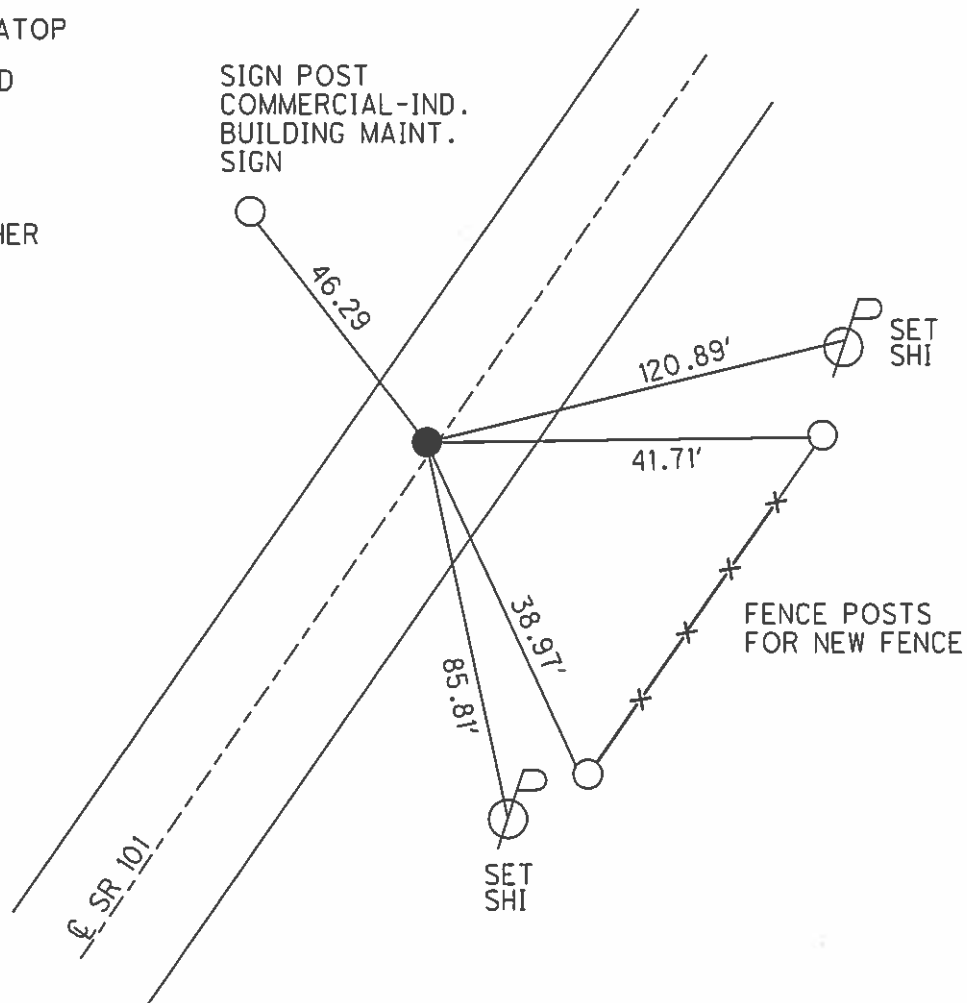

O.D.O.T. DISTRICT 2 SURVEY OFFICE

PERSONNEL

REFERENCE NO. 51

SHEET 26 OF 41

NOTES RIPPLE

H.C. BARBOUR

R.C. GEYMAN

DATE 8/28/90

WEATHER SUNNY

TEMP. 86°

ROUTE S.R. #101

COUNTY SENECA

TOWNSHIP ADAMS

SECTION 9

T 3 N R 16 E


TYPE MONUMENT SET SQUARE HEADED NAIL & SHINER

ON SURFACE - BELOW PK. NAIL AT TOP RR SPIKE


LEFT - 1' LT. & PAV'T.

TO EDGE PAVEMENT

S.L.M. _____

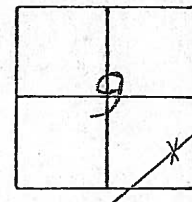


625 + 83

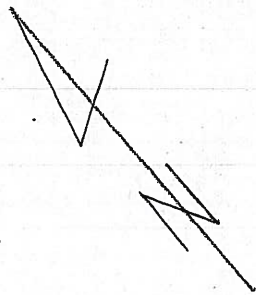

46.29'
CAMP SENECA
Sign Post

Commercial-Indo
Build. Maint
Sign

P.O.T. 116+00

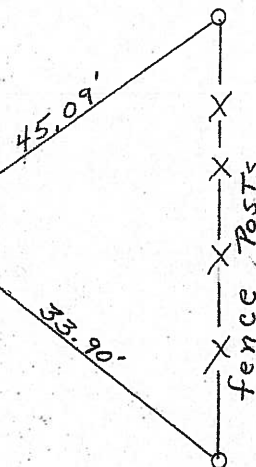

Fd
2-7-05
SAH

O.D.O.T. DISTRICT 2 SURVEY OFFICE

PERSONNEL

REFERENCE NO. 51

SHEET 26 OF 41

NOTES RIPPLE

H.C. BARBOUR

R.C. GEYMAN

DATE 8/28/90

WEATHER SUNNY

TEMP. 86°

ROUTE S.R. #101

COUNTY SENECA

TOWNSHIP ADAMS

SECTION 9

T 3 N R 16 E


TYPE MONUMENT Set Square Headed Nail & shiner

ON SURFACE - BELOW P.K. Nail A Top R.R. spike

LEFT - 1' LT. & Pav't.

TO EDGE PAVEMENT


S.L.M. _____

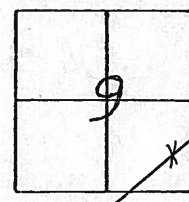

46.29'
CAMP Seneca
Sign Post

45.09'



33.90'

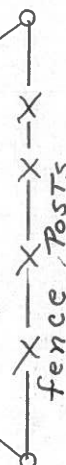


P.O.T. 116+00

O.D.O.T. DISTRICT 2 SURVEY OFFICE

Sht. ___ of ___

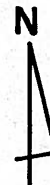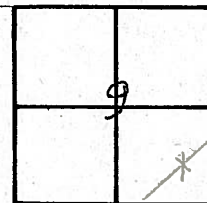County Seneca S.R. # 101Township AdamsSection 9T 3 N, R 16 EPersonnel SchneiderMosserBarbourDate 6-26-79Weather FairTemp. 75°

(51)

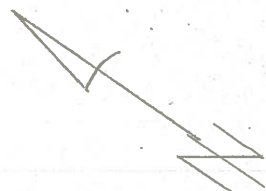~~#48~~

S.R. # 101


P.O.T.

116+00

R.R. spk. on & R/W

1.3' Lt. of &

Reset P.K. Nail

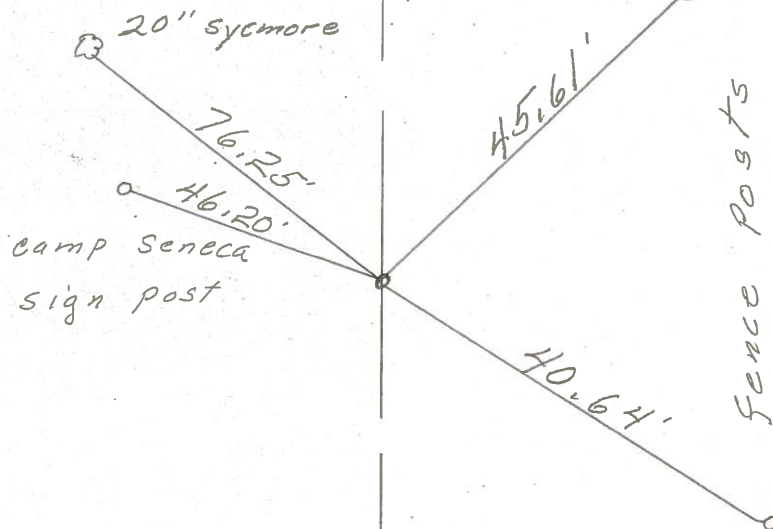

PERSONNEL TITLE PERSONNEL TITLE

COUNTY Seneca

DATE 2-11-64

Krehill

Kowaleski

Geyman

Bruggeman

S. R. # 101

WEATHER

SEC.

TEMP.

DESCRIPTION S.R. # 101 Tiffin to Sen. Co. Line

JOB NO.

LEFT

CENTER LINE


RIGHT

50

STA. 108+50

Hub

400

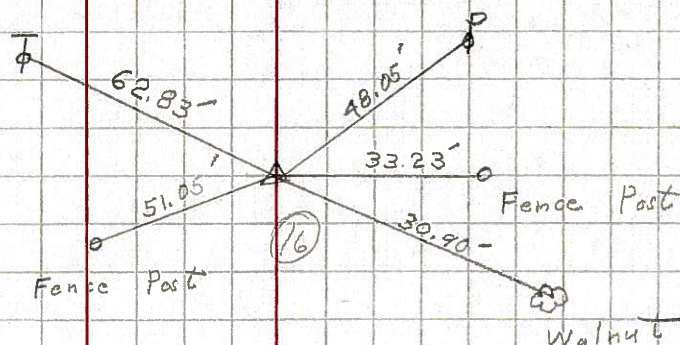


51

STA. 116+00

P.K.

401

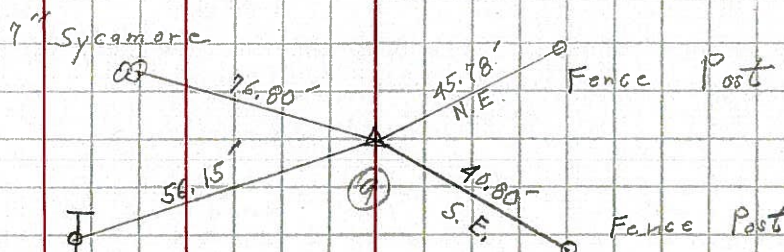


52

STA. 122+00

P.K.

402

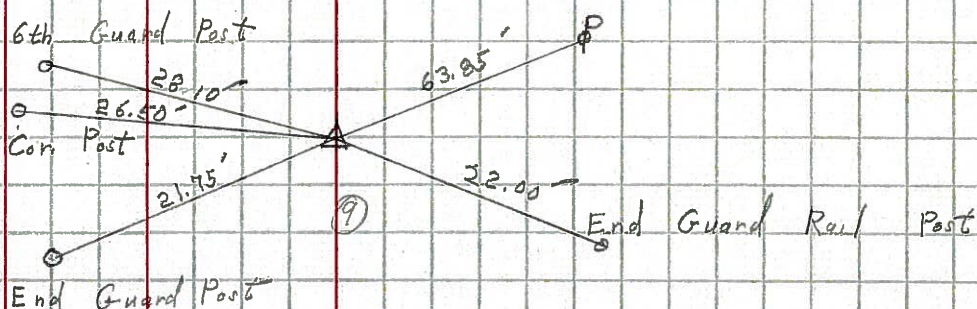


53

STA. 127+00

P.K.

403

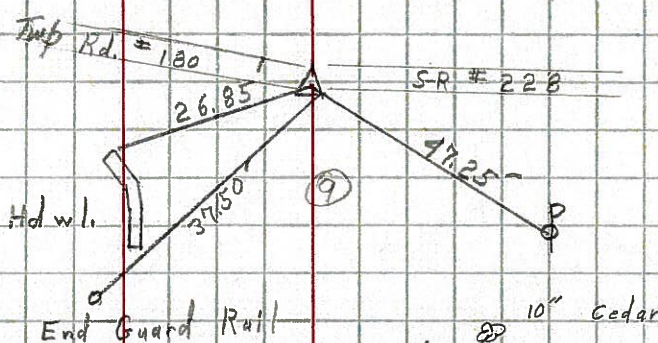

54

STA. 129+50

Iron Pin

404

