

O.D.O.T. DISTRICT 2 SURVEY OFFICE (USE ONLY)

PERSONNEL

REFERENCE NO. 52

SHEET 30 OF 46

NOTES MILLER

DATE 8/7/24

ROUTE SR 101

H.C. MILLER

WEATHER WINDY

COUNTY SENECA

R.C. BARRIERE

TEMP. 70°F

TOWNSHIP ADAMS

BLUBAUGH, ASTON, PRESTON-COLVIN

SECTION 9

DWG BY BLUBAUGH

PID 114849

T 3 N R 16 E

TYPE MONUMENT MONBOX W/1" IPIN

ON SURFACE - ~~BELOW~~ ON

OFFSET Q PAVEMENT 1.5' ~~LT~~ : RT

-- TO -- EDGE PAVEMENT

STATION: 631+83

HORIZ.DATUM: NAD83 (2011)


GEOID: NAVD88-2018

GRID: NORTHING: 569781.799


EASTING: 1825133.241

LDP: NORTHING: 338833.448

EASTING: 199465.164

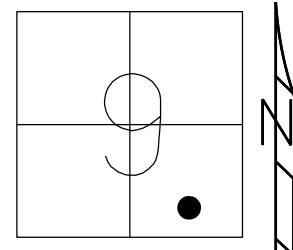

RECORD: P.O.T.
STA. 122+00
FD P.K. NAIL
ATOP R.R. SPIKE
SET SQ. HEADED
NAIL/SHINER
8/28/90, BARBOUR
FD MONBOX
W/PUNCH HOLE
2/7/05, SAH
REF53
7/21/09, DCH
FD MONBOX
W/ 1" IPIN
REF52
6/14/16
9/19/17, JFO
FD MONBOX
W/1" IPIN
REF52
12/13/23, JAM
FD MONBOX.
UNDISTURBED
8/7/24, JAM

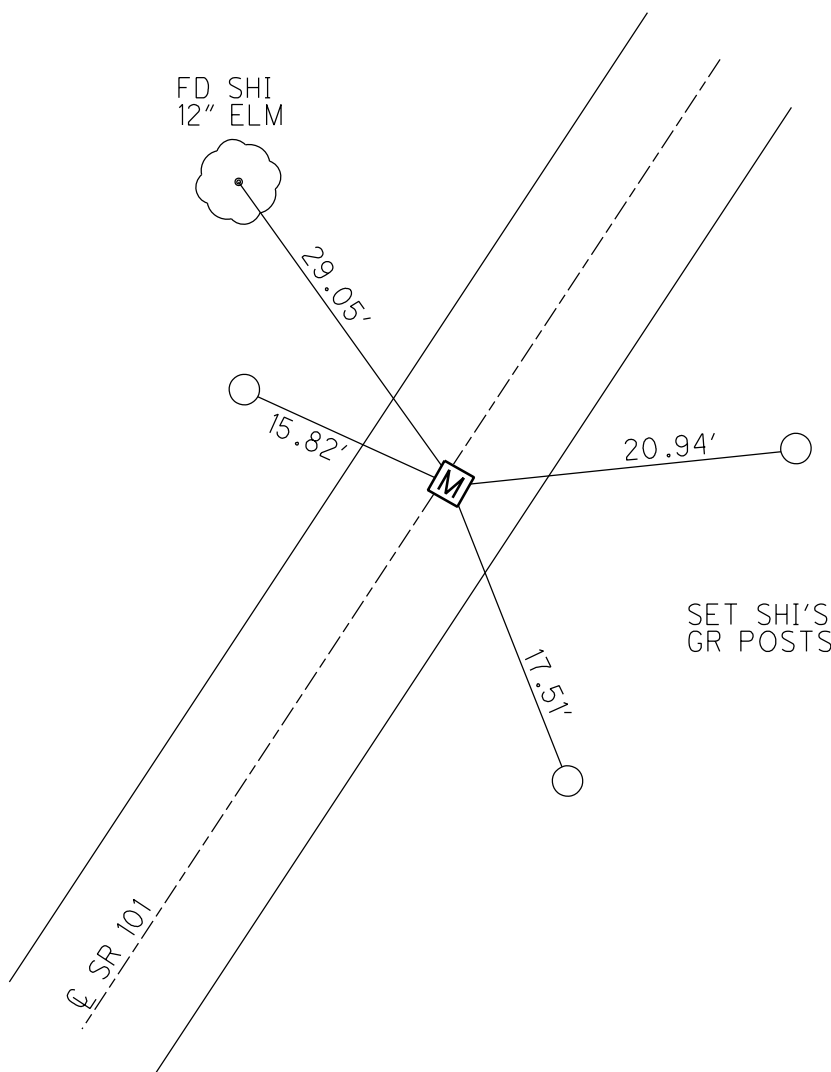

O.D.O.T. DISTRICT 2 SURVEY OFFICE (USE ONLY)

PERSONNEL

REFERENCE NO. 52

SHEET 30 OF 46

NOTES HOMAN

DATE 7-21-09

ROUTE SR 101

H.C. HOMAN

WEATHER SUNNY

COUNTY SENECA

R.C. ROUSOS

TEMP. 85°F

TOWNSHIP ADAMS

SECTION 9

DWG BY MAHLER

PID 100787

T 3 N R 16 E

TYPE MONUMENT MONBOX W/ 1" IPIN

ON SURFACE - ~~BELOW~~ ON

OFFSET CL PAVEMENT 1.5' LT : RT

- TO - EDGE PAVEMENT


STATION: 631+83

HORIZ.DATUM: NAD83 (2011)


GEOID: NAVD88-2012A

GRID: NORTHING: 569781.799

EASTING: 1825133.241

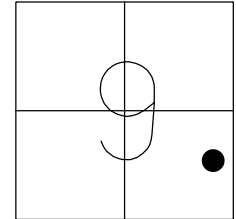

RECORD: P.O.T.
STA. 122+00
FD P.K. NAIL
ATOP R.R. SPIKE
SET SQ. HEADED
NAIL/SHINER
8/28/90, BARBOUR
FD MONBOX
W/PUNCH HOLE
2/7/05, SAH
REF53
7/21/09, DCH
FD MONBOX
W/ 1" IPIN
REF52
6/14/16
9/19/17, JFO

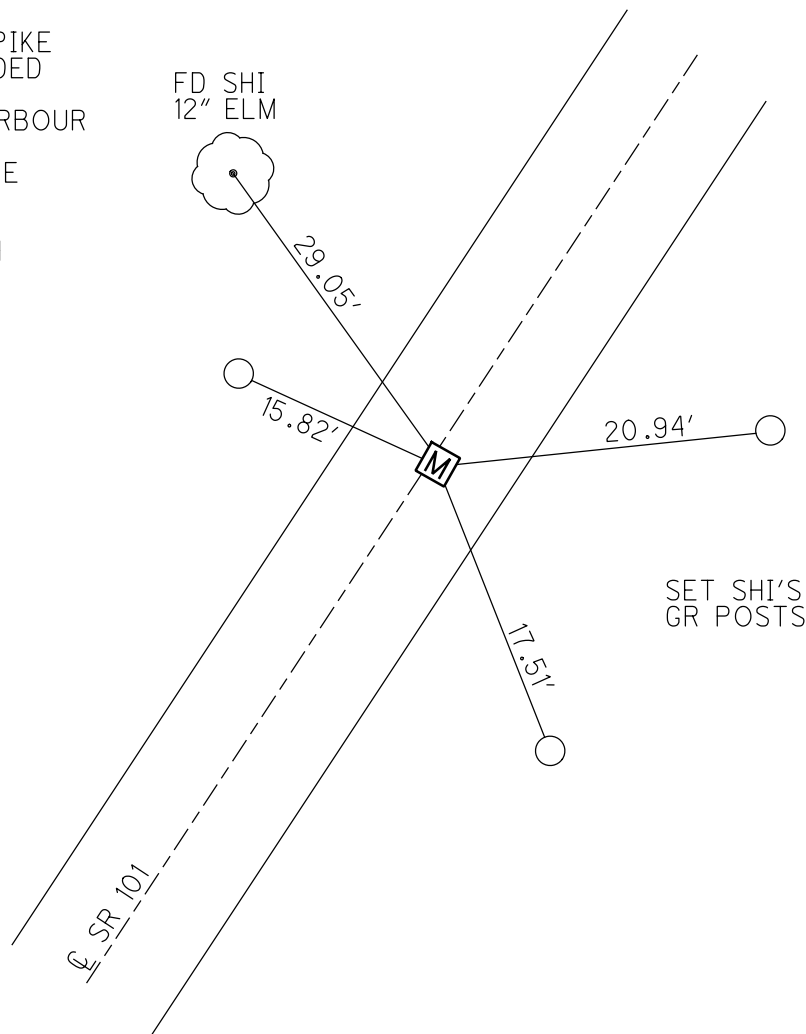


O.D.O.T. DISTRICT 2 SURVEY OFFICE (USE ONLY)

REFERENCE NO. 52 SHEET 30 OF 46


NOTES	<u>HOMAN</u>	DATE <u>7/21/09</u>	ROUTE <u>SR 101</u>
H.C.	<u>HOMAN</u>	WEATHER <u>SUNNY</u>	COUNTY <u>SENECA</u>
R.C.	<u>ROUSOS</u>	TEMP. <u>85°</u>	TOWNSHIP <u>ADAMS</u>
			SECTION <u>9</u>
			T <u>3</u> N R <u>16</u> E

TYPE MONUMENT MONBOX W/ 1" IPIN
 ON SURFACE - ~~BELOW~~ ON
~~LEFT~~ - ℄ PAV'T - RIGHT 1.0'
- TO - EDGE PAVEMENT
 S.L.M. 631+83

GRID: NORTHING: 569781.799 EASTING: 1825133.241

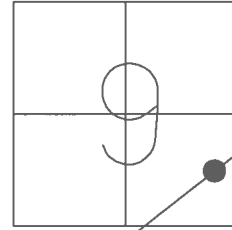

RECORD: P.O.T.
 STA. 122+00
 FD P.K. NAIL ATOP
 R.R. SPIKE
 SET SQ. HEADED
 NAIL/SHINER
 8/28/90
 FD MONBOX
 2/7/05, SAH
 FD MONBOX
 W/ 1" IPIN
 REF52
 6/14/16, JFO
 UNCOVERED
 9/19/17, JFO

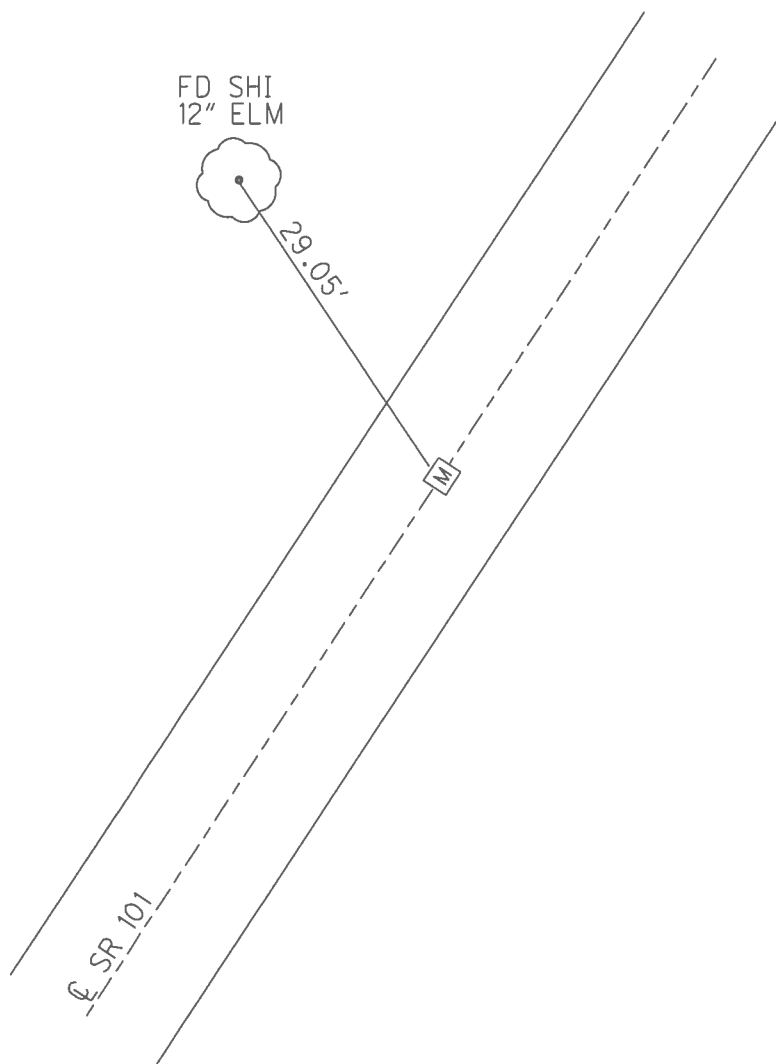


O.D.O.T. DISTRICT 2 SURVEY OFFICE (USE ONLY)

REFERENCE NO. 52 SHEET 30 OF 46


NOTES	HOMAN	DATE	7/21/09	ROUTE	SR 101
H.C.	HOMAN	WEATHER	SUNNY	COUNTY	SENECA
R.C.	ROUSOS	TEMP.	85°	TOWNSHIP	ADAMS
				SECTION	9
				T	3 N R 16 E

TYPE MONUMENT MONBOX W/PUNCH HOLE
ON SURFACE - ~~BELOW~~ ON
~~LEFT~~ - C PAV'T - RIGHT 1.5'
- TO - EDGE PAVEMENT
S.L.M. 631+83

GRID: NORTHING: 510102.828 EASTING: 1825507.282

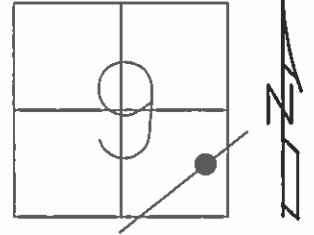

RECORD: P.O.T.
STA. 122+00
FD P.K. NAIL ATOP
R.R. SPIKE
SET SQ. HEADED
NAIL/SHINER
8/28/90
FD MONBOX
2/7/05, SAH

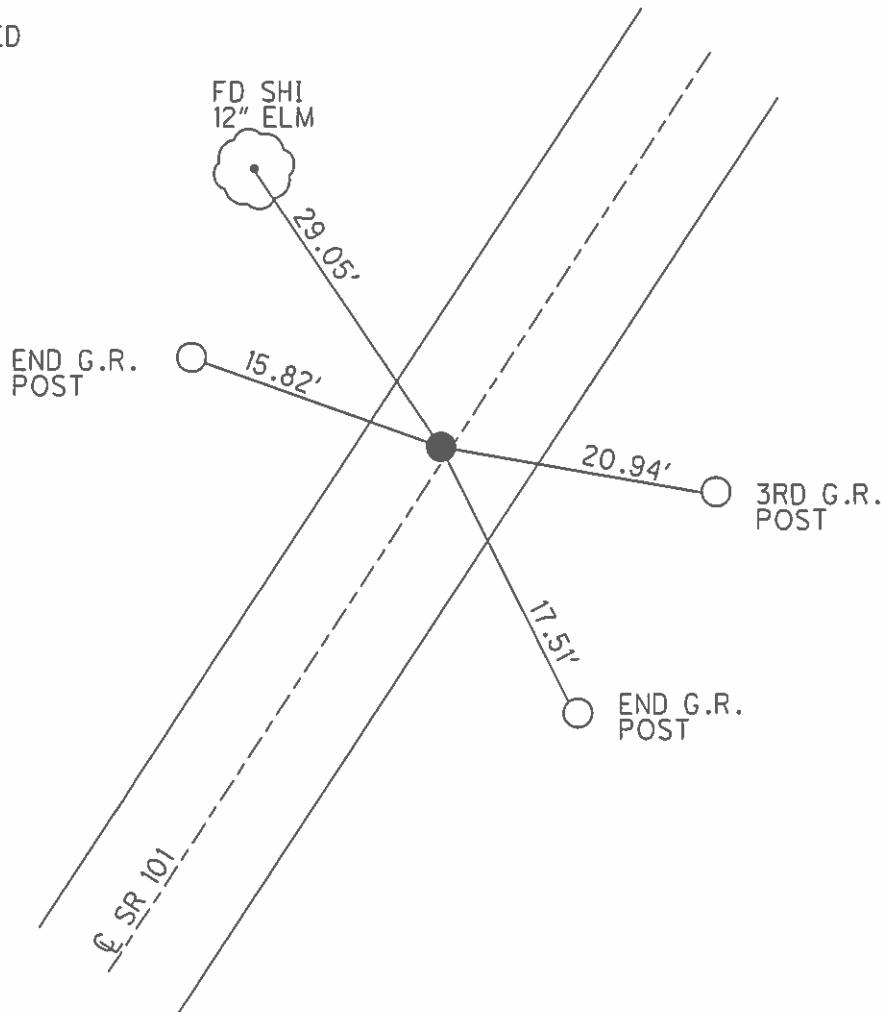

O.D.O.T. DISTRICT 2 SURVEY OFFICE

PERSONNEL

REFERENCE NO. 52

SHEET 27 OF 41

NOTES RIPPLE

H.C. BARBOUR

R.C. GEYMAN

DATE 8/28/90

WEATHER SUNNY

TEMP. 86°

ROUTE SR. #101

COUNTY SENECA

TOWNSHIP ADAMS

SECTION 9

T. 3 N R. 16 E


TYPE MONUMENT Set Square Headed Nail & Shiner

ON SURFACE - BELOW PK. Nail at Top RR. Spike

LEFT - CL PAV'T. - RIGHT 1.5' RT. CL PAV'T.

TO EDGE PAVEMENT

S.L.M. _____

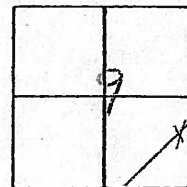


631+83

Mon Box

Fd

2-2-05

SAH

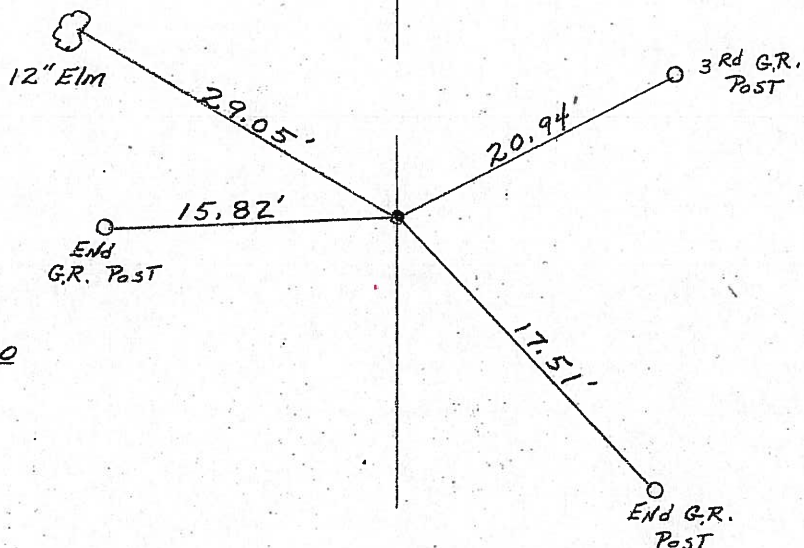

O.D.O.T. DISTRICT 2 SURVEY OFFICE

PERSONNEL

REFERENCE NO. 52

SHEET 27 OF 41

NOTES RIPPLE

H.C. BARBOUR

R.C. BEYMAN

DATE 8/28/90

WEATHER SUNNY

TEMP. 86°

ROUTE SR. #101

COUNTY SENECA

TOWNSHIP ADAMS

SECTION 9

T.3 N R. 16 E


TYPE MONUMENT Set Square Headed Nail & shiner

ON SURFACE - BELOW P.K. Nail A Top RR. spike

LEFT - CL PAV'T. - RIGHT 1.5' RT. & PAV'T.

TO EDGE PAVEMENT

S.L.M.

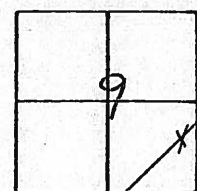

12" Elm

29.05'

15.82'

END
G.R. Post

20.94'

3rd G.R.
Post

17.51'

END G.R.
Post

P.O.T. 122+00

Q.D.O.T. DISTRICT 2 SURVEY OFFICE

Sht. of

County Seneca S.R. # 101

Township Adams

Section 9

T 3 N, R 16 E

Personnel Schneider

Mosser



Barbour

Date 6-26-79

Weather Fair

Temp. 75°

(52)

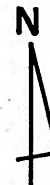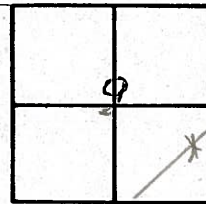

~~48A~~




P.O.T.

122+00

R.R. spk. on & R/W

2 1/2" down

Reset P.K. Nail

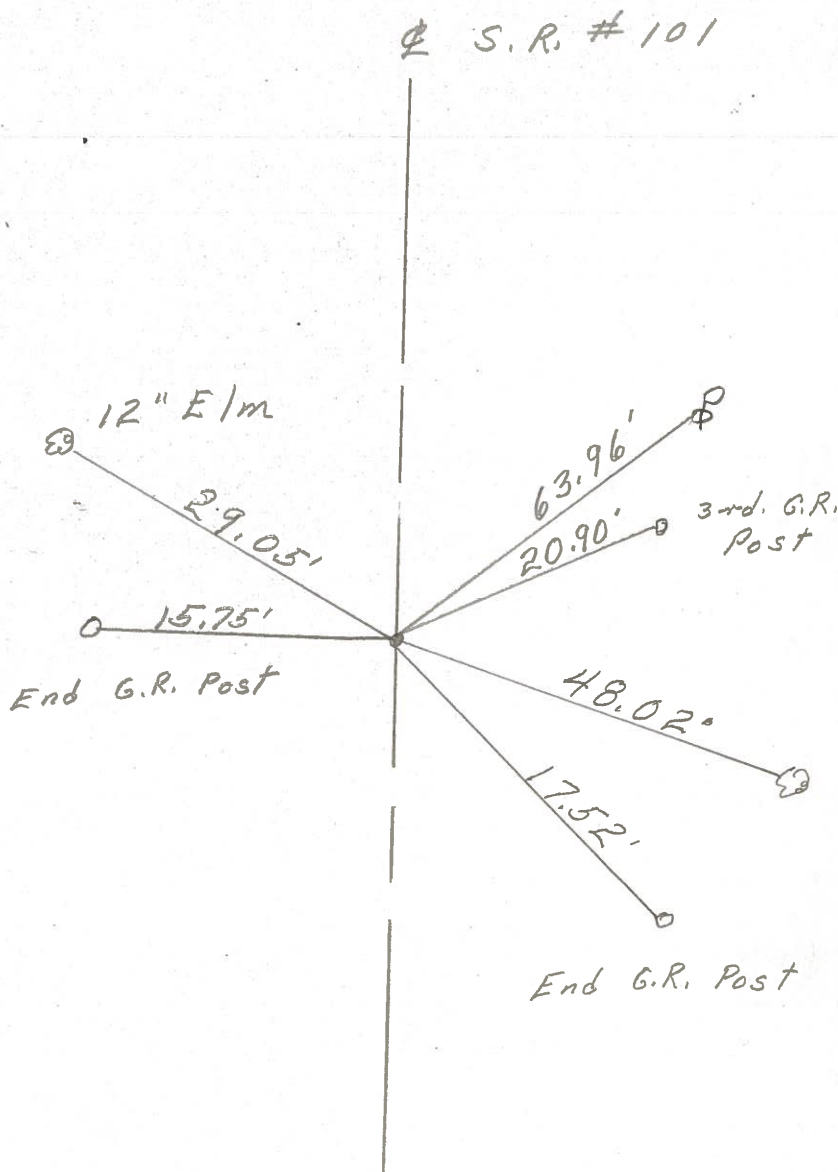

PERSONNEL TITLE PERSONNEL TITLE

COUNTY Seneca

DATE 2-11-64

Krehill

Kowaleski

S. R. # 101

WEATHER

Geyman

SEC.

TEMP.

Bruggeman

DESCRIPTION S.R. #101 Tiffin to Sen. Co. Line

JOB NO.

LEFT


CENTER LINE

RIGHT

50

STA. 108+50
Hub


400

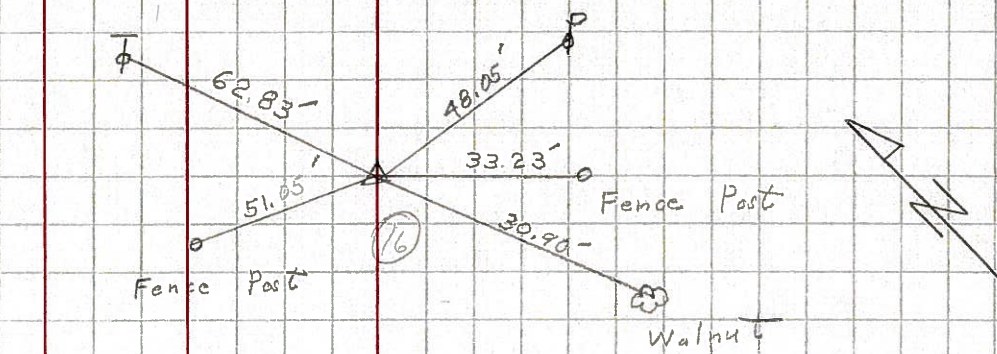

51

STA. 116+00
P.K.


401

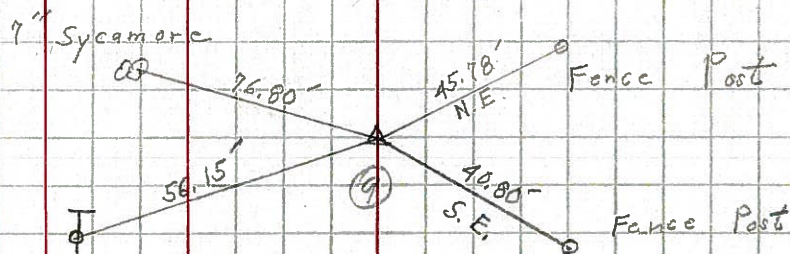

52

STA. 122+00
P.K.


402

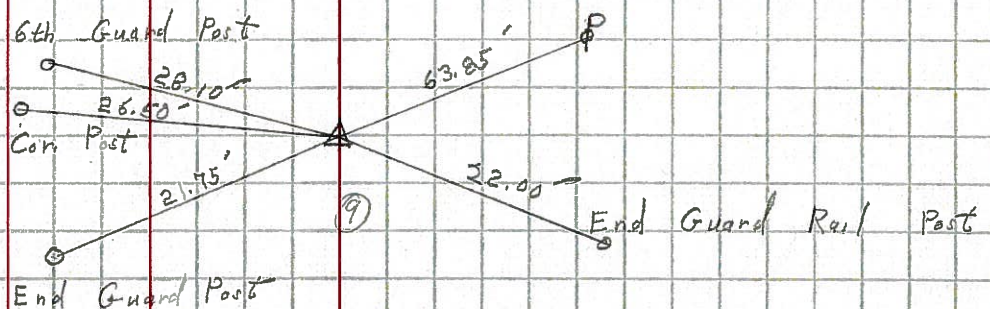

53

STA. 127+00
P.K.

403

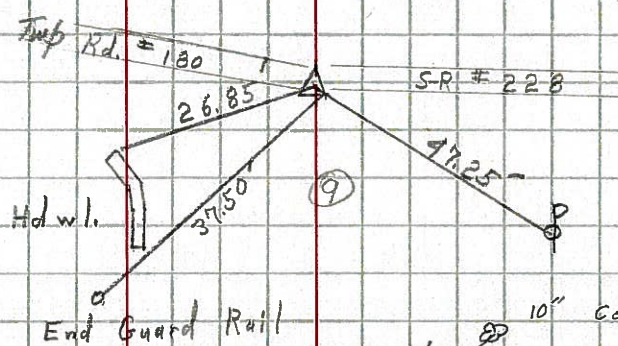

54

STA. 129+50
Iron Pin

404

