

# O.D.O.T. DISTRICT 2 SURVEY OFFICE (USE ONLY)

PERSONNEL

REFERENCE NO. 58

SHEET 37 OF 46

NOTES MILLER  
H.C. MILLER  
R.C. BARRIERE

DATE 8/7/24  
WEATHER SUNNY  
TEMP. 70°F

ROUTE SR 101  
COUNTY SENECA  
TOWNSHIP ADAMS  
SECTION 10

BLUBAUGH, ASTON, PRESTON-COLVIN

DWG BY BLUBAUGH PID 114849

T 3 N R 16 E

TYPE MONUMENT MAG/WASHER

~~ON SURFACE~~ - BELOW 0.5"

OFFSET  $\odot$  PAVEMENT ON LT : RT

-- TO -- EDGE PAVEMENT

STATION: 682+94

HORIZ.DATUM: NAD83 (2011)


GEOID: NAVD88-2018

GRID: NORTHING: 573073.894


EASTING: 1829032.964

LDP: NORTHING: 342154.849

EASTING: 203340.608

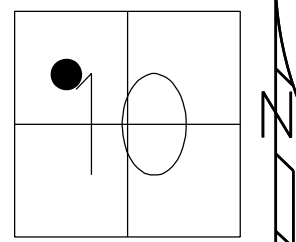

RECORD:  
STA. 173+68.3  
FD R.R. SPIKE  
4" DOWN  
SET P.K./WASHER  
8/29/90, DCH  
FD P.K./WASHER  
REF58  
7/8/09, DCH  
SET MAG/WASHER  
NEWREF58  
10-06-09, DH  
FD MAG/WASHER  
REF58  
6/15/16  
9/19/17, JFO  
FD MAG/W  
REF58  
12/12/23, TDN  
FD TONE. DID NOT  
UNCOVER. PAINTED  
8/7/24, JAM

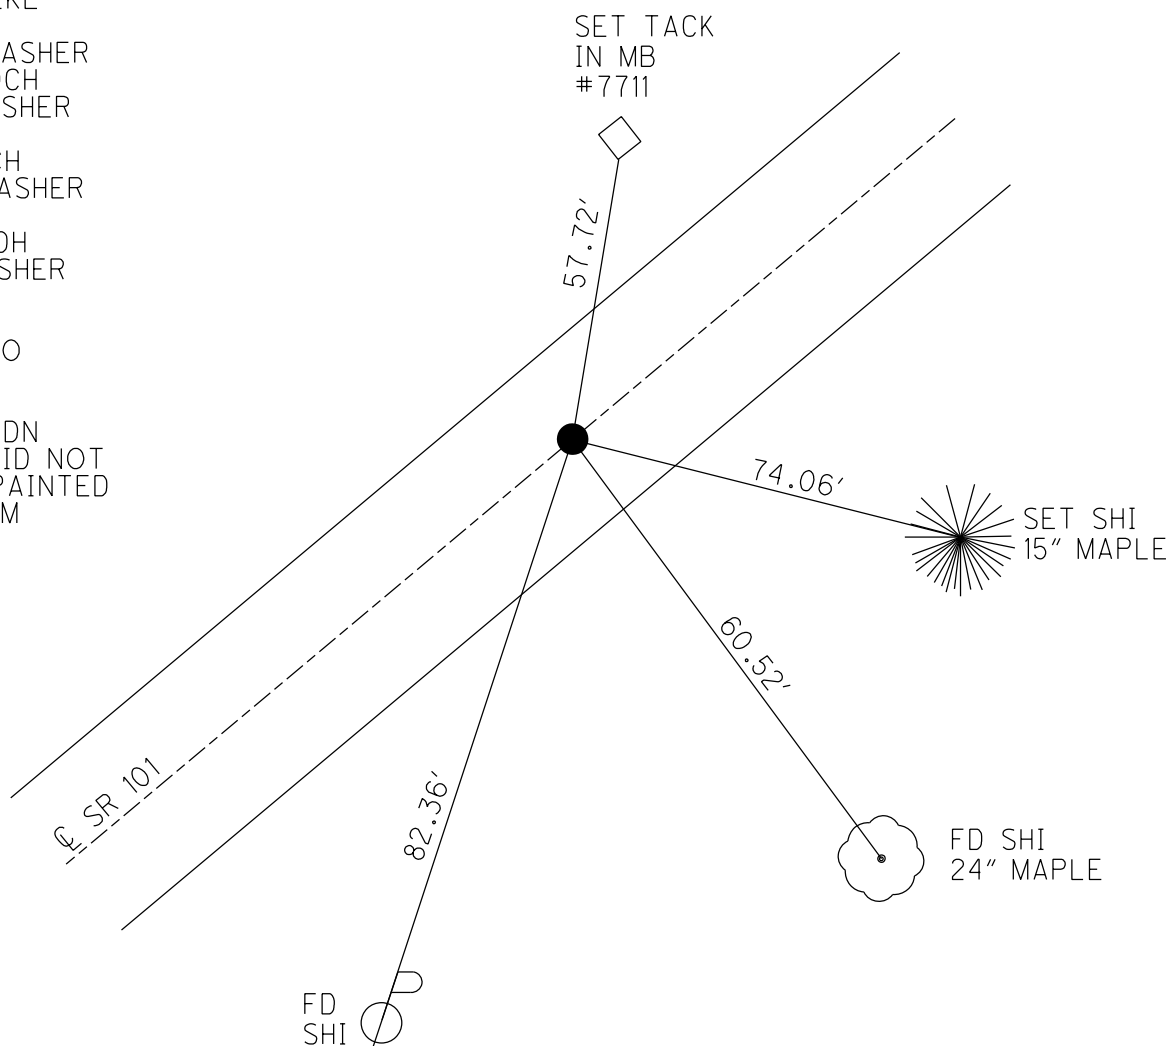

O.D.O.T. DISTRICT 2 SURVEY OFFICE (USE ONLY)

PERSONNEL

REFERENCE NO. 58

SHEET 37 OF 46

NOTES HOMAN

DATE 7-8-09

ROUTE SR 101

H.C. HOMAN

WEATHER SUNNY

COUNTY SENECA

R.C. ROUSOS

TEMP. 80°F

TOWNSHIP ADAMS

DWG BY MAHLER PID 100787

SECTION 10

T 3 N R 16 E

TYPE MONUMENT P.K./WASHER

~~ON SURFACE~~ - BELOW 1 1/2"

OFFSET Q PAVEMENT ON LT : RT

- TO - EDGE PAVEMENT


STATION: 682+94

HORIZ.DATUM: NAD83 (2011)


GEOID: NAVD88-2012A

GRID: NORTHING: 573073.894

EASTING: 1829032.964

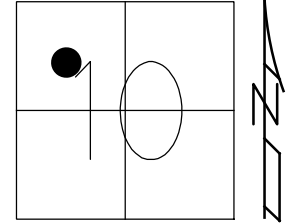

RECORD:  
STA. 173+68.3  
FD R.R. SPIKE  
4" DOWN  
SET P.K./WASHER  
8/29/90, DCH  
FD P.K./WASHER  
REF58  
7/8/09, DCH  
SET MAG/WASHER  
NEWREF58  
10-06-09, DH  
FD MAG/WASHER  
REF58  
6/15/16  
9/19/17, JFO

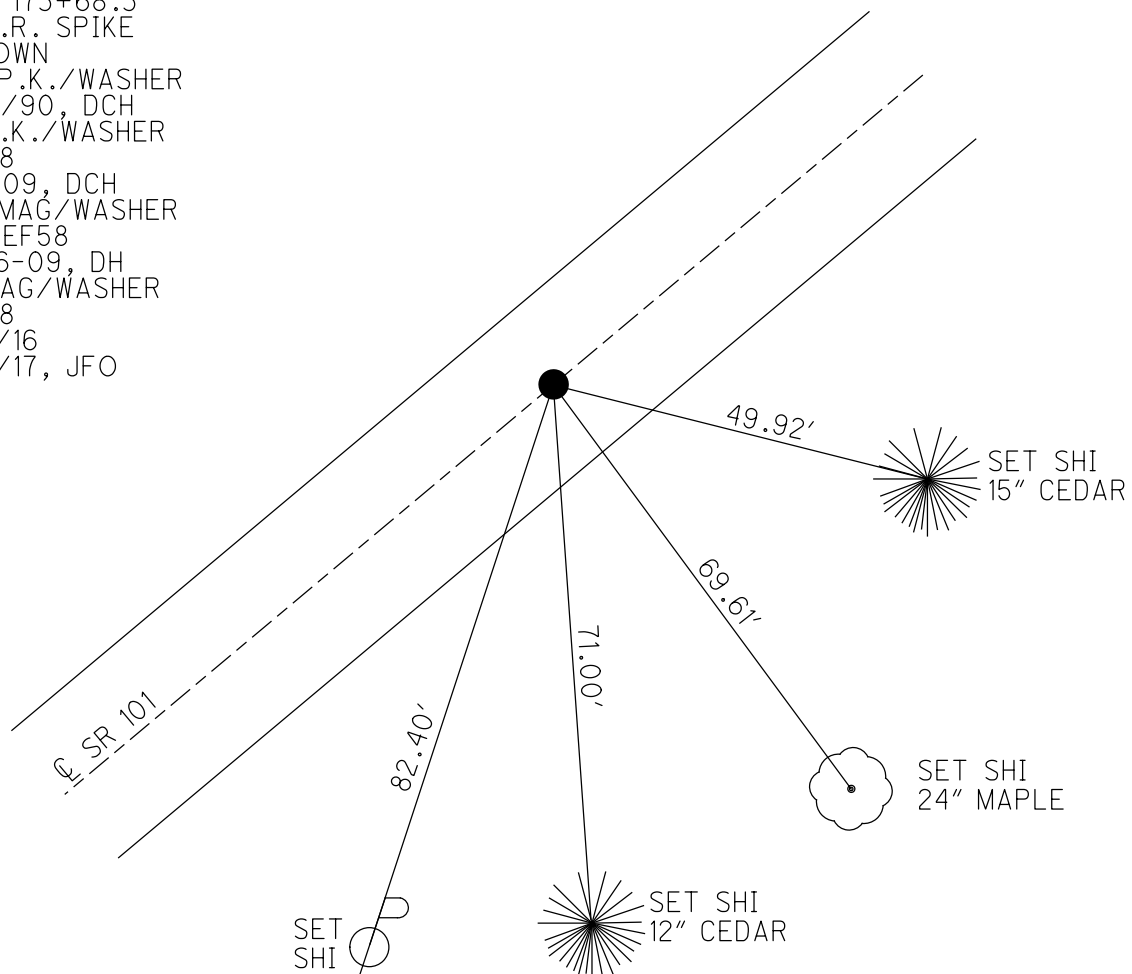


# O.D.O.T. DISTRICT 2 SURVEY OFFICE (USE ONLY)


|                    |                         |                              |
|--------------------|-------------------------|------------------------------|
| PERSONNEL          | REFERENCE NO. <u>58</u> | SHEET <u>37</u> OF <u>46</u> |
| NOTES              | DATE <u>7/08/09</u>     | ROUTE <u>SR 101</u>          |
| H.C. <u>HOMAN</u>  | WEATHER <u>SUNNY</u>    | COUNTY <u>SENECA</u>         |
| R.C. <u>ROUSOS</u> | TEMP. <u>80°</u>        | TOWNSHIP <u>ADAMS</u>        |
|                    |                         | SECTION <u>10</u>            |
|                    |                         | T <u>3</u> N R <u>16</u> E   |

TYPE MONUMENT P.K./WASHER  
~~ON SURFACE~~ - BELOW 1 1/2"  
 LEFT - C PAV'T - RIGHT ON  
- TO - EDGE PAVEMENT  
 S.L.M. 682+94

GRID: NORTHING: 573073.894 EASTING: 1829032.964

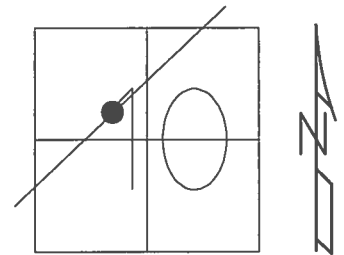

RECORD:  
 STA. 173+68.3  
 FD R.R. SPIKE  
 4" BELOW  
 SET P.K./WASHER  
 8/29/90  
 RESET MAG/WASHER  
 10-06-09, DH  
 FD MAG/WASHER  
 REF58  
 6/15/16, JFO  
 UNCOVERED  
 9/19/17, JFO

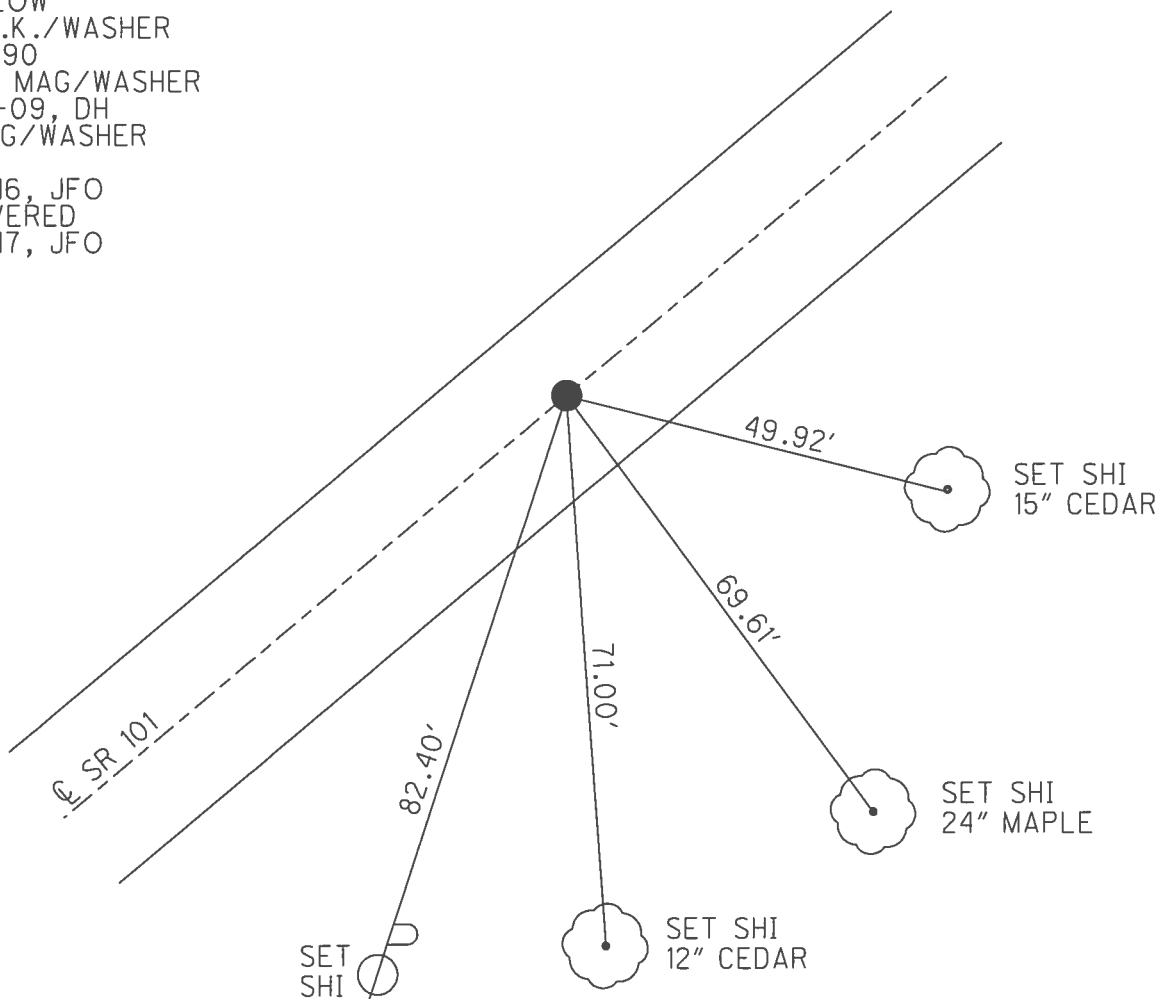

# O.D.O.T. DISTRICT 2 SURVEY OFFICE (USE ONLY)

PERSONNEL \_\_\_\_\_ REFERENCE NO. 58 SHEET 37 OF 46  
 NOTES HOMAN DATE 7/08/09 ROUTE SR 101  
 H.C. HOMAN WEATHER SUNNY COUNTY SENECA  
 R.C. ROUSOS TEMP. 80° TOWNSHIP ADAMS  
 \_\_\_\_\_ SECTION 10  
 \_\_\_\_\_ T 3 N R 16 E

TYPE MONUMENT P.K./WASHER


~~ON SURFACE~~ - BELOW 1 1/2"

LEFT - Q PAV'T - RIGHT ON


- TO - EDGE PAVEMENT

S.L.M. 682+94

GRID: NORTHING: 573073.974 EASTING: 1829032.869

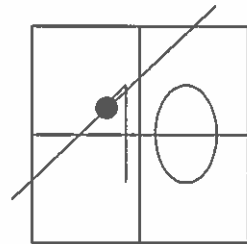

RECORD:  
 STA. 173+68.3  
 FD R.R. SPIKE  
 4" BELOW  
 SET P.K./WASHER  
 8/29/90  
 RESET MAG/WASHER  
 10-06-09, DH

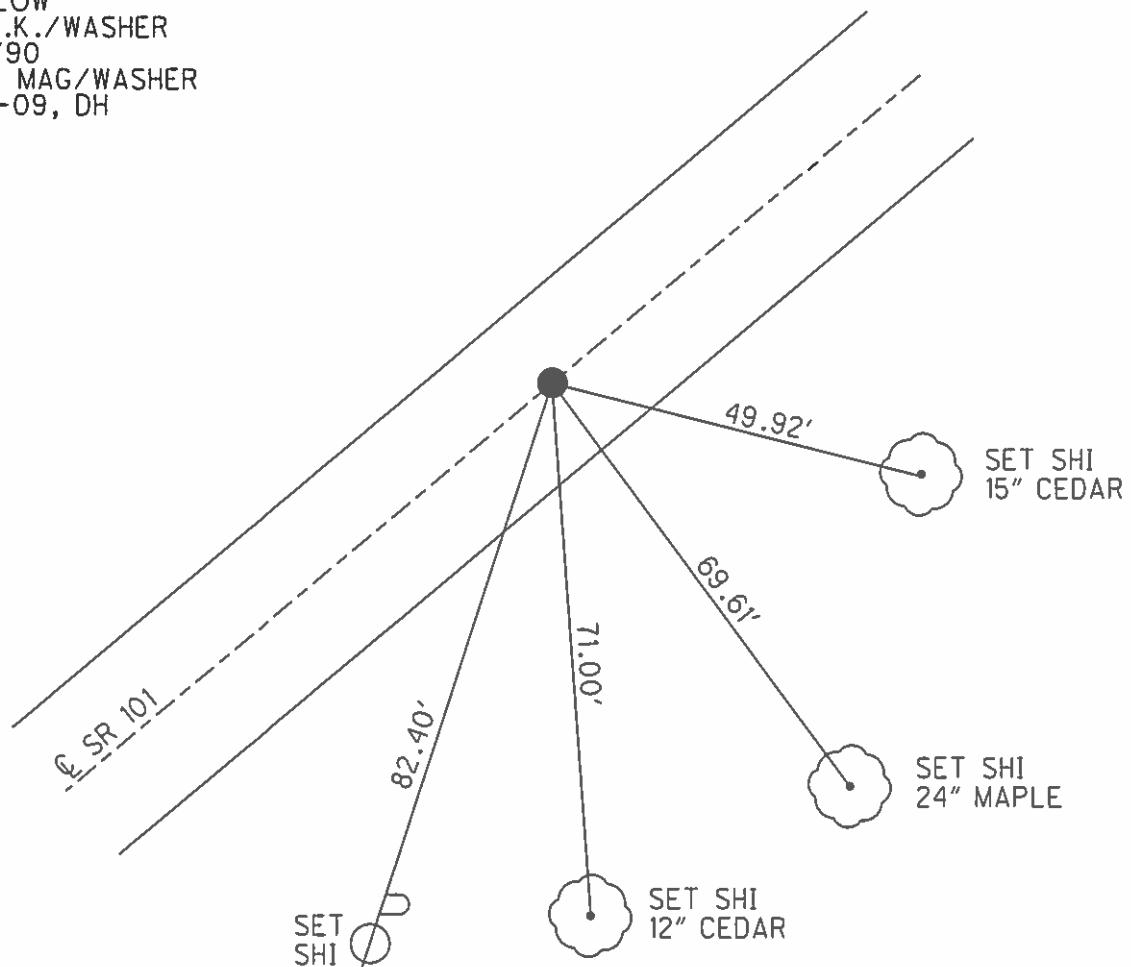

# O.D.O.T. DISTRICT 2 SURVEY OFFICE

PERSONNEL

REFERENCE NO. 58

SHEET 33 OF 41

NOTES Ripple

H.C. BARBOUR

R.C. GEYMAN

DATE 8-29-90

WEATHER Cloudy

TEMP. 78°

ROUTE 101


COUNTY SEN.

TOWNSHIP Adams

SECTION 10

T 3 N R 16 E

TYPE MONUMENT Set. P.K. & Washer  
 ON SURFACE - BELOW R/R spike 4" below  
 LEFT - CL PAV'T. - RIGHT CL  
 TO EDGE PAVEMENT  
 S.L.M.                     

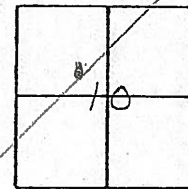

682+94

STA. 173+11 ±

883+

60.86

49.97

14" Cedar

70.83

10" Cedar

Fol (Need to)  
Patch Dig  
2-2-05  
SAH

O.D.O.T. DISTRICT 2 SURVEY OFFICE

PERSONNEL

REFERENCE NO. 58

SHEET 33 OF 41

NOTES Ripple

H.C. BARBOUR

R.C. Geyman

DATE 8-29-90

WEATHER Cloudy

TEMP. 78°

ROUTE 101


COUNTY Sen.

TOWNSHIP Adams


SECTION 10

T3 N R 16 E

TYPE MONUMENT Set. P.K. & Washer  
ON SURFACE - BELOW RR spike 4" below  
LEFT - CL PAV'T. - RIGHT CL  
TO EDGE PAVEMENT  
S.L.M.                     

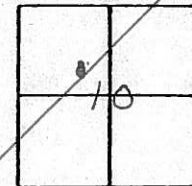

STA. 173+  
683+

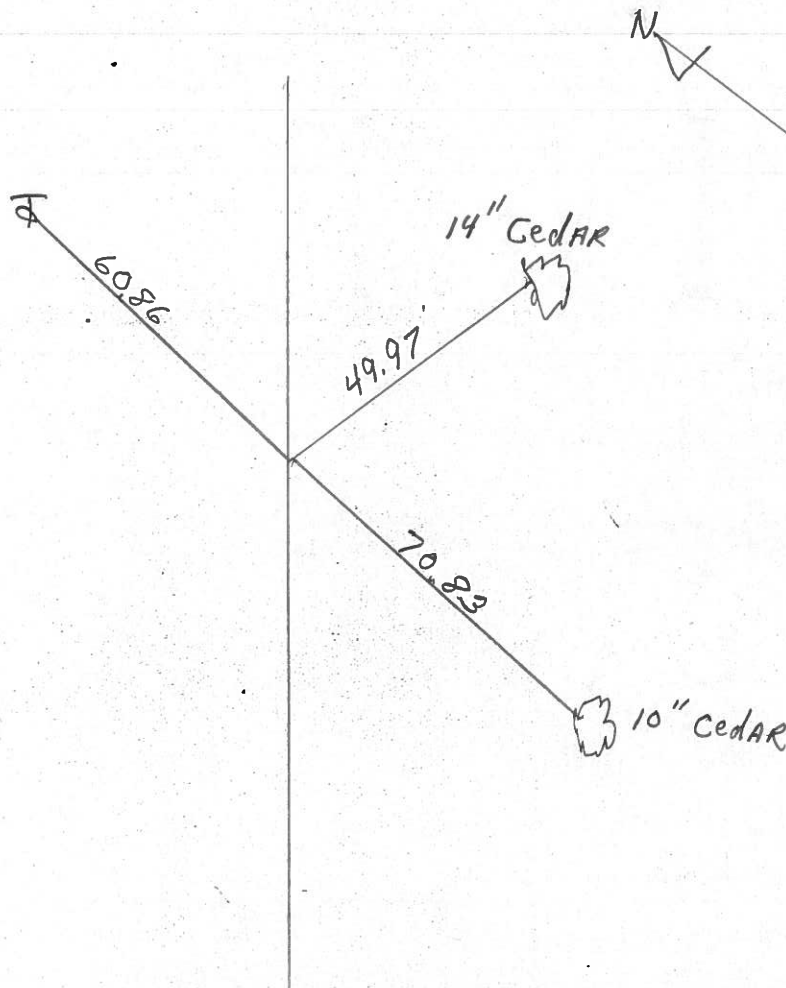

| PERSONNEL | TITLE | PERSONNEL | TITLE |
|-----------|-------|-----------|-------|
|           |       |           |       |
|           |       |           |       |
|           |       |           |       |

COUNTY SENeca DATE 11-25-63

S. R. # 101 WEATHER \_\_\_\_\_

SEC. \_\_\_\_\_ TEMP \_\_\_\_\_

DESCRIPTION LEFT CENTER LINE RIGHT JOB NO.

(61)

4-20-79  
2/27/69  
Sta. 211+00  
R.R. spk. on E R/W  
1 1/2" below surface  
HIT

8508

(60-A)

Sta. 192+00  
R.R. spk. on E R/W  
3" below surface  
1' RT. &  
HIT

8507

(59)

Sta. 181+00  
R.R. spk. on E R/W  
2" below surface


HIT

178+  
688+05 8506

(58)

Sta. 175+00  
R.R. spk. on E R/W  
2" below surface  
683+

408 8505

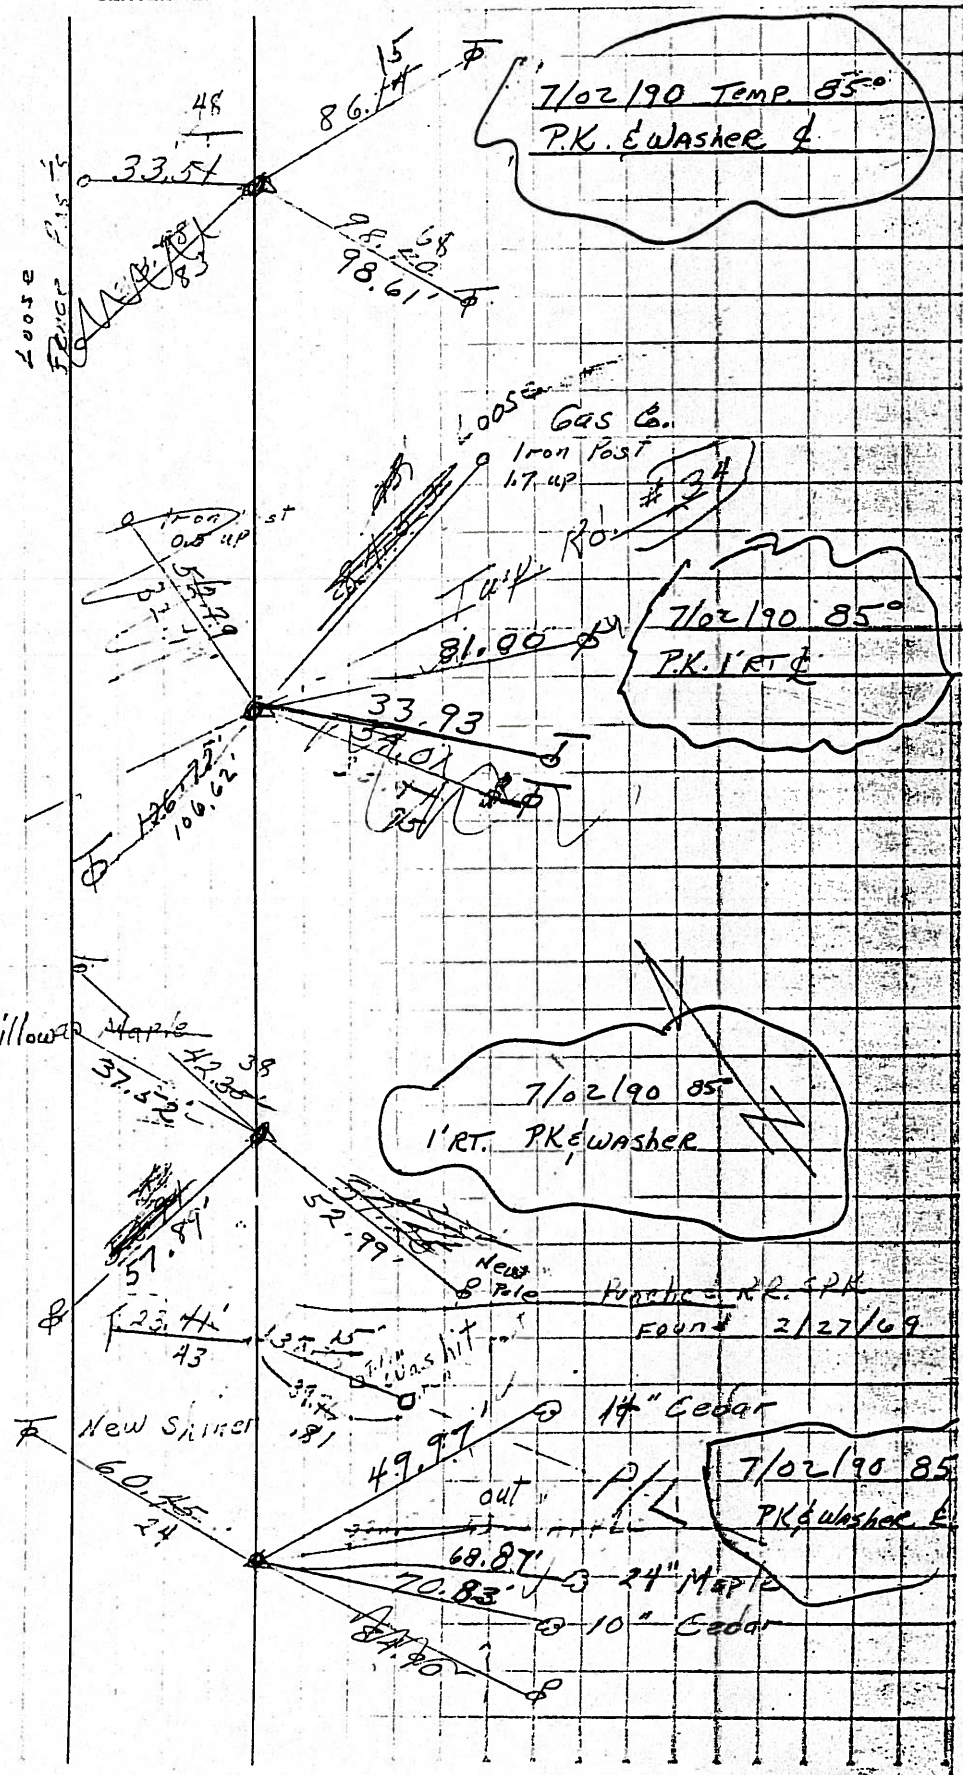

| PERSONNEL | TITLE | PERSONNEL | TITLE |
|-----------|-------|-----------|-------|
|-----------|-------|-----------|-------|

COUNTY Seneca

**DATE** 2-14-64

Krabb, 11

Kowalski

Гейман

Bruggeman

S. R. # 101

## WEATHER

SEC.

TEMP

| DESCRIPTION | S. R. # | 101 | Tiffin to San. Co. Line |
|-------------|---------|-----|-------------------------|
|             |         |     |                         |

JOB NO

**LEFT**

**CENTER LINE**

**RIGHT**

**JOB NO**

STA. 134+65  
R.R. Spike  
# 405

STA. 144+34.30  
R.R. Spike  
# 406

STA. 160+00  
Iron Pin  
#407

STA. 173+00  
Iron Pipe  
# 408

STA. 181+00  
Iron Pin  
# 409

