

O.D.O.T. DISTRICT 2 SURVEY OFFICE (USE ONLY)

PERSONNEL

REFERENCE NO. 59

SHEET 38 OF 46

NOTES MILLER

DATE 8/7/24

ROUTE SR 101

H.C. MILLER

WEATHER SUNNY

COUNTY SENECA

R.C. BARRIERE

TEMP. 70°F

TOWNSHIP ADAMS

BLUBAUGH, ASTON, PRESTON-COLVIN

SECTION 10

DWG BY BLUBAUGH

PID 114849

T 3 N R 16 E

TYPE MONUMENT MAG/WASHER

~~ON SURFACE~~ - BELOW 0.5"

OFFSET Q PAVEMENT 1' ~~LT~~ : RT

-- TO -- EDGE PAVEMENT

STATION: 682+94

HORIZ.DATUM: NAD83 (2011)


GEOID: NAVD88-2018

GRID: NORTHING: 573582.290


EASTING: 1829654.764

LDP: NORTHING: 342667.862

EASTING: 203958.670

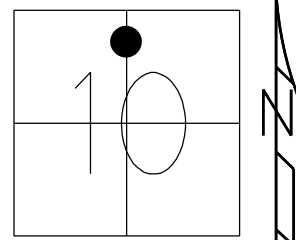

RECORD:
STA. 181+00
FD R.R. SPIKE
4" DOWN
SET P.K./WASHER
8/29/90, BARBOUR
FD P.K./WASHER
2/7/05, SAH
REF59
7/8/09, DCH
SET MAG/WASHER
NEWREF59
10-06-09, DH
FD MAG/WASHER
REF59
6/15/16
9/19/17, JFO
REF59
12/12/23, TDN
FD TONE. DID NOT
UNCOVER. PAINTED
8/7/24, JAM

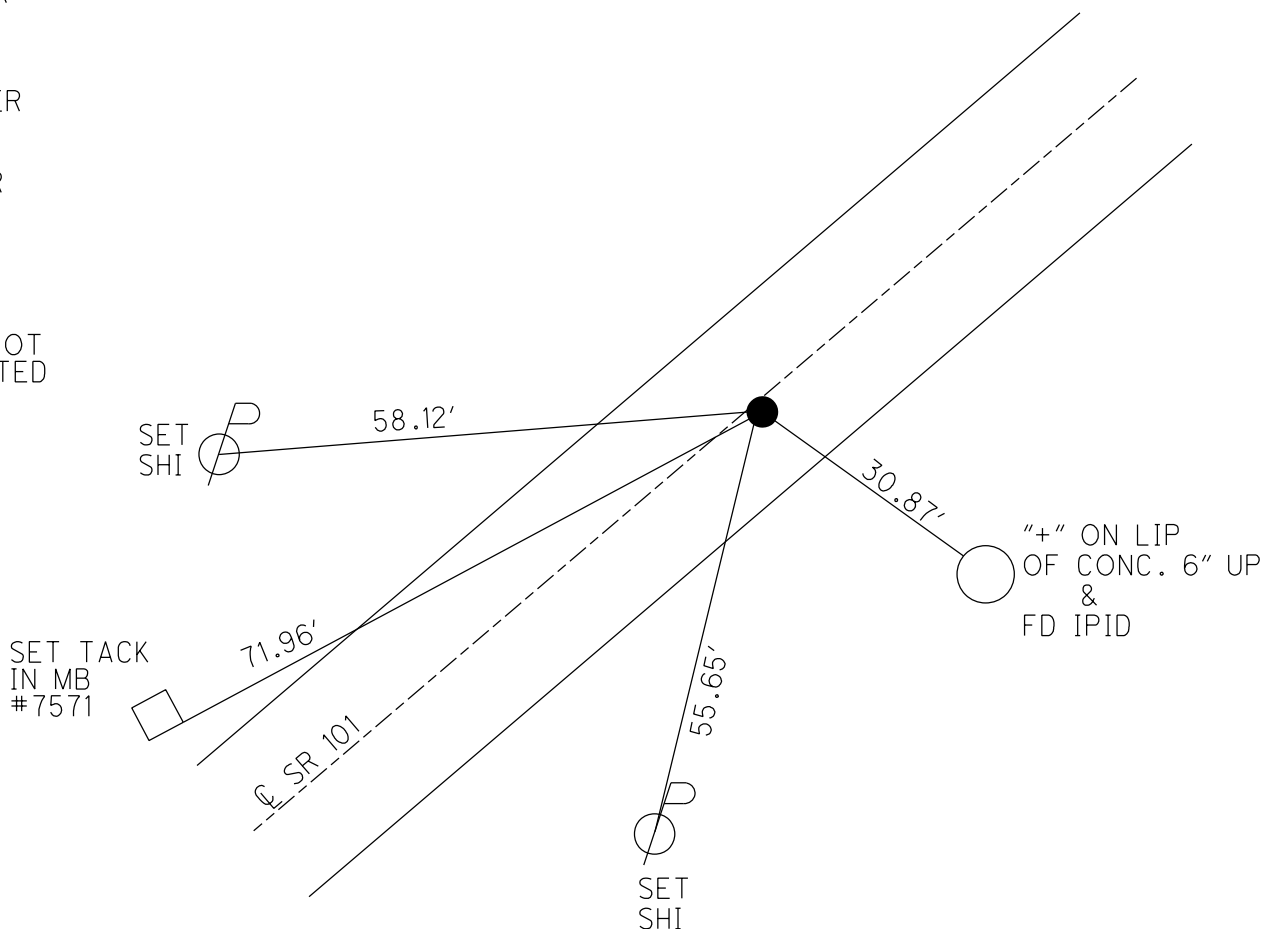

O.D.O.T. DISTRICT 2 SURVEY OFFICE (USE ONLY)

PERSONNEL

REFERENCE NO. 59

SHEET 38 OF 46

NOTES HOMAN

DATE 7-8-09

ROUTE SR 101

H.C. HOMAN

WEATHER SUNNY

COUNTY SENECA

R.C. ROUSOS

TEMP. 80°F

TOWNSHIP ADAMS

SECTION 10

DWG BY MAHLER

PID 100787

T 3 N R 16 E

TYPE MONUMENT P.K./WASHER

ON SURFACE - ~~BELOW~~ ON

OFFSET Q PAVEMENT 1' LT : RT

- TO - EDGE PAVEMENT


STATION: 690+97

HORIZ.DATUM: NAD83 (2011)

GEOID: NAVD88-2012A


GRID: NORTHING: 573582.290

EASTING: 1829654.764

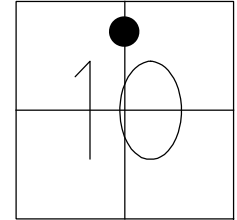

RECORD:

STA. 181+00
FD R.R. SPIKE
4" DOWN
SET P.K./WASHER
8/29/90, BARBOUR
FD P.K./WASHER
2/7/05, SAH
FD P.K./WASHER
REF59
7/8/09, DCH
SET MAG/WASHER
NEWREF59
10-06-09, DH
FD MAG/WASHER
REF59
6/15/16
9/19/17, JFO

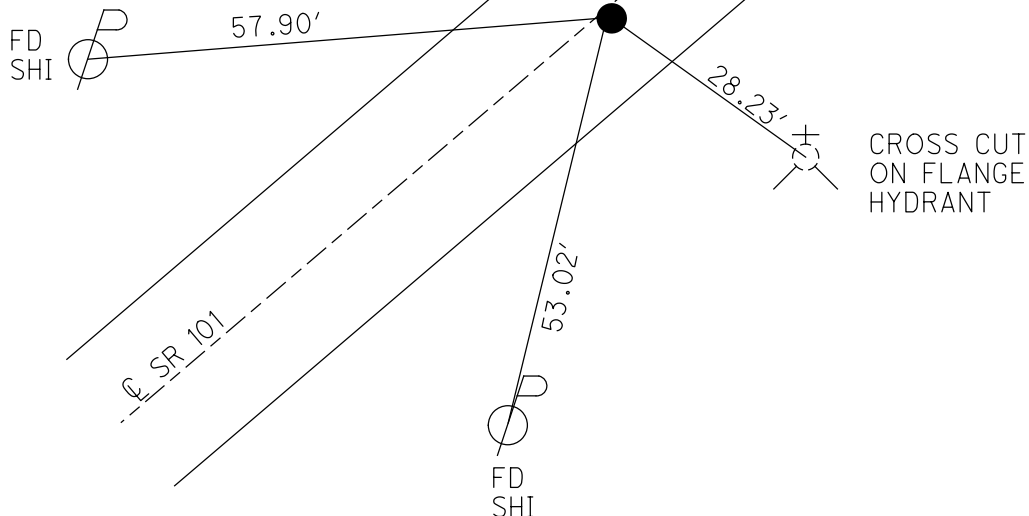


O.D.O.T. DISTRICT 2 SURVEY OFFICE (USE ONLY)


PERSONNEL	REFERENCE NO. <u>59</u>	SHEET <u>38</u> OF <u>46</u>
NOTES	DATE <u>7/08/09</u>	ROUTE <u>SR 101</u>
H.C. <u>HOMAN</u>	WEATHER <u>SUNNY</u>	COUNTY <u>SENECA</u>
R.C. <u>ROUSOS</u>	TEMP. <u>80°</u>	TOWNSHIP <u>ADAMS</u>
		SECTION <u>10</u>
		T <u>3</u> N R <u>16</u> E

TYPE MONUMENT P.K./WASHER
 ON SURFACE - ~~BELOW~~ ON _____
~~LEFT~~ - CL PAV'T - RIGHT 1'
 - TO - EDGE PAVEMENT
 S.L.M. 690+97

GRID: NORTHING: 573582.290 EASTING: 1829654.764

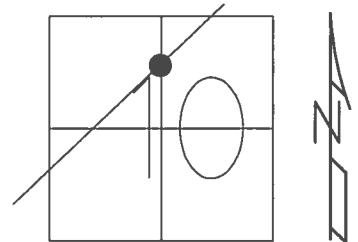

RECORD:
 STA. 181+00
 FD R.R. SPIKE
 4" BELOW
 SET P.K./WASHER
 8/29/90
 FD P.K./WASHER
 2/7/05, SAH
 SET MAG/WASHER
 10-06-09, DH
 FD MAG/WASHER
 REF59
 6/15/16, JFO
 UNCOVERED
 9/19/17, JFO

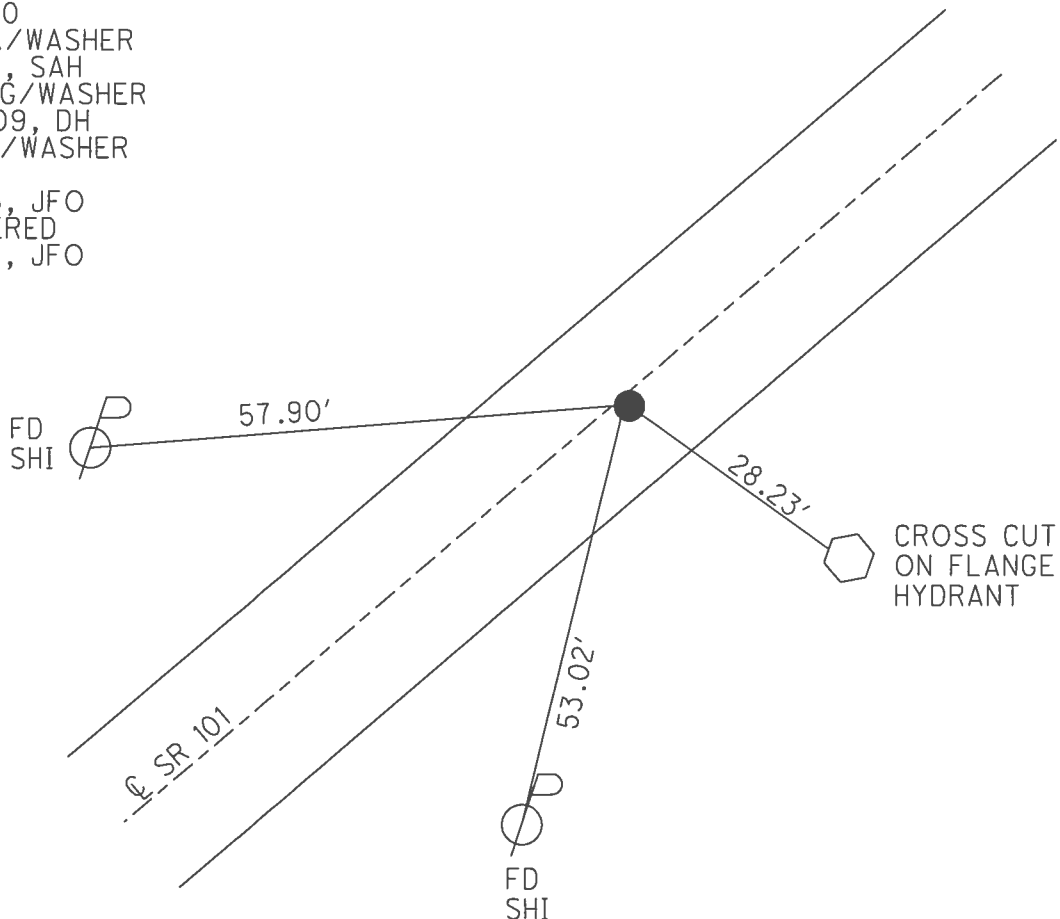


O.D.O.T. DISTRICT 2 SURVEY OFFICE (USE ONLY)


PERSONNEL _____ REFERENCE NO. 59 SHEET 38 OF 46
 NOTES HOMAN DATE 7/08/09 ROUTE SR 101
 H.C. HOMAN WEATHER SUNNY COUNTY SENECA
 R.C. ROUSOS TEMP. 80° TOWNSHIP ADAMS
 SECTION 10
 T 3 N R 16 E

TYPE MONUMENT P.K./WASHER
 ON SURFACE - ~~BELOW~~ ON _____
~~LEFT~~ - Q PAV'T - RIGHT 1'
 - TO - EDGE PAVEMENT
 S.L.M. 690+97

GRID: NORTHING: 573582.284 EASTING: 1829654.648

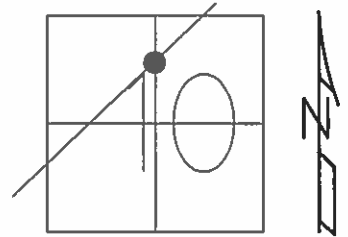

RECORD:
 STA. 181+00
 FD R.R. SPIKE
 4" BELOW
 SET P.K./WASHER
 8/29/90
 FD P.K./WASHER
 2/7/05, SAH
 SET MAG/WASHER
 10-06-09, DH

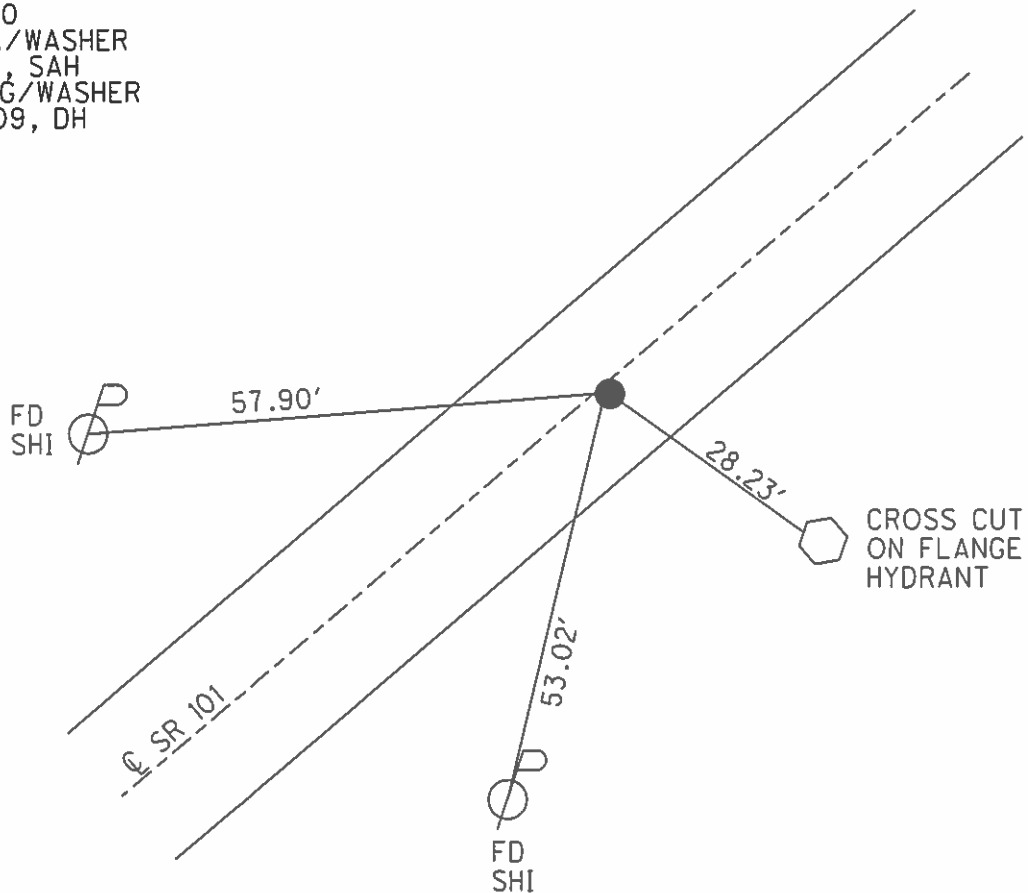

O.D.O.T. DISTRICT 2 SURVEY OFFICE

PERSONNEL

REFERENCE NO. 59

SHEET 34 OF 41

NOTES Ripple

H.C. Barbour

R.C. Geyman

DATE 8-29-90

WEATHER Cloudy

TEMP. 77°

ROUTE 101

COUNTY Sen.

TOWNSHIP Adams

SECTION 10

T 3 N R 16 E


TYPE MONUMENT Set P.K. Washer

ON SURFACE - BELOW R/R Spike 4' below

LEFT- & PAV'T. - RIGHT 1' RT. &

TO EDGE PAVEMENT

S.L.M.

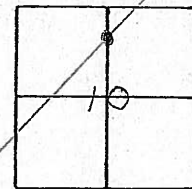

690+97

STA. 181+


Black Willow



37.52

57.89

52.99

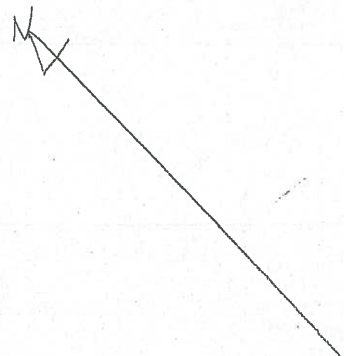

Fd

2-7-05

SAH

O.D.O.T. DISTRICT 2 SURVEY OFFICE

PERSONNEL

REFERENCE NO. 59

SHEET 34 OF 41

NOTES Ripph

H.C. Barbours

R.C. Geyman

DATE 8-29-90

WEATHER Cloudy

TEMP. 77°

ROUTE 101


COUNTY Sen.

TOWNSHIP Adams

SECTION 10

T. 3 N R. 16 E

TYPE MONUMENT Set P.K. Washer
ON SURFACE - BELOW R/R Spike 4" below
LEFT- & PAV'T. - RIGHT 1' RT. &
TO EDGE PAVEMENT
S.L.M.

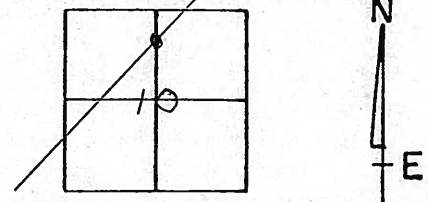


STA. 181+


Black Willow

37.52'

57.89'

52.99'

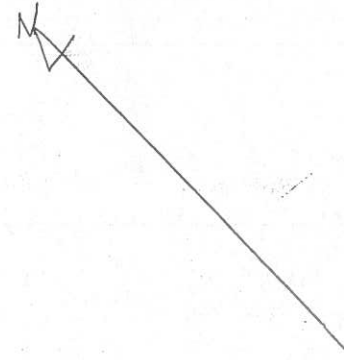

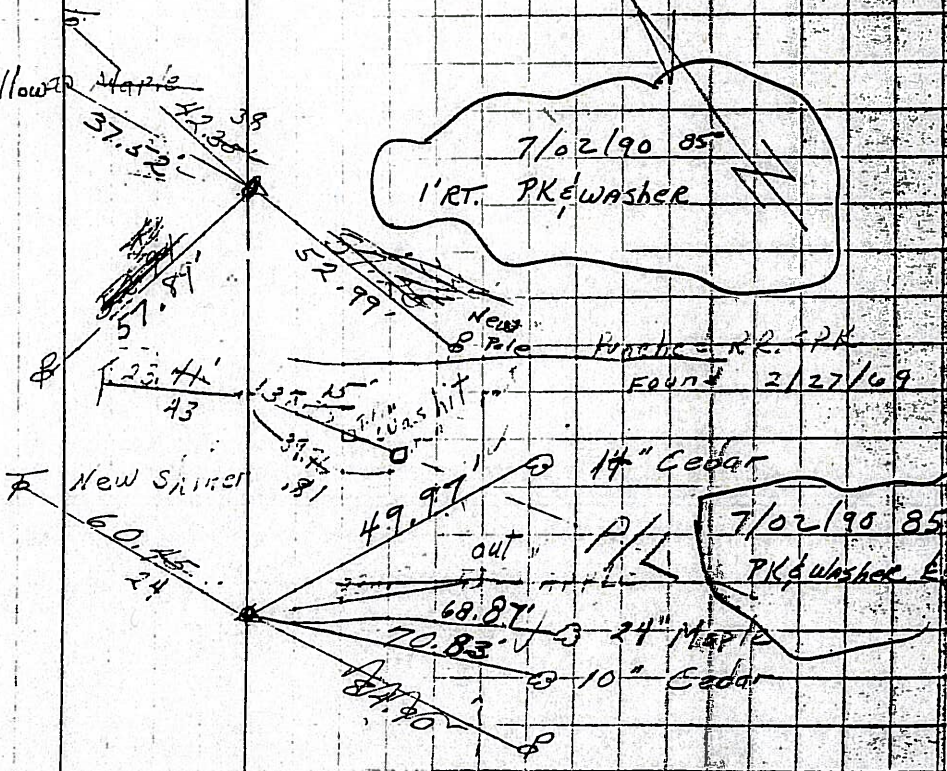

PERSONNEL	TITLE	PERSONNEL	TITLE
1	2	3	4
5	6	7	8
9	10	11	12
13	14	15	16
17	18	19	20
21	22	23	24
25	26	27	28
29	30	31	32
33	34	35	36
37	38	39	40
41	42	43	44
45	46	47	48
49	50	51	52
53	54	55	56
57	58	59	60
61	62	63	64
65	66	67	68
69	70	71	72
73	74	75	76
77	78	79	80
81	82	83	84
85	86	87	88
89	90	91	92
93	94	95	96
97	98	99	100

COUNTY Seneca

DATE 2-14-64

Kraball

Kowalewski

S. R. # 101

WEATHER

Гейман

SEC.

TEMP.

Bruggeman

DESCRIPTION S.R. # 101 Tiffin to San. Co. Line

JOB NO. _____

LEFT

CENTER LINE

RIGHT



STA. 134+65

R. R. Spike
405



STA. 144+34.30'

R. R. Spike
406



STA. 165+00

Iron Pin #407



STA. 173+00

Iron Pipe # 408



STA 131+00

Iron Pib
409

