

O.D.O.T. DISTRICT 2 SURVEY OFFICE (USE ONLY)

PERSONNEL

REFERENCE NO. 60

SHEET 39 OF 46

NOTES MILLER

DATE 8/7/24

ROUTE SR 101

H.C. MILLER

WEATHER SUNNY

COUNTY SENECA

R.C. BARRIERE

TEMP. 70°F

TOWNSHIP ADAMS

BLUBAUGH, ASTON, PRESTON-COLVIN

SECTION 3

DWG BY BLUBAUGH

PID 114849

T 3 N R 16 E

TYPE MONUMENT MAG/WASHER

~~ON SURFACE~~ - BELOW 0.5"

OFFSET $\odot$ PAVEMENT 0.2' ~~LT~~ : RT

-- TO -- EDGE PAVEMENT

STATION: 682+94

HORIZ.DATUM: NAD83 (2011)


GEOID: NAVD88-2018

GRID: NORTHING: 574280.650


EASTING: 1830481.781

LDP: NORTHING: 343372.427

EASTING: 204780.544

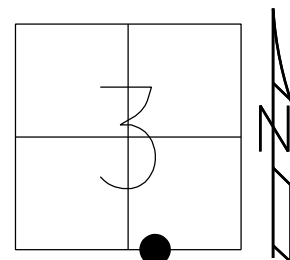

RECORD:
FD P.K.NAIL
REF60
7/8/09, DCH
SET MAG/WASHER
NEWREF60
10-06-09, DH
FD MAG/WASHER
REF60
6/15/16
9/12/17, JFO
REF60
12/12/23, TDN
FD TONE. DID NOT
UNCOVER. PAINTED
8/7/24, JAM

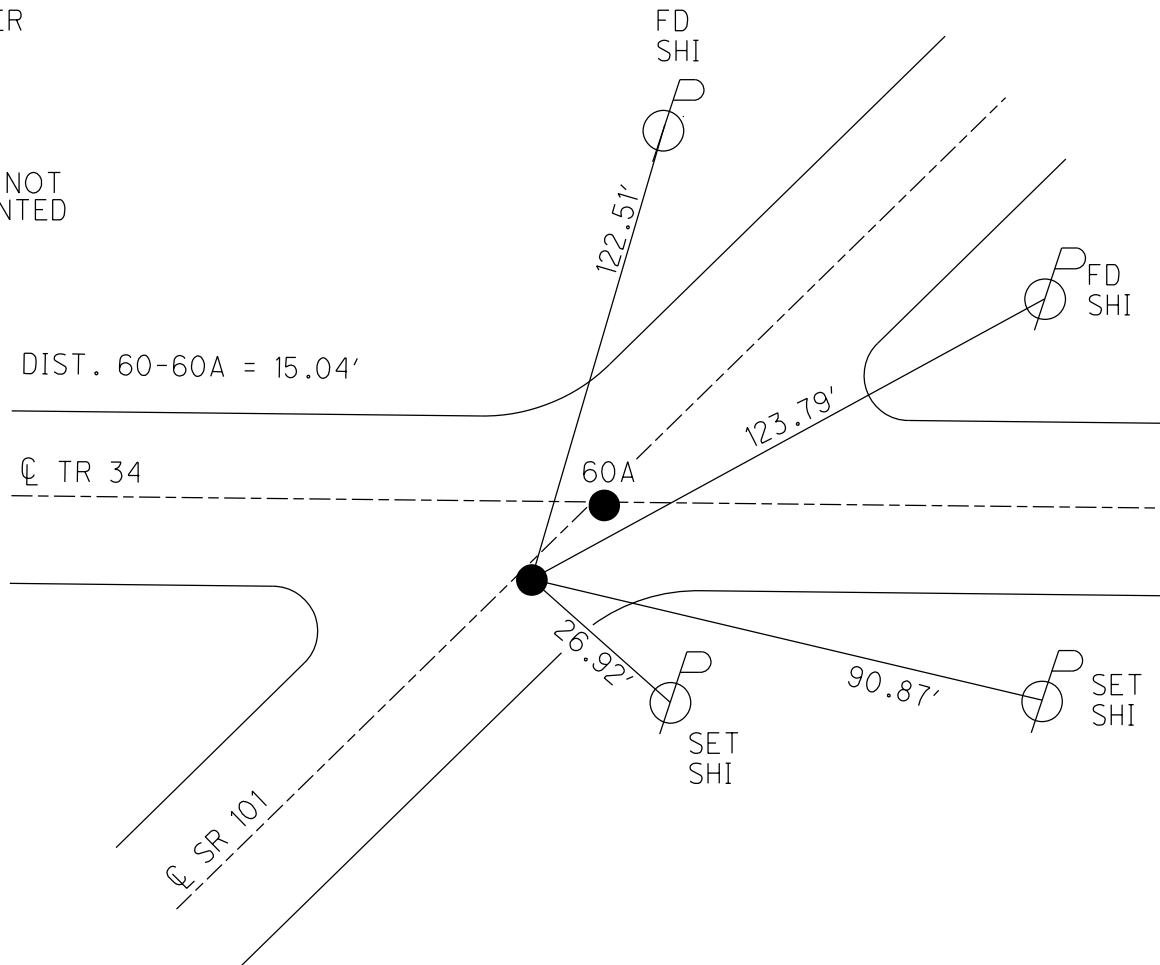

O.D.O.T. DISTRICT 2 SURVEY OFFICE (USE ONLY)

PERSONNEL

REFERENCE NO. 60

SHEET 39 OF 46

NOTES HOMAN
H.C. HOMAN
R.C. ROUSOS

DATE 7-8-09
WEATHER SUNNY
TEMP. 80°F

ROUTE SR 101
COUNTY SENECA
TOWNSHIP ADAMS
SECTION 3
T 3 N R 16 E

DWG BY MAHLER PID 100787

TYPE MONUMENT P.K./WASHER

ON SURFACE - ~~BELOW~~ ON

OFFSET Q PAVEMENT 2' LT : RT

- TO - EDGE PAVEMENT


STATION: 701+80

HORZ.DATUM: NAD83 (2011)


GEOID: NAVD88-2012A

GRID: NORTHING: 574280.650

EASTING: 1830481.781

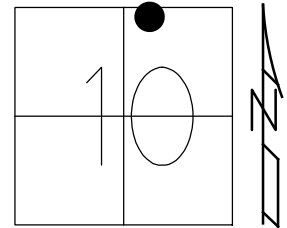


RECORD:
FD P.K.NAIL
REF60
7/8/09, DCH
SET MAG/WASHER
NEWREF60
10-06-09, DH
FD MAG/WASHER
REF60
6/15/16
9/12/17, JFO

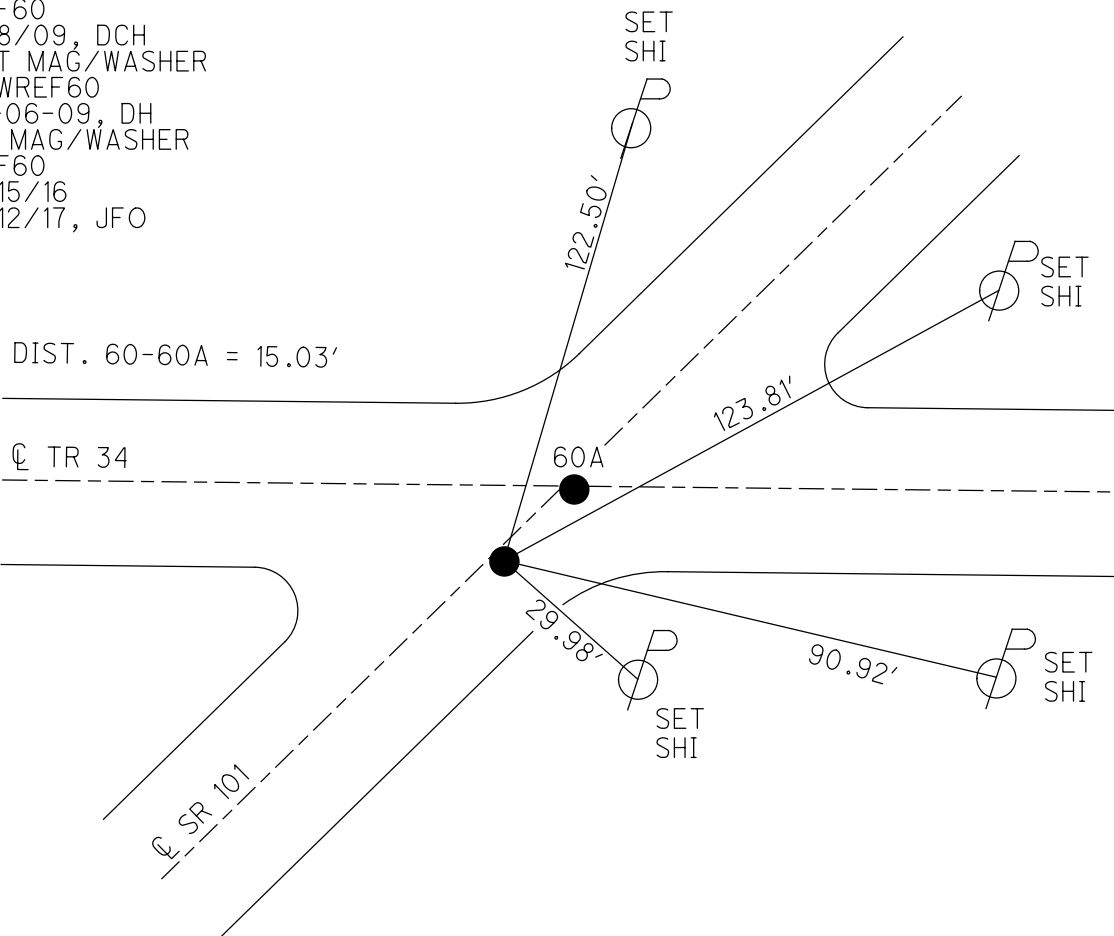

O.D.O.T. DISTRICT 2 SURVEY OFFICE (USE ONLY)


PERSONNEL		REFERENCE NO.	<u>60</u>	SHEET	<u>39</u>	OF	<u>46</u>
NOTES	<u>HOMAN</u>	DATE	<u>7/08/09</u>	ROUTE	<u>SR 101</u>		
H.C.	<u>HOMAN</u>	WEATHER	<u>SUNNY</u>	COUNTY	<u>SENECA</u>		
R.C.	<u>ROUSOS</u>	TEMP.	<u>80°</u>	TOWNSHIP	<u>ADAMS</u>		
				SECTION	<u>3</u>		
				T <u>3</u> N R <u>16</u> E			

TYPE MONUMENT P.K./WASHER
 ON SURFACE - ~~BELOW~~ ON
~~LEFT~~ - Q PAV'T - RIGHT 2'
- TO - EDGE PAVEMENT
 S.L.M. 701+80

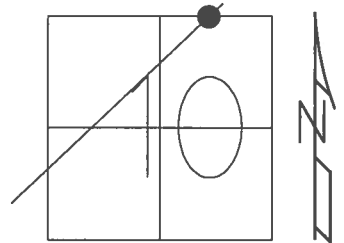

GRID: NORTHING: 574280.650 EASTING: 1830481.781

RECORD:
 SET MAGS/WASHER
 10-06-09, DH
 FD MAG/WASHER
 REF60
 6/15/16, JFO
 UNCOVERED
 9/12/17, JFO

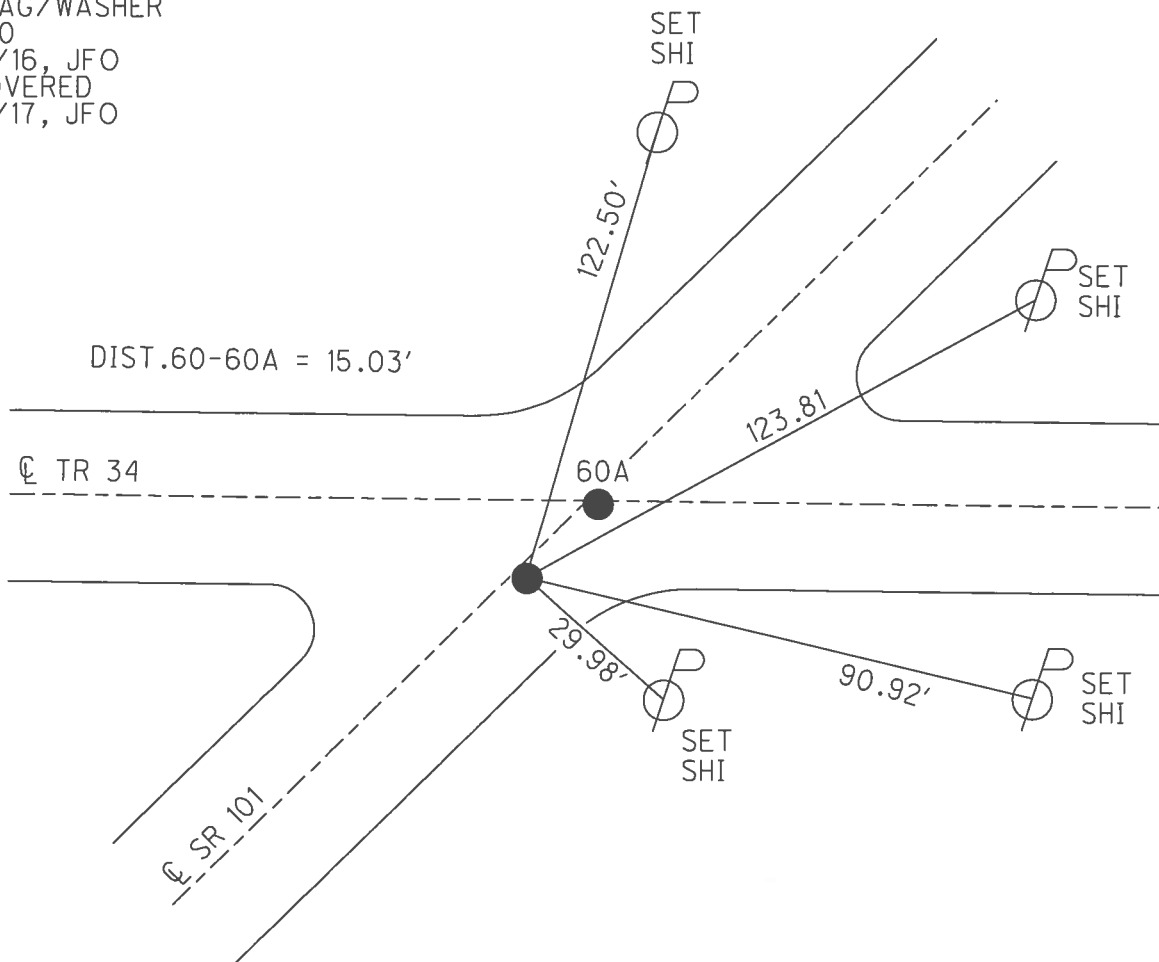


O.D.O.T. DISTRICT 2 SURVEY OFFICE (USE ONLY)

PERSONNEL _____ REFERENCE NO. 60 SHEET 39 OF 46
 NOTES HOMAN DATE 7/08/09 ROUTE SR 101
 H.C. HOMAN WEATHER SUNNY COUNTY SENECA
 R.C. ROUSOS TEMP. 80° TOWNSHIP ADAMS
 _____ SECTION 3
 _____ T 3 N R 16 E

TYPE MONUMENT P.K./WASHER
 ON SURFACE - ~~BELOW~~ ON
~~LEFT~~ - CL PAV'T - RIGHT 2'
- TO - EDGE PAVEMENT
 S.L.M. 701+80

GRID: NORTHING: 574290.461 EASTING: 1830493.153

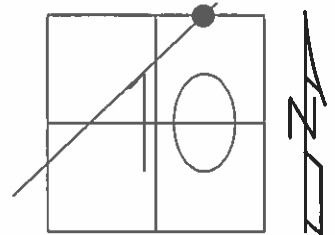

RECORD:
 SET MAGS/WASHER
 10-06-09, DH

