

O.D.O.T. DISTRICT 2 SURVEY OFFICE (USE ONLY)

PERSONNEL

REFERENCE NO. 60 A

SHEET 40 OF 46

NOTES MILLER

DATE 8/7/24

ROUTE SR 101

H.C. MILLER

WEATHER SUNNY

COUNTY SENECA

R.C. BARRIERE

TEMP. 70°F

TOWNSHIP ADAMS

BLUBAUGH, ASTON, PRESTON-COLVIN

SECTION 3

DWG BY BLUBAUGH

PID 114849

T 3 N R 16 E

TYPE MONUMENT MAG/WASHER

~~ON SURFACE~~ - BELOW 0.5"

OFFSET Q PAVEMENT 2' ~~LT~~ : RT

-- TO -- EDGE PAVEMENT

STATION: 701+95

HORIZ.DATUM: NAD83 (2011)


GEOID: NAVD88-2018

GRID: NORTHING: 574290.410


EASTING: 1830493.199

LDP: NORTHING: 343382.277

EASTING: 204791.913

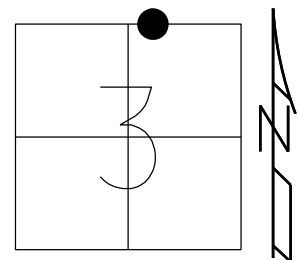

RECORD:
STA. 192+00
FD R.R. SPIKE
5" DOWN
SET P.K./WASHER
1" DOWN
8/29/90, BARBOUR
FD P.K.NAIL
2" DOWN
REF A60
7/8/09, DCH
SET MAG/WASHER
NEW REF A60
10-06-09, DH
FD MAG/WASHER
REF A60
6/15/16
9/19/17, JFO
REF 60A
12/12/23, TDN
FD TONE. DID NOT
UNCOVER. PAINTED
8/7/24, JAM

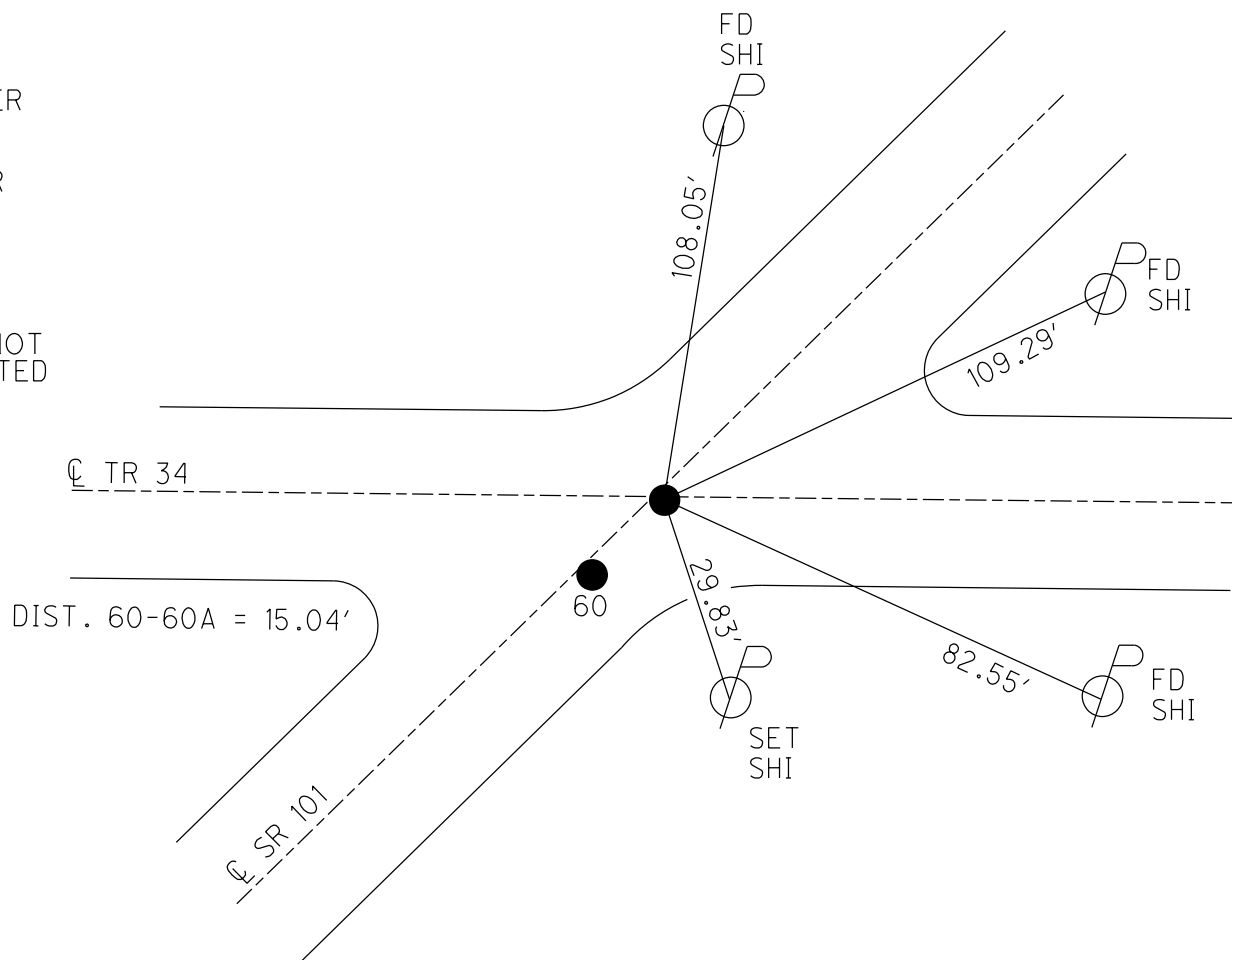

O.D.O.T. DISTRICT 2 SURVEY OFFICE (USE ONLY)

PERSONNEL

REFERENCE NO. 60 A

SHEET 40 OF 46

NOTES HOMAN

DATE 7-8-09

ROUTE SR 101

H.C. HOMAN

WEATHER SUNNY

COUNTY SENECA

R.C. ROUSOS

TEMP. 80°F

TOWNSHIP ADAMS

SECTION 3

DWG BY MAHLER

PID 25447

T 3 N R 16 E

TYPE MONUMENT P.K./WASHER

~~ON SURFACE~~ - BELOW 2"

OFFSET CL PAVEMENT 2' ~~LT~~ : RT

- TO - EDGE PAVEMENT


STATION: 701+95

HORIZ.DATUM: NAD83 (2011)


GEOID: NAVD88-2012A

GRID: NORTHING: 574290.410

EASTING: 1830493.199

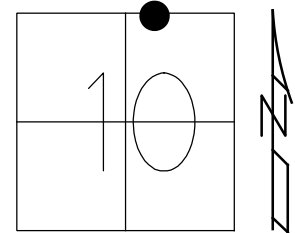

RECORD:
STA. 192+00
FD R.R. SPIKE
5" DOWN
SET P.K./WASHER
1" DOWN
8/29/90, BARBOUR
FD P.K.NAIL
2" DOWN
REFA60
7/8/09, DCH
SET MAG/WASHER
NEWREFA60
10-06-09, DH
FD MAG/WASHER
REFA60
6/15/16
9/19/17, JFO

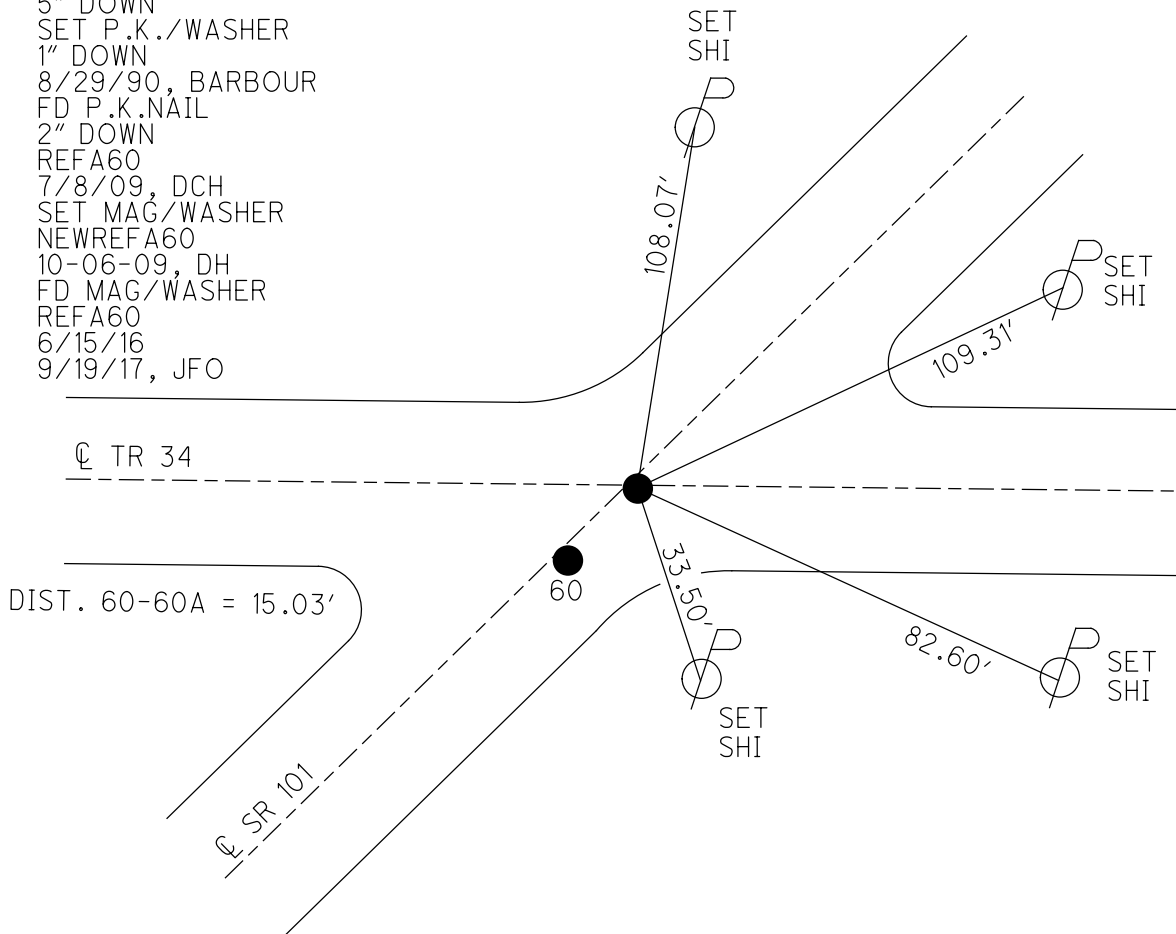

O.D.O.T. DISTRICT 2 SURVEY OFFICE (USE ONLY)

PERSONNEL

REFERENCE NO.

60 A

SHEET

40

OF 46

NOTES

HOMAN

DATE

7/08/09

ROUTE

SR 101

H.C.

HOMAN

WEATHER

SUNNY

COUNTY

SENECA

R.C.

ROUSOS

TEMP.

80°

TOWNSHIP

ADAMS

SECTION

3

T 3 N

R 16 E

TYPE MONUMENT

P.K./WASHER

~~ON SURFACE~~

- BELOW

2"

~~LEFT~~

-

Q

PAV'T - RIGHT

2'

-

TO


- EDGE PAVEMENT

S.L.M.

701+95

GRID: NORTHING

EASTING: 1830493.199

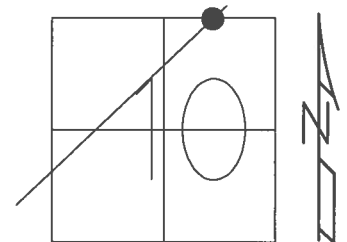

RECORD:

STA. 192+00

FD R.R. SPIKE

5" DOWN

SET P.K./WASHER

1" DOWN

8/29/90

SET MAGS/WASHER

10-06-09, DH


FD MAG/WASHER

REFA60

6/15/16, JFO

UNCOVERED

9/19/17, JFO

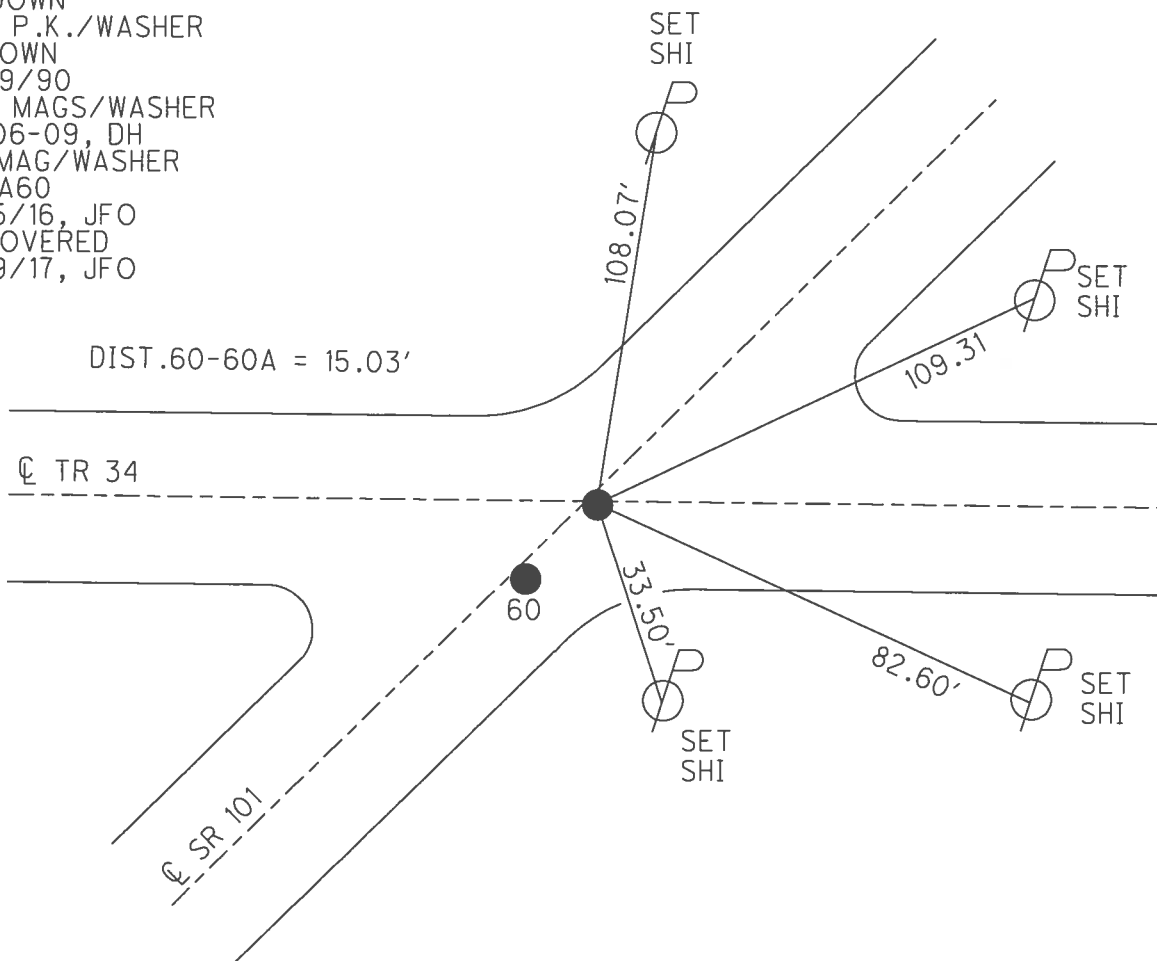

O.D.O.T. DISTRICT 2 SURVEY OFFICE (USE ONLY)

PERSONNEL _____ REFERENCE NO. 60 A SHEET 40 OF 46

NOTES _____ DATE 7/08/09 ROUTE SR 101

H.C. HOMAN WEATHER SUNNY COUNTY SENECA

R.C. ROUSOS TEMP. 80° TOWNSHIP ADAMS

SECTION 3

T 3 N R 16 E

TYPE MONUMENT P.K./WASHER


~~ON SURFACE~~ - BELOW 2"

~~LEFT~~ - Q PAV'T - RIGHT 2'


- TO - EDGE PAVEMENT

S.L.M. 701+95

GRID: NORTHING 574280.661 EASTING: 1830481.669

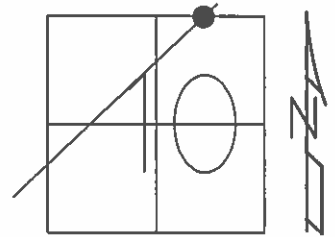

RECORD:
 STA. 192+00
 FD R.R. SPIKE
 5" DOWN
 SET P.K./WASHER
 1" DOWN
 8/29/90
 SET MAGS/WASHER
 10-06-09, DH

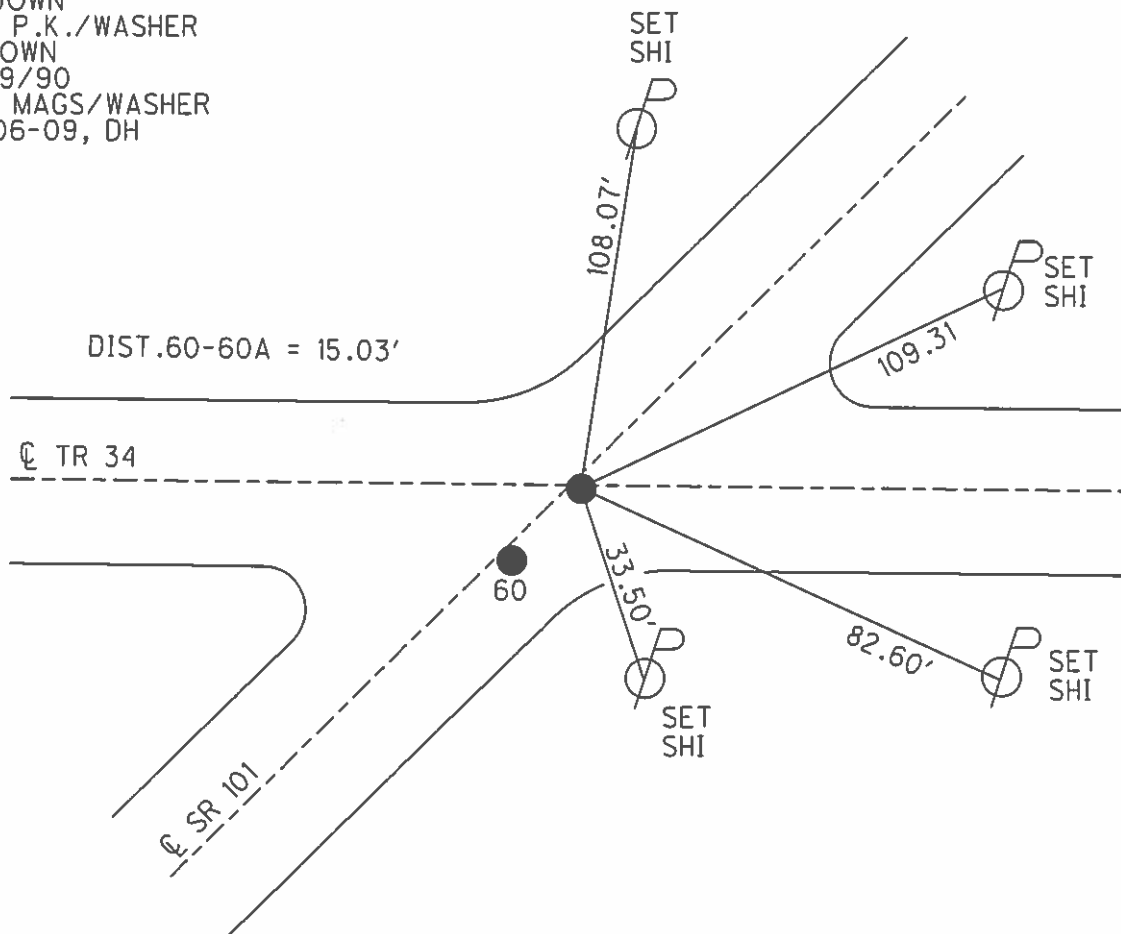

O.D.O.T. DISTRICT 2 SURVEY OFFICE

PERSONNEL

REFERENCE NO. 60

SHEET 35 OF 41

NOTES Ripple

H.C. Barbour

R.C. Geyman

DATE 8-29-90

WEATHER Cloudy

TEMP. 78°

ROUTE 101

COUNTY Sen.

TOWNSHIP Adams

SECTION 3

T. 3 N R. 16 E

TYPE MONUMENT P.K. & Washer 1" down

ON SURFACE - BELOW R/R spike 5" down

LEFT- & PAV'T. - RIGHT 2 RT. &

TO EDGE PAVEMENT


S.L.M.

60-A


3	2
10	11



701+95

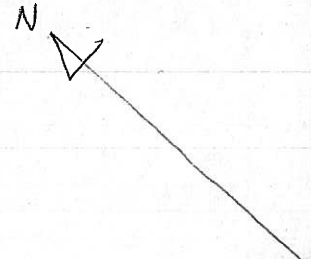

STA. 192+
Ties Did not check
suggest you dig.

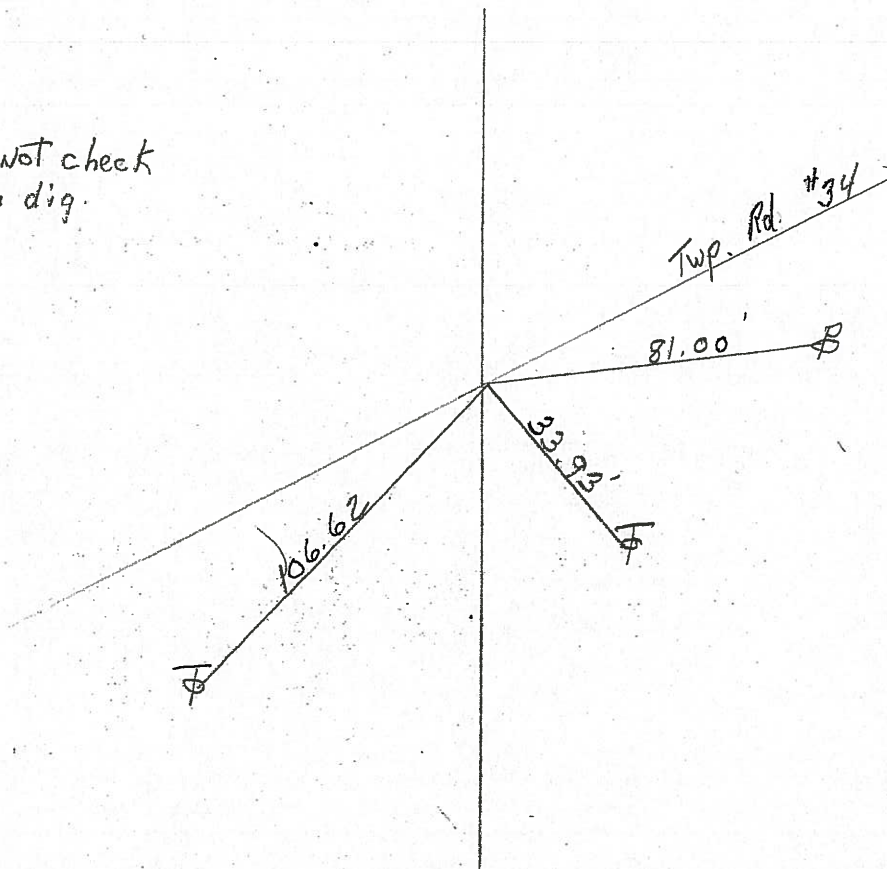

F&L hole (dig)

2-7-05

SAH

O.D.O.T. DISTRICT 2 SURVEY OFFICE

PERSONNEL

REFERENCE NO. 60

SHEET 35 OF 41

NOTES Ripple

H.C. Barbour

R.G. Geyman

DATE 8-29-90

WEATHER Cloudy

TEMP. 78°

ROUTE 101

COUNTY Sen.

TOWNSHIP Adams

SECTION 3

T 3 N R 16 E

TYPE MONUMENT P.K. & Washer 1" down



ON SURFACE - BELOW R/R spike 5" down

LEFT- & PAV'T. - RIGHT 2 RT. &


TO EDGE PAVEMENT

S.L.M.

60-A

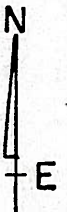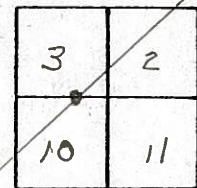

STA. 192+
Ties Did not check
suggest you dig.

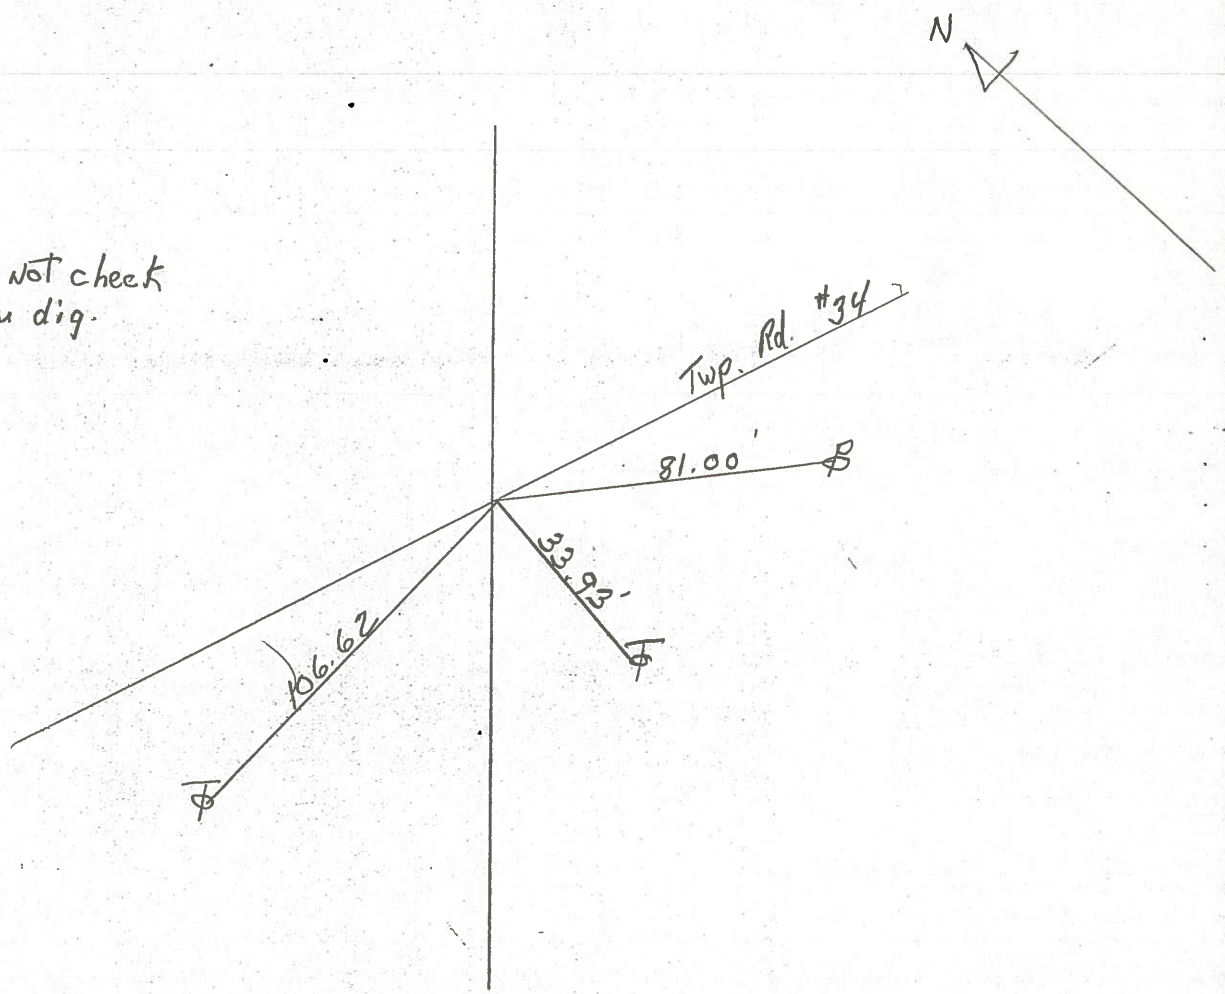

PERSONNEL TITLE PERSONNEL TITLE

COUNTY Seneca

DATE 2-14-64

Krabill

Kowaleski

Geyman

Bruggeman

S. R. # 101

WEATHER

SEC.

TEMP.

DESCRIPTION S. R. # 101 Tiffin to Sen. Co line

JOB NO.


LEFT

CENTER LINE

RIGHT


(60-A)

STA. 192+00

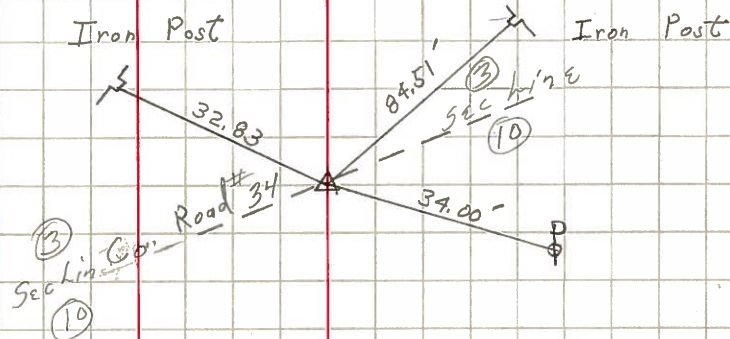Iron Pin
410


(61)

STA. 211+00

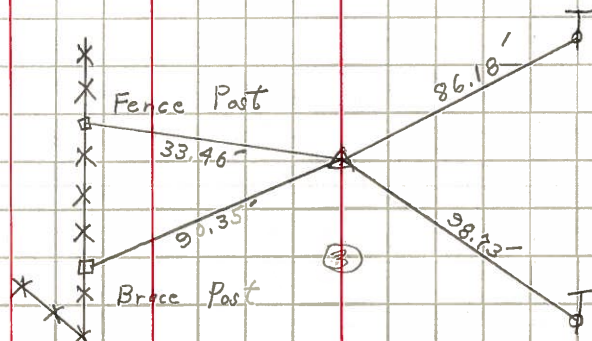Iron Pin
411

(62)

STA. 224+00

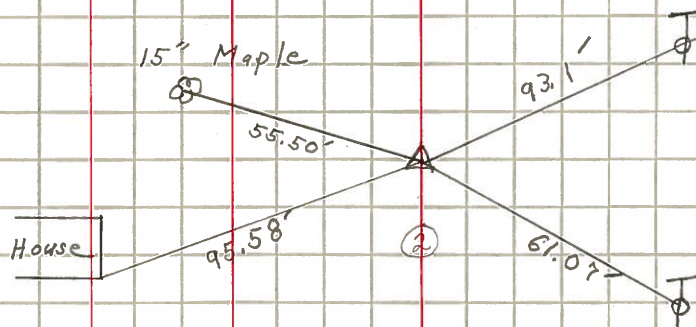Iron Pin
412

(63)

STA. 232+00

Iron Pin
413