


O.D.O.T. DISTRICT 2 SURVEY OFFICE (USE ONLY)

PERSONNEL _____ REFERENCE NO. 2 SHEET 2 OF 32


NOTES	RHOADES _____	DATE	8/1/17	ROUTE	SR 162
H.C.	HOMAN _____	WEATHER	SUNNY	COUNTY	SENECA
R.C.	CARSON _____	TEMP.	70°	TOWNSHIP	SCIPIO
	POORE _____			SECTION	16
				T	2 N R 16 E

TYPE MONUMENT MAG/WASHER
 ON SURFACE - ~~BELOW~~ ON
~~LEFT~~ - Q PAV'T - RIGHT ON
 - TO - EDGE PAVEMENT
 S.L.M. 3+73

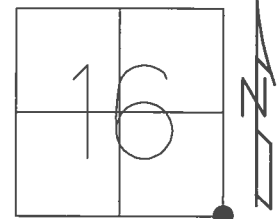

GRID: NORTHING: 531608.554 EASTING: 1826467.569

RECORD:
 FD LG RR SPIKE
 4 " DOWN
 SET MAG/WASHER
 10/6/04, MC
 FD MAG/WASHER
 REF2
 5/8/14, EBW
 FD MAG/WASHER
 REF2
 1/8/16, JFO
 SET 1" MAG/WASHER
 8/1/17, DCH

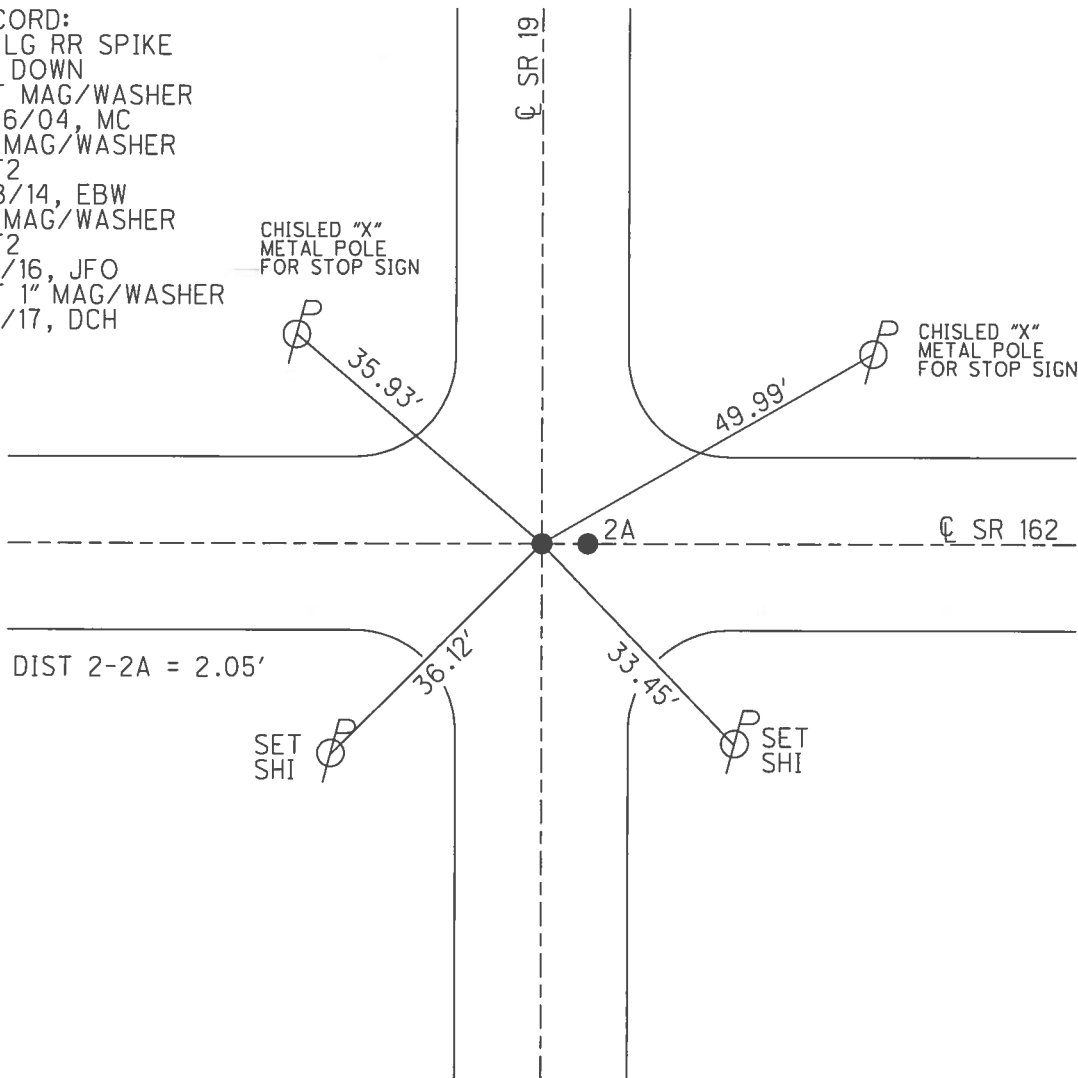

O.D.O.T. DISTRICT 2 SURVEY OFFICE (USE ONLY)

PERSONNEL

REFERENCE NO. 2

SHEET 2 OF 32

NOTES HOMAN

DATE 4/15/04

ROUTE SR 162

H.C. NUHFER

WEATHER SUNNY

COUNTY SENECA

R.C. ARMS

TEMP. 65°

TOWNSHIP SCIPIO

HOOKER

SECTION 16

T 2 N R 16 E

TYPE MONUMENT P.K./WASHER

ON SURFACE - ~~BELOW~~ ON


~~LEFT~~ - C PAV'T - RIGHT ON

- TO - EDGE PAVEMENT


S.L.M. 3+73

GRID: NORTHING: 531608.538

EASTING: 1826467.587

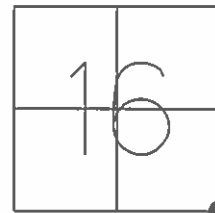

RECORD:
FD LG RR SPIKE
4" DOWN
SET MAG/WASHER
10/6/04, MC
FD MAG/WASHER
REF2
5/8/14, EBW

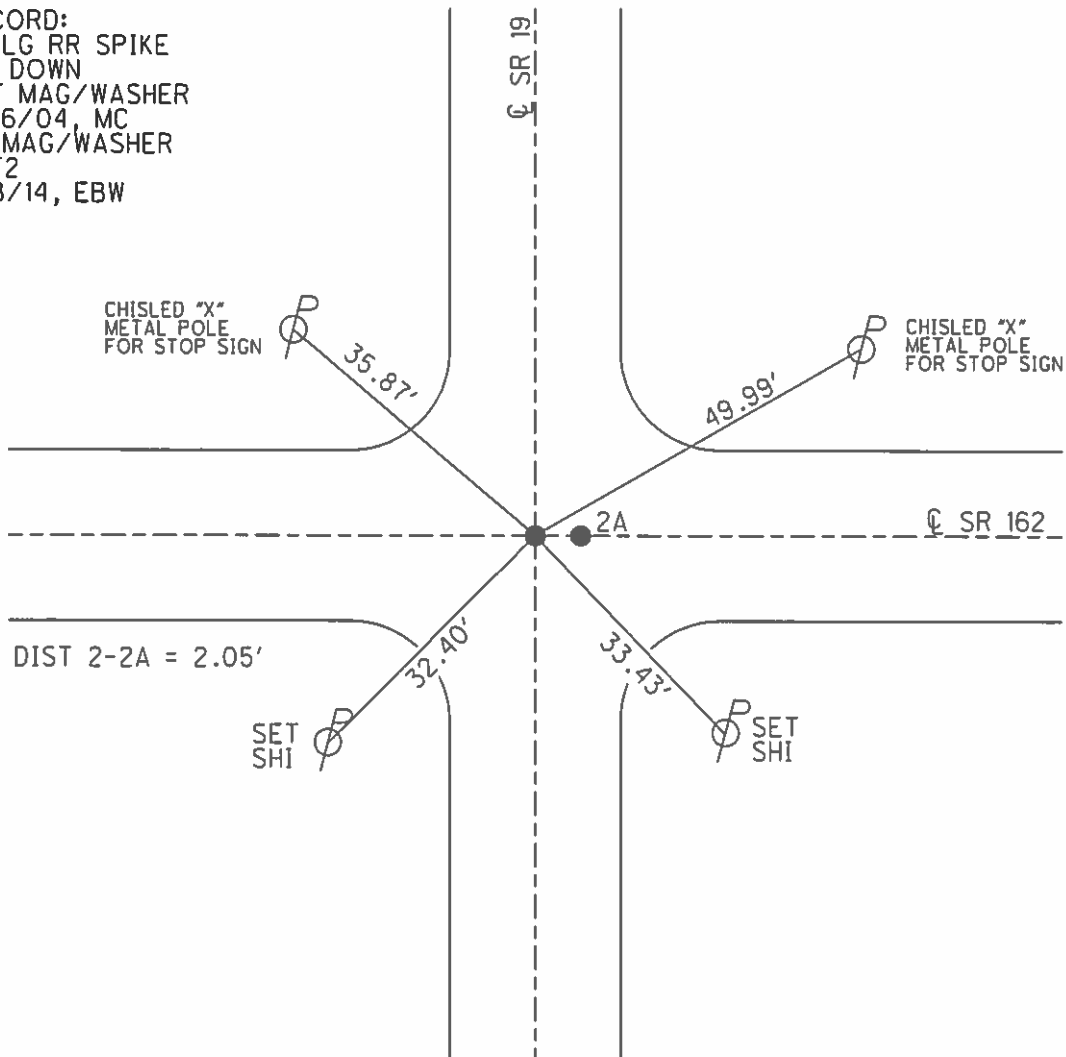

O.D.O.T. DISTRICT 2 SURVEY OFFICE

PERSONNEL

REFERENCE NO. 2

SHEET 2 OF 30

NOTES
H.C. HUMAN
R.C. NUHFER
ARMS
HOOKER

DATE 4-15-04
WEATHER SUNNY
TEMP. 65°

ROUTE SR 162
COUNTY SENECA
TOWNSHIP SCIPPIO
SECTION 15-16-21-22
T 2 N R 16 E

TYPE MONUMENT PK & WASHER'S
ON SURFACE ~~BELOW~~ ON BOTH
~~LEFT~~ - C PAV'T - RIGHT A ON C B 2' RT
TO EDGE PAVEMENT
S.L.M. 3+73

16	15
21	22




Notes:

FD LG RR SPIKES AT BOTH
LOCATIONS 4 1/4" DOWN

SET MAG NAIL
& WASHER
AT BOTH
LOCATIONS
10-06-04
MC

CHISLED "X"
METAL POLE
FOR STOP SIGN

CHISLED "X"
METAL POLE
FOR STOP SIGN

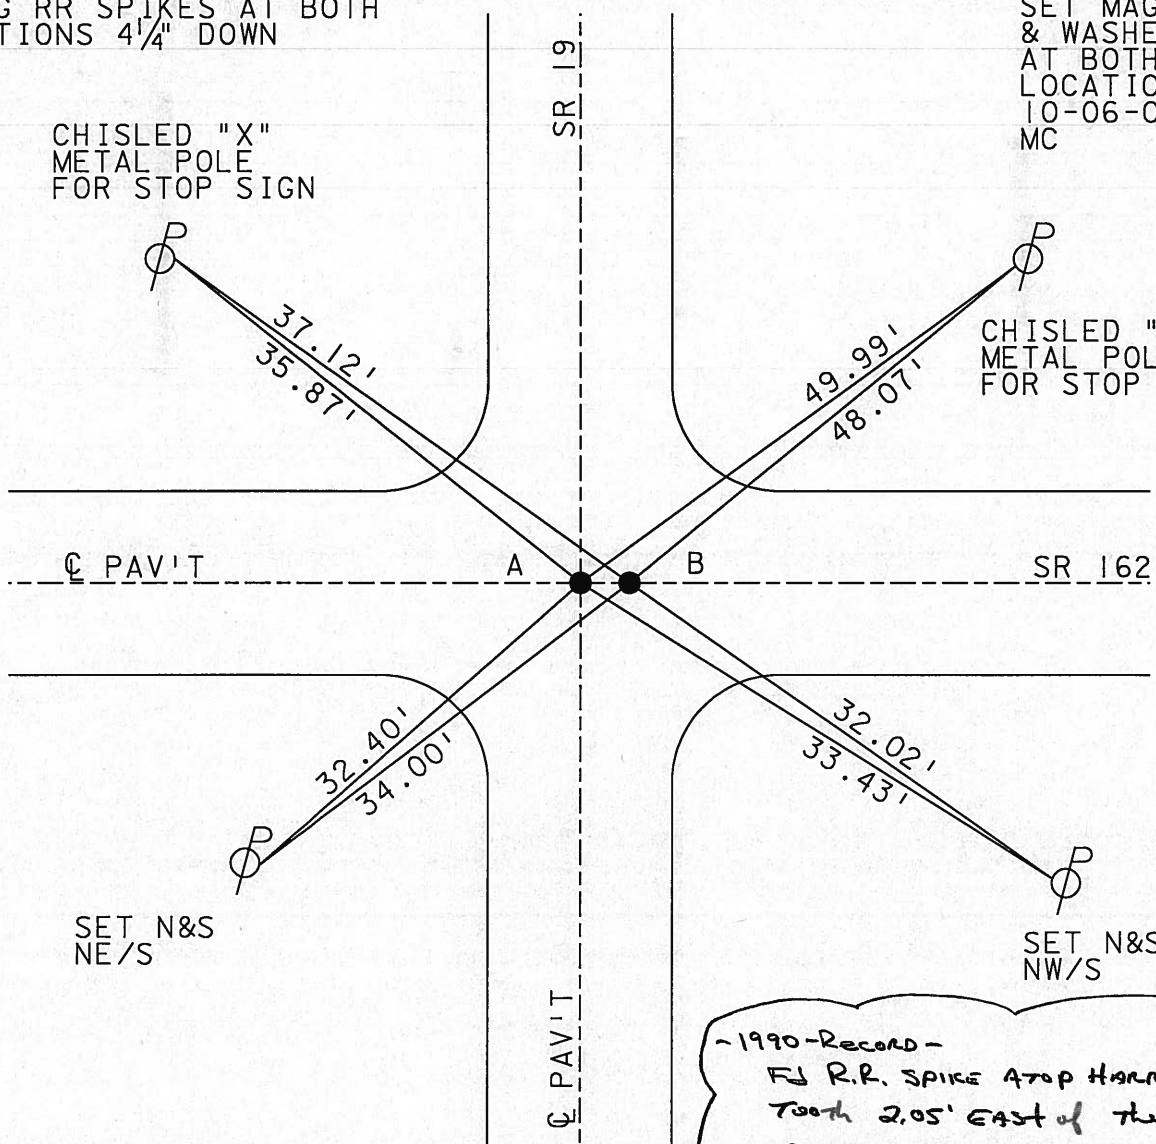

DIST A-B = 2.05'

O.D.O.T. DISTRICT 2 SURVEY OFFICE

PERSONNEL Hansen

REFERENCE NO. 2

SHEET 2 OF 30

NOTES Pippie

H.C. Barbour Washer

DATE 7-18-90 4-15-04

ROUTE 162

R.C. Gayman Arms

WEATHER Sunny

COUNTY Sen.

Hooker

TEMP. 65°

TOWNSHIP Scipio

SECTION 15-16-21-22

T 2 N R 16 E

TYPE MONUMENT P.K. + Washer

ON SURFACE - BELOW CORNER STONE 9" down

LEFT- & PAV'T. - RIGHT 2' W OF & POINT

TO EDGE PAVEMENT


S.L.M. 3+73

14	15
21	22



Dist A-B 2.05'

RESET NAG/WASHERS @ BOTH
10/6/04
M.C.

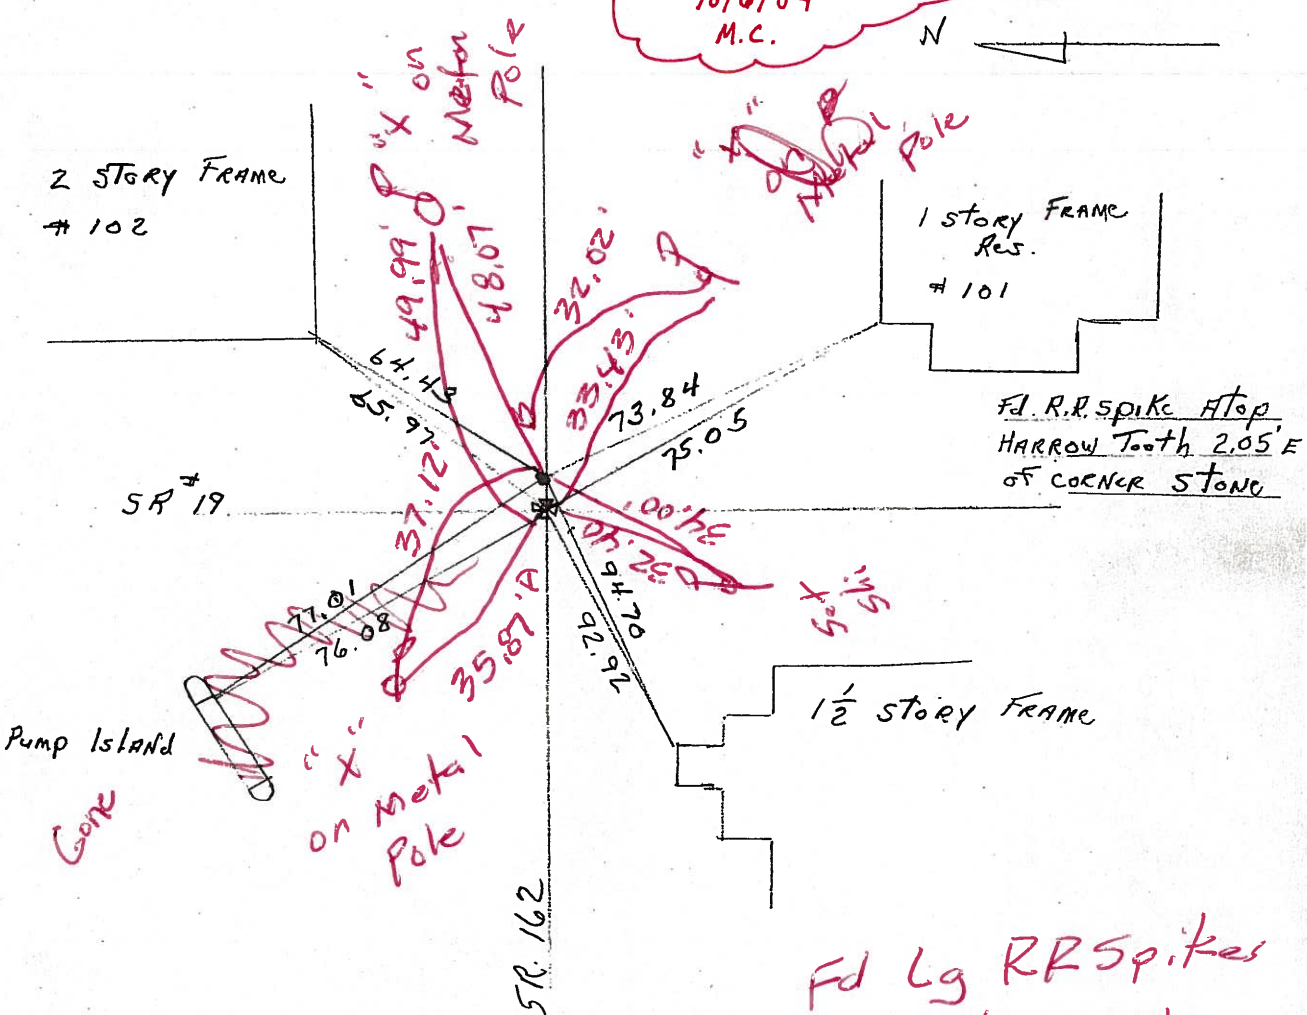

FD LG RR SPIKES
at Both points
4 1/4" Down

O.D.O.T. DISTRICT 2 SURVEY OFFICE

PERSONNEL

REFERENCE NO. 2

SHEET 2 OF 30

NOTES Ripple

H.C. BARBOUR

R.C. GEYMAN

DATE 7-18-90

WEATHER _____

TEMP. _____

ROUTE 162

COUNTY Sen.


TOWNSHIP Scipio

SECTION 15-16-21-22

T 2 N R 16 E

TYPE MONUMENT P.K. + Washer
 ON SURFACE - BELOW CORNER STONE 9" down
 LEFT - & PAW'T. - RIGHT 2' W of E Pavmt
 TO _____ EDGE PAVEMENT
 S.L.M. _____

14	15
21	22

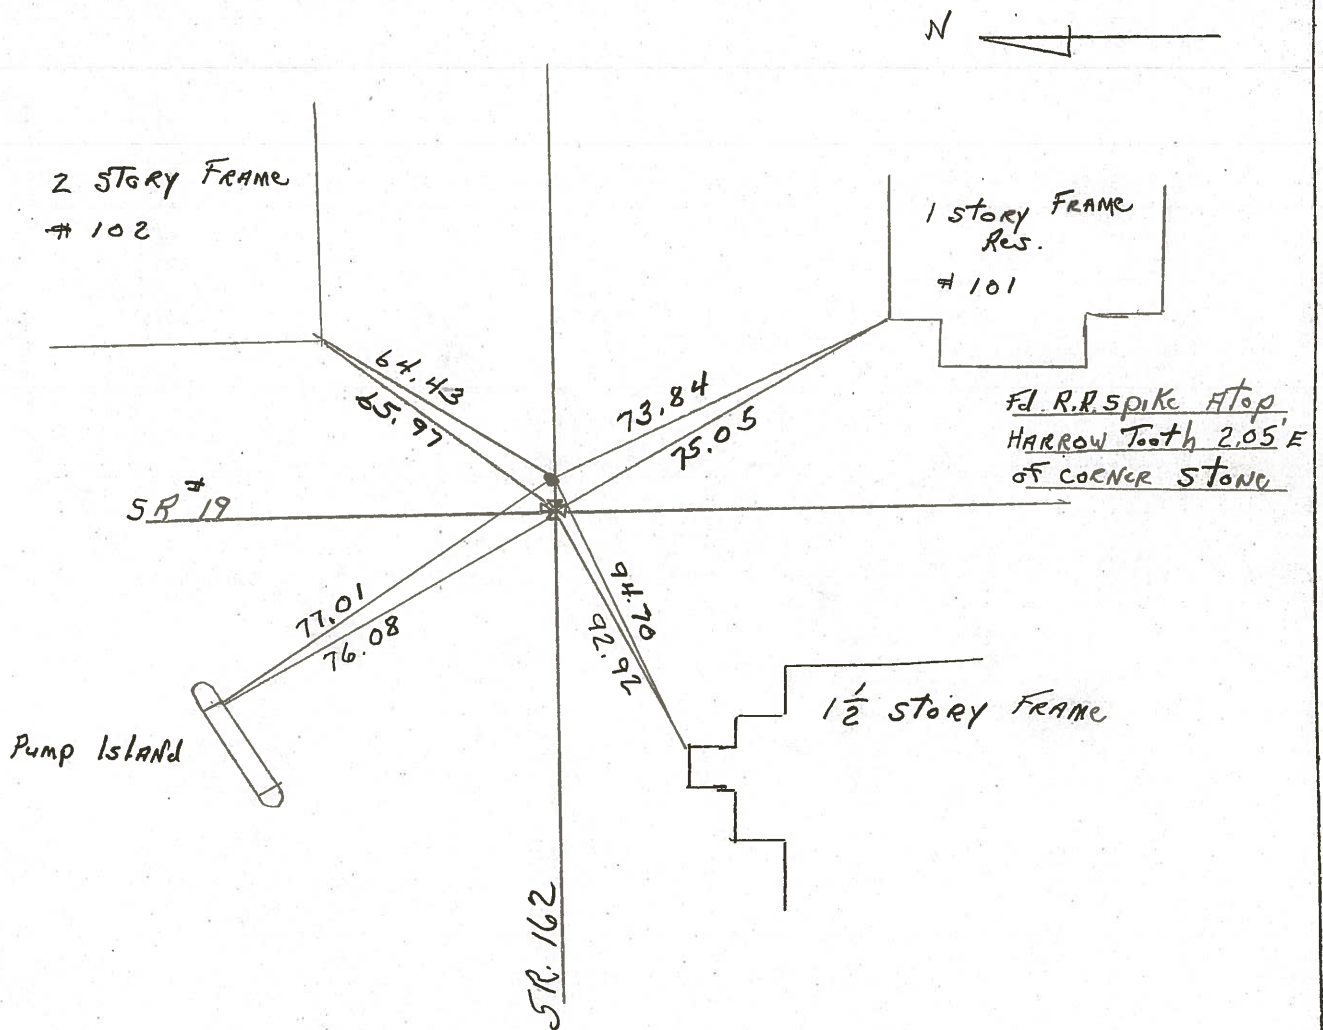


County Seneca S.R. # 162Township ScipioSection 15, 16, 21, 22T 2 N, R 16 EPersonnel CravinRippleGeymanBarbour

#2


Date 11/09/84Weather overcastTemp. 25°

16	15
21	22

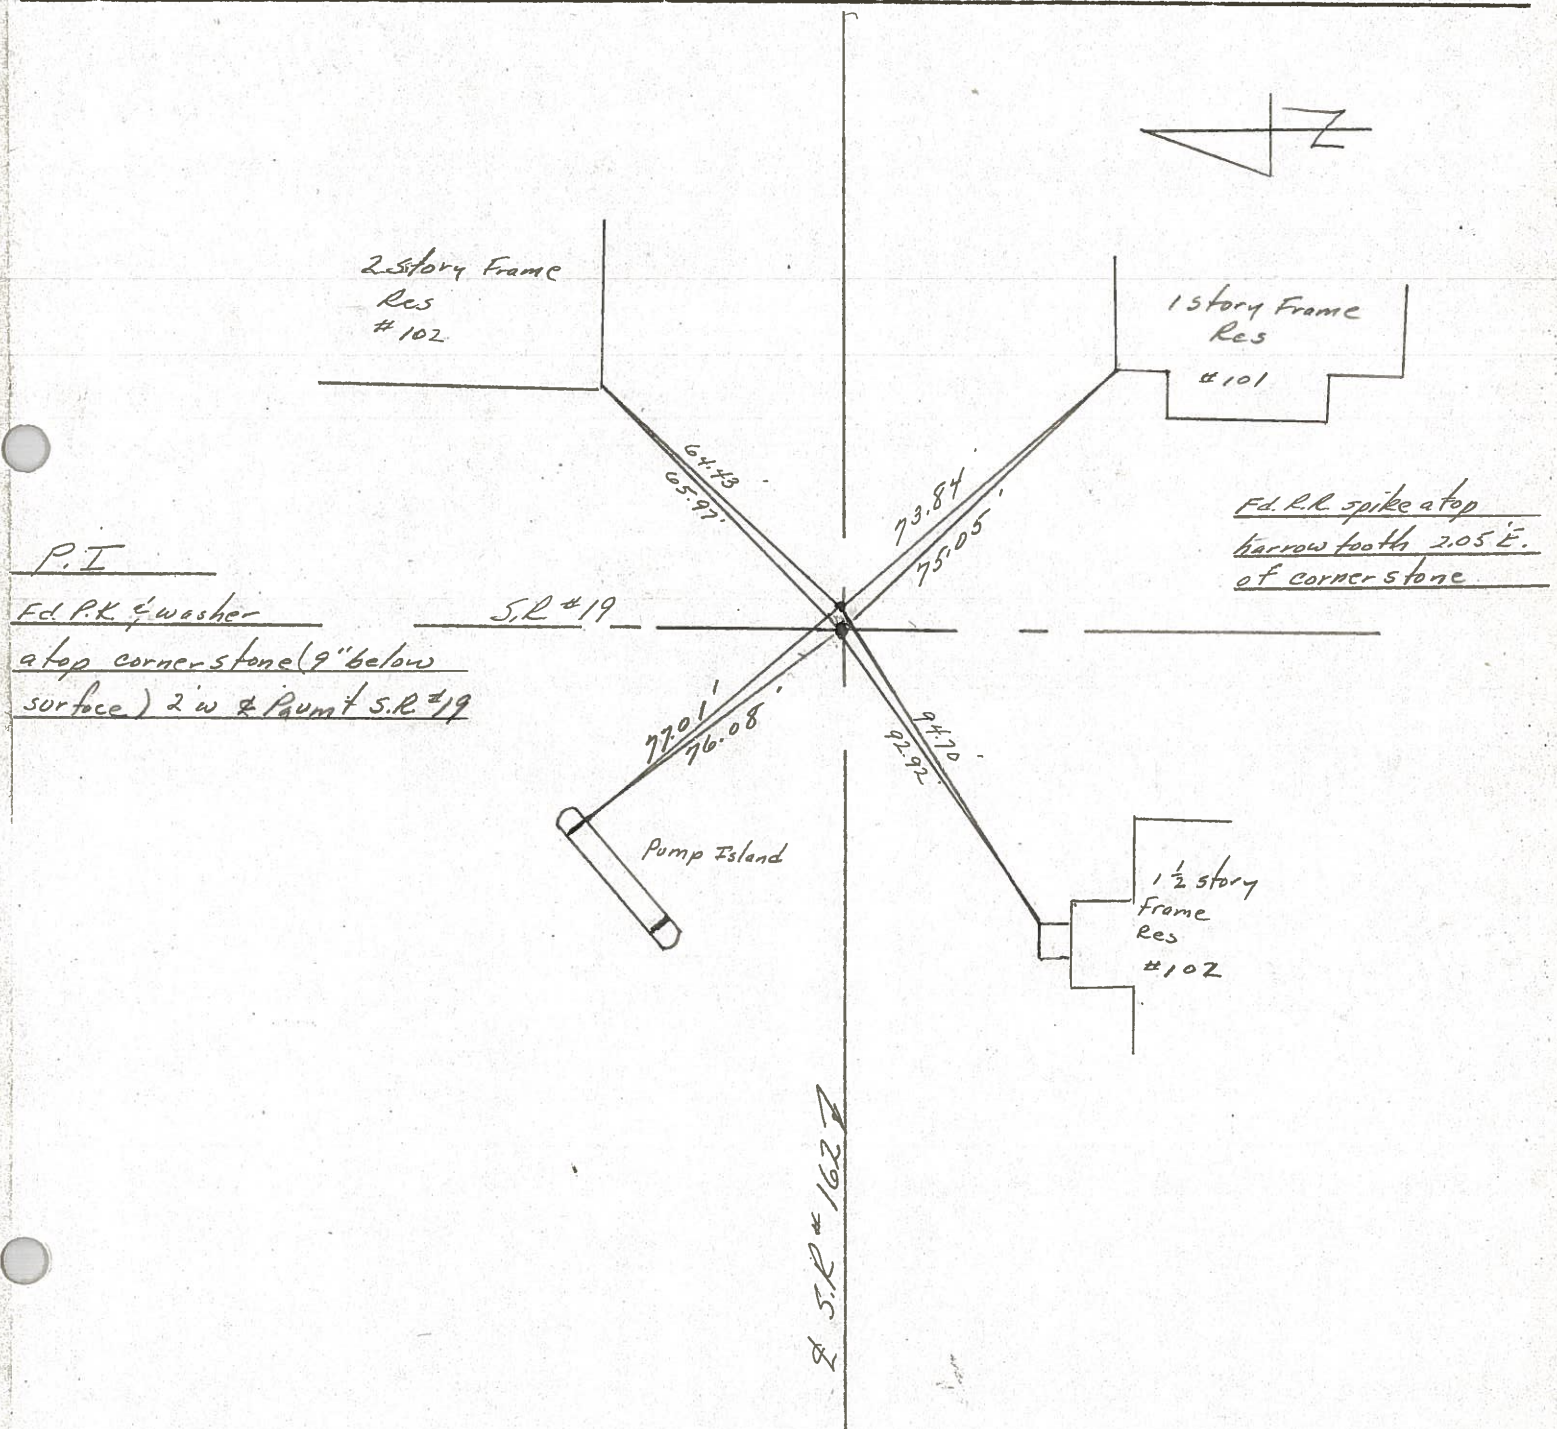

County Seneca S.R. # 162Township SciprioSection 16, 15 & 21, 22T N, R EPersonnel SchneiderMosserBarbourDate 6-11-79Weather FairTemp. 65°

16	15
21	22

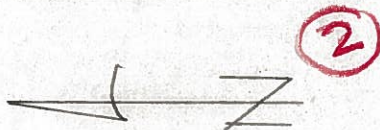

S.R. # 162

Frame
Res.
102Frame
Res.

Fd. Harrow thooth

2.05' E. of stone R.R. spk. on top

Fdt'n @ siding

Fdt'n @
Siding

P.I.

Fd. stone 9" down

P.K. Nail on top

S.R. # 19



Top 2nd. block

Frame
Res.