


O.D.O.T. DISTRICT 2 SURVEY OFFICE (USE ONLY)

PERSONNEL _____ REFERENCE NO. 16 SHEET 18 OF 32


NOTES RHOADES _____ DATE 8/1/17 ROUTE SR 162
H.C. HOMAN _____ WEATHER SUNNY COUNTY SENECA
R.C. CARSON _____ TEMP. 77° TOWNSHIP REED
POORE _____ SECTION 18
T 2 N R 17 E

TYPE MONUMENT _____ MAG/WASHER
ON SURFACE - ~~BELOW~~ ON _____
LEFT - ℄ PAV'T - ~~RIGHT~~ 2'
- TO - EDGE PAVEMENT
S.L.M. 216+40

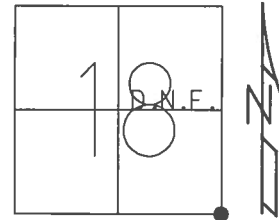

GRID: NORTHING: 531529.298 EASTING: 1847708.235

RECORD:
FD 1" IPIN
12" DOWN
SET MAG/WASHER
10-06-04, DCH
FD MAG/WASHER
REF16
5/31/16, JFO
SET 1" MAG/WASHER
8/1/17, DCH

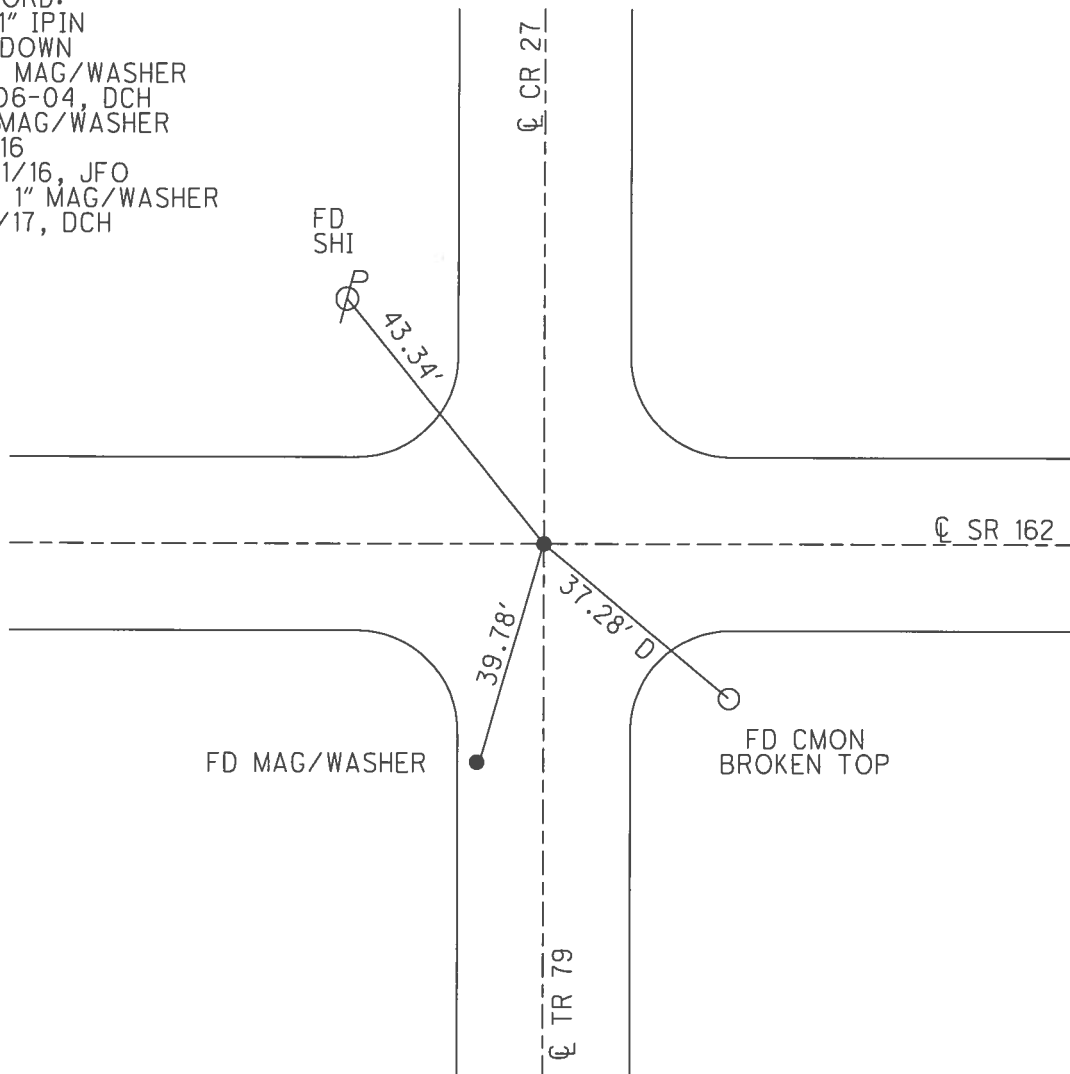

O.D.O.T. DISTRICT 2 SURVEY OFFICE (USE ONLY)

PERSONNEL

REFERENCE NO. 16

SHEET 18 OF 32

NOTES

HOMAN

DATE

7/13/04

ROUTE SR 162

H.C.

BARNHISEL

WEATHER

CLOUDY

COUNTY SENECA

R.C.

CANTERBURY

TEMP.

80°

TOWNSHIP REED

SECTION 18

T 2 N R 17 E

TYPE MONUMENT

P.K./WASHER

~~ON SURFACE~~ - BELOW

1"

LEFT - Q PAV'T - ~~RIGHT~~

2'


- TO - EDGE PAVEMENT

S.L.M.


216+40

GRID: NORTHING:

EASTING:

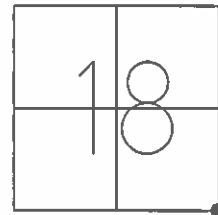

RECORD:
FD 1" IPIN
12" DOWN
SET MAG/WASHER
10-06-04, DCH

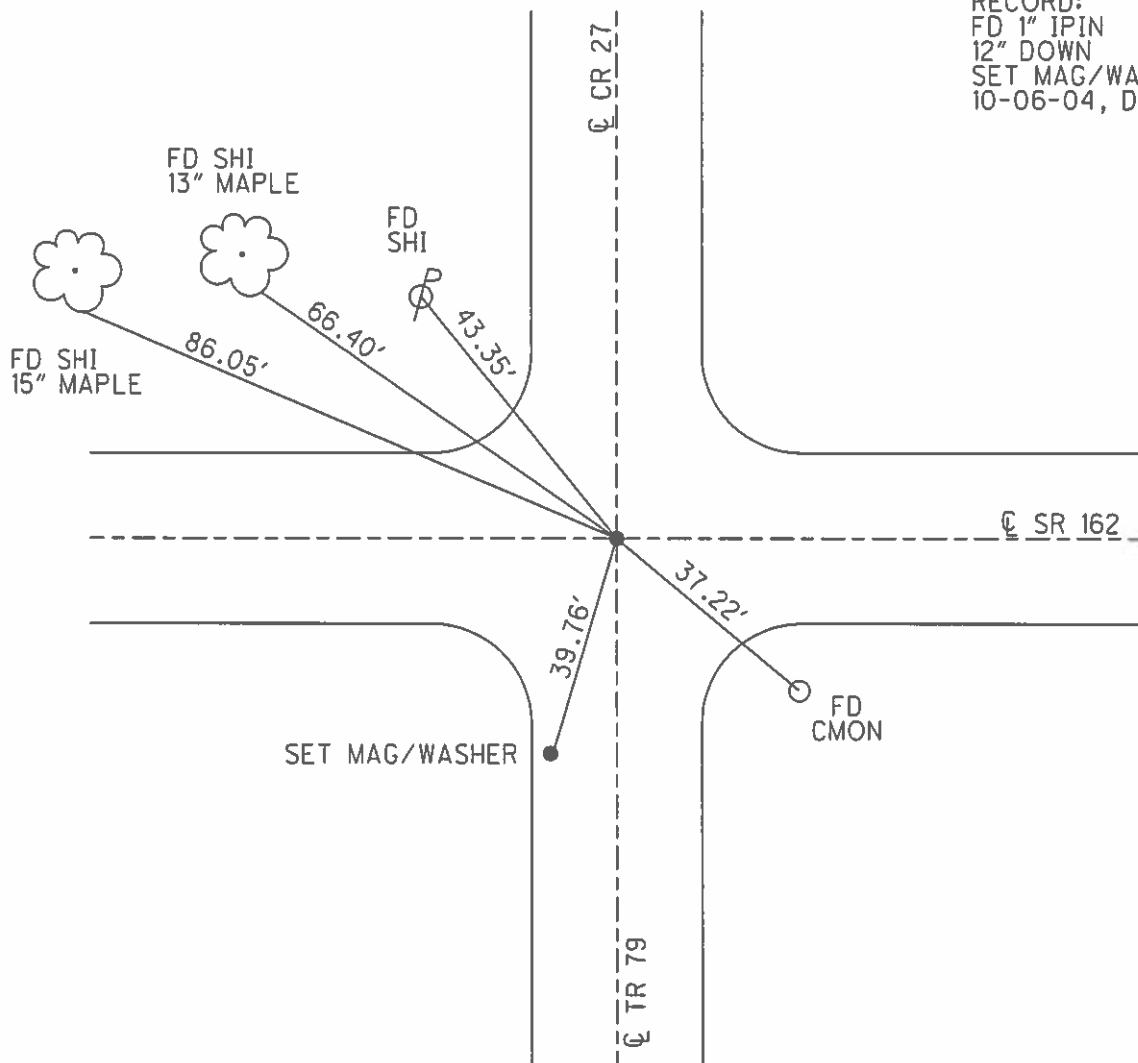

O.D.O.T. DISTRICT 2 SURVEY OFFICE

PERSONNEL

REFERENCE NO. 16

SHEET 16 OF 30

NOTES

HOMAN

DATE 7-13-04

ROUTE SR 162

H.C.

BARNHISEL

WEATHER CLOUDY

COUNTY SENECA

R.C.

CANTERBURY

TEMP. 80°

TOWNSHIP REED

SECTION 17-18-19-20

T 2 N R 17 E

TYPE MONUMENT SEE BELOW

ON SURFACE - BELOW SEE BELOW

LEFT CL PAVT - RIGHT 2' LT

TO EDGE PAVEMENT


S.L.M. 216+40

18	17
19	20



2004 FD PK & WASHER 1 1/2" DOWN
OVER A 3/4" IRON PIN 12" DOWN

SET MAG NAIL
& WASHER
10-06-04
DCH

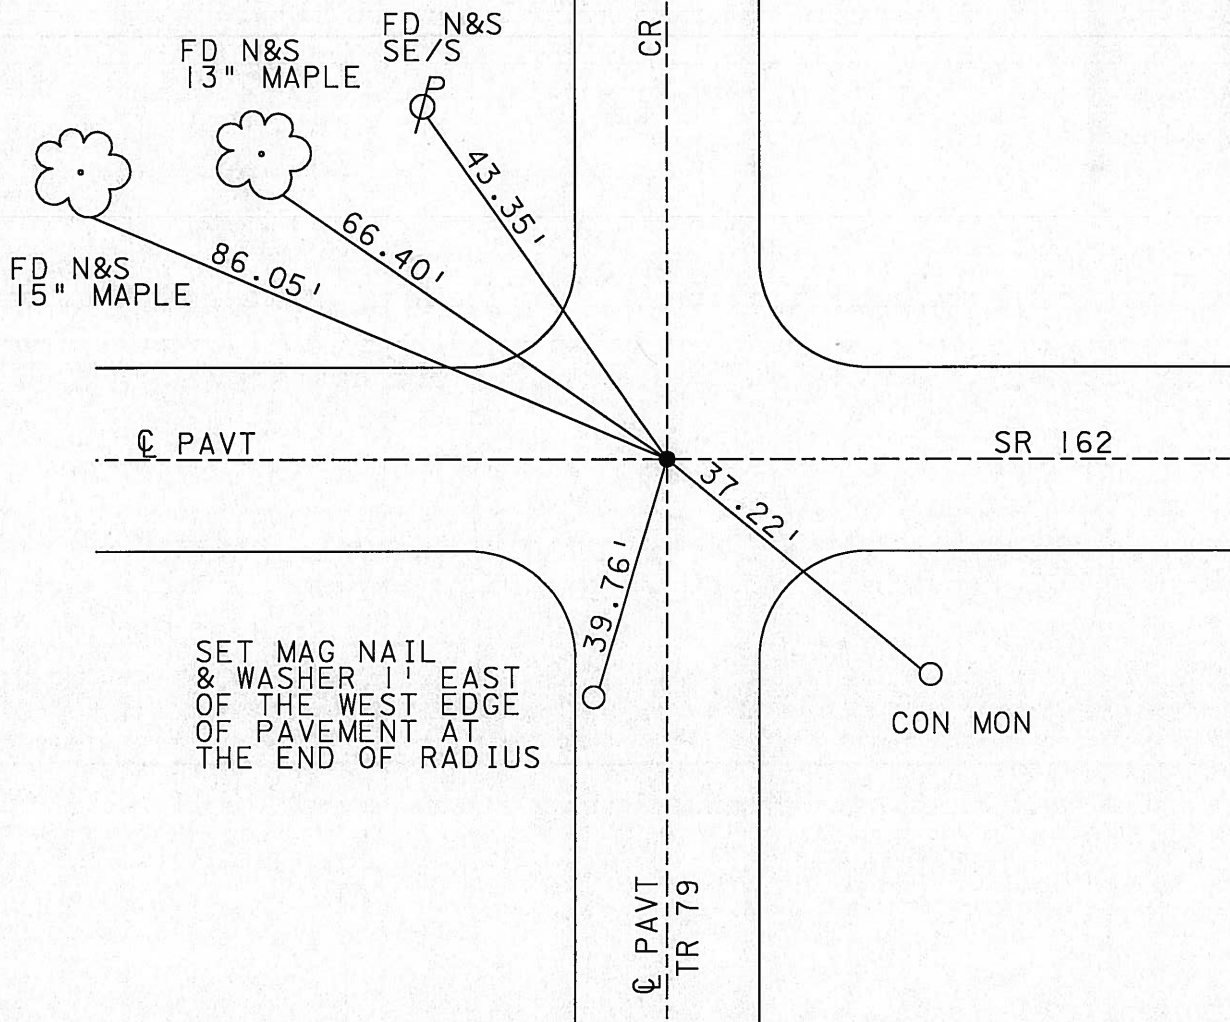

O.D.O.T. DISTRICT 2 SURVEY OFFICE

PERSONNEL

REFERENCE NO. 16

SHEET 16 OF 30

NOTES Ripple Homan

H.C. Barnhisel

DATE 7-13-04

ROUTE 162

R.C. Geyman

WEATHER Cloudy Windy Cloud

COUNTY Seneca

Canterbury

TEMP. 46 80°

TOWNSHIP Recd

SECTION 17 18 19 20

T2 N R 17 E

TYPE MONUMENT PK & Washer

ON SURFACE - BELOW PK & Washer MINI Spt. Spt

LEFT- & PAW'T. - RIGHT 2' LT & CORNER STONE

TO EDGE PAVEMENT

S.L.M. 216 + 40 373 + 60.45


18	17
19	20



Fd PK Nail & Washer 1 1/2" Down N
Fd 3/4" Iron Pin 12" Down

Set Masonry Nails
2' E, W, N & S

Reset Mag Nail
& Washer
10-06-04
DCM

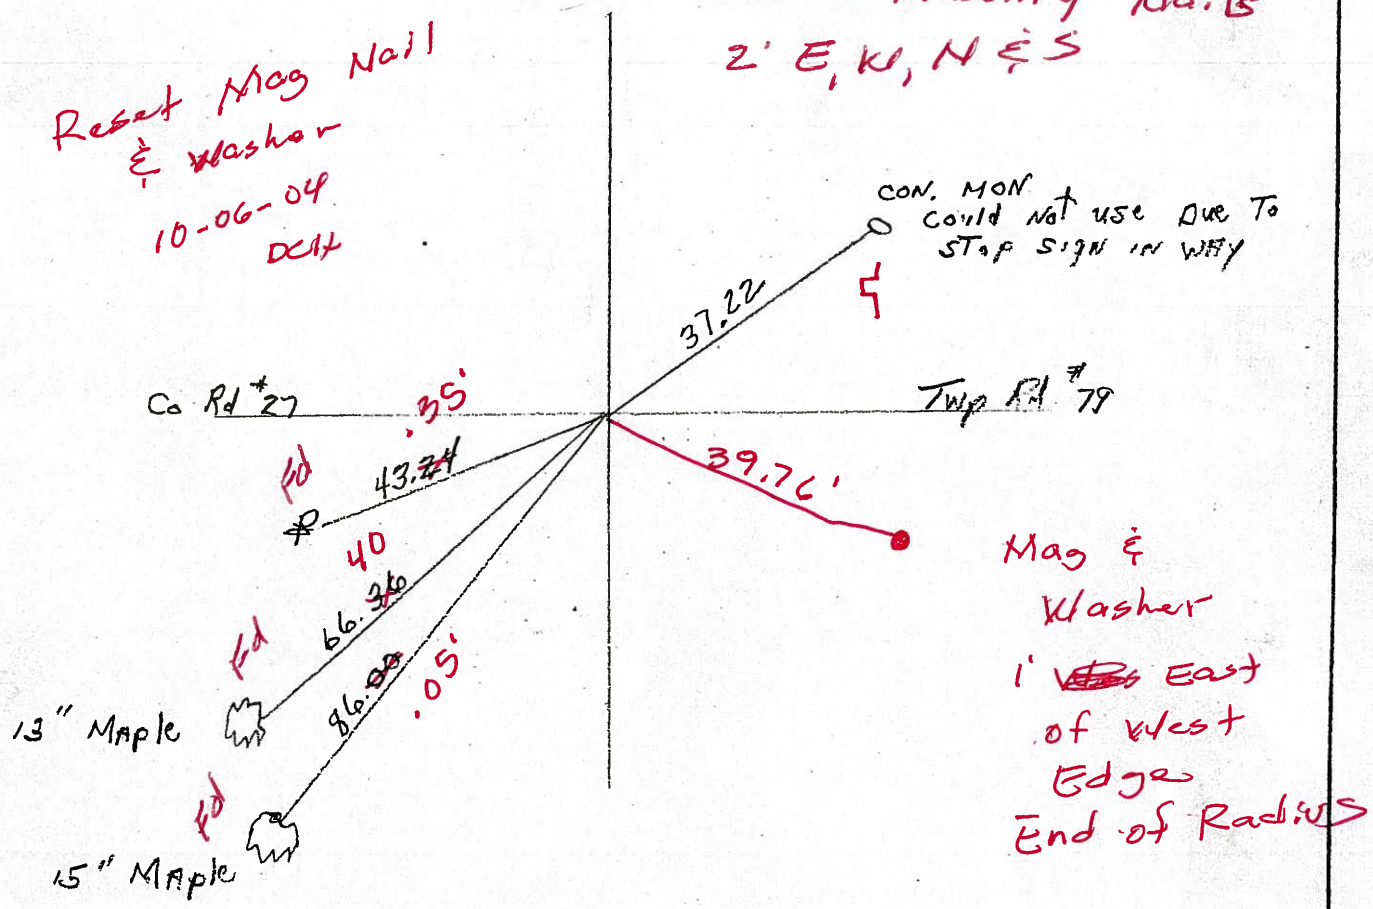

O.D.O.T. DISTRICT 2 SURVEY OFFICE

PERSONNEL

REFERENCE NO. 16

SHEET 16 OF 30

NOTES Ripple

H.C. Barbours

R.C. Geyman

DATE 10-24 90

WEATHER Cloudy Windy

TEMP. 46

ROUTE 162

COUNTY Sen

TOWNSHIP Reed

SECTION 17 18 19 20

T 2 N R 17 E

TYPE MONUMENT PK + Washer



ON SURFACE - BELOW PK + Washer at MIN. Spt. at

LEFT - & PAV'T. - RIGHT 2' LT at CORNER STAKE

TO EDGE PAVEMENT

S.L.M. 216 + 40

18	17
19	20

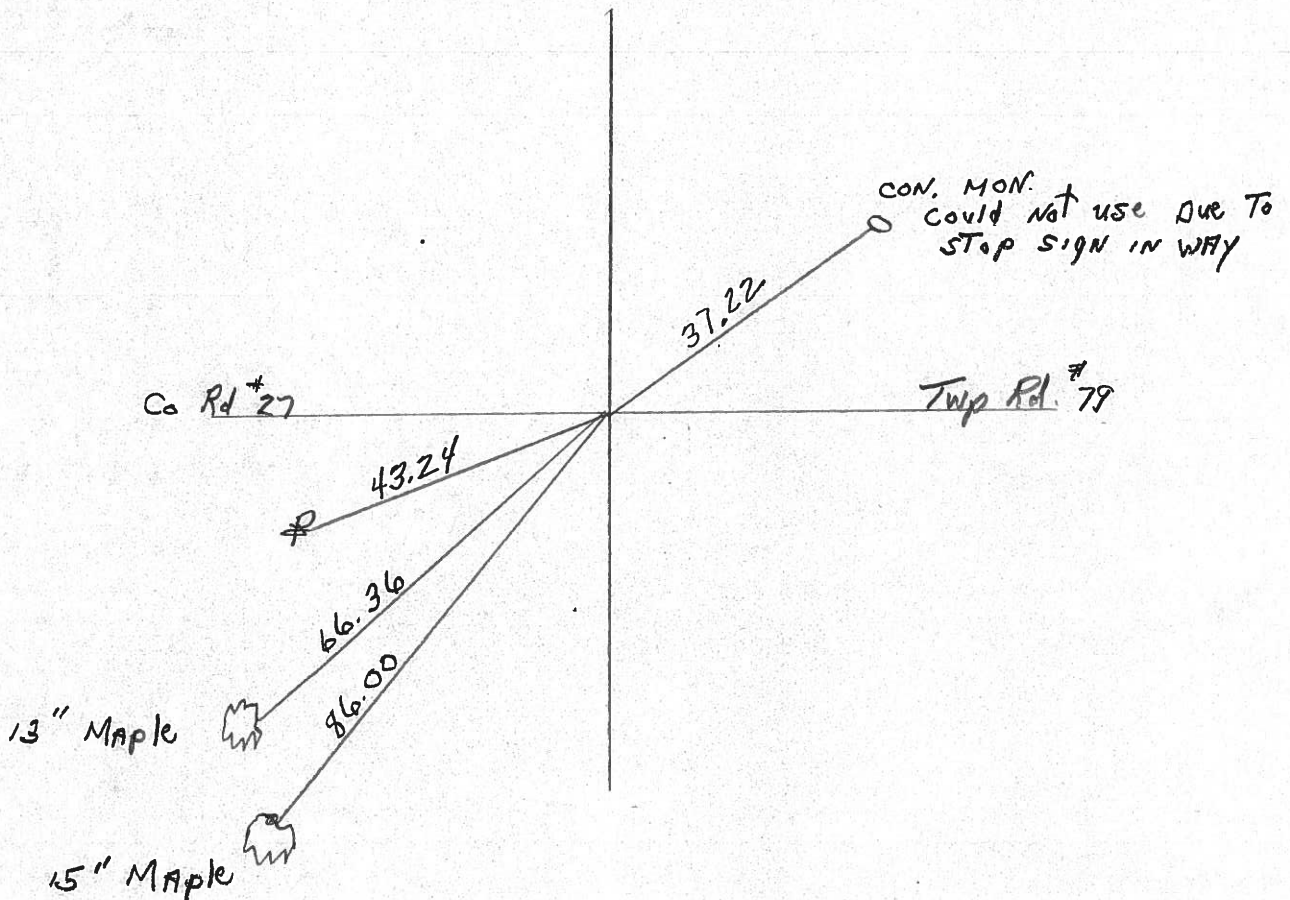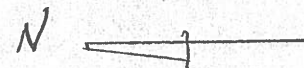

Q.D.O.T. DISTRICT 2 SURVEY OFFICE

SHEET 16 OF 30

County Seneca S.R. #162

Township Reed

Section 17, 18, 19, 20

T2N, R17E

Personnel Cronin

Ripple

Geyman

Date 12/20/83

Weather sunny

Temp. 17°

18	17
19	20



#16




P.I. $\Delta = 00^\circ 42' \text{ R.L.}$

373+60.45

set P.R. & washer at top
min. spike at top corner
stone 2' L. & R. unit.

Co. Rd. #27

Twp Rd. #79

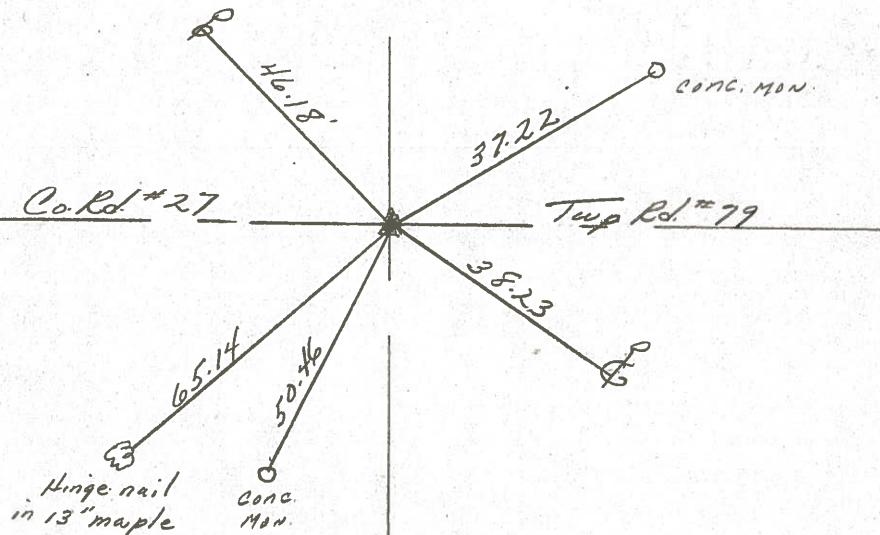

S.R. #162

County Seneca S.R. 162

Date 6-12-79

Township Reed

Weather Fair

Section 18, 17 & 19, 20

Temp. 70°

T₂N, R₁₇E

Personnel Schneider

Mosser

Barbour

18	17
19	20



(16)




373+60.45

small R.R. spk.

4" below surface

$\Delta = 0^{\circ} 42' \text{ Rt.}$

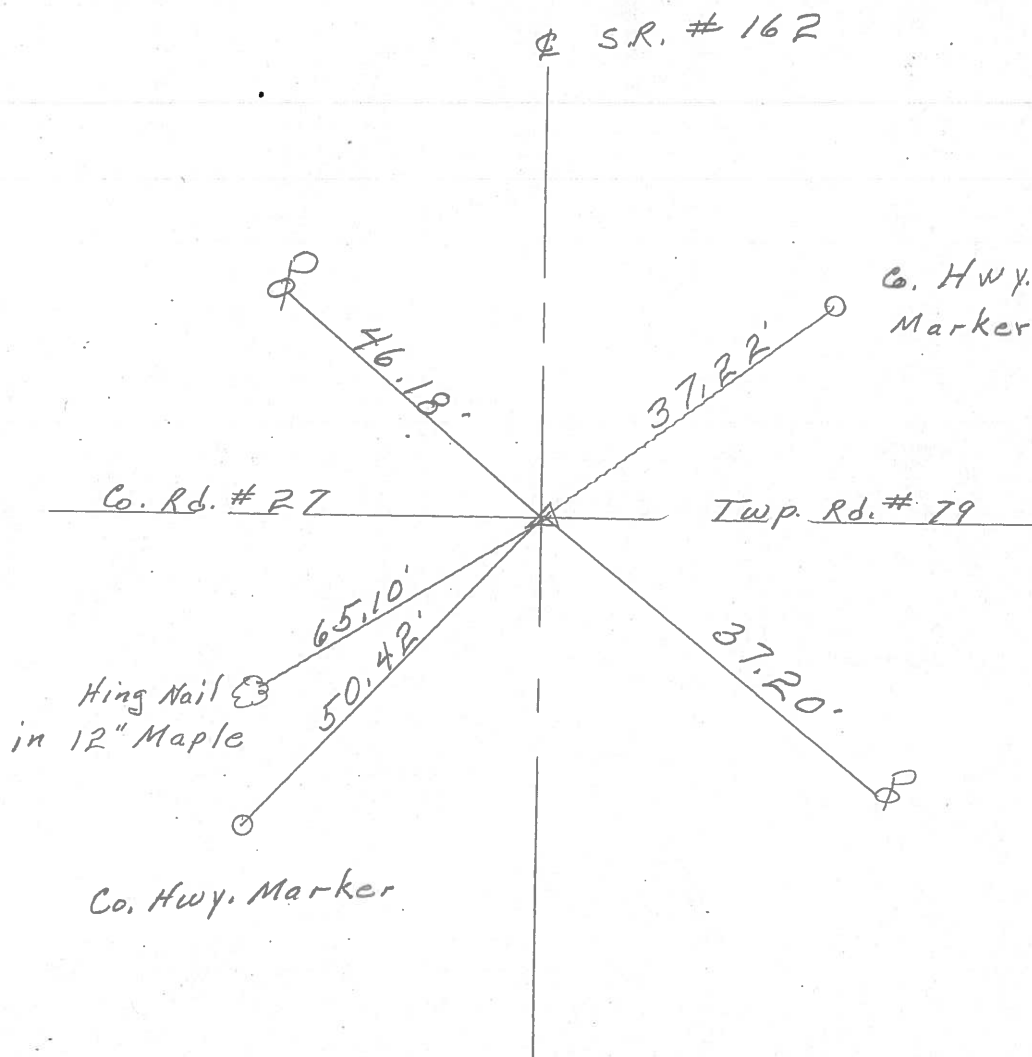

S. H. 447 Sec. M.

(14)

347+18.7

Iron Pipe on $\angle$

(13)

Fd 4-21-04

(15)

353+34.5

Harrow Tooth on $\angle$

Fd G. R. R Spike

4-21-04

(16)

373+60.45

Cor. Stone on $\angle$

(15)

Fd Iron $\angle$ Pin

4-21-04

(17)

393+00

Cor Stone on $\angle$

(16)

Fd 4-22-04

(18)

400+07.9

Cor. Stone on $\angle$

Fd 4-22-04

(19)

426+43.3

Cor. Stone on $\angle$

Fd 4-22-04

