

O.D.O.T. DISTRICT 2 SURVEY OFFICE (USE ONLY)

PERSONNEL

REFERENCE NO. 12 B

SHEET 17 OF 40

NOTES NIESE

DATE 4/28/22

ROUTE SR 15

H.C. AUBLE

WEATHER SUNNY

COUNTY WILLIAMS

R.C. PARADYZ

TEMP. 40°

TOWNSHIP MADISON

DWG BY RHOADES PID 95786

SECTION 28

T 9 S R 2 W

TYPE MONUMENT MONBOX W/ 1" IPIN

ON SURFACE - ~~BELOW~~ ON

OFFSET Q PAVEMENT ON LT : RT

- TO - EDGE PAVEMENT


STATION: 150+19.13

HORIZ.DATUM: NAD83 2011

GEOID: NAVD88 2012B

GRID: NORTHING: 733233.366

EASTING: 1407433.926

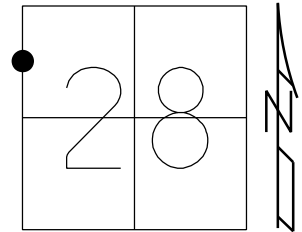

RECORD:

FD MONBOX

5/29/07, RGN

3/24/20, JLL

FD MONBOX

W/ 1" IPIN

REFB12


4/28/22

9/20/22, DSA

FD MONBOX W/ 1" IPIN

REF 12B

9/18/24, TDN

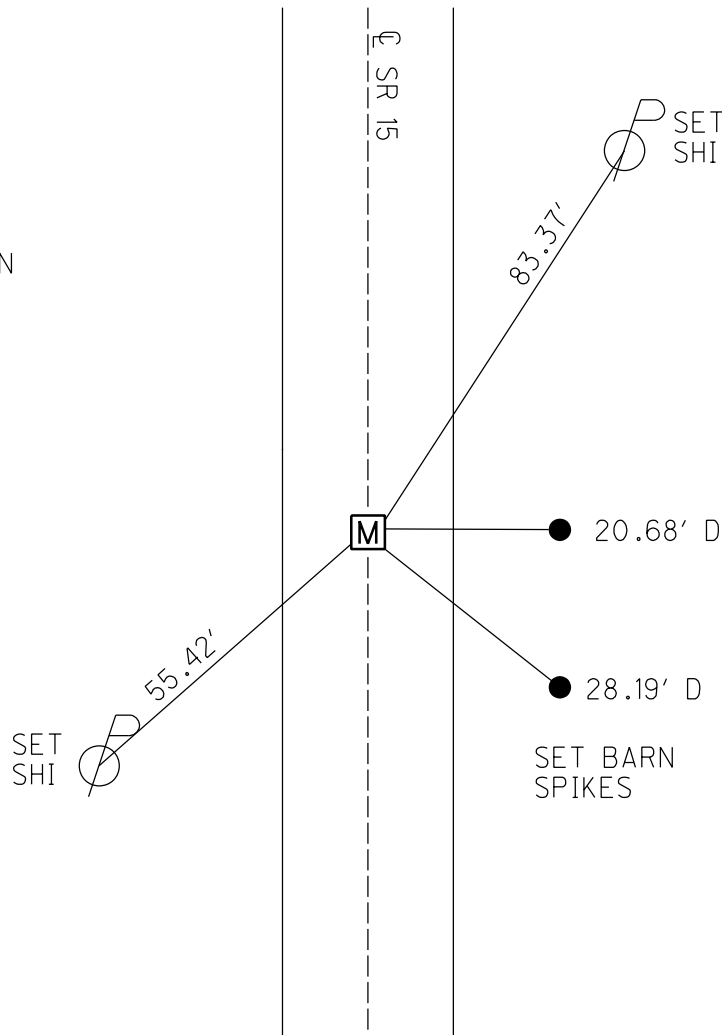

O.D.O.T. DISTRICT 2 SURVEY OFFICE (USE ONLY)

PERSONNEL

REFERENCE NO. 12 B

SHEET 17 OF 40

NOTES NIESE DATE 4/28/22
H.C. AUBLE WEATHER SUNNY
R.C. PARADYZ TEMP. 40°

ROUTE SR 15
COUNTY WILLIAMS
TOWNSHIP MADISON
SECTION 28

DWG BY RHOADES PID 95786

T 9 S R 2 W

TYPE MONUMENT MONBOX W/ 1" IPIN

ON SURFACE - ~~BELOW~~ ON

OFFSET ℄ PAVEMENT ON LT : RT

- TO - EDGE PAVEMENT


STATION: 150+19.13

HORZ.DATUM: NAD83 2011


GEOID: NAVD88 2012B

GRID: NORTHING: 734860.263

EASTING: 1407464.081

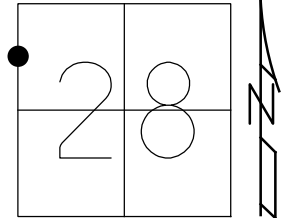

RECORD:
FD MONBOX
5/29/07, RGN
3/24/20, JLL
FD MONBOX
W/ 1" IPIN
REFB12
4/28/22
9/20/22, DSA

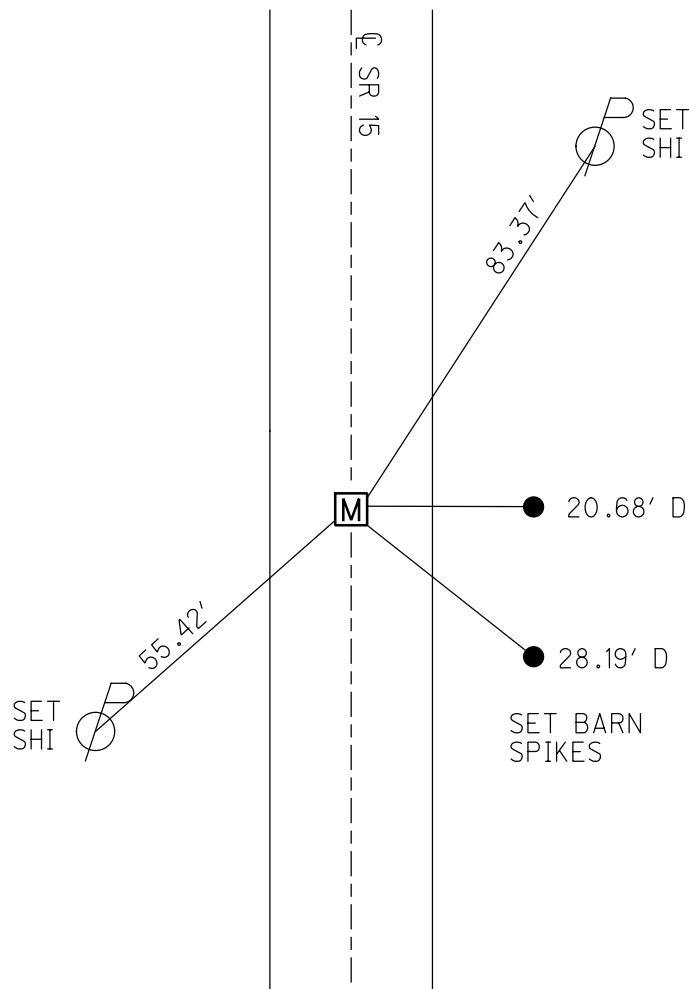


O.D.O.T. DISTRICT 2 SURVEY OFFICE (USE ONLY)

PERSONNEL _____ REFERENCE NO. 12 B SHEET 16 OF 39
NOTES NUHFER DATE 5/29/07 ROUTE SR 15
H.C. HUSS WEATHER SUNNY COUNTY WILLIAMS
R.C. HOUDSHELL TEMP. 74° TOWNSHIP MADISON
SECTION 21
T 9 S R 2 W

TYPE MONUMENT IPIN IN MON.BOX
ON SURFACE - ~~BELOW~~ ON
LEFT - ☉ PAV'T - RIGHT ON
- TO - EDGE PAVEMENT
S.L.M. 150+26.88

GRID: NORTHING: 733233.491 EASTING: 1407433.900

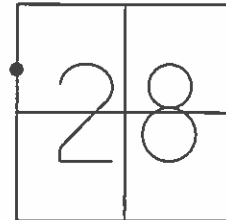

NOTE: ESTABLISHED WIL-15-2.78 PLAN

