

O.D.O.T. DISTRICT 2 SURVEY OFFICE (USE ONLY)

PERSONNEL

REFERENCE NO. 14

SHEET 19 OF 40

NOTES NIESE

DATE 4/28/22

ROUTE SR 15

H.C. AUBLE

WEATHER SUNNY

COUNTY WILLIAMS

R.C. PARADYZ

TEMP. 40°

TOWNSHIP MADISON

DWG BY RHOADES PID 95786

SECTION 33

T 9 S R 2 W

TYPE MONUMENT MAG/WASHER

ON SURFACE - ~~BELOW~~ ON

OFFSET Q PAVEMENT 0.3' LT : ~~RT~~

13.5' TO RT EDGE PAVEMENT


STATION: 186+83.99

HORZ.DATUM: NAD83 2011

GEOID: NAVD88 2012B

GRID: NORTHING: 729569.172

EASTING: 1407367.714

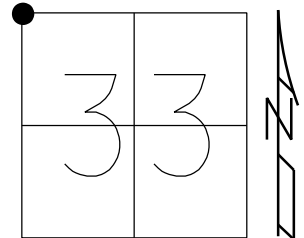

RECORD:

FD P.K./WASHER

8/31/88, MB

5/30/07, RGN

SET MAG/WASHER

9/4/07, RGN

FD MAG/WASHER

REF14

3/24/20, JLL

4/28/22


SET MAG/WASHER

9/20/22, DSA

FD MAG/WASH

REF13

9/18/24, TDN

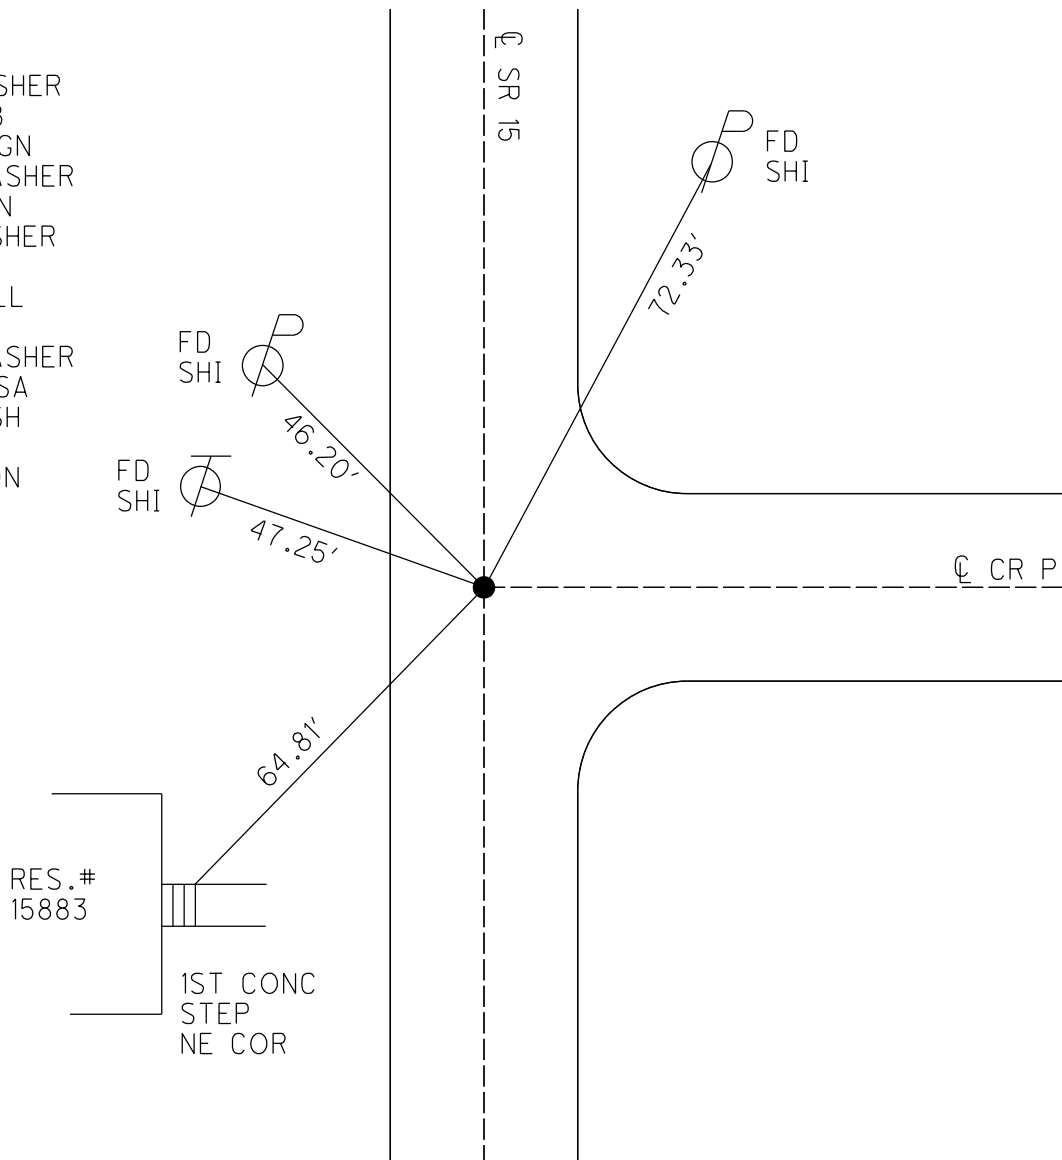

O.D.O.T. DISTRICT 2 SURVEY OFFICE (USE ONLY)

PERSONNEL

REFERENCE NO. 14

SHEET 19 OF 40

NOTES NIESE

DATE 4/28/22

ROUTE SR 15

H.C. AUBLE

WEATHER SUNNY

COUNTY WILLIAMS

R.C. PARADYZ

TEMP. 40°

TOWNSHIP MADISON

SECTION 33

DWG BY RHOADES PID 95786

T 9 S R 2 W

TYPE MONUMENT MAG/WASHER

ON SURFACE - ~~BELOW~~ ON

OFFSET CL PAVEMENT 0.3' LT : ~~RT~~

13.5' TO RT EDGE PAVEMENT


STATION: 186+83.99

HORZ.DATUM: NAD83 2011

GEOID: NAVD88 2012B

GRID: NORTHING: 729569.231

EASTING: 1407367.660

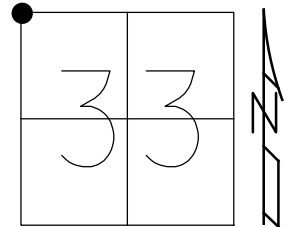

RECORD:

FD P.K./WASHER

8/31/88, MB

5/30/07, RGN

SET MAG/WASHER

9/4/07, RGN

FD MAG/WASHER


REF14

3/24/20, JLL

4/28/22

SET MAG/WASHER



9/20/22, DSA

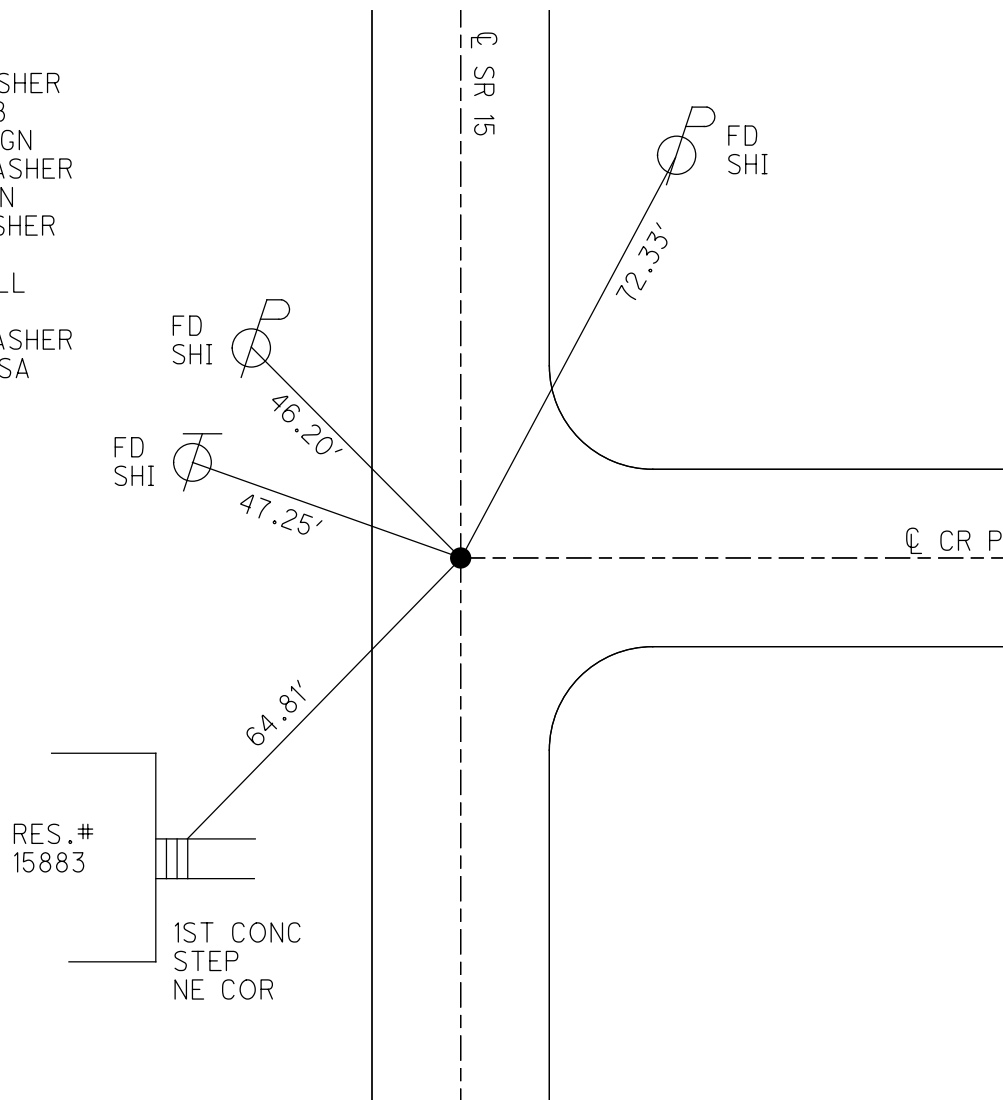

O.D.O.T. DISTRICT 2 SURVEY OFFICE (USE ONLY)

PERSONNEL	REFERENCE NO.	<u>14</u>	SHEET	<u>18</u>	OF	<u>39</u>
NOTES	NUHFER	DATE	<u>5/30/07</u>	ROUTE	<u>SR 15</u>	
H.C.	HUSS	WEATHER	<u>SUNNY</u>	COUNTY	<u>WILLIAMS</u>	
R.C.	HOUESHELL	TEMP.	<u>92°</u>	TOWNSHIP	<u>MADISON</u>	
				SECTION	<u>33</u>	
				T	<u>9</u>	R
				S		W

TYPE MONUMENT P.K./WASHER
 ON SURFACE - ~~BELOW~~ ON
 LEFT - ℄ PAV'T - ~~RIGHT~~ 0.7' EAST, ON ℄ CR P
13.5' TO RT EDGE PAVEMENT
 S.L.M. 186+92
 GRID: NORTHING: 729569.165 EASTING: 1407367.535

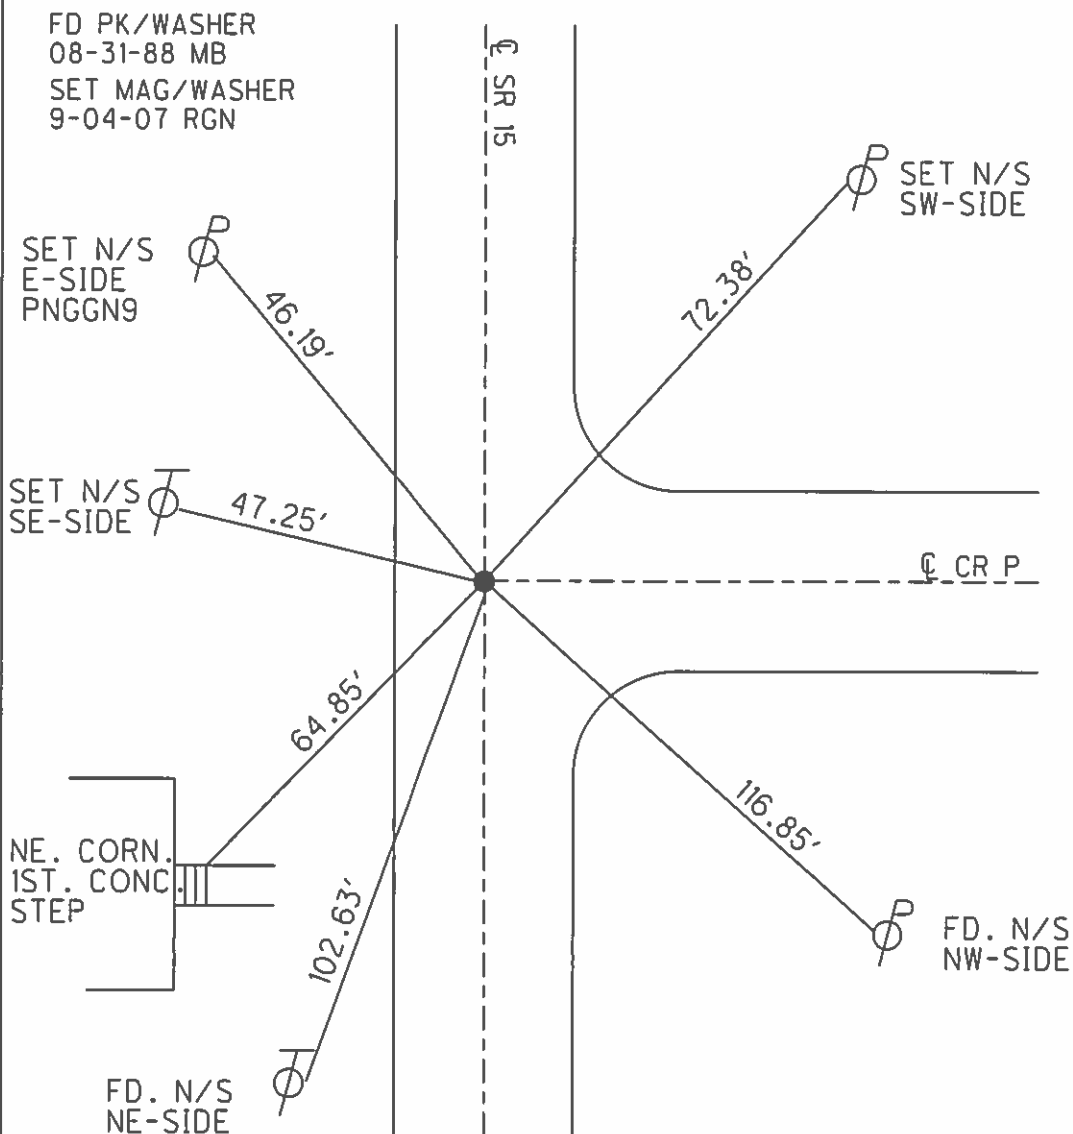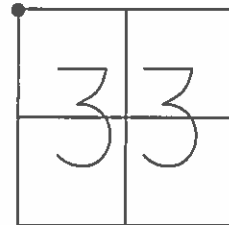

O.D.O.T. DISTRICT 2 SURVEY OFFICE

PERSONNEL

REFERENCE NO. 14

SHEET OF

NOTES BARNHISEL

H.C. Locheke

R.C. Reed

DATE 8-5-88

WEATHER Sunny

TEMP. +96°

ROUTE 15

COUNTY Williams

TOWNSHIP Madison

SECTION 33

T 9 S R 2 W


TYPE MONUMENT Sm RR Spk

ON SURFACE - BELOW yes


LEFT - Q PAW'T. - RIGHT yes - Both

124 TO R EDGE PAVEMENT

S.L.M. 186 + 92

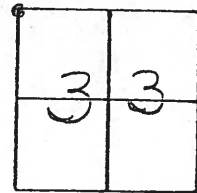


Set P.K. & Washer
8-31-88
m.B.

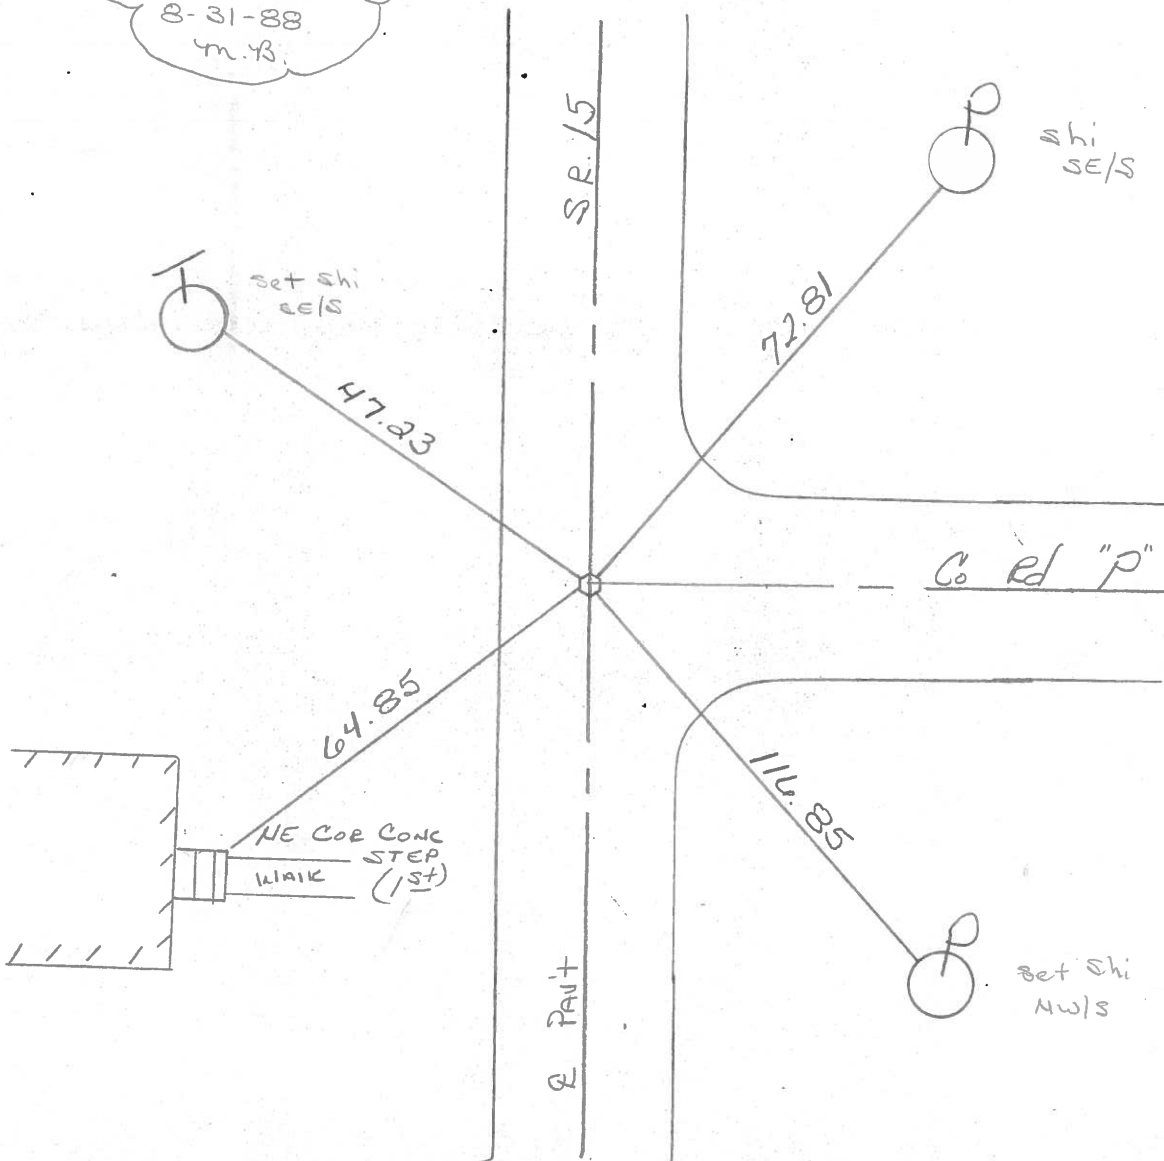

County WILLIAMS S.R. 15Township MADISONSection 33


T9S, R2E

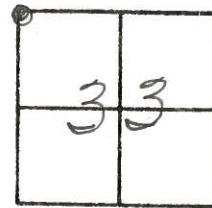Personnel HOFFMANLOEHRKEHOUSEHOLDERDate 5-13-82Weather CLEARTemp. +80°

36 (14)

FD. P.R. SPK @ SURFACE
4' ID CTR PAVEMENTS
P.I. STA. 189+66.92

Proj. Sta. 186+88

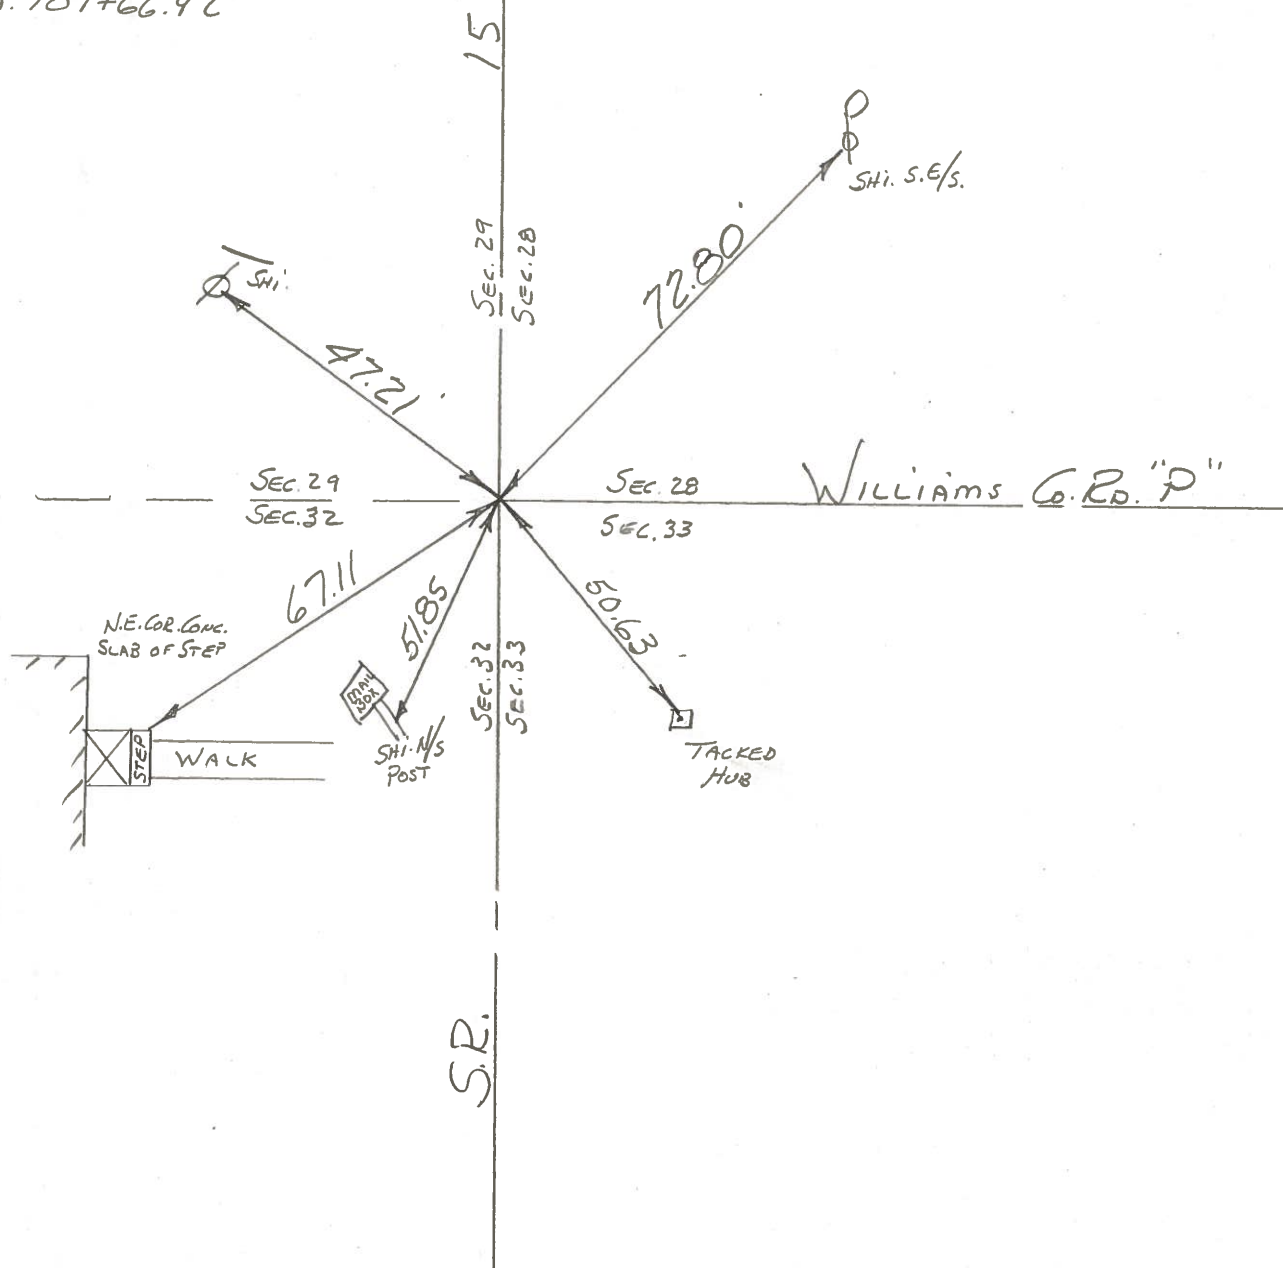

Q.D.O.T. DISTRICT 2 SURVEY OFFICE

Sht. 27 of 35

County WILLIAMS S.R. 15

Township MADISON

Section 33

T9N, R2E

Personnel BURNSIDE


SMITH

MEAD

Date 11-28-79 5-13-82

Weather CLOUDY clear


Temp. +32° +80

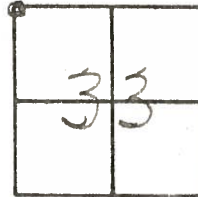

FD. R.R. SPK @ SURFACE
E IN CTR. PAVEMENTS


P.I. STA. 189+66.92

36 14

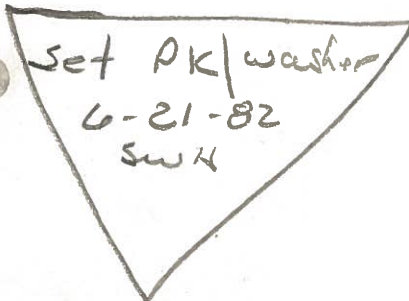

5 km sta ± 186+88 #18
12.7' to wep

DUPLER NAIL
S.E. SIDE
Shi SE/S

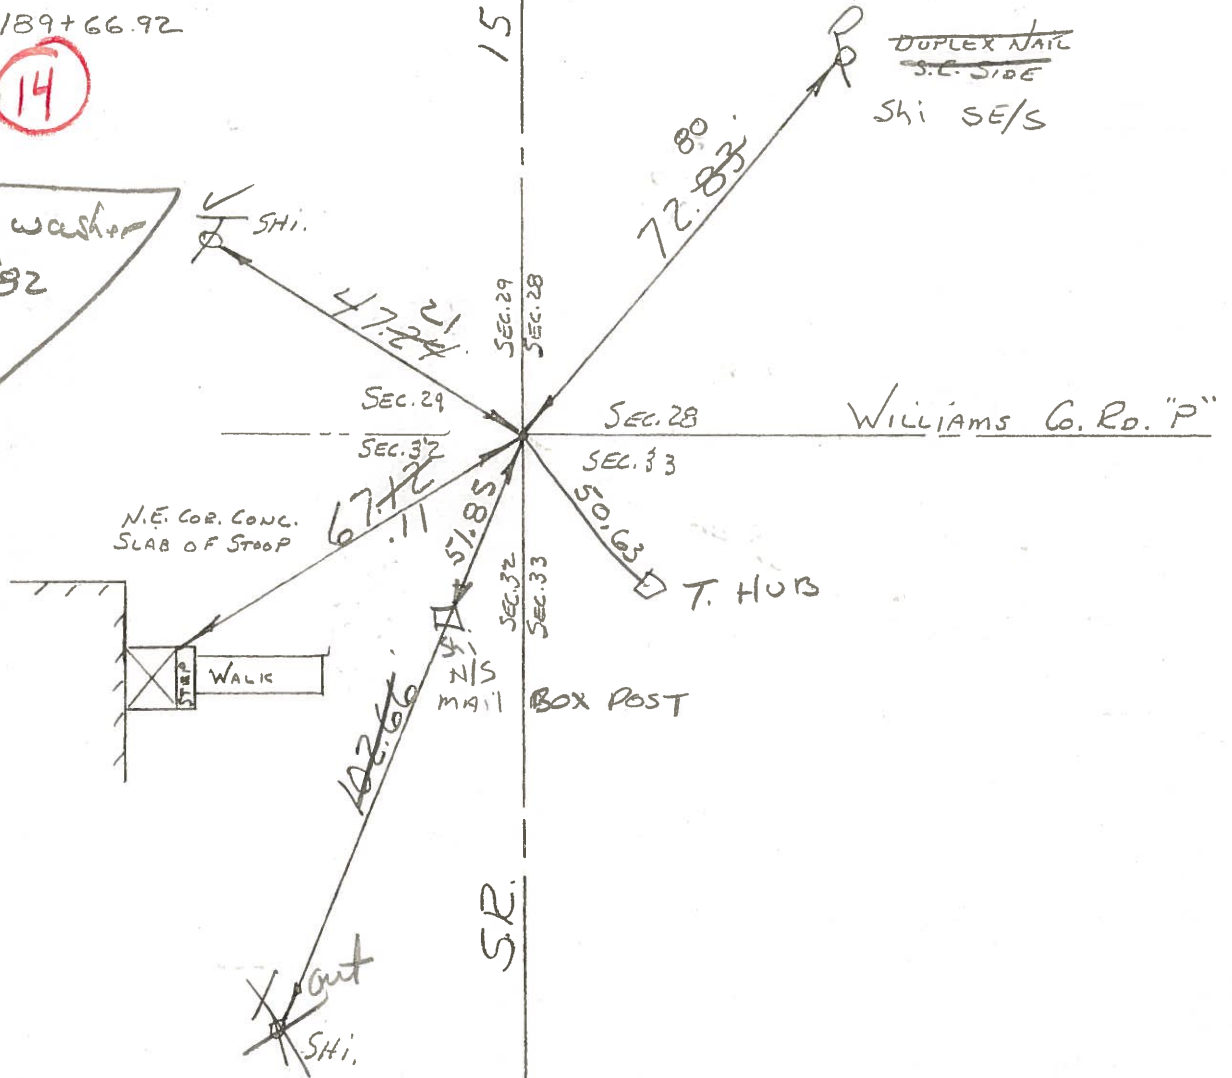

Q.D.O.T. DISTRICT 2 SURVEY OFFICE

Sht. 27 of 35

County WILLIAMS S.R. 15

Township MADISON

Section 33

T9.8, R2EV

Personnel BURNSIDE


SMITH

MEAD

Date 11-28-79

Weather Cloudy

Temp. +32°

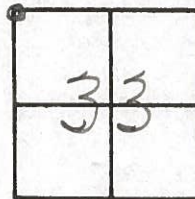

FD. R. R. SPK @ SURFACE
& IN CTR. PAVEMENTS


#18

P.I. STA. 189+66.92

~~3%~~ 14

Hand-drawn survey map showing Williams Co. Rd. "P" and various sections (SEC. 28, SEC. 29, SEC. 32, SEC. 33). The map includes bearings and distances such as 47.24, 72.83, 67.12, and 102.66. It also shows a "COR. CONC. OF STOOD" and a "WALK" area.

PERSONNEL TITLE PERSONNEL TITLE

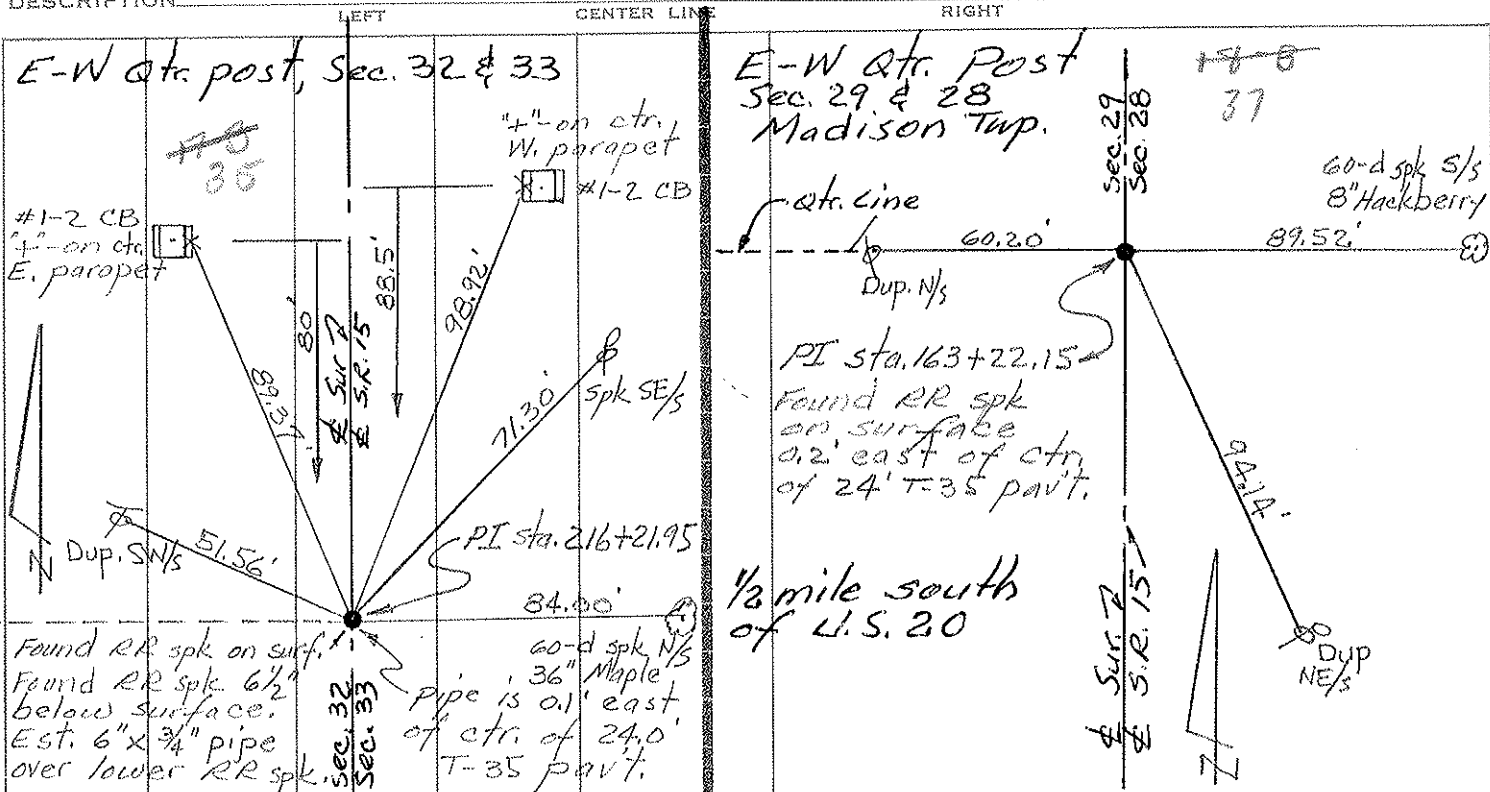Red Beach
Newcomb
KnappeCOUNTY Williams DATE Sept. '72S. R. 15 WEATHER _____SEC. Madison Twp. TEMP. _____DESCRIPTION CONTROL POINTS JOB NO. _____

Sec. Cor. 28, 29, 32 & 33 Madison Twp

18
36

shiner

Sec Line 7

Twp Rd. "P"

69.37'

45.46'

65'

49'

20'

shiner

Sec. 29
Sec. 28

72.81'

Spk SE/S

PI sta. 189+66.92

Found RR spk
on surf.
0.5' east of ctr.
of 24.2' T-35 pav't.Sec. 32
Sec. 33

PERSONNEL TITLE PERSONNEL TITLE

SHEET NO.

Louys
Perrifall
Wise
Krohn

COUNTY W.I.

DATE 7-22-58

S. R. 15

WEATHER Cloudy

SEC. From Rt. #20 to Bryan N. Corp. Line

TEMP. 75°

225 DESCRIPTION Re-check of witnesses.

LEFT

CENTER LINE

RIGHT JOB NO.

P.I. sta. 242+75.55

 $\Delta = 1^\circ - 18' \text{ RT}$

R.R. Spk. W. Pav't.

(33)

Cement Block FOUND. - res.

10.92

80.11

Cement Block FOUND. Garage

31.91

Spk. W. side

224

ADD

P.C. sta. 240+80.55

Shiner in Pav't.

Shiner W.N.W. side

45.45

64.82

Duplex Nail S.E. side 9" twin Cedar

223

(34)

P.I. sta. 231+91.2

Small R.R. Spk.

Shiner E. root 4 1/2" twin Elm

94.08

66.97

44.71

Shiner E. side 20" mulberry

Spk. N.W. side

97.40

Shiner S.E. side

222

(15)

P.I. sta. 216+21.95

 $\Delta = 0^\circ - 14' \text{ LT.}$

Small R.R. Spk.

2 Spk. S. side 20" Apple

103.63

83.90

Spk. N. side 30" Maple

91.29

51.34

Shiner S.E. side

Spk. S.E. side

221

ADD

P.T. sta. 190+94.92

37.41

44.59

Spk. S.E. side

Spk. N.E. side

220

(14)

P.I. sta. 189+66.92

 $\Delta = 0^\circ - 51' \text{ RT.}$

80.15

69.38

47.31

1 1/2 story res.

Shiner E. side

NORTH