

# O.D.O.T. DISTRICT 2 SURVEY OFFICE (USE ONLY)

PERSONNEL

REFERENCE NO. 28

SHEET 8 OF 18

NOTES BARRIERE  
H.C. BARRIERE  
R.C. BLUBAUGH

DATE 8/8/24  
WEATHER CLOUDY  
TEMP. 75

ROUTE SR 49  
COUNTY WILLIAMS  
TOWNSHIP FLORENCE  
SECTION 4

DWG BY BARRIERE PID 114849

T 7 N R 1 E

TYPE MONUMENT MAG SHANK  
ON SURFACE - BELOW ON  
OFFSET Q PAVEMENT 1.3' LT LT : RT


TO EDGE PAVEMENT

STATION: 621+52.99

HORIZ.DATUM: NAD83 (2011) GEOID: 18


GRID: NORTHING: 707113.843 EASTING: 1347791.591

LDP: NORTHING: 359263.086 EASTING: 104081.603

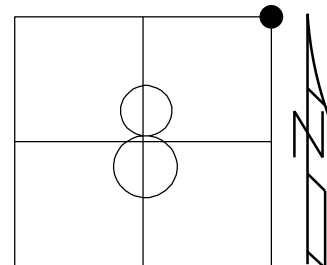

RECORD:  
SET SM RR SPIKE  
5-23-85, CL  
FD SM.R.R.SPIKE  
4/25/88, DC  
FD 1" IPIPE  
2" BELOW  
5/20/97, MB  
SET P.K./WASHER  
10-02-97, MB  
FD SM.R.R.SPIKE  
REF28  
2/7/11, MB  
0.35' DOWN  
5/10/12, MC  
SET MAG/WASHER  
9/11/12, SAH  
FD MAG/WASHER  
REF1  
6-17-14  
12/31/14, EBW  
FD MAG/WASHER  
9/18/19, JMR  
FD MAG SHANK, REF28  
7/5/23-DSA  
11/27/23-TDN  
8/8/24-JAB

NOTE: REF 1 SR 107

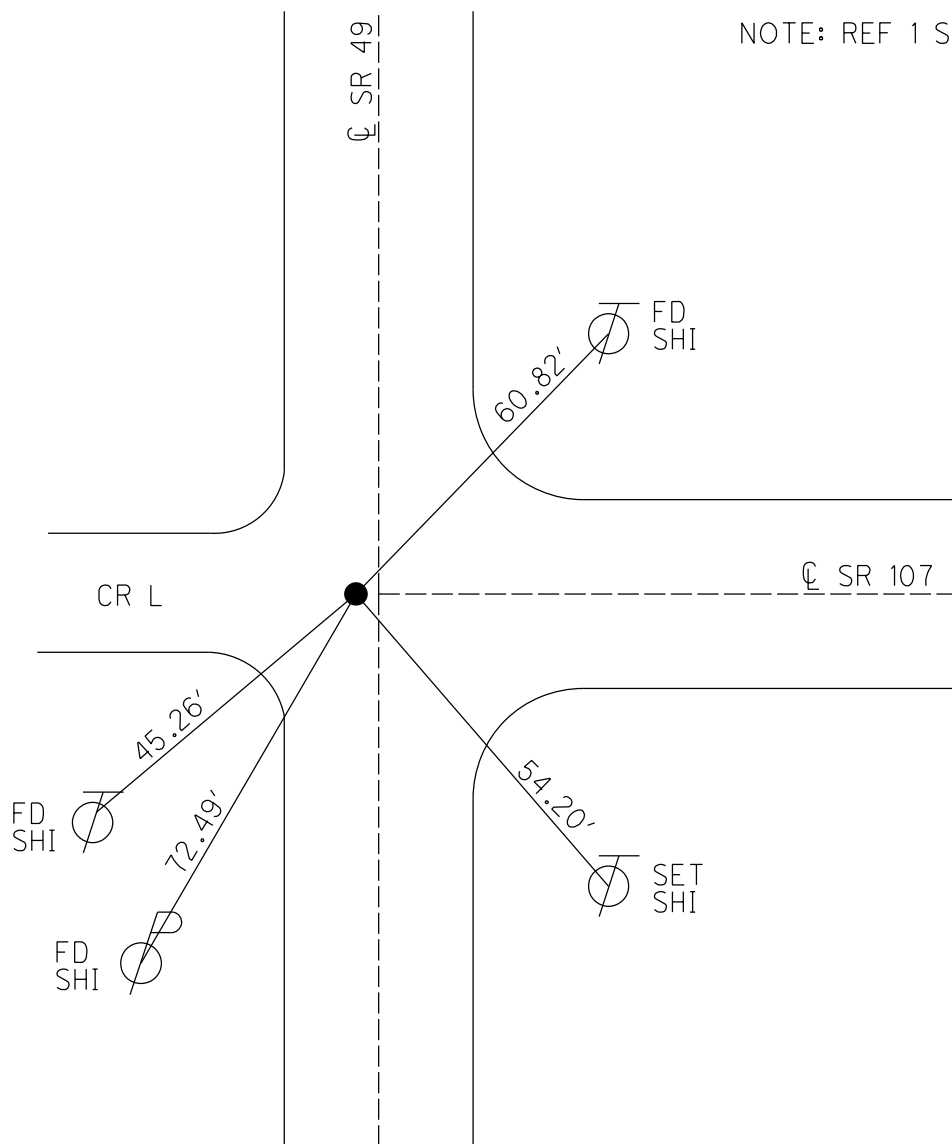

O.D.O.T. DISTRICT 2 SURVEY OFFICE (USE ONLY)

PERSONNEL

REFERENCE NO. 28

SHEET 8 OF 18

NOTES HUSS

DATE 5/10/12

ROUTE SR 49

H.C. HUSS

WEATHER CLEAR/BREEZY

COUNTY WILLIAMS

R.C. CANTERBURY

TEMP. 54°

TOWNSHIP FLORENCE

SECTION 8

T 7 N R 1 E

TYPE MONUMENT SM.R.R.SPIKE


~~ON SURFACE~~ - BELOW 0.35'

LEFT - CL PAV'T - ~~RIGHT~~ 1.3'

- TO - EDGE PAVEMENT ON CL SR 107

S.L.M. 621+52.99

Grid: Northing: 707113.843 Easting: 1347791.591

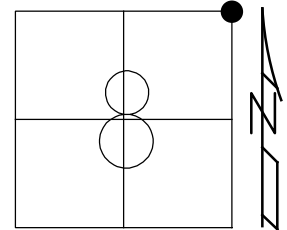

RECORD:  
SET SM RR SPIKE  
5-23-85, CL  
FD SM.R.R.SPIKE  
4/25/88, DC  
FD 1" IPIPE  
2" BELOW  
5/20/97, MB  
SET P.K./WASHER  
10-02-97, MB  
FD SM.R.R.SPIKE  
REF28  
2/7/11, MB  
0.35' DOWN  
5/10/12, MC  
SET MAG/WASHER  
9/11/12, SAH  
FD MAG/WASHER  
REF1  
6-17-14  
12/31/14, EBW  
FD MAG/WASHER  
9/18/19, JMR

NOTE: REF 1 SR 107

