

O.D.O.T. DISTRICT 2 SURVEY OFFICE (USE ONLY)

PERSONNEL

REFERENCE NO. 28A

SHEET 9 OF 18

NOTES BARRIERE

DATE 8/8/24

ROUTE SR 49

H.C. BARRIERE

WEATHER CLOUDY

COUNTY WILLIAMS

R.C. BLUBAUGH

TEMP. 75

TOWNSHIP FLORENCE

SECTION 4

DWG BY BARRIERE PID 114849

T 7 N R 1 E

TYPE MONUMENT MAG WASHER

ON SURFACE - BELOW ON

OFFSET Q PAVEMENT 0.4' LT LT : RT

9.5' TO LT EDGE PAVEMENT

STATION: 644+52.67

HORZ.DATUM: NAD83 (2011)


GEOID: 18

GRID: NORTHING: 709413.032


EASTING: 1347844.162

LDP: NORTHING: 361562.984

EASTING: 104080.104

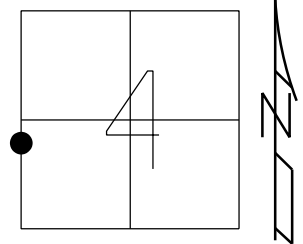

FD P.K.NAIL
5/20/97, MB
RESET P.K./WASHER
10/3/97, MB
FD P.K./WASHER
1/25/11, MC
GPS, REFA28
2/7/11
SET MAG/WASHER
9/11/12, SAH
FD MAG/WASH
REF28A
7/5/23, DSA
11/27/23, TDN

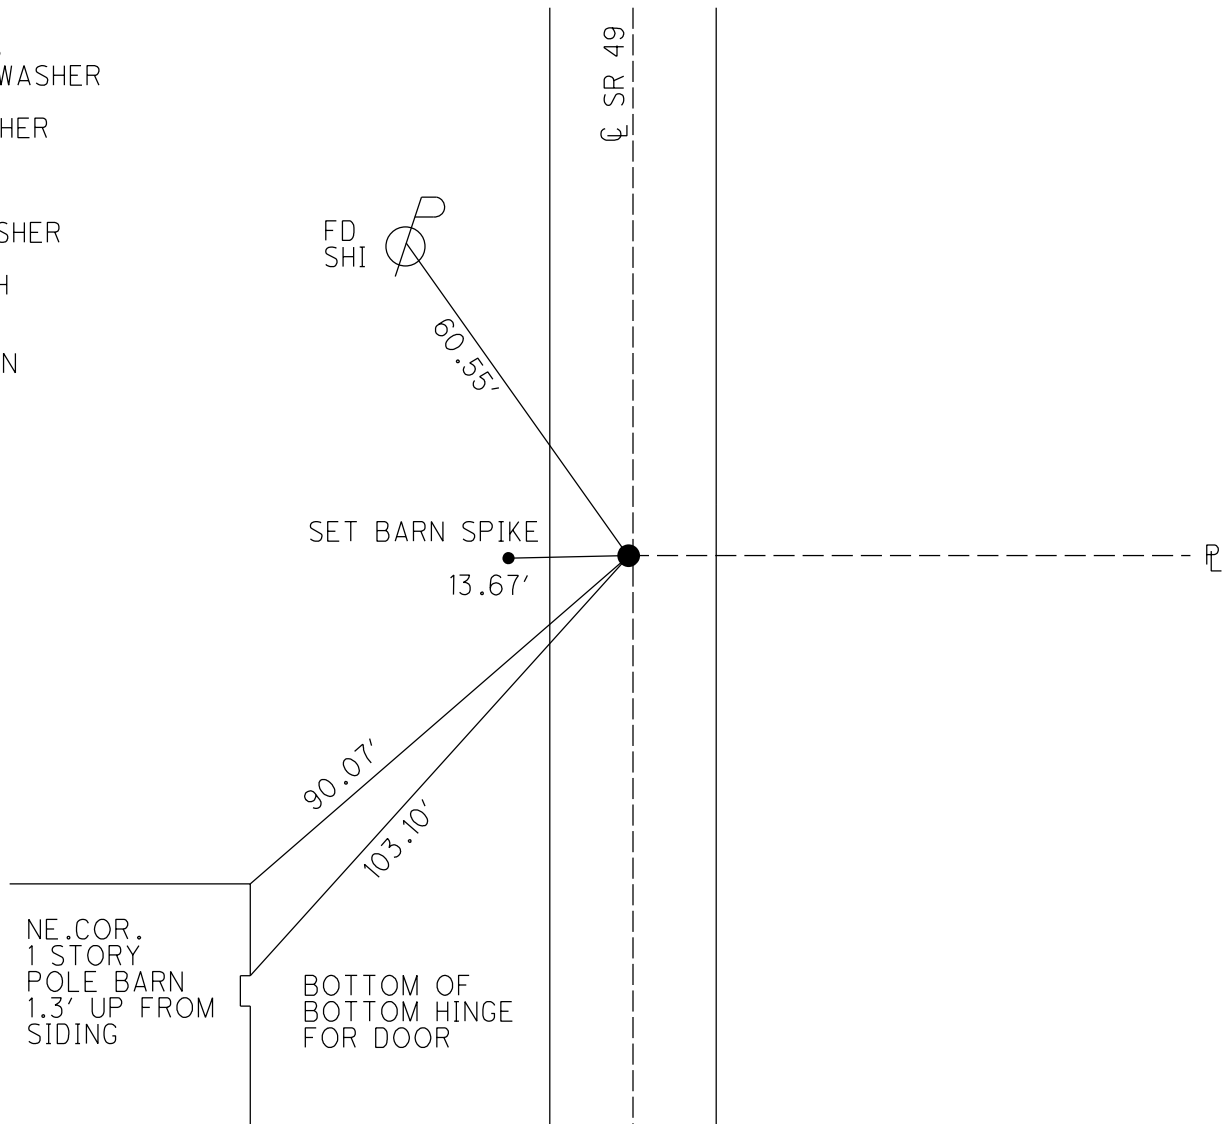

O.D.O.T. DISTRICT 2 SURVEY OFFICE (USE ONLY)

PERSONNEL

REFERENCE NO.

28 A

SHEET

9

OF 18

NOTES HUSS

DATE

5/10/12

ROUTE

SR 49

H.C. CANTERBURY

WEATHER

CLEAR/BREEZY

COUNTY

WILLIAMS

R.C. HUSS

TEMP.

58°

TOWNSHIP

FLORENCE

SECTION

4

T 7 N R 1 E

TYPE MONUMENT P.K. NAIL

ON SURFACE - ~~BELOW~~ ON

LEFT - CL PAV'T - ~~RIGHT~~ 0.4'

9.5' TO LT EDGE PAVEMENT

S.L.M. 644+52.67

Grid: Northing: 709413.032 Easting: 1347844.162

