

O.D.O.T. DISTRICT 2 SURVEY OFFICE (USE ONLY)

PERSONNEL

REFERENCE NO. 29

SHEET 10 OF 18

NOTES BARRIERE

DATE 8/8/24

ROUTE SR 49

H.C. BARRIERE

WEATHER CLOUDY

COUNTY WILLIAMS

R.C. BLUBAUGH

TEMP. 74

TOWNSHIP FLORENCE

DWG BY BARRIERE

PID 114849

SECTION 4

T 7 N R 1 E

TYPE MONUMENT MAG/WASHER

ON SURFACE - BELOW ON

OFFSET Q PAVEMENT 0.7' LT LT : RT

9.5' TO LT EDGE PAVEMENT

STATION: 647+86.89

HORIZ.DATUM: NAD83 (2011)


GEOID: 18

GRID: NORTHING: 709747.155

EASTING: 1347852.138

LDP: NORTHING: 361897.093

EASTING: 104080.317

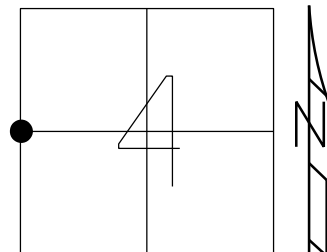

SET SM.R.R.SPIKE
7/6/88, IRS


FD 1" IPIPE
6/3/97, MB

RESET P.K./WASHER
10/2/97, MB

FD P.K./WASHER
1/25/11, MC
GPS, REF29
2/7/11

SET MAG/WASHER
9/11/12, SAH

FD MAG/WASH, REF29
6/28/23-JMR
11/27/23-TDN
8/8/24-JAB


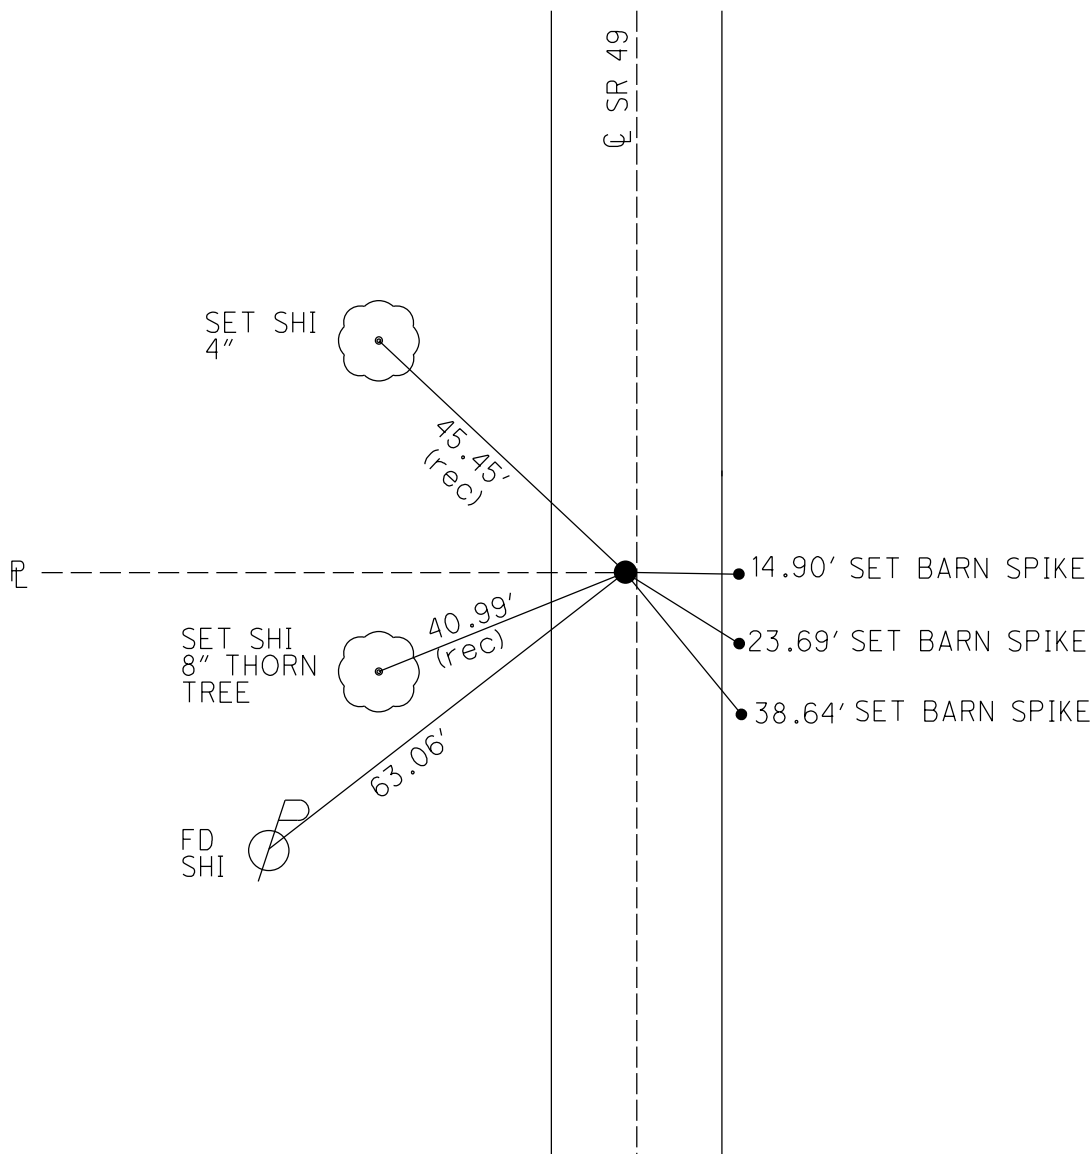


O.D.O.T. DISTRICT 2 SURVEY OFFICE (USE ONLY)

PERSONNEL _____ REFERENCE NO. 29 SHEET 10 OF 18
 NOTES HUSS DATE 5/10/12 ROUTE SR 49
 H.C. CANTERBURY WEATHER CLEAR COUNTY WILLIAMS
 R.C. HUSS TEMP. 58° TOWNSHIP FLORENCE
 _____ SECTION 4
 _____ T 7 N R 1 E

TYPE MONUMENT PK./WASHER
 ON SURFACE - ~~BELOW~~ ON
 LEFT - Q PAV'T - ~~RIGHT~~ 0.7'
9.5' TO LT EDGE PAVEMENT
 S.L.M. 647+86.89

Grid: Northing: 709747.155 Easting: 1347852.138

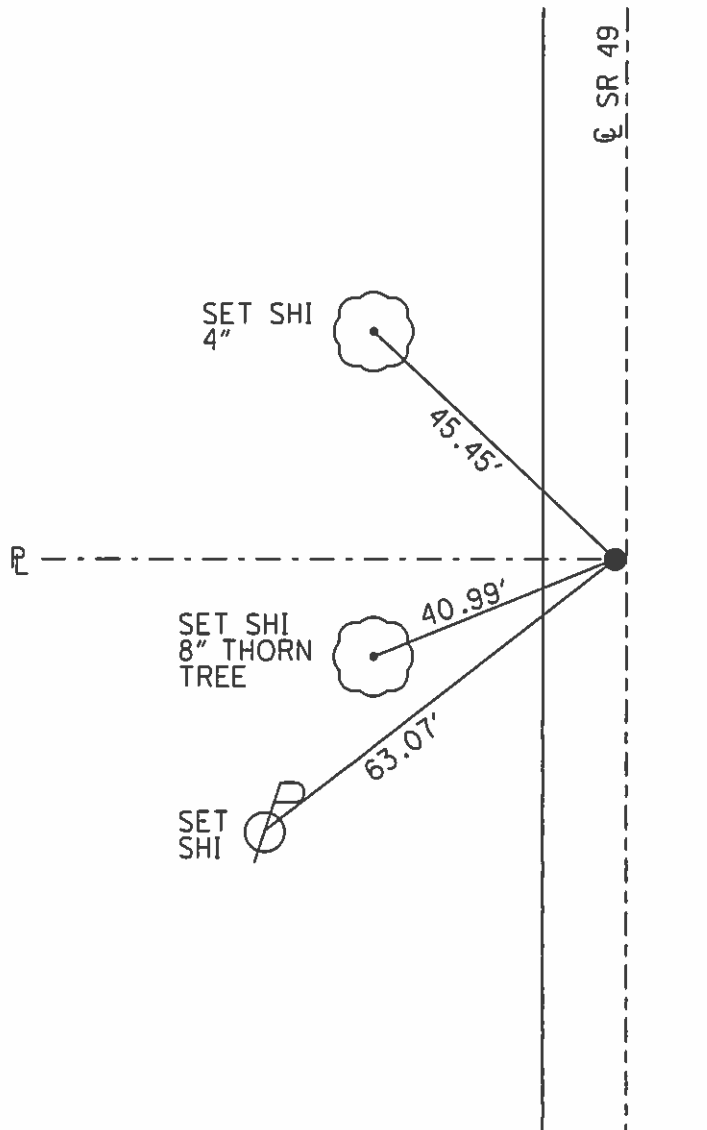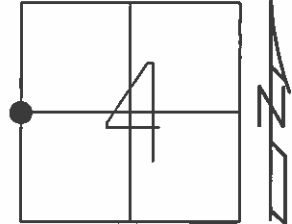

SET SM.R.R.SPIKE
7/6/88, IRS

FD 1" IPIPE
6/3/97, MB

RESET P.K./WASHER
10/2/97, MB

FD P.K./WASHER
1/25/11, MC
GPS, REF29
2/7/11

SET MAG/WASHER
9/11/12, SAH