

O.D.O.T. DISTRICT 2 SURVEY OFFICE (USE ONLY)

PERSONNEL

REFERENCE NO. 29 A

SHEET 11 OF 18

NOTES BARRIERE
H.C. BARRIERE
R.C. BLUBAUGH

DATE 8/8/24
WEATHER CLOUDY
TEMP. 74

ROUTE SR 49
COUNTY WILLIAMS
TOWNSHIP FLORENCE
SECTION 4
T 7 N R 1 E

DWG BY BARRIERE PID 114849

TYPE MONUMENT MAG/WASHER

ON SURFACE - BELOW ON

OFFSET Q PAVEMENT 0.3' LT LT : RT

10.1' TO LT EDGE PAVEMENT

STATION: 674+31.85

HORIZ.DATUM: NAD83 (2011)


GEOID: 18

GRID: NORTHING: 712391.457

EASTING: 1347911.412

LDP: NORTHING: 364542.132

EASTING: 104077.443

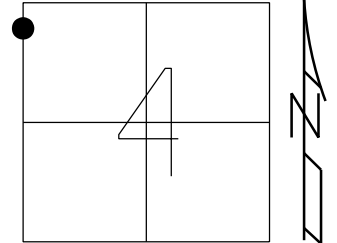

FD 1" IPIPE
6/13/97, MB

RESET P.K./WASHER
10/3/97, MB

FD P.K.SHANK
1/25/11, MC
GPS, REFA29
2/8/11

SET MAG/WASHER
9/11/12, SAH

FD MAG/WASH, REF29A
6/28/23-JMR
11/27/23-TDN
8/8/24-JAB

