

O.D.O.T. DISTRICT 2 SURVEY OFFICE (USE ONLY)

PERSONNEL

REFERENCE NO. 30

SHEET 12 OF 18

NOTES BARRIERE
H.C. BARRIERE
R.C. BLUBAUGH


DATE 8/8/24
WEATHER CLOUDY
TEMP. 74

ROUTE SR 49
COUNTY WILLIAMS
TOWNSHIP FLORENCE
SECTION 4

DWG BY BARRIERE PID 114849

T 7 N R 1 E

TYPE MONUMENT MAG/WASHER
ON SURFACE - BELOW ON
OFFSET $\varnothing$ PAVEMENT 1.6" LT LT : RT
TO EDGE PAVEMENT
STATION: 683+52.52

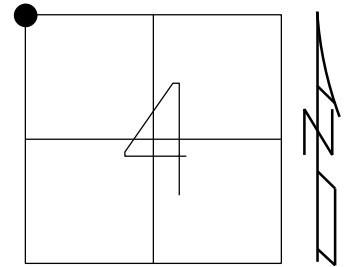

HORIZ.DATUM: NAD83 (2011) GEOID: 18
GRID: NORTHING: 713311.858 EASTING: 1347933.473
LDP: NORTHING: 365462.979 EASTING: 104077.891

SET SM.R.R.SPIKE
7/6/88, IRS

FD 1" IPIPE
5/20/97, MB

RESET P.K./WASHER
10/3/97, MB

FD P.K./WASHER
1/25/11, MC
GPS, REF30
2/8/11

SET MAG/WASHER
9/11/12, SAH

FD MAG/WASH, REF30
6/28/24-JMR
11/27/23-TDN
8/8/24-JAB

CUT NOTCH
1' UP SIGN
'ONE LANE BRIDGE'

