

O.D.O.T. DISTRICT 2 SURVEY OFFICE (USE ONLY)

PERSONNEL

REFERENCE NO. 31

SHEET 13 OF 18

NOTES BARRIERE

DATE 8/8/24

ROUTE SR 49

H.C. BARRIERE

WEATHER CLOUDY

COUNTY WILLIAMS

R.C. BLUBAUGH

TEMP. 74°

TOWNSHIP FLORENCE

DWG BY BARRIERE

PID 114849

SECTION 33

T 8 N R 1 E

TYPE MONUMENT MAG/WASHER

ON SURFACE - BELOW ON

OFFSET Q PAVEMENT ON LT : RT

TO EDGE PAVEMENT

STATION: 709+79.67

HORZ.DATUM: NAD83 (2011)


GEOID:

GRID: NORTHING: 715938.259

EASTING: 1347996.319

LDP: NORTHING: 368090.3

EASTING: 104078.969

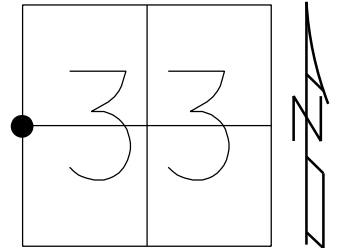

FD SM.R.R.SPIKE
5/20/97, MB

RESET P.K./WASHER
10/3/97, MB

FD SQ.HEADED SPIKE
1/25/11, MC
GPS, REF31
2/8/11

SET MAG/WASHER
9/12/12, SAH

FD MAG/WASH, REF31
6-28-23-JMR
11-27-23-TDN
8/8/24-JAB

