

O.D.O.T. DISTRICT 2 SURVEY OFFICE (USE ONLY)

PERSONNEL

REFERENCE NO. 32 A

SHEET 15 OF 18

NOTES RHODES
H.C. NIESE
R.C. ASTON

DATE 11/27/23
WEATHER CLOUDY
TEMP. 30° F

ROUTE SR 49
COUNTY WILLIAMS
TOWNSHIP FLORENCE
SECTION 33

DWG BY BARRIERE PID 114849

T 8 N R 1 E

TYPE MONUMENT 1" IPIPE

ON SURFACE - BELOW 1" BELOW

OFFSET $\varnothing$ PAVEMENT 98.5' RT

10' TO S EDGE PAVEMENT

STATION: 752+29.91

HORIZ.DATUM: NAD83 (2011)


GEOID: 18

GRID: NORTHING: 719933.733


EASTING: 1348982.940

LDP: NORTHING: 372108.047

EASTING: 104971.560

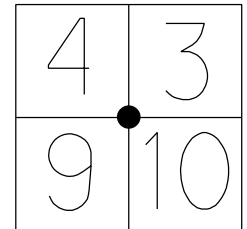

RECORD:
FD STONE
7/6/88, IRS
FD 1" IPIPE
5/20/97, MB
FD 1" IPIPE
1/25/11, MC
GPS, REFA32
2/8/11
GPS, REFA32
10/27/14, SBW
FD 1" IPIPE
1" DOWN, REF32A
11/27/23-TDN

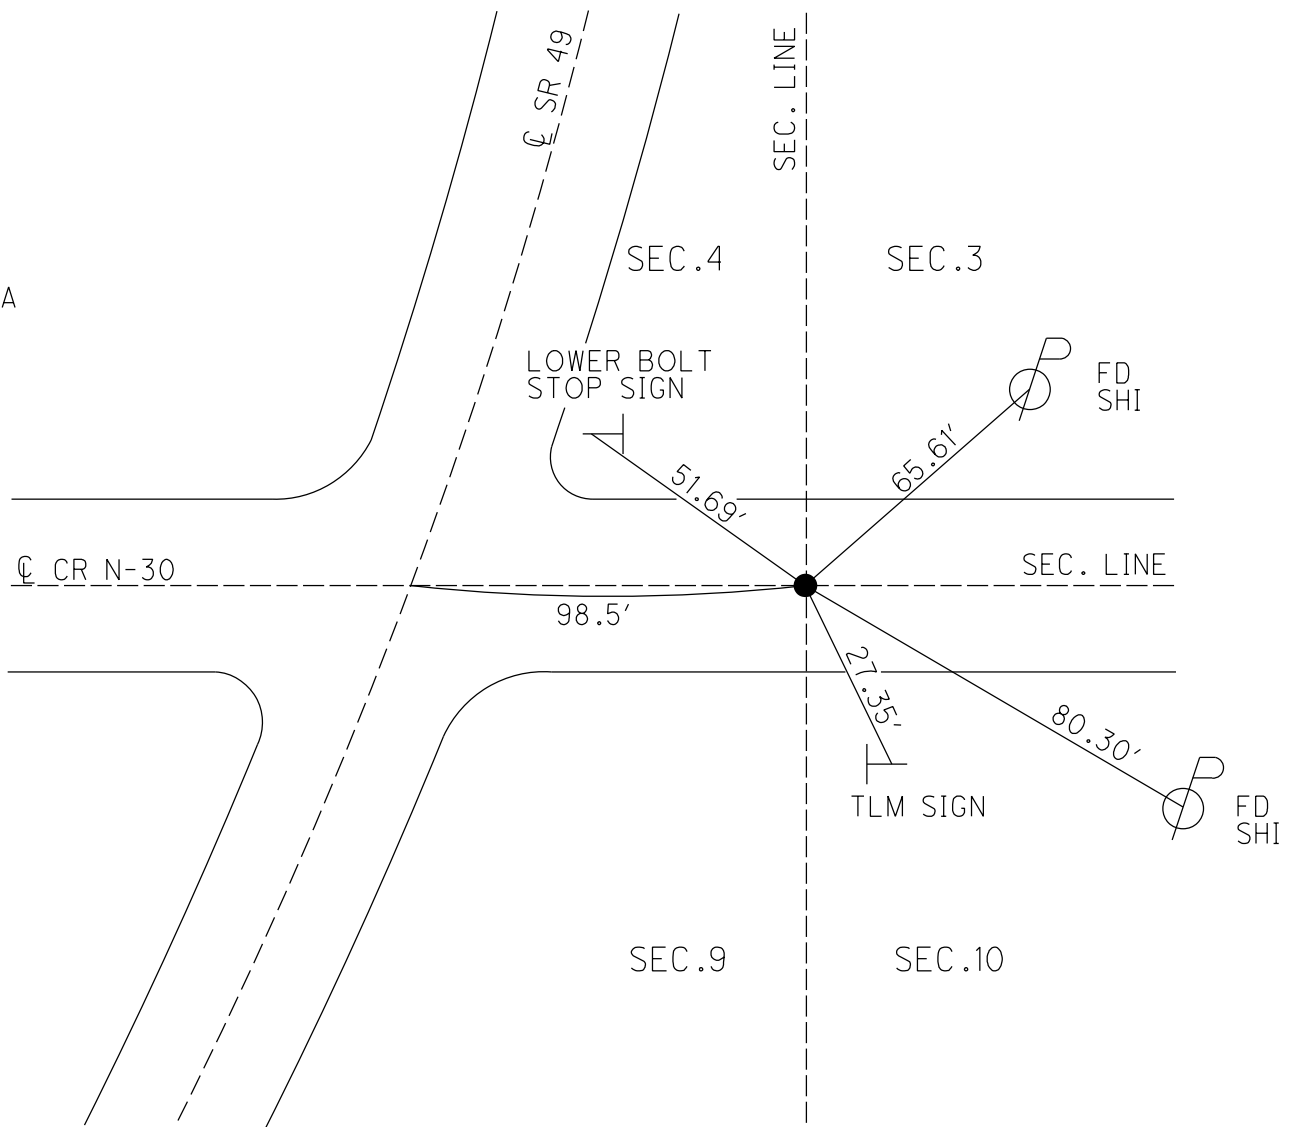

O.D.O.T. DISTRICT 2 SURVEY OFFICE (USE ONLY)

PERSONNEL

REFERENCE NO. 32 A

SHEET 15 OF 18

NOTES HUSS

DATE 5/11/12

ROUTE SR 49

H.C. HUSS

WEATHER CLEAR/FAIR

COUNTY WILLIAMS

R.C. CANTERBURY

TEMP. 63°

TOWNSHIP NORTHWEST

DWG BY WHITAKER PID 98653

SECTION 3

T 10 N R 4 E

TYPE MONUMENT 1" IPIPE

ON SURFACE - ~~BELOW~~ ON

OFFSET Q PAVEMENT 98.5', 0.8' S ~~LT~~ : RT

10' TO S EDGE PAVEMENT


STATION: 752+29.91

HORZ.DATUM: NAD83 2011


GEOID: NAVD88 2012A

GRID: NORTHING: 719933.713

EASTING: 1348983.015

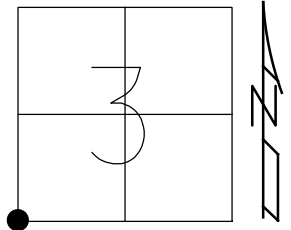

RECORD:
FD STONE
7/6/88, IRS
FD 1" IPIPE
5/20/97, MB
FD 1" IPIPE
1/25/11, MC
REFA32
2/8/11
REFA32
10/27/14, SBW

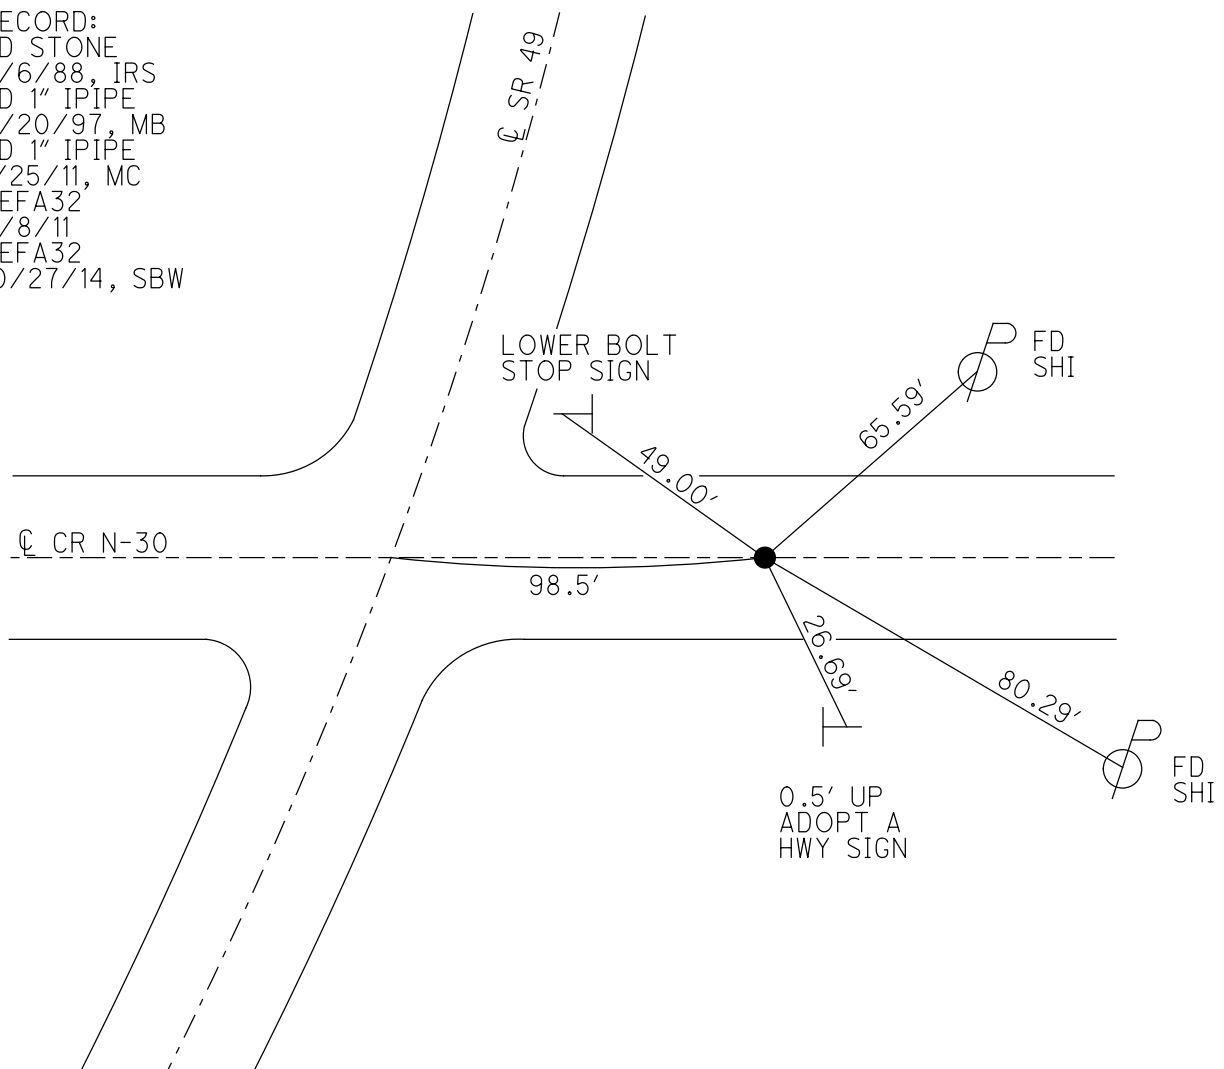

O.D.O.T. DISTRICT 2 SURVEY OFFICE (USE ONLY)

PERSONNEL _____ REFERENCE NO. 32 A SHEET 15 OF 32 A
 NOTES HUSS DATE 5/11/12 ROUTE SR 49
 H.C. HUSS WEATHER CLEAR/FAIR COUNTY WILLIAMS
 R.C. CANTERBURY TEMP. 63° TOWNSHIP NORTHWEST
 SECTION 3, 4, 9, 10
 T 10 S R 4 W


TYPE MONUMENT 1" IPIPE

ON SURFACE - ~~BELOW~~ ON _____

~~LEFT~~ - Q PAV'T - RIGHT 98.5', 0.8' S. OF Q CR N-30
10.0' TO S EDGE PAVEMENT (CR N-30)

S.L.M. 752+40

Grid: Northing: 719933.752 Easting: 1348982.864

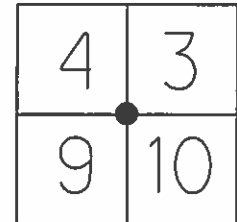

FD STONE
7/6/88, IRS

FD 1" IPIPE
5/20/97, MB

FD 1" IPIPE
1/25/11, MC
GPS, REFA32
2/8/11

